ADDENDUM NO. FOUR

Eric S. Weflen, AIA, NCARB Indiana Registration No. AR11500136

THIS ADDENDUM FORMS A PART OF THE CONTRACT DOCUMENTS AND IS ISSUED IN ACCORDANCE WITH THE INSTRUCTIONS TO BIDDERS. ACKNOWLEGE RECEIPT OF THIS ADDENDUM BY SIGNING THE ADDENDUM ACKNOWLEDGEMENT SECTION OF YOUR PROPOSAL.

General Notifications:

- 1. See attached for Bid Question Log responses.
- 2. IT (Room 2603), rename to Security Electronics.

Specifications:

1. Specification No.: 01 12 00 Specification Title: Multiple Contract Summary Description:

- Bid Package No. 1 General Trades
 - Remove and replace with attached BP #01 document
 - Bid Package No. 6 Metal Studs, Drywall, Paint
 - Remove and replace with attached BP #06 document
- All Bid Packages
 - Disregard all requirements for BIM included in Bid Package Scope documents, and specification sections. Work will be constructed onsite via Bid Package coordination.
- 2. Specification No.: 00 42 00 Specification Title: Supplementary Bid Form

Description: Replace with attached, adding Bid Alternate E "Duplex Booster Pump"

- Specification No.: 00 54 36 Specification Title: Building Information Modeling Description: Remove this specification in entirety-BIM will not be implemented on this project.
- 4. Specification No.: 00 62 16 Specification Title: Insurance Requirements Description: Remove/replace with attached.
- Specification No.: 01 23 00 Specification Title: Alternates Description: Replace with attached, adding Bid Alternate E "Duplex Booster Pump"
- Specification No.: 08 71 00 Specification Title: Door Hardware Description: Replace with attached spec, adjusting set 18.5 as shown below.

Set: 18.5

Doors: 1301.1

Description: Access Control Function Pair - Panic Egress - Hold-Open

4 Hinge, Full Mortise, Hvy Wt	MPB68 (size per spec)	US26D	MK
2 Electric Hinge, Hvy Wt	MPB68-QC (size per spec)	US26D	MK
1 Elec CVR Exit Device (EL/RX/LX/NL)	7160 B S MELR 121NL A640 CMK	630	¥A
1 Elec CVR Exit Device (EL/RX/EO)	7160 B MELR EO	630	YA
1 Elec CVR Exit Device (EL/NL/LX/RX)	7160 B S MELR CR627F A640 CMK	630	YA
2 Surface Closer	3501	689	YA
2 Surface Closer w/ Stop	3531	689	¥A
2 Kick Plate	K1050 10" HGT x CSK x BEV	US32D	RO
2 Electromagnetic Holder	99xM for wall condition	689	RF
<i>2 Electromagnetic Holder</i>1 Gasketing	99xM for wall condition S88D	689	RF PE
C C	·	689	
1 Gasketing	S88D	689	PE
1 Gasketing 1 Astragal	S88D S772BL	689	PE PE
 Gasketing Astragal Wiring Harness 	S88D S772BL QC-C3000P (frame to JB/PS)	689	PE PE MK
 Gasketing Astragal Wiring Harness Wiring Harness 	S88D S772BL QC-C3000P (frame to JB/PS) QC-CxxxP (door - length as req'd)	689	PE PE MK MK
 Gasketing Astragal Wiring Harness Wiring Harness Card Reader 	S88D S772BL QC-C3000P (frame to JB/PS) QC-CxxxP (door - length as req'd) By Security Contractor	689	PE PE MK MK OT

Notes:

Doors can be placed in hold-open position as needed by electronic wall magnets. Magnets must be integrated with fire alarm system and release in alarmed state. When locked, entry to Unit D by valid input at reader to retract latch or manual key (active leaf). Free egress (both leafs) at all times.

Door position switches to monitor opening status. Exit devices have integral RX feature to signal egress. Coordinate with electrical and security contractors.

- Specification No.: 09 97 26 Specification Title: Cementitious Coatings Description: Add attached specification.
- Specification No.: 10 51 13 Specification Title: Metal Lockers Description: Add Lyon All Welded Lockers as approved product.
- Specification No.: 11 19 30 Specification Title: Security Hardware and Sliding Door Devices Description: Add Hardware set S01.6

Hardware Set S01.6 - Padded Cell

Each to Receive:

4	ea	Hinge	NW645 FMST x #30 Torx	US32D	NW
2	ea	Food Pass Hinge	NW631 FPB	USP	NW
1	ea	Elec Jamb Lock	5022M-MSLH 24VDC	USP	BR
1	ea	Food Pass Lock	7017	USP	BR
1	ea	Loop Pull	NW601	US32D	NW
1	ea	Flush Pull	Titan #2 (by door mfg.)	USP	ΤI
1	ea	Concealed Closer	2214	AL	LC
1	ea	Wall Stop	NW706	Black	NW
3	ea	Silencers	608	Grey	RO
1	ea	Magnetic DPS	201020	US32D	BR

- Specification No.: 22 13 00
 Specification Title: Sanitary Sewer Systems
 Description: Added manufacturer Duratrench model specification for trench drains.
- Specification No.: 23 25 13 Specification Title: Water Treatment For Closed-Loop Systems Description: Added Water Treatment specification.
- 12. Specification No.: 23 64 23
 - Specification Title: Dedicated Heat Recovery Scroll Water Chillers Description: Removed verbiage stating that units must be fully operational after a seismic event. Changed Seismic Component Important Factor to 1.0.
- 13. Specification No.: 23 64 23.13
 Specification Title: Air-Cooled Scroll Water Chillers
 Description: Added seismic performance requirements. Added Component Important Factor of 1.0.

14. Specification No.: 23 72 23 Specification Title: Air-To-Air Energy Recovery Equipment Description: Removed verbiage stating that units must be fully operational after a seismic event. Changed Seismic Component Important Factor to 1.0.

 15. Specification No.: 23 73 13.13
 Specification Title: Basic Air-Handling Units
 Description: Removed verbiage stating that units must be fully operational after a seismic event. Changed Seismic Component Important Factor to 1.0.

- Specification No.: 23 74 33
 Specification Title: Dedicated Outdoor-Air Units
 Description: Removed verbiage stating that units must be fully operational after a seismic event. Changed Seismic Component Important Factor to 1.0.
- 17. Specification No.: 28 31 00
 Specification Title: Addressable Fire-Alarm System
 Description: Replace this specification section in its entirety with attached modified Addressable
 Fire-Alarm System specification section.

Drawings:

- 1. Drawing Sheet No.: C100 Revision: Site Demolition Plan
 - Key Notes revised to show demo of radio tower and AC equipment by others.
 - Key Notes revised to show generator and transformer location for unit D alternate
 - Demo note added for existing storm structure 103 and associated storm pipe
- 2. Drawing Sheet No.: C200 Revision: Site Layout Plan
 - Electrical Transformer Pad Location was revised
 - Riprap apron was added at proposed storm pipe location into pond
- 3. Drawing Sheet No.: C300 Revision: Site Utility Plan
 - Top Casting (TC) Rim Elevations were added to all sanitary sewer structures
 - Existing and proposed symbol legend was added to the sheet
 - Storm network background was updated to match revised storm drainage
- 4. Drawing Sheet No.: C400 and C401 Revision: Site Grading and Drainage Plan
 - Detention pond was revised to respond to Drainage Board comments
 - Storm pipe and inlet location was revised at Unit D to avoid conflicts with Electrical Generator/Transformer Equipment locations
- 5. Drawing Sheet No.: C500

Revision: Site Erosion Control Plan

• Legend was updated to include soil stockpile location and riprap location for proposed storm outlet to pond

- Location of soil stockpile at the existing berm was added to the plan
- Location of proposed riprap apron was added to the plan
- Inlet protection locations were update to reflect revised storm inlet location
- Additional silt fence and erosion control blanket was added around the detention pond to correspond with the revisions made to the grading plan.
- 6. Drawing Sheet No.: C501

Revision: Site Erosion Control Details

- Soil stockpile sediment control detail was added
- Riprap apron detail was added
- Drawing Sheet No.: C502 Revision: Stormwater Pollution Prevention Plan
 - Soil Map was added
 - Receiving water body was updated.
- Drawing Sheet No.: 6C02 Revision: Construction Details
 - Outlet control structure detail was added.
- Drawing Sheet No.: A211 Revision: Add eave elevations. Refer to attached drawing.
- Drawing Sheet No.: A212 Revision: Add eave elevations. Refer to attached drawing.
- Drawing Sheet No.: A600 Revision: Door sizes and hardware modified. Refer to attached drawing.
- 12. Drawing Sheet No.: P210C Revision: First Floor Plumbing Plan – Unit C
 - Indicated origin of 4" cold water main off existing Corridor 1300 in Unit C.
- Drawing Sheet No.: P210D Revision: First Floor Plumbing Plan – Unit D
 - Revised gas pipe size to Mech. Room 1659.
 - Indicated origin of water and gas mains off existing Corridor 1300 in Unit C.
 - Added make-up air water w/ backflow preventer for air separator in Mech. 1612.
- 14. Drawing Sheet No.: P220D Revision: Second Floor Plumbing Plan – Unit U
 - Revised gas pipe size to Mech. Room 1659.
 - Indicated origin of water and gas mains off existing Corridor 1300 in Unit C.
- 15. Drawing Sheet No.: P220F

Revision: Second Floor Plumbing Plan – Unit F

- Revised water pipe sizes dropping down to first floor.
- 16. Drawing Sheet No.: P500

Revision: Enlarged Plumbing Plans.

• Revised gas pipe sizes to boilers and water heaters in Mech. 1659, Unit C.

- Added FD-4 adjacent B-3.
- Revised gas pipes in Mech. 1532, Unit F.
- Indicated raw cold water line main.
- Indicate storm drain line on detail 5.
- Added note for air separator.
- 17. Drawing Sheet No.: P600

Revision: Plumbing Schedules

- Added two compartment sink to plumbing fixture schedule.
- 18. Drawing Sheet No.: P704

Revision: Plumbing Natural Gas Piping Diagram.

- Revised gas pipe sizes.
- 19. Drawing Sheet No.: P804
 - Revision: Plumbing Details.
 - Replaced detail 4 with water piping schematic for Unit A and D.
- Drawing Sheet Nos: E001,E010,E011,E210D,E310A,E310B,E310C,E310D,E320D,E330,E410A,E410B,E410C,E410 D,E410F,E420D,E490D,E601,E602,E603,E700 Revision: Refer to attached drawings.
- 21. Drawing Sheet No.: ES104D and ES104D1

Revision: Make this adjustment. Note: Revised drawing not attached.

• Cameras #130 and #131 as shown on drawing ES104D1 (Alternate D1) shall be removed from this drawing and added to drawing ES104D (Alternate D) in the same physical location.

	Item No.	Item Description	Received From	Date Received	Date To RQAW	Response Date	
	01	Area "C" – existing ceiling is not labeled for demolition (is this exposed as existing, Installation of new MEP will require access ?)	Garmong		2/2/2022		Added to set pre-addendum
-	02	Wall partition M10-D used on Area "D" – do not see that wall type on A002	Garmong		2/2/2022		Added to set pre-addendum
-	03	Finish Plan IN 101 1B1 – indicates new floor finishes in all rooms, excluding Kitchen (Kitchen is indicated as "existing" – are we providing new floor finish as indicated ? (New floor finishes in rooms not being remodeled will require contents removal / replacement – kitchen support areas / freezer will require shutdown)	Garmong		2/2/2022	2/16/2022	ADDN 02- Sheet IN101 1B F Kitchen 1309 flooring (Own remain existing VCT (addtio
	04	General Note Drawing IN 001 Existing areas "B" wall paint, at all rooms ?	Garmong		2/2/2022	2/16/2022	ADDN 02 - clarified in Interi
	05	Drawing partition type details to not reflect this construction CCC. All TOP OF MASONRY WALLS SHALL BE TO DECK AS INDICATED ON PLANS 2' SHORT OF DECK OR STRUCTURE ABOVE. FILL GAP WITH SOUND ATTENUATION BLANKET, AND PROVIDE JOINT SEALANT ON BOTH SIDES BETWEEN TOP OF WALL AND UNDERSIDE OF STRUCTURE/DECK. AT RATED WALL ASSEMBLIES PROVIDE FIRE RESISTIVE JOINT SYSTEM BETWEEN TOP OF WALL AND BOTTOM OF STRUCTURE/DECK.	Garmong		2/2/2022		See sheet A 335 Addendum
	06	A reflected ceiling plan has not been provided for Area "C" (AC 1B1 for Area B extends into Area C, but indicates the existing ceiling is to remain. (Electrical is shown from feeding 1245 - 1247 area)	Garmong		2/2/2022		Added to set pre-addendun
	07	Civil Drawing C-300 does not indicate domestic water route into the building. Several utility pipe sizes are indicated as "X"	Garmong		2/2/2022		These will be addressed in A
	08	Drawn A210 REF Section 3A / A321 - drawing section doesn't appear to be the correct location at the exterior wall	Garmong		2/2/2022		Added to set pre-addendum
	09	Site Electrical E010 does not indicate primary / secondary power feed to Unit "F", or emergency generator	Garmong		2/2/2022		Added to Addendum #2
	10	Site Electrical E010 does not indicate revisions to accommodate Unit "D" alternates (relocation of generator, transformer etc.)	Garmong		2/2/2022		Added to Addendum #2



Response
ım #1
um #1
Floor tags updated; Cart Storage 1316 flooring to match existing oner has attic storage product); Chemical Storage 1318 flooring to ional VCT may be required)
riors General Notes on Sheet IN001
m #2
um #1 (Garmong comment: please confirm for electrical feeds)
n Addendum #2
um #1

11	Geotechnical Report - please provide document	Garmong		2/3/2022	Document provided
12	Volume II Index includes 05 40 00 Cold Formed Metal Framing - no specification has been included in the documents	Garmong		2/3/2022	ADDN 01 added specificatio
13	Specifications include Seismic Hanger sections for HVAC and Plumbing - No Seismic Hanger specification is included for Electrical	Garmong		2/3/2022	Addendum 03
14	A1-D5 (not in drawing index)	Garmong		2/7/2022	ADDN 01
15	AC-ALT-D1-D5 (not in drawing index)	Garmong		2/7/2022	ADDN 01
16	A400 (not in drawing index)	Garmong		2/7/2022	ADDN 01
17	S-012 (not in drawing index) S-301 (on drawing index, no physical drawings)S-302; S-303; SF-ALTD1-1; SR2D2; SR2F1 (not in drawing index)	Garmong		2/7/2022	ADDN 01 UPDATED DRAWI
18	C000 & C602 (not in drawing index)	Garmong		2/7/2022	ADDN 01
19	FS100; FS300; FS400; FS500 (not in drawing index)	Garmong		2/7/2022	ADDN 01 UPDATED DRAWI
20	P700; P701; P703 (not in drawing index)	Garmong		2/7/2022	ADDN 01 UPDATED DRAWI
21	E001; E010, E392D (not in drawing index)	Garmong		2/7/2022	ADDN 01
22	E011; E012; E013; E110; E391D (on drawing index, no physical drawings)	Garmong		2/7/2022	E010, E011 Included in Add
23	E500; E292D ; ES104D; ES204D; ES204D4 (on drawing index, no physical drawings)	Garmong		2/7/2022	ES104D and ES204D were in
24	ES101A; ES301; ES302; ES303; ES401; ES402 (not in drawing index)	Garmong		2/7/2022	ADDN 01 UPDATED DRAWII
25	Would it be possible to get the CAD drawings for the Knox County Justice Campus project in order to establish cut & fill?	Wabash Utilities	2/8/2022	2/9/2022	This can be released to con
26	RQAW Specification 11 19 00 Detention Contractors - indicates to submit a bid to the General Trades Contractor - BP #07 is a stand alone package for the Detention Equipment scope of work.	Garmong		2/9/2022	ADDN 02
				l	



ion
/ING COVER SHEET , Addendum #2 added S-301
/ING COVER SHEET
/ING COVER SHEET
Idendum #2. E013 and E391D will be omitted.
included issued with original set.
/ING COVER SHEET
ntractor once bids are awarded.

Bid Question Log Project Name: Knox County Justice Center March 8, 2022 Date:

27	Section 033000 Cast in Place-Concrete Rev_1 shows precast items and structures. Nothing on Concrete Mix designs usually show aggregate requirements, Minimum cement, admixtures, Water Cement ratios, Slump requirements. (<i>specifications provided are section 33 05 13 "Manholes & Structures</i>)	Jones & Son	2/9/2022	2/9/2022	See 03-30-00 page 4 for agree information
28	Storm drainage for Unit "F" (building roof drains) does not appear to be indicated, on either C300 or C400	Garmong	2/9/2022	2/9/2022	updated in Addendum #2
29	Civil Drawings for Unit D Alternates - have not been provided (erosion control, sanitary, storm, grading etc)	Garmong	2/9/2022	2/9/2022	This will be added in Addendu
30	ES302 indicates Room 1515 as IT Room - floor plans indicate 1515 as a Restroom (IT appears to be Room 1514)	Garmong	2/9/2022	2/9/2022	Addendum #2; Room should b
31	Security systems for Unit A land at SQE #06 in the existing IT Room, and then to SQE #01 in Room 2603 (new IT Room at Unit D - Level II) - will Unit "A" Security and other area systems remain operable - without SQE #01 complete and operable ?	Garmong	2/9/2022	2/9/2022	Addendum #2; New field devic systems in Unit "A" shall not b head-end at SQE#6 shall be up
32	Sanitary site piping: please confirm depth of existing manhole, which new Unit D / F pipe runs are indicated to tie into - has sufficient depth for pipe runs (Previous project installing site contractor has indicated the existing manhole is shallow (less than 36")) New sanitary piping will cross multiple existing utilities	Wabash Utilities	2/10/2022	2/10/2022	Conflicts were resolved in add
33	Drawing AF 1A1 Note 11 references Drawing A401 for Book In Counter details (Drawing A401 is stair details)	Garmong	2/10/2022	2/11/2022	Note #11 should refer to A 404
34	Unit "A" foundations vs. interior / exterior slabs are indicated in different locations , at the overhead door locations. Structural drawings indicate the exterior slab pours over the foundation entirely vs Architectural indicates the interior slab pouring completely over the foundation	Garmong	2/11/2022	2/11/2022	Provide slab on grade as per th
35	Drawing SF 1A1 contains the foundation schedules - there is no indication for 8W1, 8W2 etc., which are continuous foundations at the interior / exterior areas on several units.	Garmong	2/11/2022	2/11/2022	See 06/S-012 for CMU Wall Re
36	Drawing SR1A1 contains many section cuts referenced to Drawing S301 (no S301 drawing has been issued)	Garmong	2/11/2022	2/11/2022	S-301 was part of the bid pack addendum #2
37	"Shackle Rings" are indicated at concrete benches - please provide specifications	Garmong	2/11/2022	2/11/2022	See 2B/A-405 for detail, no spo
38	RE: Insulation indicated on detail pages shows 4" R-13 in the roof and walls but the spec pages have R- 30 simple saver roof and 6" walls. Which one is correct?	Service Partners	2/15/2022	2/15/2022	All PEMB walls are min R-13 a



agreegate requiremnts. See section 2.2 page 8 of -3-30-00 for mix design

lendum #2

build be labeled as 1514 on drawing ES302.

I devices for Unit "A" to terminate to SQE#3 and SQE#4. Functionality of not be dependent on SQE#1 being complete and operable. Controls be updated to integrate with new controls at SQE#3 and SQE#4.

n addendum #3

A 404

per the structural drawings.

all Reinforcement Schedule

I pack. If it is missing in the prints, it will be provided as part of

no specification needed

-13 and roofs are R-19 (no simple saver system)

39	Site Layout drawing indicates 6" curb on the west side of the drive (north side of Salleyport). Grades appear to indicate a low point, with water run off towards the west - an opening in the curbing would be needed for water passage	Garmong	2/16/2022	2/16/2022	Addressed in addedum #2
40	No site curbing is indicated at the asphalt paving edge / landscape area immediately east of the Salleyport. Given traffic flow radius, should curbing be placed to prevent driving into the landscape area ?	Garmong	2/16/2022	2/16/2022	Addressed in addedum #2
45	Civil Drawings are not included for Alternate "A" (Day Room 1533 & Cell Area)	Garmong	2/16/2022	2/16/2022	This will be addressed in Ac
46	RULE 5 / CSGP - has RQAW Team applied and paid fee for Erosion Control / NOI ?	Prebid BP Contractor	2/17/2022	2/17/2022	In coordination
47	Drawing C001 "Erosion Control" Note #12 - this note conflicts with requirements indicated on Drawing C400 / Note "G"	Garmong	2/17/2022	2/17/2022	The note will be update in a
	Raw Water, Unit A - Main piping incomplete lines. Where does it come from?	HG Heinz	2/17/2022	2/17/2022	Corrected in Addendum #3
48	Hot water piping to TMV and isolation pods in unit A. Line sizes don't make sense.	HG Heinz	2/17/2022	2/17/2022	Corrected Addendum #2.
49	Shower valve adjacent to room 1510. No fixture specified.	HG Heinz	2/17/2022	2/17/2022	Added to plumbing fixture
50	Detail 8 on P802 - does this apply to both mechanical rooms in units A & D?	HG Heinz	2/17/2022	2/17/2022	Corrected in Addendum #3
51	Is there a water softener in unit A or D mechanical room? Not shown on enlarged mech room drawings. Where is RM # D109?	HG Heinz	2/17/2022	2/17/2022	Water Softener for Unit F. C
52	Is there a booster pump in Unit A or D mechanical room? Not shown on enlarged mech room drawings.	HG Heinz	2/17/2022	2/17/2022	Booster pump is an alterna
53	No booster pump on plumbing schedule	HG Heinz	2/17/2022	2/17/2022	Booster pump is an alterna
54	3" gas in mechanical room unit A? Where does this come from?	HG Heinz	2/17/2022	2/17/2022	Gas goes up to roof. Correc
55	4" gas line in unit D? Where is this going?	HG Heinz	2/17/2022	2/17/2022	4" gas line comes from the
56	Gas isometric and plumbing drawings don't match. Where is tie-in to existing gas located at?	HG Heinz	2/17/2022	2/17/2022	4" gas line comes from the
57	CFSH-5 on drawings not shown in fixture spec	HG Heinz	2/17/2022	2/17/2022	Corrected in Adddendum #
58	P100- The grease interceptor outside is hashed out as if it were being demoed. Is this correct? If so, is it being replaced?	Altstadt / Hoffman	2/17/2022	2/17/2022	Grease trap is existing to re
59	P110- Note 5 says sinks and piping to remain, but they are not on P210B	Altstadt / Hoffman	2/17/2022	2/17/2022	Corrected Addendum #2.
60	P210A- There are TMV's with ½" pipe coming off of them and are running to several fixtures that are ¾" drops. Is this size correct?	Altstadt / Hoffman	2/17/2022	2/17/2022	Corrected Addendum #2.



2
2
Addendum #2
n addendum #2 to reflect that no cut will be removed from the site
ŧ3.
e schedule. Corrected in Addendum #3.
/ 3.
. Corrected in Addendume #3.
nate bid . Corrected in Addendum #3.
nate bid. Corrected in Addendum #3.
ected in Addendum #3.
e existing gas main in Unit C corridor. Corrected in Addendum #3.
e existing gas main in Unit C corridor. Corrected in Addendum #3.
#3.
remain. Corrected Addendum #2.

61	P210D- Where does the water for Building D originate from?	Altstadt / Hoffman	2/17/2022	2/17/2022		An existing capped 4" dome connections in the existing
62	P210F- Rm 178, is the one toilet with the larger stall supposed to be handicapped?	Altstadt /	2/17/2022	2/17/2022		Yes
63	P210F- There is a prep sink in rm 144, who's responsible for that?	Altstadt / Hoffman	2/17/2022	2/17/2022		Yes, the plumbing contracto
64	P220D- Where does the 4" gas main terminate in Restroom 2606A	Altstadt / Hoffman	2/17/2022	2/17/2022		Corrected in Addendum #3
65	(Question #9) P220F- What size are the risers for domestic water to the 2nd floor? Note 7 says 1" for hot and cold, but this is feeding 3" and 2" mains on the 2nd floor.	Altstadt / Hoffman	2/17/2022	2/17/2022		Corrected in Addendum #3
66	P500- Drawing 1, Where do the water pipes go outside of the doors? Are they underground?	Altstadt / Hoffman	2/17/2022	2/17/2022		Corrected in Addendum #3
67	P500- Drawing 1, Where does the 3" gas come from?	Altstadt / Hoffman	2/17/2022			Gas piping goes to the roof.
68	P500- Drawing 3, Pipe sizes in this room, are they correct? Refer to my number 9 question	Altstadt / Hoffman	2/17/2022			Corrected in Addendum #3
69	P600- I do not find anything for roof drains, and there are several fixture abbreviations throughout the job with the number being X. None of these are in the schedule (TMV and ST are a couple).	Altstadt / Hoffman	2/17/2022	2/17/2022		Refet to specification section HW Storage Tank Schedule
70	Will there be Civil drawings showing the Hydronic piping to building F?	Altstadt / Hoffman	2/17/2022	2/17/2022		hydronic piping called out i
71	Alternates for D1-3: Can you color code a drawing for separating the piping between each one?	Altstadt / Hoffman	2/17/2022			Can not be provided at the
72	Is there a special type of caulking for the correctional fixtures?	Altstadt / Hoffman	2/17/2022	2/17/2022		See spec 07 92 00. Anywhe is required. If movement is
73						
74	RQAW Specification Index: 036020 Non-shrink grout (specification issued 036200)	Garmong	2/17/2022	2/17/2022		Both 03 60 20 and 03 62 00
75	RQAW Specification Index: 090100 Maintenance of Finishes (specification issued 090111)	Garmong	2/17/2022	2/17/2022		Corrected Addendum #2
76	RQAW Specification Index: 087110 Door Hardware Schedule (section not included in specifications)	Garmong	2/17/2022	2/17/2022		Corrected Addendum #2
77	RQAW Specification Index: 101423 Room Indentification Signage (specification issued 10.14.23.13)	Garmong	2/17/2022	2/17/2022		Corrected Addendum #2
78	RQAW Specification Index: 105113 Metal Wardrobe Lockers (duplicate spec section with Metal Lockers)	Garmong	2/17/2022	2/17/2022		Corrected Addendum #2
79	RQAW Specification Index: 096723 Resinous Flooring (not in specification book)	Garmong	2/17/2022	2/17/2022		Removed from Spec Index,
80	RQAW Specification Index: 220502 Selective Demolition (not in specification book)	Garmong	2/17/2022	2/17/2022		Added in Addendum #3
81	RQAW Specification section 282300 ("End Of Section" indicates 282320)	Garmong	2/17/2022	2/17/2022		Corrected in Addendum #3
82	RQAW Specification Section 270526 - appears to be missing part of the specification	Garmong	2/17/2022	2/17/2022		Formatting issue. Corrected
83	HRC chiller module included in bid? Shown on chiller schedule but M500 shows it is for future. If it is not to be included in bid are recirc pumps and lines needed?	HG Heinz	2/18/2022	2/18/2022	2/21/22	HRC-1 module is included in HRCs if the owner needs ad hot water and chilled water
84	Where is DOAS-D2. Only one DOAS is shown in D on first floor.	HG Heinz		2/18/2022	2/21/22	DOAS-D2 is located in the a M291D, M390D, and M391
85	North roof drain piping in Unit F not shown	HG Heinz	2/18/2022	2/18/2022		Drains tie together & route
86	Duplex booster pump in Unit F mechanical room?	HG Heinz	2/18/2022	2/18/2022		Booster pump is an alterna
87	Pipe sizes in Unit F mech room detail are smaller than lines throughout the building. Review pipe sizes.	HG Heinz	2/18/2022	i		Corrected in Addendum #3
88	SK-X in Unit F not shown on fixture schedule	HG Heinz	2/18/2022	2/18/2022		Fixture is SK-5. Corrected in



omestic water main was provided near Secure Corridor 1300 for future ng design. Corrected in Addendum #4.

ctor. Corrected in Addendum #4.
¥3.
¥3.
#3 .
of. Corrected in Addendum #3.
¥3.
tion 22 14 00 for roof drain specs. ST (storage tanks) are listed on the le.
t in addendum #3 - refer to mechanical drawings for additional detail
ne time.
here inmates will have access to, Dynapoxy "pick-proof" security sealant is expected, Dynaflex is required.
00 are included in set. Error in index only for 03 62 00
x, Addendum #2
#3
ed in Addendum #3
d in the bid. The note on M500 indicates allocating space for (2) future additional capacity when the existing HVAC system is placed on the new ter plant.
e alternate buildout of the Pod in unit D. Refer to drawings M290D, 91D.
tes down in chase at RR123 below f.f. Corrected on Addendum #4.
nate bid. Corrected in Addendum #3.
¥3.
in Addendum #3.

	Door 1505 is shown as 36" - is this sufficient for passage from the Salleyport into Booking (handcuffed					The following doors are to 1511.1, 1511.2, 1511.5
89	person + law enforcement)	Garmong	2/18/2022	2/18/2022		
	Looks like footers on P200F with pipes going through or under them. There will be a minimum of a 2'	Altstadt /				
	drop from the farthest point south to the exit of the building with these drains. How thick are the	Hoffman				
90	footers?		02/21/2022	02/21/2022		Corrected in Addendum #3
	There are several fixtures not in schedule- WC-3, LV-2 FV-1, TMV-x, YCO, SK-X, RD-1 & 2, F-WF-2, F-	Altstadt /				
 91	HWRP-2	Hoffman	02/21/2022	02/21/2022		Corrected in Addendum #3
		Altstadt /				
 92	Are the washer/dryer units by owner? Also not on schedule	Hoffman	02/21/2022	02/21/2022		Yes, By owner
		Altstadt /				
 93	P210F has CFC-7 in observation 141, P500 calls it to be CFC-2	Hoffman	02/21/2022	02/21/2022		Corrected in Addendum #3
		Altstadt /				
 94	P500, mixing valve not labeled	Hoffman	02/21/2022	02/21/2022		Corrected in Addendum #3
		Altstadt /				
 95	P500 #2 Unit C water heater equipment, none of this is on schedule	Hoffman	02/21/2022	02/21/2022		Corrected on Addendum #3
		Altstadt /				
 96	P802 #4: where is this system? And is there a booster pump?	Hoffman	02/21/2022	02/21/2022		Booster pump is an alterna
		Altstadt /				
 97	P805 has fittings darkened, nothing in the plumbing system is pre-fabbed is it?	Hoffman	02/21/2022	02/21/2022		Only fixtures/equipment is
						General Trades contractor
 98	Who provides mechanical equipment foundations / pads ?	HG Heinz	02/21/2022			equipment
	We are looking at bidding some section on this project. One of them being the casework / millwork. The					
	spec would indicate that the casework would be commercial grade div 12 casework but the finish plans	Lee Company	02/21/2022	02/21/2022		
	make reference to aristocrat cabinetry. The elevations would also indicate that the cabinet would have					Submit Alternatives to Arch
99	face frames and framed doors. Can you clarify what is to be provided?					and Door Styles as called o
	Note 36 calls for existing 24x24x72 lockers. where are these coming from? The demo plans do not show			00/04/0000		
100	any lockers coming out of the existing building. What package is responsible for relocation /	Lee Company	02/21/2022	02/21/2022		Owner is responsible for re
 100	reinstallation of these lockers?					contractor.
101	Should note 35 read 12x12x72 3 tier locker? The elevations clearly show these as 12x12x72 triple tier	Lee Company	02/21/2022	02/21/2022		Ver there below and (2) th
 101	lockers.					Yes, these lockers are (3) th
102	How many tiers are the note 34 lockers? The note just says 15x18x72 Locker. Is this the type A locker	Lee Company	02/21/2022	02/21/2022		This is a single tion looker. T
 102	shown on Sheet A500?					This is a single tier locker.
	The spec section 105113 does not match what the architect has detailed on the drawings. The specs	Lee Company	02/21/2022	02/21/2022		
103	would indicate all of the lockers are a first responder type locker but none of these are shown or detailed on the documents		02/21/2022	02/21/2022		Lockers are not first respon
 105	detailed on the documents. On the one-line(s), sheet E700 and E701, there are a handful of panels shown mounted on a pad. The					
	panel schedules for these show that the amperages of these panels range between 400A-800A, with					
	smaller amperage feeder breakers also, therefore we could quote these are a power panel or even our					
	standard lighting panel product. The concern I have is that our power panel product does not offer feet	AJ Baker	02/21/2022	02/21/2022		
	to be able to free-stand on a pad, the enclosures would need to be bolted to the wall for support.					
104	Would this be acceptable or are you looking for more of a switchboard type?				2/28/2022	Pad or Surface mounted ar
		L	I	L	-, -0, 2022	



to be changed from 36" to 42" in addendum #4: 1114, 1115.1, 1505,

13.	
13.	
ł3.	
13.	
#3	

nate bid. Corrected in Addendum #3.

is pre-fabricated by the cell manufacturer. All piping is detailed on site. or will provide all interior / exterior pads & foundations - for all MEP

rchitect with color samples that match Aristokraft Finishes, Face Frames, I out on Finish Schedule.

relocating and installing existing lockers. New lockers installed by

three tier lockers.

The detail 1A/A-500 is incorrect.

onder type.

2/28/2022 Pad or Surface mounted are both acceptable. Addressed via Addendum #3.

	105	A few of the panel schedules (1HEM1, 1HEM3, 1HEMDP1, 1HLRDP1, 1HNDP1, 1HOPDP1,1LEMDP1) call for the main breaker to be 100% rated and be individually mounted. We can do this for the necessary power panels by making our main breaker vertically mounted, so I do not see an issue here. But if we quoted panels 1HEM1 and 1HEM3 as a power panel, I feel it would be overkill on size and cost due to these panels being rated 100A with 20A/1P feeder. Can you advise if this is a typo or do they need to have 100% rated mains and have the mains individually mounted?	AJ Baker	02/21/2022	02/21/2022		Addressed via Addendum #
	106	Switchboard 1HSNB1 – on the one-line this switchboard shows as 3 sections, in which 1 of the sections feeds (4) ATS and each of these ATS are 1600A. On this switchboard schedule there is no feeder breakers listed to feed these. Can you advise if a revision needs to be made and what amperage of feeders are necessary ?	AJ Baker	02/21/2022	02/21/2022		Addressed via Addendum #
	107	Switchboard 1HEMSB1 – running into the same concerns as 1HSNB1	AJ Baker	02/21/2022	02/21/2022		Addressed via Addendum #
	108	Unit F One-Line, Sheet E701 : Missing amperages on panel schedules for CDHEM1 and CDHOP1, Panel schedule is empty with no feeder breakers for C1LEM1	AJ Baker		02/21/2022		Addressed via Addendum #
	109	Under BP 2 Scope of work it states that temporary roads and snow removal is to be included but under 015000 Temporary Facilities and Controls B. 1. it states that snow removal and temp access shall be included as part of BP 1. Could you please clarity?	Kerns	02/21/2022		2/21/2022	Follow BP #2 narrative, a cla
	110	Does the paving near the Sallyport have to be done in phases or will it be available all at the same time?	E&B Paving	2/21/2022		2/21/2022	Include (2) Mobilizations - (existing
	111	Where does vent pipe for unit D alternates terminate? No vent main shown on mezzanine or isometric.	HG Heinz		2/23/2022		One 4" vent main shall term
	112	Mechanical piping mains in alternates D2 and D3 will be required to finish classrooms 1641 & 1649.	HG Heinz		2/23/2022	2/28/22	Piping to VAV-D1-10 to serv Alternate D2 and D3 will ha ductwork mains. The ductw Alternate D1 is accepted.
	113	Should all mechanical piping and equipment in alternate D be in the base bid to maintain space temperature if alternates D1-D3 are not taken?	HG Heinz	2/23/2022	2/23/2022	2/28/22	FCU-D4 and FCU-D5 are pro
	114	Are there MEP plans for alternates A & C, building out day rooms? Will there be MEP work if alternates are taken?	HG Heinz	2/23/2022	2/23/2022	2/28/22	The MEP build out for Alter discipline. The MEP build ou 390s, and 490s.
	115	Domestic water drops in unit F on the 2nd floor are smaller than pipe sizes shown on enlarged drawing P501. Verify drop sizes.	HG Heinz	2/23/2022	2/23/2022		Corrected In Addendum #3
ľ	116	Fixtures not labeled detail #7 plan P500	HG Heinz		2/23/2022		All fixtures tagged. Correcte
ľ	117	What is the sink in meal prep 144?	HG Heinz		2/23/2022		2-Compartment sink (CS-1)
Ì	118	Gas line size in unit F mechanical room is different on isometric and detail drawing.	HG Heinz		2/23/2022		Correct sizing on isometric.
	119	Duke Power Transformer Requirement- must be within 10' of access road (for transformer replacement). Please include this notation on the site electrical drawing.	Garmong		2/23/2022	2/28/2022	Electrical Site Plan includes
	120	Are supports need for toilet partitions or are they floor mounted? If ceiling mounted are they in our scope?	Waukegen Steel	2/23/2022	2/23/2022		Please confirm - floor moun required overhead)
	121	RE: the fire alarm system at the Knox County Justice Campus. In the spec is says this is a new system, but on the plans its says fire alarm system is existing and will be extend into the additions. Can you tell me which one is true? And what the existing system is?	Midwest Security Solutions	2/24/2022	2/24/2022		(Existing F/A Drawings were
	122	Where is the connection point, to tie onto the existing Fire Sprinkler systems for the new additions?	Southwestern Sprinkler Services	2/24/2022	2/24/2022		Unit B sprinkler main shall t the existing sprinkler main.
	123	Per SF1D1 at the following column lines(P.9/11.4, P.9/16, P.9/19.7) the column in question is not sized. Is it possible these are to be furnished by the pre-engineered building provider?	Geiger & Peters	2/24/2022	2/24/2022		These columns are in the sc



n #3
n #3
n #3
n #2 & #3
a clarification as part of Addn #03 for 015000 will be issued
s - (1) for placing base / binder & (1) for mill (if required) / top of new and
erminate to the roof at each Alternate if accepted.
erve classroom 1641 is in the base bid. The piping mains shown in have to be routed if Alternate D1 is accepted. This also applies to the ctwork mains shown in Alternate D2 and D3 will have to be routed if l.
provided in Alternate D to temper the buildout area.
ternate A are shown on the callouts on the Unit A plans for each d out for Alternates D-D4 are shown on the alternate sheet series 290s,
#3 & #4.
ected in Addendum #3.
-1) by plumbing contractor. Corrected in Addendum #4.
ric. Corrected in Addendum #4.
des notes to coordinate exact location with Utility.
ounted toilet partitions / over head braced (no structural steel support is
rere included in Addn #03 "For Reference Only")
all be extended to new Unit A. Unit D requires a new sprinkler riser off in.
e scope of PEMB Vendor

124	As a follow-up on SF1D1would the following column locations also be provided by others? Ref: R14, R19, S19.	Geiger & Peters	2/24/2022	2/24/2022	These columns are in the so
		Southwestern			
		Sprinkler	2/24/2022	2/24/2022	
125	Drawing F-800, the jail zone risers detail for unit -F? I don't see any cell areas on my F drawings?	Services			Unit F does not have cells.
	Looking through addendum #2 civil plans and there is a note on C300 for a sanitary lift station. Can more	Koberstein			Detail for lift pump/station
126	detail be provided on this	Contracting	2/25/2022	2/25/2022	electrical drawings for addi
120	4/S-301 shows kickers and new deck where Units A and B meet, HSS kicker is welded to every joist but	Waukegen			
127	there is no joist spacing indicated. Is there structural drawings for the existing building?	Steel	2/25/2022	2/25/2022	See existing jail as-builts att
	Area D has two columns that are not called out, I'm guessing they're HSS5 x 5 x 5/16? See SF1D1,	Waukegen	2/25/2022	2/25/2022	
128	SR1D1, and SF Alt D1-1, 10.1 Line at U.2 & V.7.	Steel	2/25/2022	2/25/2022	YES - HSS 5x5x5/16 is correct
		Waukegen	2/25/2022	2/25/2022	YES - BP #01 should include
129	Structural Detail 8/S3.00 shows a ¼" x 6" x 6" plate with girt, does this belong to BP #1?	Steel	2/23/2022	2/23/2022	
	Zinkan Enterprises/Chem Ready (a water treatment company) reviewing the Knox County Justice				
	project. The Plans mention a 4,200 gallon heating system and 4,500 gallon glycol chill loop. There isn't				
120	anything in the specs for water treatment. Usually Section 232513 HVAC Water Treatment. It will list	Zinkan	2/20/2022	2/20/2022	
130	chemical pot feeder to add corrosion inhibitor to the closed loop systems. It might mention an automatic glycol feed system for the glycol loop to maintain system pressure. Usually a 1-year chemical	Enterprises	2/28/2022	2/28/2022	23 25 13 Water Treatment
	treatment and service contract. I have attached some data sheets for items that are usually common for				
	these projects.				
	Is Note 3 on SR 1F1 included in steel shown on this drawing or is this for additional steel not shown? If	Waukegen	a /aa /aaaa	a (ao (ao ao	
131	not what is beam size and what walls and can a detail be provided?	Steel	2/28/2022	2/28/2022	Note 3 on SR1F1 refers only
	4/S303 detail shows continuous angle at Kane Screen - where is this located ? (Specification 11 19 10	Maukagan			
	indicates Detention Contractor provides angles at masonry and concrete - shouldn't this contractor also	Waukegen Steel	2/28/2022	2/28/2022	
132	provide these attachment angles at the stud framing, for their screen installation ?)	31221			Coordinate Kane Screen loc
		Geiger &	2/28/2022	2/28/2022	
133	Please provide the structural roof framing for the Unit A alternate.	Peters			See sheet SR ALT A1
	On A315 & A319 Section 1A there is steel framing called out above the security mesh. The notes refer to	Geiger &	2/28/2022	2/28/2022	
134	S-series drawings but there is no detail of this referenced material on structural drawings. Can a detail be provided to clarify?	Peters	2/28/2022	2/28/2022	See Detail 4/S303, Security
134	On A331 Section 1C: bent plate frame and razor ribbon - where in the document are these materials	Geiger &			Basis of Design Atkore Razo
135	specified ? Are these to be provided by the Detention BP ?	Peters	2/28/2022	2/28/2022	Stainless Steel
	Div 7 lists intumescent coatings as part of the project; however, I have not located which structural				
136	members are to be coated. Please clarify the need for intumescent. Also, is there a place that notes	Sherwin Williams	03/01/2022	03/01/2022	Intumescent coating is expe columns in stair ST01.
	which hour rating that you are looking for?	vvillariis			
	Item #2-Cooler/Freezer- On FS100-the schedule confirms to "Replace Door Panels & Light Fixtures", One				
	FS101-There isn't a note detailed on the schedule. There is also no information listed on the spec to				Item # 2 Cooler/Freezer has
137	confirm where modification work needs to be completed-Please advise.	Stafford Smith	3/1/2022	3/1/2022	project any longer.
	Item #4-Dry Storage Shelving Unit-On the drawing schedule on both FS100 and FS101 this item is				
138	showing as "Existing/Remain" but in the FS Spec it doesn't confirm this to be an "Existing/Remain" item.	Stafford Smith	3/1/2022	3/1/2022	New Item as specified in wr
	Please advised if this is to be a new or existing/remain item.		<u> </u>		· · · · ·
139	Item #21-Toaster-Please advise if this is to be a "Spare"	Stafford Smith	3/1/2022	3/1/2022	Any changes to the Item # 2
	Item #31.1-Chemical Storage Shelving Unit- On the drawing schedule on both FS100 and FS101 this item is showing as "Existing/Remain" but in the FS Spec it doesn't confirm this to be an "Existing/Remain"				
140	item. Please advised if this is to be a new or existing/remain item.	Stafford Smith	3/1/2022	3/1/2022	New item as specified in wr
	In reviewing the specifications, we are not finding any insurance limits that are required. Section 006216		5, 1, 2022		
	references a schedule of coverages, but we do not see where any where provided. 007300	Hannig			
141	Supplementary Conditions Article 11 references coverages, but no limits.	Construction	3/1/2022	3/1/2022	Specification 006213 will be



scope of PEMB Vendor

s. Unit D has cells.

on product info was added in addendum #3 sheet C603. Refer to ditional information

attached with Addendum #3 for Reference Only.

rect

de the 6"x6" plate, which is indicated along with the girt in the detail

nt For Closed-Loop Systems specification added in Addendum 4.

nly to the steel beams shown on the drawing.

location with Architectural.

ity Screen is called Kane Screen on Structural drawings. azor Ribbon, Maximum Security Application, NSN 5660-01-495-9534, 30in

xpected in areas where steel structure is in fire rated walls such as

has been corrected by the jail maintenance and this is not inlcuded in this

written specifications.

21 Toaster is not included in this project

written specifications.

be reissued with Addendum #04, indicating insurance limits

142	Need clarification on Thermal Insulation as it is specified in Bid Package #1 and Bid Package #6. Need to know which bid package it is to be included in and if It is both need clarification of what each bid	Wolfe Construction	3/1/2022	3/1/2022	BP #01 -All Exterior Envelo or BP 05 required for comp
142	package need to include SC-01 Sealed Concrete Floor : what is specification for this finish, and which bid package should it be	Wolfe	3/1/2022	3/1/2022	indicated to be provided by
E310B shows the following panels and transformer as existing H1B, T:2, L1B. However panels and transformers T1LEM3, LEM3, T1LOP3, LOP3, T1LN3 are shown in the storage room but not shown at all on the 1 line diagram. Also panel 1LN3 is shown in storage room but is shown as being fed from Panel Central		Construction Central State Construction	3/1/2022	3/1/2022	Will be addressed via Adde Will be addressed via Adde
145	Transformer labeled T-1LOPDP1, I believe this should be T-1LOP3 and the panel it's feeding is 1LOP3. Do you agree?	Lytle/ Skill Electric	3/2/2022	3/2/2022	Will be addressed via Adde
145	How do you want to handle the AIC ratings?	Lytle/ Skill Electric	3/2/2022	3/2/2022	Addressed via Addendum #
 146a	480/277V Switchboards – 65KAIC?	Lytle/ Skill Electric Lytle/ Skill	3/2/2022	3/2/2022	Addressed via Addendum #
146b	480/277V Distribution Panels – 65KAIC?	Electric	3/2/2022	3/2/2022	Addressed via Addendum #
146c	480/277V Branch Panels – 35KAIC?	Lytle/ Skill Electric	3/2/2022	3/2/2022	Addressed via Addendum #
146d	208/120V Distribution Panels – 42KAIC?	Lytle/ Skill Electric	3/2/2022	3/2/2022	Addressed via Addendum #
146e	208/120V Branch Panels – 22KAIC?	Lytle/ Skill Electric	3/2/2022	3/2/2022	Addressed via Addendum #
147	Civil Plans do not indicate riprap or any other erosion control construction, for the storm piping from Unit F, into the drainage pond. What is required ?	Garmong	3/2/2022	3/2/2022	Addendum #4
148	Does the owner expect placement, grading and compaction of excess cut from site(build a new berm)? Or will we only be stockpiling excess cut from site near the gun range berms?	S&G	3/2/2022	3/2/2022	Assume that the owner wo expand the berms that alre
149	Can you provide detail on lift station hatch?	S&G	3/2/2022	3/2/2022	The lift station detail was p
150	What, if any, materials cannot be placed on gun range berms? Can concrete, asphalt, waste stone from old laydown areas etc., be placed in the berm?)	S&G	3/2/2022	3/2/2022	The material placed on the concrete, waste stone, etc.
151	Can you provide specifications or drawings on the radio tower to be removed?	S&G	3/2/2022	3/2/2022	Tower will be removed by o reinforced with 3 antana st
152	Can you add the sanitary structures to the structure table? I can gather most info needed but there are no rim elevations that i can see on any sanitary structures.	S&G	3/2/2022	3/2/2022	A structure schedule for the in addendum 4.
153	Does the generator or transformer need to salvaged for the owner?	S&G	3/2/2022	3/2/2022	Refer to electrical drawings
154	Plans say "excess cut from site" to be placed on gun range berms. What is the definition of "excess cut from site"?	S&G	3/2/2022	3/2/2022	Excess cut refers to the exc
155	Will knox county require road bonds? We must drive a few miles down county roads to get to our dump site.	S&G	3/2/2022	3/2/2022	The county will wave road
156	Will garmong handle processing of procotors for aggregate?	S&G	3/2/2022	3/2/2022	See ADDENDUM #02
157	Mechanical Room Unit A : . TMV-1 size per spec is 2" inlet and outlet. / Drawing on P500 shows 2" CW inlet 2-1/2" HW inlet and 3" HW outlet	HG Heinz	3/2/2022	3/2/2022	2" H&CW inlet and 3" ou
158	P802 has a detail for Unit F Water piping system F. Is there a detail for Unit A mechanical room? What about a detail for Unit C mechanical room?	HG Heinz	3/2/2022	3/2/2022	Detail added. Corrected on
159	C-TMV-1 shown on P-500 with 3" HW outlet. No TMV's this size or this spec on plumbing schedule	HG Heinz	3/2/2022	3/2/2022	Lawler Model 805
160	Notes 2 & 3 on P220F show 1" CW drops. P501 shows 2" CW.	HG Heinz	3/2/2022	3/2/2022	Note 3 revised to show 2" of



elope Insulation, including foundations - except where indicated in BP 03, nposite roof system. BP 06 All interior insulation - excluding insulation by BP03

dendum #4.

lendum #4.	
lendum #4.	
#3	
#3	
#3	
#3	
#3	
#3	

would want the dirt to be placed, graded, compacted and seeded to lready exist on the site.

s provided in addendum 3

he berm should be limited to soil only. construction debris (asphalt, tc.) should not be placed on the berm.

by owner. Contractor to remove pad. Concrete pad is 5'x4' -5'-0" Deep a stubs.

the sanitary manholes that includes top of casting information included

ngs

excess dirt that might remain after all proposed grading is completed.

d bonds for this project.

outlet is correct.

on Addendum #4.

" cw & 1-1/4" hw drop. Correction on Addendum #4.

	Will hid package 2 he responsible for any damage to existing asphalt 2 PE: concerns about damage to		Γ			PD #11 Contractor is respon
161	Will bid package 2 be responsible for any damage to existing asphalt.? RE: concerns about damage to existing asphalt where it is being used as a construction entrance	S&G	3/2/2022	3/2/2022		BP #11 Contractor is respon to project construction (Ad
	Drawing C100 indicates removal of the existing Radio Tower is part of the construction project. Knox	543	3,2,2022	3,2,2022		Tower will be removed by a
	County Sheriff has indicated this is not included in the construction scope, and will be done via a	Garmong	3/2/2022	3/2/2022		reinforced with 3 antana st
162	separate contractor, hired by Knox County - please correct the notation on the project drawings	_				removed by owner. Contrac
163	P500 Mech Room C : Only 2 boilers shown on P500, 3 listed on the schedule and shown on M500	HG Heinz	3/2/2022	3/2/2022		Three boilers noted as on n
	P500 Mech Room C: Gas header for boilers shown as 4" on P500, gas isometric shows 2-1/2" @ 2.0 psi.					
164	Which is right?	HG Heinz	3/2/2022	3/2/2022		Gas piping corrected to ind
165	P500 Mech Room C : Gas line to water heaters shown as 3" on P500. Isometric shown 2-1/2" @ 2.0 psi	HG Heinz	3/2/2022	3/2/2022		Gas piping corrected to wa
166	P210D / P220D / P500: Where does 4" CW originate from? Note 25 in addendum 3 says up from roof.	HG Heinz	3/2/2022	3/2/2022		4" cw originates from an ex
						All fixtures are tagged acco
	Correction Fixtures Spec 22 46 00 - Unit D Alternate Housing Pod:Addendum 3 spec calls for base bid of					then all fixtures, devices, va
	unit D to be masonry construction with fixtures by plumbing contractor. Latest drawings P210D/P220D & P291D/P292D show fixtures that are called out to be by cell manufacturer. What fixtures are to be in					contractor. This applies to a plumbing fixtures in cells sh
167a	base bid of unit D and what fixtures are to be in alternate for unit D?	HG Heinz	3/3/2022	3/3/2022		cells) and all associated cor
1678 167b	Does any this apply to alternates D - D3?	HG Heinz	3/3/2022	3/3/2022		This applies to alternated la
1675 167c	Will there be base bids and alternate bids under each alternate D1, D2 and D3?	HG Heinz	3/3/2022	3/3/2022		Provide pricing for base bid
167d	Is there an updated list of alternates?	HG Heinz	3/3/2022	3/3/2022		Alternates will be updated
168	Should lockers in rooms 166 and 163 have addendum note 36 for existing owner provided lockers?	Lee Company	+ · ·	03/03/2022		Yes. Owner Provided Locke
168	Should lockers in rooms 100 and 105 have addendaminote so for existing owner provided lockers? Should lockers on west wall of 207 2nd floor unit F have note 34?	Lee Company				Yes. Note 34
	Should lockers on the south wall of 174 1st floor unit F have note 34?	Lee Company		03/03/2022		
170	Drawing E410B shows no fire alarm equipment in the kitchen area. Is there a drawing showing this		03/03/2022	03/03/2022		Yes. Note 34
171	equipment?	Weyer Electric	3/3/2022	3/3/2022		No fire alarm work in this a
172	Drawing E410C shows no fire alarm equipment. Is there a drawing showing this equipment?	Weyer Electric	3/3/2022	3/3/2022		No fire alarm work in this a
172	Specifications call for voice system but drawing symbols are for horn strobe devices. Which is correct?	Weyer Electric	3/3/2022	3/3/2022	3/7/2022	Fire Alarm System shall be
174	Specifications discuss aspirating smoke detection system. Is there any of these systems?	Weyer Electric	3/3/2022	3/3/2022	3/7/2022	No, will be removed from s
175	Drawing E491D shows no fire alarm equipment. Is there a drawing showing this equipment?	Weyer Electric	3/3/2022	3/3/2022		E491D does have work in the
	Specifications ask for 520hz sounders in sleeping areas. Day rooms have and standard horn only devices.					
176	Are these to be 520hz Horns?	Weyer Electric	3/3/2022	3/3/2022	3/7/2022	Dayrooms are not consider
. ==	Specifications ask for 520hz sounders in sleeping areas. Day rooms have and standard Smoke detectors.				o /= /o o o o	
177	Do these need to be 520hz sounder bases?	Weyer Electric	3/3/2022	3/3/2022	3/7/2022	Dayrooms are not consider
178	The plan indicates an existing system but does not identify what it is. Are they looking to replace the whole system or expand / reuse existing equipment and do you know what is there currently?	Weyer Electric	3/3/2022	3/3/2022		Refer to Addendum #04.
178	On the drawings there are area's with no indication of existing fire alarm devices or new devices. Unit C	Weyer Liectric	3/3/2022	3/3/2022		Neier to Addendari #04.
179	for example. What is the plan for those areas?	Weyer Electric	3/3/2022	3/3/2022		Existing to remain unless in
	Is floor slab in new Electric Rooms on Sheet E310D being removed to allow for new secondary feeder	,	, , <u> </u>			
	conduits/conductors from utility transformers & generators? If so, who is responsible for removal and					Yes, saw cut floor as require
180	replacement?	Weyer Electric	3/3/2022	3/3/2022		removal, replace is the resp
	On Addendum #3 there was to be a revised Sheet E700 per the written narrative, however upon	·				Refer to Addendum #04.
181	opening the Sheet E700 on the plan site, it opened to Page E603. Is there a revised E700?	Weyer Electric	3/3/2022	3/3/2022		
182	Specs make mention of a BIM modeling component for this project. Will BIM for all trades be required?	Weyer Electric	3/3/2022	3/3/2022		BIM removed from project
	On Sheet E210F, there are several rooms (Programming 117 and 125, Women's Locker 128, Men's					Waiting 120 Drug Test 122
	Locker 131, Waiting 121 & 129, Drug Test RR 122 & 130, Body Scan 120 , Meal Prep 144) that call out to					Waiting 129, Drug Test 122 docs set. The other spaces
	connect light fixtures to lighting control devices shown. No lighting control devices are shown in these					
183	connect light fixtures to lighting control devices shown. No lighting control devices are shown in these areas. Please provide clarifications as to how these lights are to be controlled.	Weyer Electric	3/3/2022	3/3/2022	3/6/2022	does set. The other spaces



oonsible for any repair, which is required to the existing pavement, due Addendum #02 clarification)

y owner. Contractor to remove pad. Concrete pad is 5'x4' -5'-0" Deep stubs. The existing air conditioner unit next to tower will also be ractor to remove 4" concrete pad.

n mechanical plan. Corrected on Addendum #4.

ndicate 3" gas header @ 5.0 psi. Corrected on Addendum #4.

vater heaters to indicate 1" gas @ 5.0 psi. Corrected on Addendum #4.

existing 4" capped connection from existing design in Corridor 1300 cordingly. Masonry construction is the basis of design and if selected valves, controls, sleeves, etc., shall be provided by the plumbing o alternated layouts D1-D3. If steel construction is accepted then all shall be by the cell manufacturer. All other plumbing fixtures (not in controls, devices, valves, sleeves etc. shall be by the plumbing contractor. I layouts D1-D3.

bid and alternates as described in documents

ed to include Booster Pump

kers

s area.

s area.

e a horn type system. Will be addressed via Addendum #04.

n spec. via Addendum #04.

this area. Refer to original bid documents.

ered sleeping areas.

ered sleeping areas.

indicated otherwise. Refer to Addendum #04.

uired for conduit/conductors. Replace where needed. (Floor x-ray, esponsibility of BP #10

ct scope by Addn #04

22 & 130, and Body Scan 120 all had controls shown on the original bid es will be addressed via Addendum #4.

ad all associated piping to be disconnected and capped in Staff RR 1317.

Bid Question Log Project Name: Knox County Justice Center March 8, 2022 Date:

		General note 10 on P100 states that "IT MAY BE NECESSARY FOR THE CONTRACTOR TO X-RAY					
	405	CONCRETE FLOORS TO DETERMINE EXACT LOCATIONS OF HIDDEN PIPING OR STRUCTURAL OBJECTS."		a /a /aaaa			YES
	185	Should the plumbing contractor include this cost in their proposal?	HFI Mechanical	3/3/2022	3/3/2022		
		On M001, HVAC Demolition General Note C states "THE MECHANICAL CONTRACTOR SHALL PERFORM					
		SERVICE AND REPAIR ON THE EXISTING EQUIPMENT AND ITS ACCESSORIES AS FOLLOWS: CLEAN ALL					
		COILS, REPLACE THE FILTERS AND BELTS, INSPECT, REPAIR, OR REPLACE THE ECONOMIZERS, DRIVES					Disregard General Note C on M001. T
	186	AND FAN BEARINGS, MOTORS, CONTROL COMPONENTS, VALVES AND ANY OTHER ITEM NECESSARY FOR A COMPLETE AND PROPER OPERATING SYSTEM. THIS CONTRACTOR SHALL ALSO VISIT THE SITE,	HFI Mechanical	3/3/2022	3/3/2022		INCLUDE ANY COSTS OR ALLOWANCES
	100	PRIOR TO FINAL BIDDING, AND VERIFY ALL EXISTING SITE CONDITIONS. PROVIDE ALL MATERIAL AND		5/5/2022	3/3/2022		SPECIFIC TO NOTE M001)
		COMPONENTS AS NEEDED TO BRING THE UNITS TO FULL COMPLIANCE OF THE LANDLORD'S CRITERIA					
		AND LOCAL AUTHORITY HAVING JURISDICTION." Can you provide a complete list of equipment with					
		manufacturer and model # for each?					
		What bid package is responsible for the buried HHW/CHW piping running between buildings D and F			- /- /		BP #09 should include this site piping -
	187	shown on both mechanical and site drawings?	HFI Mechanical	3/3/2022	3/3/2022		hookup
		After reviewing the documents, we believe that the best option for BIM coordination is to fully					
	188	coordinate the new areas A, D, and F, including the mechanical room in area C, but field coordinate the	HFI Mechanical	3/3/2022	3/3/2022		BIM removed from project scope by A
		existing areas B and C. Please advise if this is acceptable.					
							Existing Building As Build Drawings we
	189	No fire alarm drawings for area E. Is there drawings for this area?	Weyer Electric	3/3/2022	3/3/2022		drawings (Drawings indicated as "For
		Will primary conduits be required to new utility transformer for Community Corrections? None shown					
	190	on electrical site plan or Civil Drawings.	Weyer Electric	3/3/2022	3/3/2022		Primary conduits by Duke energy.
		Note 9 on Sheet E010, calls for $(2) - 4''$ Conduits to extend to property line, but sheet shows them					
		stopping just outside the building. Can you provide clarification as to where these terminate? If to a					
	191	property line, which line and where at on the line as it will affect our conduit footage?	Weyer Electric	3/3/2022	3/3/2022	3/7/2022	Please coordinate with owner's teleco
	192a	Spec Section 00 54 36 - Building Information Modeling: Is this spec section being used? If yes, see below	HG Heinz	3/3/2022	3/3/2022		BIM removed from project scope by A
	192b	To what extent is the design team's construction model complete?	HG Heinz	3/3/2022	3/3/2022		BIM removed from project scope by A
	192c	What LOD is the design teams model?	HG Heinz	3/3/2022	3/3/2022		BIM removed from project scope by A
	192d	Will you give your model to the contractors to make adjustments?	HG Heinz	3/3/2022	3/3/2022		BIM removed from project scope by A
		How much of the model is incomplete for the MEP contractor to finish -ie. To what extent are the items					
		listed under section 3.4 of the spec complete by the design design team prior to construction? What					BIM removed from project scope by A
	192e	items and in what quantity will remaining items of section 3.4 need to be completed?	HG Heinz	3/3/2022	3/3/2022		
			Hannig				
	193	Pre-Engineered Building - is erection part of BP # 4 ?	Construction	3/7/2022	3/7/2022		PEMB complete (material / erect) is er
		Questions regarding Unit D building: More specifically the area on the high side looks to extend beyond					
		the main frame and then there is some masonry wall as well as some columns that may be part of PEMB					
		but may not be PEMB. A201 detail 1A is building section / Blow up is 3A and A313 - Looks like main					No specific metal building company w
		single slope frame goes to Column Line 10, then large masonry wall is at Column Line 9, then lower roof					indicated or similar in design
	404	framing at Column Line 8.5 (The section appears to extend PEMB Roof/siding to beyond (and bear) on	Hannig	2/7/2022	2/7/2022		
\vdash	194	the masonry wall.) Did RQAW worked with any specific Metal Building Company in the design of this?	Construction	3/7/2022	3/7/2022		
	105	Spec Section 21 13 13 :2.7 Nitrogen Generating System - Will two nitrogen systems be required, one for	Tri-State Fire	2/0/2022	2/0/2022		Vee one in Unit D and and in Unit 5
	195	each building?	Protection	3/8/2022	3/8/2022		Yes, one in Unit D and one in Unit F.



C on M001. This note will be deleted in the Construction Set. (DO NOT ALLOWANCES FOR SERVICE OR REPAIR OF EXISTING EQUIPMENT -

is site piping - as a complete system, Unit F to Unit D to equipment

ct scope by Addn #04

Drawings were included with Addn #03 - which do include the F/A cated as "For Reference Only"

wner's telecom vendor and provide as required, as per plan note.

ct scope by Addn #04

I / erect) is entirely included in BP #01

g company was used. Provide delegated design by PEMB, for areas sign

ADDENDUM #04

SECTION 00 42 00 SUPPLEMENTARY BID FORM

FOR (PROJECT):	Knox County Jail and Community Corrections Vincennes, IN 47591
TO (OWNER):	KNOX County Board of Commissioners 111 North 7 th Street, Vincennes, IN 47591

BY (CONTRACTOR):

COMPANY NAME:	
ADDRESS:	
CONTACT PERSON:	
MOBILE PHONE:	
EMAIL:	

Pursuant to notices given, the undersigned proposes to complete the Work of the Project according to Bidding Documents prepared by RQAW Corporation 328 N. Second Street, #304 Vincennes, IN 47591 for the sum of:

BID PACKAGE #:		BID PACKAGE DESCRIPTION:	
BASE BID:			\$
	(amount in wor	rds)	(numeric value)
COMBINATION BID PA	CKAGES #s:		
COMBINATION BASE BID:	-		\$
	(amount in wor	rds)	(numeric value)

This bid shall be valid for ninety (90) days.

Alternate bids continued next page.

ALTERNATE BIDS:

The undersigned also proposes to furnish or to omit all labor and materials necessary to complete work as required by the "Alternate Bids", as provided in the Drawings and Specifications as follows:

ALTERNATE A – BUILD-OUT OF DAYROOM 1533 AND SURROUNDING ISOLATION CELLS

	Add _\$
ALTERNATE B – BODY CAMERAS IN JAIL	
	Add/Deduct _\$
ALTERNATE C – DAYROOM 1614 & 1615 MODIFICATIONS (4	MAN CELLS IN LIEU OF DORMITORIES)
	Add/Deduct _\$
ALTERNATE D – SHELL SPACE OF HOUSING POD	
	Add/Deduct \$
ALTERNATE D1 – DAYROOM 1625, CLASSROOM 1649, EXPAND 1641, ADD STORAGE 1658, 1650	
	Add/Deduct _\$
ALTERNATE – D2 DAYROOM 1630 BUILDOUT	
	Add/Deduct <u>\$</u>
ALTERNATE – D3 DAYROOM 1635 BUILDOUT	
	Add/Deduct <u>\$</u>
ALTERNATE – E DUPLEX BOOSTER PUMP	Add/Deduct <u>\$</u>
NAMES AND EXPERIENCE:	
List names of the following and the years of experience in w Project:	ork comparable to the size and scope of Work of this
Job Superintendent:	
Years of Experience:	

KNOX COUNTY JUSTICE CENTER

ADDENDA:

The Undersigned acknowledges receipt of the following Addenda and agrees that this proposal includes all items mentioned in such Addenda:

No.

COMPLETION OF WORK:

The undersigned guarantees, if awarded the Contract, to complete the Work not later than the dates established in the Project Manual, or earlier date established by the Construction Manager's Schedule.

BIDDER'S SIGNATURE:

IN TESTIMONY WHEREOF, the Bidder (an individual) has hereunto set their hands this

	day of	20	
(Individual)			
N TESTIMONY WHEF	REOF, the Bidder (a firm) has hereu	unto set his hand this	
	day of	20	
Firm Name:			
Ву:			
Ву:			
	REOF, the Bidder (a Corporation) h l its corporate seal this	as caused this proposal to be signed by it	s President a
	day of	20	
Firm Name:			
President:			
Secretary:			

OATH AND AFFIRMATION:

I affirm under the penalties of perjury that the foregoing facts and information are true and correct to the best of my knowledge and belief.

Subscribed and sworn to before me by					
this	day of	20			
My Commission expires					

Notary Public

PART 1 - GENERAL

1.1 RELATED DOCUMENTS

A. Drawings and general provisions of the Contract, including General and Supplementary Conditions and other Division 01 Specification Sections, apply to this Section.

1.2 SUMMARY

A. Section includes administrative and procedural requirements for alternates.

1.3 DEFINITIONS

- A. Alternate: An amount proposed by bidders and stated on the Bid Form for certain work defined in the bidding requirements that may be added to or deducted from the base bid amount if the Owner decides to accept a corresponding change either in the amount of construction to be completed or in the products, materials, equipment, systems, or installation methods described in the Contract Documents.
 - 1. Alternates described in this Section are part of the Work only if enumerated in the Agreement.
 - 2. The cost or credit for each alternate is the net addition to or deduction from the Contract Sum to incorporate alternates into the Work. No other adjustments are made to the Contract Sum.

1.4 PROCEDURES

- A. Coordination: Revise or adjust affected adjacent work as necessary to completely integrate work of the alternate into Project.
 - 1. Include as part of each alternate, miscellaneous devices, accessory objects, and similar items incidental to or required for a complete installation whether or not indicated as part of alternate.
- B. Notification: Immediately following award of the Contract, notify each party involved, in writing, of the status of each alternate. Indicate if alternates have been accepted, rejected, or deferred for later consideration. Include a complete description of negotiated modifications to alternates.
- C. Execute accepted alternates under the same conditions as other work of the Contract.
- D. Schedule: A schedule of alternates is included at the end of this Section. Specification Sections referenced in schedule contain requirements for materials necessary to achieve the work described under each alternate.

PART 3 - EXECUTION

1.1 SCHEDULE OF ALTERNATES

A. ALTERNATE A – BUILD-OUT OF DAYROOM 1533 AND SURROUNDING ISOLATION CELLS

1. All costs associated with the build-out of dayroom 1533 and surrounding isolation cells.

B. ALTERNATE B

1. All costs associated with adding Body Cameras in the jail.

c. ALTERNATE C –

1. All costs associated with modifying Dayrooms 1614 & 1615, replace dormitories with 4-man cells.

D. ALTERNATE D –

All D alternates build on the previous one. (So if Alt D1 is accepted, Alt D must be accepted as well)

- D. Shell space of the additional half of the housing pod.
- D1. Build out Dayroom 1625, Classroom 1649, Expand classroom 1641, add storage 1658 & 1650.
- D2. Build out Dayroom 1630
- D3. Build out of Dayroom 1635

E. ALTERNATE E –

1. All costs associated with "Duplex Booster Pump Unit" – if city pressure is inadequate, and the booster pump is required to provide proper system operation.

SECTION 08 71 00

DOOR HARDWARE

PART 1 - GENERAL

1.1 RELATED DOCUMENTS

A. Drawings and general provisions of the Contract, including General and Supplementary Conditions and Division 1 Specification Sections, apply to this Section.

1.2 SUMMARY

- A. This Section includes commercial door hardware for the following:
 - 1. Swinging doors.
 - 2. Other doors to the extent indicated.
- B. Door hardware includes, but is not necessarily limited to, the following:
 - 1. Mechanical door hardware.
 - 2. Electromechanical door hardware.
 - 3. Automatic operators.
- C. Related Sections:
 - 1. Division 08 Section "Hollow Metal Doors and Frames".
 - 2. Division 08 Section "Flush Wood Doors".
 - 3. Division 08 Section "Aluminum-Framed Entrances and Storefronts".
 - 4. Division 08 Section "Automatic Door Operators".
 - 5. Division 28 Section "Access Control Hardware Devices".
- D. Codes and References: Comply with the version year adopted by the Authority Having Jurisdiction.
 - 1. ANSI A117.1 Accessible and Usable Buildings and Facilities.
 - 2. ICC/IBC International Building Code.
 - 3. NFPA 70 National Electrical Code.
 - 4. NFPA 80 Fire Doors and Windows.
 - 5. NFPA 101 Life Safety Code.
 - 6. NFPA 105 Installation of Smoke Door Assemblies.
 - 7. UL/ULC and CSA C22.2 Standards for Automatic Door Operators Used on Fire and Smoke Barrier Doors and Systems of Doors.

- 8. State Building Codes, Local Amendments.
- E. Standards: All hardware specified herein shall comply with the following industry standards as applicable. Any undated reference to a standard shall be interpreted as referring to the latest edition of that standard:
 - 1. ANSI/BHMA Certified Product Standards A156 Series.
 - 2. UL10C Positive Pressure Fire Tests of Door Assemblies.
 - 3. ANSI/UL 294 Access Control System Units.
 - 4. UL 305 Panic Hardware.
 - 5. ANSI/UL 437- Key Locks.

1.3 SUBMITTALS

- A. Product Data: Manufacturer's product data sheets including installation details, material descriptions, dimensions of individual components and profiles, operational descriptions and finishes.
- B. Door Hardware Schedule: Prepared by or under the supervision of supplier, detailing fabrication and assembly of door hardware, as well as procedures and diagrams. Coordinate the final Door Hardware Schedule with doors, frames, and related work to ensure proper size, thickness, hand, function, and finish of door hardware.
 - 1. Format: Comply with scheduling sequence and vertical format in DHI's "Sequence and Format for the Hardware Schedule."
 - 2. Organization: Organize the Door Hardware Schedule into door hardware sets indicating complete designations of every item required for each door or opening. Organize door hardware sets in same order as in the Door Hardware Sets at the end of Part 3. Submittals that do not follow the same format and order as the Door Hardware Sets will be rejected and subject to resubmission.
 - 3. Content: Include the following information:
 - a. Type, style, function, size, label, hand, and finish of each door hardware item.
 - b. Manufacturer of each item.
 - c. Fastenings and other pertinent information.
 - d. Location of door hardware set, cross-referenced to Drawings, both on floor plans and in door and frame schedule.
 - e. Explanation of abbreviations, symbols, and codes contained in schedule.
 - f. Mounting locations for door hardware.
 - g. Door and frame sizes and materials.
 - h. Warranty information for each product.
 - 4. Submittal Sequence: Submit the final Door Hardware Schedule at earliest possible date, particularly where approval of the Door Hardware Schedule must precede fabrication of other work that is critical in the Project construction schedule. Include Product Data,

Samples, Shop Drawings of other work affected by door hardware, and other information essential to the coordinated review of the Door Hardware Schedule.

- C. Shop Drawings: Details of electrified access control hardware indicating the following:
 - 1. Wiring Diagrams: Upon receipt of approved schedules, submit detailed system wiring diagrams for power, signaling, monitoring, communication, and control of the access control system electrified hardware. Differentiate between manufacturer-installed and field-installed wiring. Include the following:
 - a. Elevation diagram of each unique access controlled opening showing location and interconnection of major system components with respect to their placement in the respective door openings.
 - b. Complete (risers, point-to-point) access control system block wiring diagrams.
 - c. Wiring instructions for each electronic component scheduled herein.
 - 2. Electrical Coordination: Coordinate with related sections the voltages and wiring details required at electrically controlled and operated hardware openings.
- D. Keying Schedule: After a keying meeting with the owner has taken place prepare a separate keying schedule detailing final instructions. Submit the keying schedule in electronic format. Include keying system explanation, door numbers, key set symbols, hardware set numbers and special instructions. Owner must approve submitted keying schedule prior to the ordering of permanent cylinders/cores.
- E. Informational Submittals:
 - 1. Product Test Reports: Indicating compliance with cycle testing requirements, based on evaluation of comprehensive tests performed by manufacturer and witnessed by a qualified independent testing agency.
- F. Operating and Maintenance Manuals: Provide manufacturers operating and maintenance manuals for each item comprising the complete door hardware installation in quantity as required in Division 01, Closeout Procedures.

1.4 QUALITY ASSURANCE

- A. Manufacturers Qualifications: Engage qualified manufacturers with a minimum 5 years of documented experience in producing hardware and equipment similar to that indicated for this Project and that have a proven record of successful in-service performance.
- B. Certified Products: Where specified, products must maintain a current listing in the Builders Hardware Manufacturers Association (BHMA) Certified Products Directory (CPD).
- C. Installer Qualifications: A minimum 3 years documented experience installing both standard and electrified door hardware similar in material, design, and extent to that indicated for this Project and whose work has resulted in construction with a record of successful in-service performance.

- D. Door Hardware Supplier Qualifications: Experienced commercial door hardware distributors with a minimum 5 years documented experience supplying both mechanical and electromechanical hardware installations comparable in material, design, and extent to that indicated for this Project. Supplier recognized as a factory direct distributor by the manufacturers of the primary materials with a warehousing facility in Project's vicinity. Supplier to have on staff a certified Architectural Hardware Consultant (AHC) available during the course of the Work to consult with Contractor, Architect, and Owner concerning both standard and electromechanical door hardware and keying.
- E. Source Limitations: Obtain each type and variety of door hardware specified in this section from a single source unless otherwise indicated.
 - 1. Provide electromechanical door hardware from the same manufacturer as mechanical door hardware, unless otherwise indicated.
- F. Each unit to bear third party permanent label demonstrating compliance with the referenced standards.
- G. Keying Conference: Conduct conference to comply with requirements in Division 01 Section "Project Meetings." Keying conference to incorporate the following criteria into the final keying schedule document:
 - 1. Function of building, purpose of each area and degree of security required.
 - 2. Plans for existing and future key system expansion.
 - 3. Requirements for key control storage and software.
 - 4. Installation of permanent keys, cylinder cores and software.
 - 5. Address and requirements for delivery of keys.
- H. Pre-Submittal Conference: Conduct coordination conference in compliance with requirements in Division 01 Section "Project Meetings" with attendance by representatives of Supplier(s), Installer(s), and Contractor(s) to review proper methods and the procedures for receiving, handling, and installing door hardware.
 - 1. Prior to installation of door hardware, conduct a project specific training meeting to instruct the installing contractors' personnel on the proper installation and adjustment of their respective products. Product training to be attended by installers of door hardware (including electromechanical hardware) for aluminum, hollow metal and wood doors. Training will include the use of installation manuals, hardware schedules, templates and physical product samples as required.
 - 2. Inspect and discuss electrical roughing-in, power supply connections, and other preparatory work performed by other trades.
 - 3. Review sequence of operation narratives for each unique access controlled opening.
 - 4. Review and finalize construction schedule and verify availability of materials.
 - 5. Review the required inspecting, testing, commissioning, and demonstration procedures
- I. At completion of installation, provide written documentation that components were applied to manufacturer's instructions and recommendations and according to approved schedule.

1.5 DELIVERY, STORAGE, AND HANDLING

- A. Inventory door hardware on receipt and provide secure lock-up and shelving for door hardware delivered to Project site. Do not store electronic access control hardware, software or accessories at Project site without prior authorization.
- B. Tag each item or package separately with identification related to the final Door Hardware Schedule, and include basic installation instructions with each item or package.
- C. Deliver, as applicable, permanent keys, cylinders, cores, access control credentials, software and related accessories directly to Owner via registered mail or overnight package service. Instructions for delivery to the Owner shall be established at the "Keying Conference".

1.6 COORDINATION

- A. Templates: Obtain and distribute to the parties involved templates for doors, frames, and other work specified to be factory prepared for installing standard and electrified hardware. Check Shop Drawings of other work to confirm that adequate provisions are made for locating and installing hardware to comply with indicated requirements.
- B. Door Hardware and Electrical Connections: Coordinate the layout and installation of scheduled electrified door hardware and related access control equipment with required connections to source power junction boxes, low voltage power supplies, detection and monitoring hardware, and fire and detection alarm systems.
- C. Door and Frame Preparation: Doors and corresponding frames are to be prepared, reinforced and pre-wired (if applicable) to receive the installation of the specified electrified, monitoring, signaling and access control system hardware without additional in-field modifications.

1.7 WARRANTY

- A. General Warranty: Reference Division 01, General Requirements. Special warranties specified in this Article shall not deprive Owner of other rights Owner may have under other provisions of the Contract Documents and shall be in addition to, and run concurrent with, other warranties made by Contractor under requirements of the Contract Documents.
- B. Warranty Period: Written warranty, executed by manufacturer(s), agreeing to repair or replace components of standard and electrified door hardware that fails in materials or workmanship within specified warranty period after final acceptance by the Owner. Failures include, but are not limited to, the following:
 - 1. Structural failures including excessive deflection, cracking, or breakage.
 - 2. Faulty operation of the hardware.
 - 3. Deterioration of metals, metal finishes, and other materials beyond normal weathering.
 - 4. Electrical component defects and failures within the systems operation.
- C. Standard Warranty Period: One year from date of Substantial Completion, unless otherwise indicated.

- D. Special Warranty Periods:
 - 1. Ten years for mortise locks and latches.
 - 2. Five years for exit hardware.
 - 3. Ten years for manual overhead door closer bodies.
 - 4. Twenty five years for manual overhead door closer bodies.
 - 5. Five years for motorized electric latch retraction exit devices.
 - 6. Two years for electromechanical door hardware.

1.8 MAINTENANCE SERVICE

A. Maintenance Tools and Instructions: Furnish a complete set of specialized tools and maintenance instructions as needed for Owner's continued adjustment, maintenance, and removal and replacement of door hardware.

PART 2 - PRODUCTS

2.1 SCHEDULED DOOR HARDWARE

- A. General: Provide door hardware for each door to comply with requirements in Door Hardware Sets and each referenced section that products are to be supplied under.
- B. Designations: Requirements for quantity, item, size, finish or color, grade, function, and other distinctive qualities of each type of door hardware are indicated in the Door Hardware Sets at the end of Part 3. Products are identified by using door hardware designations, as follows:
 - 1. Named Manufacturer's Products: Product designation and manufacturer are listed for each door hardware type required for the purpose of establishing requirements. Manufacturers' names are abbreviated in the Door Hardware Schedule.
- C. Substitutions: Requests for substitution and product approval for inclusive mechanical and electromechanical door hardware in compliance with the specifications must be submitted in writing and in accordance with the procedures and time frames outlined in Division 01, Substitution Procedures. Approval of requests is at the discretion of the architect, owner, and their designated consultants.

2.2 HANGING DEVICES

- A. Hinges: ANSI/BHMA A156.1 certified butt hinges with number of hinge knuckles and other options as specified in the Door Hardware Sets.
 - 1. Quantity: Provide the following hinge quantity:
 - a. Two Hinges: For doors with heights up to 60 inches.
 - b. Three Hinges: For doors with heights 61 to 90 inches.
 - c. Four Hinges: For doors with heights 91 to 120 inches.

- d. For doors with heights more than 120 inches, provide 4 hinges, plus 1 hinge for every 30 inches of door height greater than 120 inches.
- 2. Hinge Size: Provide the following, unless otherwise indicated, with hinge widths sized for door thickness and clearances required:
 - a. Widths up to 3'0": 4-1/2" standard or heavy weight as specified.
 - b. Sizes from 3'1" to 4'0": 5" standard or heavy weight as specified.
- 3. Hinge Weight and Base Material: Unless otherwise indicated, provide the following:
 - a. Exterior Doors: Heavy weight, non-ferrous, ball bearing or oil impregnated bearing hinges unless Hardware Sets indicate standard weight.
 - b. Interior Doors: Standard weight, steel, ball bearing or oil impregnated bearing hinges unless Hardware Sets indicate heavy weight.
- 4. Hinge Options: Comply with the following:
 - a. Non-removable Pins: With the exception of electric through wire hinges, provide set screw in hinge barrel that, when tightened into a groove in hinge pin, prevents removal of pin while door is closed; for the all out-swinging lockable doors.
- 5. Manufacturers:
 - a. Bommer Industries (BO).
 - b. Hager Companies (HA).
 - c. McKinney Products; ASSA ABLOY Architectural Door Accessories (MK) MacPro Series.
- B. Continuous Geared Hinges: ANSI/BHMA A156.26 Grade 1-600 certified continuous geared hinge. with minimum 0.120-inch thick extruded 6060 T6 aluminum alloy hinge leaves and a minimum overall width of 4 inches. Hinges are non-handed, reversible and fabricated to template screw locations. Factory trim hinges to suit door height and prepare for electrical cutouts.
 - 1. Manufacturers:
 - a. Bommer Industries (BO).
 - b. Hager Companies (HA).
 - c. Pemko Products; ASSA ABLOY Architectural Door Accessories (PE).
- C. Pin and Barrel Continuous Hinges: ANSI/BHMA A156.26 Grade 1-600 certified pin and barrel continuous hinges with minimum 14 gauge Type 304 stainless steel hinge leaves, concealed stainless pin, and twin self-lubricated nylon bearings at each knuckle separation. Factory trim hinges to suit door height and prepare for electrical cut-outs.
 - 1. Manufacturers:
 - a. Hager Companies (HA).

- b. Markar Products; ASSA ABLOY Architectural Door Accessories (MR).
- c. Pemko Products; ASSA ABLOY Architectural Door Accessories (PE).

2.3 POWER TRANSFER DEVICES

- A. Electrified Quick Connect Transfer Hinges: Provide electrified transfer hinges with Molex[™] standardized plug connectors and sufficient number of concealed wires (up to 12) to accommodate the electrified functions specified in the Door Hardware Sets. Connectors plug directly to through-door wiring harnesses for connection to electric locking devices and power supplies. Wire nut connections are not acceptable.
 - 1. Manufacturers:
 - a. Bommer Industries (BO) ETW Option.
 - b. Hager Companies (HA) ETW-QC (# wires) Option.
 - c. McKinney Products; ASSA ABLOY Architectural Door Accessories (MK) QC (# wires) Option.
- B. Concealed Quick Connect Electric Power Transfers: Provide concealed wiring pathway housing mortised into the door and frame for low voltage electrified door hardware. Furnish with Molex[™] standardized plug connectors and sufficient number of concealed wires (up to 12) to accommodate the electrified functions specified in the Door Hardware Sets. Connectors plug directly to through-door wiring harnesses for connection to electric locking devices and power supplies. Wire nut connections are not acceptable.
 - 1. Manufacturers:
 - a. Pemko Products; ASSA ABLOY Architectural Door Accessories (PE) EL-CEPT Series.
 - b. Securitron (SU) EL-CEPT Series.
 - c. Von Duprin (VD) EPT-10 Series.
- C. Electric Door Wire Harnesses: Provide electric/data transfer wiring harnesses with standardized plug connectors to accommodate up to twelve (12) wires. Connectors plug directly to throughdoor wiring harnesses for connection to electric locking devices and power supplies. Provide sufficient number and type of concealed wires to accommodate electric function of specified hardware. Provide a connector for through-door electronic locking devices and from hinge to junction box above the opening. Wire nut connections are not acceptable. Determine the length required for each electrified hardware component for the door type, size and construction, minimum of two per electrified opening.
 - 1. Manufacturers:
 - a. Hager Companies (HA) Quick Connect.
 - b. McKinney Products; ASSA ABLOY Architectural Door Accessories (MK) QC-C Series.
 - c. Stanley Hardware (ST) WH Series.

2.4 DOOR OPERATING TRIM

- A. Flush Bolts and Surface Bolts: ANSI/BHMA A156.3 and A156.16, Grade 1, certified.
 - 1. Flush bolts to be furnished with top rod of sufficient length to allow bolt retraction device location approximately six feet from the floor.
 - 2. Furnish dust proof strikes for bottom bolts.
 - 3. Surface bolts to be minimum 8" in length and U.L. listed for labeled fire doors and U.L. listed for windstorm components where applicable.
 - 4. Provide related accessories (mounting brackets, strikes, coordinators, etc.) as required for appropriate installation and operation.
 - 5. Manufacturers:
 - a. Door Controls International (DC).
 - b. Rockwood Products; ASSA ABLOY Architectural Door Accessories (RO).
 - c. Trimco (TC).
- B. Coordinators: ANSI/BHMA A156.3 certified door coordinators consisting of active-leaf, holdopen lever and inactive-leaf release trigger. Model as indicated in hardware sets.
 - 1. Manufacturers:
 - a. Door Controls International (DC).
 - b. Rockwood Products; ASSA ABLOY Architectural Door Accessories (RO).
 - c. Trimco (TC).
- C. Door Push Plates and Pulls: ANSI/BHMA A156.6 certified door pushes and pulls of type and design specified in the Hardware Sets. Coordinate and provide proper width and height as required where conflicting hardware dictates.
 - 1. Push/Pull Plates: Minimum .050 inch thick, size as indicated in hardware sets, with beveled edges, secured with exposed screws unless otherwise indicated.
 - 2. Door Pull and Push Bar Design: Size, shape, and material as indicated in the hardware sets. Minimum clearance of 2 1/2-inches from face of door unless otherwise indicated.
 - 3. Offset Pull Design: Size, shape, and material as indicated in the hardware sets. Minimum clearance of 2 1/2-inches from face of door and offset of 90 degrees unless otherwise indicated.
 - 4. Fasteners: Provide manufacturer's designated fastener type as indicated in Hardware Sets.
 - 5. Manufacturers:
 - a. Burns Manufacturing (BU).
 - b. Rockwood Products; ASSA ABLOY Architectural Door Accessories (RO).
 - c. Trimco (TC).

2.5 CYLINDERS AND KEYING

- A. General: Cylinder manufacturer to have minimum (10) years experience designing secured master key systems and have on record a published security keying system policy.
 - 1. Manufacturers:
 - a. Corbin Russwin Hardware (RU).
 - b. Schlage (SC).
 - c. Medeco (MC).
 - d. Yale Commercial (YA).
- B. Cylinder Types: Original manufacturer cylinders able to supply the following cylinder formats and types:
 - 1. Threaded mortise cylinders with rings and cams to suit hardware application.
 - 2. Rim cylinders with back plate, flat-type vertical or horizontal tailpiece, and raised trim ring.
 - 3. Bored or cylindrical lock cylinders with tailpieces as required to suit locks.
 - 4. Tubular deadlocks and other auxiliary locks.
 - 5. Mortise and rim cylinder collars to be solid and recessed to allow the cylinder face to be flush and be free spinning with matching finishes.
 - 6. Keyway: Manufacturer's Standard.
- C. Interchangeable Cores: Provide small format interchangeable cores as specified, core insert, removable by use of a special key; usable with other manufacturers' cylinders.
- D. Patented Cylinders: ANSI/BHMA A156.5, Grade 1 Certified Products Directory (CPD) listed cylinders employing a utility patented and restricted keyway requiring the use of a patented key. Cylinders are to be protected from unauthorized manufacture and distribution by manufacturer's United States patents. Cylinders are to be factory keyed with owner having the ability for onsite original key cutting.
 - 1. Patented key systems shall not be established with products that have an expired patent. Expired systems shall only be specified and supplied to support existing systems.
 - 2. Manufacturers:
 - a. Medeco (MC) X4.
- E. Keying System: Each type of lock and cylinders to be factory keyed.
 - 1. Supplier shall conduct a "Keying Conference" to define and document keying system instructions and requirements.
 - 2. Furnish factory cut, nickel-silver large bow permanently inscribed with a visual key control number as directed by Owner.
 - 3. New System: Key locks to a new key system as directed by the Owner.
- F. Key Quantity: Provide the following minimum number of keys:
 - 1. Change Keys per Cylinder: Two (2)

- 2. Master Keys (per Master Key Level/Group): Five (5).
- 3. Construction Keys (where required): Ten (10).
- 4. Construction Control Keys (where required): Two (2).
- 5. Permanent Control Keys (where required): Two (2).
- G. Construction Keying: Provide temporary keyed construction cores.
- H. Key Registration List (Bitting List):
 - 1. Provide keying transcript list to Owner's representative in the proper format for importing into key control software.
 - 2. Provide transcript list in writing or electronic file as directed by the Owner.

2.6 KEY CONTROL

- A. Key Control Cabinet: Provide a key control system including envelopes, labels, and tags with self-locking key clips, receipt forms, 3-way visible card index, temporary markers, permanent markers, and standard metal cabinet. Key control cabinet shall have expansion capacity of 150% of the number of locks required for the project.
 - 1. Manufacturers:
 - a. Lund Equipment (LU).
 - b. MMF Industries (MM).
 - c. Telkee (TK).

2.7 MECHANICAL LOCKS AND LATCHING DEVICES

- A. Mortise Locksets, Grade 1 (Heavy Duty): ANSI/BHMA A156.13, Series 1000, Operational Grade 1 Certified Products Directory (CPD) listed. Locksets are to be manufactured with a corrosion resistant steel case and be field-reversible for handing without disassembly of the lock body.
 - 1. Manufacturers:
 - a. Corbin Russwin Hardware (RU) ML2000 Series.
 - b. Schlage (SC) L9000 Series.
 - c. Yale Commercial(YA) 8800FL Series.

2.8 ELECTROMECHANICAL LOCKING DEVICES

A. Electromechanical Mortise Locksets, Grade 1 (Heavy Duty): ANSI/BHMA A156.13, Series 1000, Operational Grade 1 Certified Products Directory (CPD) listed, subject to same compliance standards and requirements as mechanical mortise locksets, electrified locksets to be of type and design as specified below and in the hardware sets.

- 1. Electrified Lock Options: Where indicated in the Hardware Sets, provide electrified options including: outside door lock/unlock trim control, latchbolt and lock/unlock status monitoring, deadbolt monitoring, and request-to-exit signaling. Support end-of-line resistors contained within the lock case. Unless otherwise indicated, provide electrified locksets standard as fail secure.
- 2. Energy Efficient Design: Provide lock bodies which have a holding current draw of 15mA maximum, and can operate on either 12 or 24 volts. Locks are to be field configurable for fail safe or fail secure operation.
- 3. Manufacturers:
 - a. Corbin Russwin Hardware (RU) ML20900 Series.
 - b. Schlage (SC) L9000 EL/EU/RX Series.
 - c. Yale Commercial(YA) 8800FL Series.

2.9 LOCK AND LATCH STRIKES

- A. Strikes: Provide manufacturer's standard strike with strike box for each latch or lock bolt, with curved lip extended to protect frame, finished to match door hardware set, unless otherwise indicated, and as follows:
 - 1. Flat-Lip Strikes: For locks with three-piece antifriction latchbolts, as recommended by manufacturer.
 - 2. Extra-Long-Lip Strikes: For locks used on frames with applied wood casing trim.
 - 3. Aluminum-Frame Strike Box: Provide manufacturer's special strike box fabricated for aluminum framing.
 - 4. Double-lipped strikes: For locks at double acting doors. Furnish with retractable stop for rescue hardware applications.
- B. Standards: Comply with the following:
 - 1. Strikes for Mortise Locks and Latches: BHMA A156.13.
 - 2. Strikes for Bored Locks and Latches: BHMA A156.2.
 - 3. Strikes for Auxiliary Deadlocks: BHMA A156.36.
 - 4. Dustproof Strikes: BHMA A156.16.

2.10 CONVENTIONAL EXIT DEVICES

- A. General Requirements: All exit devices specified herein shall meet or exceed the following criteria:
 - 1. At doors not requiring a fire rating, provide devices complying with NFPA 101 and listed and labeled for "Panic Hardware" according to UL305. Provide proper fasteners as required by manufacturer including sex nuts and bolts at openings specified in the Hardware Sets.

- 2. Where exit devices are required on fire rated doors, provide devices complying with NFPA 80 and with UL labeling indicating "Fire Exit Hardware". Provide devices with the proper fasteners for installation as tested and listed by UL. Consult manufacturer's catalog and template book for specific requirements.
- 3. Except on fire rated doors, provide exit devices with hex key dogging device to hold the pushbar and latch in a retracted position. Provide optional keyed cylinder dogging on devices where specified in Hardware Sets.
- 4. Devices must fit flat against the door face with no gap that permits unauthorized dogging of the push bar. The addition of filler strips is required in any case where the door light extends behind the device as in a full glass configuration.
- 5. Lever Operating Trim: Where exit devices require lever trim, furnish manufacturer's heavy duty escutcheon trim with threaded studs for thru-bolts.
 - a. Lock Trim Design: As indicated in Hardware Sets, provide finishes and designs to match that of the specified locksets.
 - b. Where function of exit device requires a cylinder, provide a cylinder (Rim or Mortise) as specified in Hardware Sets.
- 6. Vertical Rod Exit Devices: Where surface or concealed vertical rod exit devices are used at interior openings, provide as less bottom rod (LBR) unless otherwise indicated. Provide dust proof strikes where thermal pins are required to project into the floor.
- 7. Narrow Stile Applications: At doors constructed with narrow stiles, or as specified in Hardware Sets, provide devices designed for maximum 2" wide stiles.
- 8. Dummy Push Bar: Nonfunctioning push bar matching functional push bar.
- 9. Rail Sizing: Provide exit device rails factory sized for proper door width application.
- 10. Through Bolt Installation: For exit devices and trim as indicated in Door Hardware Sets.
- B. Conventional Push Rail Exit Devices (Heavy Duty): ANSI/BHMA A156.3, Grade 1 Certified Products Directory (CPD) listed panic and fire exit hardware devices furnished in the functions specified in the Hardware Sets. Exit device latch to be stainless steel, pullman type, with deadlock feature.
 - 1. Manufacturers:
 - a. Corbin Russwin Hardware (RU) ED4000 / ED5000 Series.
 - b. Von Duprin (VD) 35A/98 XP Series.
 - c. Yale (YA) 7000 Series.
- C. Security Push Rail Exit Devices (Heavy Duty): ANSI/BHMA A156.3, Grade 1 Certified Products Directory (CPD) listed rim panic and fire exit hardware devices furnished in the functions specified in the Hardware Sets. Exit device latch to be constructed of high grade, heat treated, corrosion resistant nickel steel alloy, and have a full 3/4" throw projection with slide action positive deadlocking.

- 1. Static Load Force Resistance: Minimum 3000 lbs certified independent tested.
- 2. Manufacturers:
 - a. Corbin Russwin Hardware (RU) ED4000S / ED5000S Series.
 - b. Yale (YA) 7050 Series.
- D. Conventional Push Rail Exit Devices (Commercial Duty): ANSI/BHMA A156.3, Grade 1 Certified Products Directory (CPD) listed panic and fire exit hardware devices furnished in the functions specified in the Hardware Sets. Fabricate latchbolts from cast stainless steel, Pullman type, incorporating a deadlocking feature.
 - 1. Manufacturers:
 - a. Von Duprin (VD) 22 Series.
 - b. Yale Commercial(YA) 6000 Series.
 - c. Corbin Russwin Hardware (RU) ED8000 Series.

2.11 ELECTROMECHANICAL EXIT DEVICES

- A. Electromechanical Push Rail Exit Devices (Heavy Duty): ANSI/BHMA A156.3, Grade 1 Certified Products Directory (CPD) listed panic and fire exit hardware devices subject to same compliance standards and requirements as mechanical exit devices. Electrified exit devices to be of type and design as specified below and in the hardware sets.
 - 1. Energy Efficient Design: Provide devices which have a holding current draw of 15mA maximum, and can operate on either 12 or 24 volts. Locks are to be field configurable for fail safe or fail secure operation.
 - 2. Where conventional power supplies are not sufficient, include any specific controllers required to provide the proper inrush current.
 - 3. Motorized Electric Latch Retraction: Devices with an electric latch retraction feature must use motors which have a maximum current draw of 600mA. Solenoid driven latch retraction is not acceptable.
 - 4. Manufacturers:
 - a. Corbin Russwin Hardware (RU) ED5000 Series.
 - b. Von Duprin (VD) 35A/98 XP Series.
 - c. Yale (YA) 6000/7000 Series.

2.12 DOOR CLOSERS

A. All door closers specified herein shall meet or exceed the following criteria:

- 1. General: Door closers to be from one manufacturer, matching in design and style, with the same type door preparations and templates regardless of application or spring size. Closers to be non-handed with full sized covers.
- 2. Standards: Closers to comply with UL-10C for Positive Pressure Fire Test and be U.L. listed for use of fire rated doors.
- 3. Size of Units: Comply with manufacturer's written recommendations for sizing of door closers depending on size of door, exposure to weather, and anticipated frequency of use. Where closers are indicated for doors required to be accessible to the Americans with Disabilities Act, provide units complying with ANSI ICC/A117.1.
- 4. Closer Arms: Provide heavy duty, forged steel closer arms unless otherwise indicated in Hardware Sets.
- 5. Closers shall not be installed on exterior or corridor side of doors; where possible install closers on door for optimum aesthetics.
- 6. Closer Accessories: Provide door closer accessories including custom templates, special mounting brackets, spacers and drop plates as required for proper installation. Provide through-bolt and security type fasteners as specified in the hardware sets.
- B. Door Closers, Surface Mounted (Large Body Cast Iron): ANSI/BHMA A156.4, Grade 1 Certified Products Directory (CPD) listed surface mounted, heavy duty door closers with complete spring power adjustment, sizes 1 thru 6; and fully operational adjustable according to door size, frequency of use, and opening force. Closers to be rack and pinion type, one piece cast iron body construction, with adjustable backcheck and separate non-critical valves for closing sweep and latch speed control.
 - 1. Manufacturers:
 - a. Corbin Russwin Hardware (RU) DC8000 Series.
 - b. LCN Closers (LC) 4040XP Series.
 - c. Norton Door Controls (NO) 410 Series.
 - d. Yale Commercial (YA) 5800 Series.
- C. Door Closers, Surface Mounted (Commercial Duty): ANSI/BHMA 156.4, Grade 1 Certified Products Directory (CPD) listed surface mounted, institutional grade door closers with complete spring power adjustment, sizes 1 thru 6; and fully operational adjustable according to door size, frequency of use, and opening force. Closers to be rack and pinion type, one piece cast iron or aluminum alloy body construction, with adjustable backcheck, closing sweep, and latch speed control valves. Provide non-handed units standard.
 - 1. Manufacturers:
 - a. Corbin Russwin Hardware (RU) DC6000 Series.
 - b. LCN Closers (LC) 1460 Series.
 - c. Norton Door Controls (NO) 8500 Series.
 - d. Yale Commercial (YA) 3500 Series.

2.13 ELECTROHYDRAULIC DOOR OPERATORS

- A. General: Provide low energy operators of size recommended by manufacturer for door size, weight, and movement; for condition of exposure; and for compliance with UL 325. Coordinate operator mechanisms with door operation, hinges, and activation devices.
 - 1. Fire-Rated Doors: Provide door operators for fire-rated door assemblies that comply with NFPA 80 for fire-rated door components and are listed and labeled by a qualified testing agency.
- B. Standard: Certified ANSI/BHMA A156.19.
- C. Performance Requirements:
 - 1. Opening Force if Power Fails: Not more than 15 lbf required to release a latch if provided, not more than 30 lbf required to manually set door in motion, and not more than 15 lbf required to fully open door.
 - 2. Entrapment Protection: Not more than 15 lbf required to prevent stopped door from closing or opening.
- D. Configuration: Surface mounted or in-ground as required. Door operators to control single swinging and pair of swinging doors.
- E. Operation: Power opening and spring closing operation capable of meeting ANSI A117.1 accessibility guideline. Provide time delay for door to remain open before initiating closing cycle as required by ANSI/BHMA A156.19. When not in automatic mode, door operator to function as manual door closer with fully adjustable opening and closing forces, with or without electrical power.
- F. Features: Operator units to have full feature adjustments for door opening and closing force and speed, backcheck, motor assist acceleration from 0 to 30 seconds, time delay, vestibule interface delay, obstruction recycle, and hold open time from 0 up to 30 seconds.
- G. Provide outputs and relays on board the operator to allow for coordination of exit device latch retraction, electric strikes, magnetic locks, card readers, safety and motion sensors and specified auxiliary contacts.
- H. Brackets and Reinforcements: Manufacturer's standard, fabricated from aluminum with nonferrous shims for aligning system components.
- I. Manufacturers: Subject to compliance with requirements, provide products by one of the following:
 - 1. LCN Closers (LC) 4640 Series.
 - 2. Norton Door Controls (NO) 6000 Series.
 - 3. Stanley Security Solutions (ST) D-4990 Series.

2.14 ARCHITECTURAL TRIM

- A. Door Protective Trim
 - 1. General: Door protective trim units to be of type and design as specified below or in the Hardware Sets.
 - 2. Size: Fabricate protection plates (kick, armor, or mop) not more than 2" less than door width (LDW) on stop side of single doors and 1" LDW on stop side of pairs of doors, and not more than 1" less than door width on pull side. Coordinate and provide proper width and height as required where conflicting hardware dictates. Height to be as specified in the Hardware Sets.
 - 3. Where plates are applied to fire rated doors with the top of the plate more than 16" above the bottom of the door, provide plates complying with NFPA 80. Consult manufacturer's catalog and template book for specific requirements for size and applications.
 - 4. Protection Plates: ANSI/BHMA A156.6 certified protection plates (kick, armor, or mop), fabricated from the following:
 - a. Stainless Steel: 300 grade, 050-inch thick.
 - 5. Options and fasteners: Provide manufacturer's designated fastener type as specified in the Hardware Sets. Provide countersunk screw holes.
 - 6. Manufacturers:
 - a. Hager Companies (HA).
 - b. Rockwood Products; ASSA ABLOY Architectural Door Accessories (RO).
 - c. Trimco (TC).

2.15 DOOR STOPS AND HOLDERS

- A. General: Door stops and holders to be of type and design as specified below or in the Hardware Sets.
- B. Door Stops and Bumpers: ANSI/BHMA A156.16, Grade 1 certified door stops and wall bumpers. Provide wall bumpers, either convex or concave types with anchorage as indicated, unless floor or other types of door stops are specified in Hardware Sets. Do not mount floor stops where they will impede traffic. Where floor or wall bumpers are not appropriate, provide overhead type stops and holders.
 - 1. Manufacturers:
 - a. Hager Companies (HA).
 - b. Rockwood Products; ASSA ABLOY Architectural Door Accessories (RO).
 - c. Trimco (TC).

- C. Overhead Door Stops and Holders: ANSI/BHMA A156.8, Grade 1 Certified Products Directory (CPD) listed overhead stops and holders to be surface or concealed types as indicated in Hardware Sets. Track, slide, arm and jamb bracket to be constructed of extruded bronze and shock absorber spring of heavy tempered steel. Provide non-handed design with mounting brackets as required for proper operation and function.
 - 1. Manufacturers:
 - a. Rixson Door Controls (RF).
 - b. Rockwood Products; ASSA ABLOY Architectural Door Accessories (RO).
 - c. Sargent Manufacturing (SA).

2.16 ARCHITECTURAL SEALS

- A. General: Thresholds, weatherstripping, and gasket seals to be of type and design as specified below or in the Hardware Sets. Provide continuous weatherstrip gasketing on exterior doors and provide smoke, light, or sound gasketing on interior doors where indicated. At exterior applications provide non-corrosive fasteners and elsewhere where indicated.
- B. Smoke Labeled Gasketing: Assemblies complying with NFPA 105 that are listed and labeled by a testing and inspecting agency acceptable to authorities having jurisdiction, for smoke control ratings indicated, based on testing according to UL 1784.
 - 1. Provide smoke labeled perimeter gasketing at all smoke labeled openings.
- C. Fire Labeled Gasketing: Assemblies complying with NFPA 80 that are listed and labeled by a testing and inspecting agency acceptable to authorities having jurisdiction, for fire ratings indicated, based on testing according to UL-10C.
 - 1. Provide intumescent seals as indicated to meet UL10C Standard for Positive Pressure Fire Tests of Door Assemblies, and NPFA 252, Standard Methods of Fire Tests of Door Assemblies.
- D. Sound-Rated Gasketing: Assemblies that are listed and labeled by a testing and inspecting agency, for sound ratings indicated.
- E. Replaceable Seal Strips: Provide only those units where resilient or flexible seal strips are easily replaceable and readily available from stocks maintained by manufacturer.
- F. Manufacturers:
 - 1. National Guard Products (NG).
 - 2. Pemko Products; ASSA ABLOY Architectural Door Accessories (PE).
 - 3. Reese Enterprises, Inc. (RE).

2.17 ELECTRONIC ACCESSORIES

- A. Push-Button Switches: Industrial grade momentary or alternate contact, back-lighted push buttons with stainless-steel switch enclosures. 12/24 VDC bi-color illumination suitable for either flush or surface mounting.
 - 1. Manufacturers:
 - a. Alarm Controls (AK) TS Series.
 - b. Security Door Controls (SD) 400 Series.
 - c. Securitron (SU) PB Series.
- B. Door Position Switches: Door position magnetic reed contact switches specifically designed for use in commercial door applications. On recessed models the contact and magnetic housing snap-lock into a 1" diameter hole. Surface mounted models include wide gap distance design complete with armored flex cabling. Provide SPDT, N/O switches with optional Rare Earth Magnet installation on steel doors with flush top channels.
 - 1. Manufacturers:
 - a. Security Door Controls (SD) DPS Series.
 - b. Securitron (SU) DPS Series.

2.18 FABRICATION

A. Fasteners: Provide door hardware manufactured to comply with published templates generally prepared for machine, wood, and sheet metal screws. Provide screws according to manufacturers recognized installation standards for application intended.

2.19 FINISHES

- A. Standard: Designations used in the Hardware Sets and elsewhere indicate hardware finishes complying with ANSI/BHMA A156.18, including coordination with traditional U.S. finishes indicated by certain manufacturers for their products.
- B. Provide quality of finish, including thickness of plating or coating (if any), composition, hardness, and other qualities complying with manufacturer's standards, but in no case less than specified by referenced standards for the applicable units of hardware
- C. Protect mechanical finishes on exposed surfaces from damage by applying a strippable, temporary protective covering before shipping.

PART 3 - EXECUTION

3.1 EXAMINATION

- A. Examine scheduled openings, with Installer present, for compliance with requirements for installation tolerances, labeled fire door assembly construction, wall and floor construction, and other conditions affecting performance.
- B. Notify architect of any discrepancies or conflicts between the door schedule, door types, drawings and scheduled hardware. Proceed only after such discrepancies or conflicts have been resolved in writing.

3.2 PREPARATION

- A. Hollow Metal Doors and Frames: Comply with ANSI/DHI A115 series.
- B. Wood Doors: Comply with ANSI/DHI A115-W series.

3.3 INSTALLATION

- A. Install each item of mechanical and electromechanical hardware and access control equipment to comply with manufacturer's written instructions and according to specifications.
 - 1. Installers are to be trained and certified by the manufacturer on the proper installation and adjustment of fire, life safety, and security products including: hanging devices; locking devices; closing devices; and seals.
- B. Mounting Heights: Mount door hardware units at heights indicated in following applicable publications, unless specifically indicated or required to comply with governing regulations:
 - 1. Standard Steel Doors and Frames: DHI's "Recommended Locations for Architectural Hardware for Standard Steel Doors and Frames."
 - 2. Wood Doors: DHI WDHS.3, "Recommended Locations for Architectural Hardware for Wood Flush Doors."
 - 3. Where indicated to comply with accessibility requirements, comply with ANSI A117.1 "Accessibility Guidelines for Buildings and Facilities."
 - 4. Provide blocking in drywall partitions where wall stops or other wall mounted hardware is located.
- C. Retrofitting: Install door hardware to comply with manufacturer's published templates and written instructions. Where cutting and fitting are required to install door hardware onto or into surfaces that are later to be painted or finished in another way, coordinate removal, storage, and reinstallation of surface protective trim units with finishing work specified in Division 9 Sections. Do not install surface-mounted items until finishes have been completed on substrates involved.

- D. Thresholds: Set thresholds for exterior and acoustical doors in full bed of sealant complying with requirements specified in Division 7 Section "Joint Sealants."
- E. Storage: Provide a secure lock up for hardware delivered to the project but not yet installed. Control the handling and installation of hardware items so that the completion of the work will not be delayed by hardware losses before and after installation.

3.4 FIELD QUALITY CONTROL

- A. Field Inspection (Punch Report): Reference Division 01 Sections "Closeout Procedures". Produce project punch report for each installed door opening indicating compliance with approved submittals and verification hardware is properly installed, operating and adjusted. Include list of items to be completed and corrected, indicating the reasons or deficiencies causing the Work to be incomplete or rejected.
 - 1. Organization of List: Include separate Door Opening and Deficiencies and Corrective Action Lists organized by Mark, Opening Remarks and Comments, and related Opening Images and Video Recordings.
 - 2. Submit documentation of incomplete items in the following formats:
 - a. PDF electronic file.
 - b. Electronic formatted file integrated with the Openings StudioTM door opening management software platform.

3.5 ADJUSTING

A. Initial Adjustment: Adjust and check each operating item of door hardware and each door to ensure proper operation or function of every unit. Replace units that cannot be adjusted to operate as intended. Adjust door control devices to compensate for final operation of heating and ventilating equipment and to comply with referenced accessibility requirements.

3.6 CLEANING AND PROTECTION

- A. Protect all hardware stored on construction site in a covered and dry place. Protect exposed hardware installed on doors during the construction phase. Install any and all hardware at the latest possible time frame.
- B. Clean adjacent surfaces soiled by door hardware installation.
- C. Clean operating items as necessary to restore proper finish. Provide final protection and maintain conditions that ensure door hardware is without damage or deterioration at time of owner occupancy.

3.7 DEMONSTRATION

A. Instruct Owner's maintenance personnel to adjust, operate, and maintain mechanical and electromechanical door hardware.

3.8 DOOR HARDWARE SETS

- A. The hardware sets represent the design intent and direction of the owner and architect. They are a guideline only and should not be considered a detailed hardware schedule. Discrepancies, conflicting hardware and missing items should be brought to the attention of the architect with corrections made prior to the bidding process. Omitted items not included in a hardware set should be scheduled with the appropriate additional hardware required for proper application and functionality.
 - 1. Quantities listed are for each pair of doors, or for each single door.
 - 2. The supplier is responsible for handing and sizing all products.
 - 3. Where multiple options for a piece of hardware are given in a single line item, the supplier shall provide the appropriate application for the opening.
- B. Manufacturer's Abbreviations:
 - MK McKinney
 PE Pemko
 MR Markar
 RO Rockwood
 YA Yale
 MC Medeco
 RF Rixson
 NO Norton
 OT Other
 AK Alarm Controls
 SU Securitron

Hardware Sets

Set: 1.0

Doors: 100A.1

Description: Exterior - Alumnum Storefront - Egress Pair - Access Control Function - CR x Auto-Door

2 Elec Continuous Hinge (AL)	CFMxxSLF-HD1 EL-EPTL		PE
1 Elec CVR Exit Device (EL/RX/LX/NL)	7160 B S MELR 121NL A640 CMK	630	YA
1 Elec CVR Exit Device (EL/RX/EO)	7160 B MELR EO	630	YA
1 Small Format Inter Core	33700007N P MK	26	MC
2 Offset Pull	RM201	US32D	RO
2 Conc Overhead Stop	6-336	630	RF
1 Surface Closer	TJ3301	689	YA
1 Automatic Opener	6061 D SN-134	689	NO
1 Threshold	253x3AFG		PE
2 Wiring Harness	QC-C3000P (frame to JB/PS)		MK
2 Wiring Harness	QC-CxxxP (door - length as req'd)		MK
1 Card Reader	By Security Contractor		OT
2 Position Switch	DPS-M-GY		SU
1 ADA Switch / Jamb Mount	503		NO
1 ADA Switch / Wall Mount	505		NO
1 Shared Power Supply	AQ series as req'd		SU
1 Seals, Sweeps & Astragal(s)	by Aluminum Door Supplier		OT

Doors normally locked. Entry by valid input at reader or manual key. Free egress at all times.

Doors can also be unlocked by electronic dogging via access control system.

Door position switches to monitor opening status. Exit devices have integral RX feature to signal egress. Auto-Door operator system must be integrated with active leaf exit device.

Exterior ADA switch controlled by latch monitor in active leaf exit device and is active only when latch is retracted.

Interior ADA switch is always active and will retract latch for egress.

Coordinate with electrical and security contractors.

Verify and match aluminum storefront finish.

Door stile minimum of 4-1/2" required for panic hardware.

<u>Set: 2.0</u>

Description: Exterior - Access Control - CR - Panic Egress x Intercom

Elec Continuous Hinge (HM)	FM300 EL-EPTL	630	MR
Elec Rim Exit Device (EL/RX/NL)	7150 B MELR 632F A600 Temp Core CMK	630	YA
Small Format Inter Core	33700007N P MK	26	MC
Surface Closer w/ Stop	5821	689	YA
Kick Plate	K1050 10" HGT x CSK x BEV	US32D	RO
Threshold	253x3AFG		PE
Rain Guard	346A		PE
Perimeter Gasketing	Integral Kerfed by HM Frame Mfr		PE


1 Sweep	3452APK	PE
1 Wiring Harness	QC-C3000P (frame to JB/PS)	MK
1 Wiring Harness	QC-CxxxP (door - length as req'd)	MK
1 Card Reader	By Security Contractor	OT
1 Position Switch	DPS-M-GY	SU
1 Shared Power Supply	AQ series as req'd	SU
1 Call Station / Remote Release	System by Others	OT

Entry by valid input at reader, remote release via intercom or manual key. Free egress at all times. Door position switch to monitor opening status. Exit device has RX feature to signal egress. Coordinate with electrical and security contractors.

<u>Set: 3.0</u>

Doors: 112.1, 112.2, 126.2, 134.2, 183

Description: Exterior - Access Control Function - CR

1	Elec Continuous Hinge (HM)	FM300 EL-EPTL	630	MR
]	Elec Lock - FSE x RX	CRR 8891FL REX A620 x Temp Core CMK	626	YA
]	Small Format Inter Core	33700007N P MK	26	MC
1	Surface Closer w/ Stop	5821	689	YA
]	Kick Plate	K1050 10" HGT x CSK x BEV	US32D	RO
1	Threshold	253x3AFG		PE
1	Rain Guard	346A		PE
]	Perimeter Gasketing	Integral Kerfed by HM Frame Mfr		PE
1	Sweep	3452APK		PE
1	Wiring Harness	QC-C3000P (frame to JB/PS)		MK
1	Wiring Harness	QC-CxxxP (door - length as req'd)		MK
]	Card Reader	By Security Contractor		OT
1	Position Switch	DPS-M-GY		SU
]	Shared Power Supply	AQ series as req'd		SU
1	Call Station / Remote Release	System by Others		OT

Notes:

Entry by valid input at reader or manual key. Free egress at all times. Door position switch to monitor opening status. Exit device has RX feature to signal egress. Coordinate with electrical and security contractors.

Set: 4.0

Description: Exterior - Access Control Function - CRKP

1	Elec Continuous Hinge (HM)	FM300 EL-EPTL	630	MR
1	Elec Lock - FSE x RX	CRR 8891FL REX A620 x Temp Core CMK	626	YA
]	Small Format Inter Core	33700007N P MK	26	MC
1	Surface Closer w/ Stop	5821	689	YA
1	Kick Plate	K1050 10" HGT x CSK x BEV	US32D	RO
1	Threshold	253x3AFG		PE
1	Rain Guard	346A		PE
1	Perimeter Gasketing	Integral Kerfed by HM Frame Mfr		PE
]	Sweep	3452APK		PE
]	Wiring Harness	QC-C3000P (frame to JB/PS)		MK
1	Wiring Harness	QC-CxxxP (door - length as req'd)		МК
1	Card Reader x Keypad	By Security Contractor		OT
1	Position Switch	DPS-M-GY		SU
]	Shared Power Supply	AQ series as req'd		SU
1	Call Station / Remote Release	System by Others		OT

Entry by valid input at reader

or manual key. Free egress at all times.

Door position switch to monitor opening status. Exit device has RX feature to signal egress. Coordinate with electrical and security contractors.

<u>Set: 5.0</u>

Doors: 1246.2, 155.2

Description: Exterior - Storeroom Function - Panic Egress x Door Contact

1 Continuous Hinge (HM)	FM300	630	MR
1 Rim Exit Device, Nightlatch	7150 632F A600 Temp Core CMK	630	YA
1 Small Format Inter Core	33700007N P MK	26	MC
1 Surface Closer w/ Stop	5821	689	YA
1 Kick Plate	K1050 10" HGT x CSK x BEV	US32D	RO
1 Threshold	253x3AFG		PE
1 Rain Guard	346A		PE
1 Perimeter Gasketing	Integral Kerfed by HM Frame Mfr		PE
1 Sweep	3452APK		PE
1 Position Switch	DPS-M-GY		SU

Notes:

Entry by manual key. Free egress at all times.

Door position switch to monitor opening status. Coordinate with electrical and security contractors.

<u>Set: 6.0</u>

Doors: 152.2, 153.2

Description: Exterior - Storeroom Function x Door Contact

1 Continuous Hinge (HM)	FM300	630	MR
1 Storeroom Lock	CRR 8805FL A620 Temp Core CMK	626	YA
1 Small Format Inter Core	33700007N P MK	26	MC
1 Surface Closer w/ Stop	5821	689	YA
1 Kick Plate	K1050 10" HGT x CSK x BEV	US32D	RO
1 Threshold	253x3AFG		PE
1 Rain Guard	346A		PE
1 Perimeter Gasketing	Integral Kerfed by HM Frame Mfr		PE
1 Sweep	3452APK		PE
1 Position Switch	DPS-M-GY		SU

Notes: Entry by manual key. Free egress at all times. Door position switch to monitor opening status. Coordinate with electrical and security contractors.

Set: 7.0

Doors: 1532, 154.2, 1646.1, 1661.1

Description: Exterior - Storeroom Function Pair x Door Contacts

2 Continuous Hinge (HM)	FM300	630	MR
2 Flush Bolt	555 / 557 as req'd	US26D	RO
1 Dust Proof Strike	570	US26D	RO
1 Storeroom Lock	CRR 8805FL A620 Temp Core CMK	626	YA
2 Surface Closer w/ Stop	5821	689	YA
1 Threshold	253x3AFG		PE
1 Rain Guard	346A		PE
1 Perimeter Gasketing	Integral Kerfed by HM Frame Mfr		PE
2 Sweep	3452APK		PE
2 Position Switch	DPS-M-GY		SU
1 Metal Edge Astragal	By Door Mfr.		OT

Notes:

Door position switches to monitor opening status as required.

Set: 8.0

Doors: ST01.2

Description: Access Control Function CRKP - Stairwell - Panic Egress - Rated

2 Hinge, Full Mortise	MPB79 (size per spec)	US26D	MK
1 Electric Hinge	MPB79-QC (size per spec)	US26D	MK
1 Electrified Rim Exit, Fail Safe	6100F MO690F K640	606	YA
1 Surface Closer	3501 / PR3501 as req'd	689	YA
1 Door Stop	400 series as req'd	US4	RO
1 Gasketing	S88D		PE
1 Sweep	321DN		PE
1 Wiring Harness	QC-C3000P (frame to JB/PS)		MK
1 Wiring Harness	QC-CxxxP (door - length as req'd)		MK
1 Card Reader x Keypad	By Security Contractor		OT
1 Shared Power Supply	AQ series as req'd		SU
1 Call Station / Remote Release	System by Others		OT

Notes:

Entry to Floor Levels by valid input at reader or manual key. Free egress to Stairwell at all times. Electrifed Exit Device Trim is "Fail Safe" and must unlock upon signal from fire alarm system or remote release from Fire Command location.

Coordinate with electrical and security contractors.

Set: 9.0

Doors: 103 Description: Access Control Function - CRKP x Intercom - Outswing

2 Hinge, Full Mortise	MPB79 x NRP (size per spec)	US26D	MK
1 Electric Hinge	MPB79-QC (size per spec)	US26D	MK
1 Elec Lock - FSE x RX	CRR 8891FL REX A620 x Temp Core CMK	626	YA
1 Surface Closer	3501 / PR3501 as req'd	689	YA
1 Kick Plate	K1050 10" HGT x CSK x BEV	US32D	RO
1 Door Stop	400 series as req'd	US4	RO
3 Silencer	608 / 608CA as req'd		RO
1 Wiring Harness	QC-C3000P (frame to JB/PS)		MK
1 Wiring Harness	QC-CxxxP (door - length as req'd)		MK
1 Card Reader x Keypad	By Security Contractor		OT

1 Position Switch	DPS-M-GY	SU
1 Shared Power Supply	AQ series as req'd	SU
1 Call Station / Remote Release	System by Others	OT

Entry by valid input at reader, remote release via intercom or manual key. Free egress at all times. Door position switch to monitor opening status. Lockset has RX feature to signal egress. Coordinate with electrical and security contractors.

Set: 10.0

Doors: 120, 121, 129, 135, 157.1, 171.1, 174.1, 177.1, 180

Description: Access Control Function - CR - Intercom

2	Hinge, Full Mortise	MPB79 x NRP (size per spec)	US26D	MK
1	Electric Hinge	MPB79-QC (size per spec)	US26D	MK
1	Elec Lock - FSE x RX	CRR 8891FL REX A620 x Temp Core CMK	626	YA
1	Small Format Inter Core	33700007N P MK	26	MC
1	Surface Closer	3501 / PR3501 as req'd	689	YA
1	Door Stop	400 series as req'd	US4	RO
3	Silencer	608 / 608CA as req'd		RO
1	Wiring Harness	QC-C3000P (frame to JB/PS)		MK
1	Wiring Harness	QC-CxxxP (door - length as req'd)		MK
1	Card Reader	By Security Contractor		OT
1	Door Release	TS-18		AK
1	Position Switch	DPS-M-GY		SU
1	Shared Power Supply	AQ series as req'd		SU
1	Call Station / Remote Release	System by Others		OT

Notes:

Entry by valid input at reader, remote release via intercom or manual key. Free egress at all times. Door position switch to monitor opening status. Lockset has RX feature to signal egress. Coordinate with electrical and security contractors.

Set: 10.5

Doors: 158.1, 159.1, 162.1, 165.1, 168.1

Description: Access Control Function - CR - Intercom - Fire Rated

2 Hinge, Full Mortise	MPB79 x NRP (size per spec)	US26D	MK
1 Electric Hinge	MPB79-QC (size per spec)	US26D	MK
1 Elec Lock - FSE x RX	CRR 8891FL REX A620 x Temp Core	626	YA

	СМК		
1 Small Format Inter Core	33700007N P MK	26	MC
1 Surface Closer	3501 / PR3501 as req'd	689	YA
1 Door Stop	400 series as req'd	US4	RO
3 Silencer	608 / 608CA as req'd		RO
1 Wiring Harness	QC-C3000P (frame to JB/PS)		MK
1 Wiring Harness	QC-CxxxP (door - length as req'd)		MK
1 Card Reader	By Security Contractor		OT
1 Door Release	TS-18		AK
1 Position Switch	DPS-M-GY		SU
1 Shared Power Supply	AQ series as req'd		SU
1 Call Station / Remote Release	System by Others		OT

Entry by valid input at reader, remote release via intercom or manual key. Free egress at all times. Door position switch to monitor opening status. Lockset has RX feature to signal egress. Coordinate with electrical and security contractors.

Set: 11.0

Description: Access Control Function - CR - Intercom x Overhead Stop

2 Hinge, Full Mortise	MPB79 x NRP (size per spec)	US26D	MK
1 Electric Hinge	MPB79-QC (size per spec)	US26D	MK
1 Elec Lock - FSE x RX	CRR 8891FL REX A620 x Temp Core CMK	626	YA
1 Small Format Inter Core	33700007N P MK	26	MC
1 Conc Overhead Stop	6-336	630	RF
1 Surface Closer	3501 / PR3501 as req'd	689	YA
3 Silencer	608 / 608CA as req'd		RO
1 Wiring Harness	QC-C3000P (frame to JB/PS)		MK
1 Wiring Harness	QC-CxxxP (door - length as req'd)		MK
1 Card Reader	By Security Contractor		OT
1 Door Release	TS-18		AK
1 Position Switch	DPS-M-GY		SU
1 Shared Power Supply	AQ series as req'd		SU
1 Call Station / Remote Release	System by Others		OT

Notes:

Entry by valid input at reader, remote release via intercom or manual key. Free egress at all times. Door position switch to monitor opening status. Lockset has RX feature to signal egress. Coordinate with electrical and security contractors.

Set: 12.0

Description: Access Control Function - CR x Overhead Stop

2	2 Hinge, Full Mortise	MPB79 x NRP (size per spec)	US26D	MK
	Electric Hinge	MPB79-QC (size per spec)	US26D	MK
	Elec Lock - FSE x RX	CRR 8891FL REX A620 x Temp Core CMK	626	YA
	Small Format Inter Core	33700007N P MK	26	MC
	Conc Overhead Stop	6-336	630	RF
	Surface Closer	3501 / PR3501 as req'd	689	YA
	3 Silencer	608 / 608CA as req'd		RO
	Wiring Harness	QC-C3000P (frame to JB/PS)		MK
	Wiring Harness	QC-CxxxP (door - length as req'd)		MK
	Card Reader	By Security Contractor		OT
	Door Release	TS-18		AK
	Position Switch	DPS-M-GY		SU
	Shared Power Supply	AQ series as req'd		SU
	Call Station / Remote Release	System by Others		OT

Notes:

Entry by valid input at reader or manual key. Free egress at all times. Door position switch to monitor opening status. Lockset has RX feature to signal egress. Coordinate with electrical and security contractors.

Set: 13.0

Doors: 136, 138, 139, 145, 147, 151.1, 151.2, 2603

Description: Access Control Function - CR - Inswing

2 Hinge, Full Mortise	MPB79 x NRP (size per spec)	US26D	MK
1 Electric Hinge	MPB79-QC (size per spec)	US26D	MK
1 Elec Lock - FSE x RX	CRR 8891FL REX A620 x Temp Core CMK	626	YA
1 Surface Closer	3501 / PR3501 as req'd	689	YA
1 Kick Plate	K1050 10" HGT x CSK x BEV	US32D	RO
1 Door Stop	400 series as req'd	US4	RO
3 Silencer	608 / 608CA as req'd		RO
1 Wiring Harness	QC-C3000P (frame to JB/PS)		MK
1 Wiring Harness	QC-CxxxP (door - length as req'd)		MK
1 Card Reader	By Security Contractor		OT

1 Position Switch	DPS-M-GY	SU
1 Shared Power Supply	AQ series as req'd	SU

Entry by valid input at reader or manual key. Free egress at all times. Door position switch to monitor opening status. Lockset has RX feature to signal egress. Coordinate with electrical and security contractors.

Set: 14.0

Doors: 1126, 126.1, 127, 134.1

Description: Access Control Function - CRKP - Outswing

2	Hinge, Full Mortise	MPB79 x NRP (size per spec)	US26D	MK
1	Electric Hinge	MPB79-QC (size per spec)	US26D	MK
1	Elec Lock - FSE x RX	CRR 8891FL REX A620 x Temp Core CMK	626	YA
1	Surface Closer	3501 / PR3501 as req'd	689	YA
1	Kick Plate	K1050 10" HGT x CSK x BEV	US32D	RO
1	Door Stop	400 series as req'd	US4	RO
3	Silencer	608 / 608CA as req'd		RO
1	Wiring Harness	QC-C3000P (frame to JB/PS)		MK
1	Wiring Harness	QC-CxxxP (door - length as req'd)		MK
1	Card Reader x Keypad	By Security Contractor		OT
1	Position Switch	DPS-M-GY		SU
1	Shared Power Supply	AQ series as req'd		SU

Notes:

Entry by valid input at reader or manual key. Free egress at all times. Door position switch to monitor opening status. Lockset has RX feature to signal egress. Coordinate with electrical and security contractors.

Set: 15.0

Doors: 149, 150.1, 1510.2

Description: Access Control Function - CR - Card-In / Card-Out x Remote Release - Fail Safe

2 Hinge, Full Mortise, Hvy Wt	MPB68 (size per spec)	US26D	MK
1 Electric Hinge, Hvy Wt	MPB68-QC (size per spec)	US26D	MK
1 Fail Safe Lock - Both Levers	CRR 8894-2FL A620 Less Core	626	YA
2 Small Format Inter Core	33700007N P MK	26	MC
1 Surface Closer w/ Stop	5821	689	YA
1 Kick Plate	K1050 10" HGT x CSK x BEV	US32D	RO

3 Silencer	608 / 608CA as req'd	RO
1 Wiring Harness	QC-C3000P (frame to JB/PS)	МК
1 Wiring Harness	QC-CxxxP (door - length as req'd)	MK
2 Card Reader	By Security Contractor	OT
1 Position Switch	DPS-M-GY	SU
1 Shared Power Supply	AQ series as req'd	SU
1 Call Station / Remote Release	System by Others	OT

Entry / Egress (either side) by valid input at reader, remote release via intercom or manual key. Electrifed locksets are "Fail Safe" and must unlock upon signal from fire alarm system or remote release from Fire Command location.

Coordinate with electrical and security contractors.

<u>Set: 16.0</u>

Description: Access Control Function - CR Card-In / CRPK Card-Out x Remote Release - Fail Safe

	Hinge, Full Mortise, Hvy Wt	MPB68 (size per spec)	US26D	MK
	Electric Hinge, Hvy Wt	MPB68-QC (size per spec)	US26D	MK
1	Fail Safe Lock - Both Levers	CRR 8894-2FL A620 Less Core	626	YA
2	Small Format Inter Core	33700007N P MK	26	MC
1	Surface Closer	3501 / PR3501 as req'd	689	YA
1	Kick Plate	K1050 10" HGT x CSK x BEV	US32D	RO
1	Door Stop	400 series as req'd	US4	RO
3	Silencer	608 / 608CA as req'd		RO
1	Wiring Harness	QC-C3000P (frame to JB/PS)		MK
1	Wiring Harness	QC-CxxxP (door - length as req'd)		MK
1	Card Reader x Keypad	By Security Contractor		OT
1	Card Reader	By Security Contractor		OT
1	Position Switch	DPS-M-GY		SU
1	Shared Power Supply	AQ series as req'd		SU
1	Call Station / Remote Release	System by Others		OT

Notes:

Entry / Egress (either side) by valid input at reader, remote release via intercom or manual key. Electrifed locksets are "Fail Safe" and must unlock upon signal from fire alarm system or remote release from Fire Command location.

Coordinate with electrical and security contractors.

Set: 17.0

Doors: 117.1, 125.1, 130

Description: Access Control Function - CR Card-In / CRPK Card-Out - Fail Safe

2 Hinge, Full Mortise, Hvy Wt	MPB68 (size per spec)	US26D	MK
1 Electric Hinge, Hvy Wt	MPB68-QC (size per spec)	US26D	MK
1 Fail Safe Lock - Both Levers	CRR 8894-2FL A620 Less Core	626	YA
1 Small Format Inter Core	33700007N P MK	26	MC
1 Surface Closer	3501 / PR3501 as req'd	689	YA
1 Kick Plate	K1050 10" HGT x CSK x BEV	US32D	RO
1 Door Stop	400 series as req'd	US4	RO
3 Silencer	608 / 608CA as req'd		RO
1 Wiring Harness	QC-C3000P (frame to JB/PS)		MK
1 Wiring Harness	QC-CxxxP (door - length as req'd)		MK
1 Card Reader x Keypad	By Security Contractor		OT
1 Card Reader	By Security Contractor		OT
1 Position Switch	DPS-M-GY		SU
1 Shared Power Supply	AQ series as req'd		SU

Notes:

Entry / Egress (either side) by valid input at reader or manual key.

Electrifed locksets are "Fail Safe" and must unlock upon signal from fire alarm system or remote release from Fire Command location.

Coordinate with electrical and security contractors.

<u>Set: 17.5</u>

Doors: 141, 146, 150.2

Description: Access Control Function - CR Card-In / CRPK Card-Out - Fail Secure

2 Hinge, Full Mortise, Hvy Wt	MPB68 (size per spec)	US26D	MK
1 Electric Hinge, Hvy Wt	MPB68-QC (size per spec)	US26D	MK
1 Fail Secure Lock - Both Levers	CRR 8895-2FL A620 Temp Core CMK	626	YA
1 Small Format Inter Core	33700007N P MK	26	MC
1 Surface Closer	3501 / PR3501 as req'd	689	YA
1 Kick Plate	K1050 10" HGT x CSK x BEV	US32D	RO
1 Door Stop	400 series as req'd	US4	RO
3 Silencer	608 / 608CA as req'd		RO
1 Wiring Harness	QC-C3000P (frame to JB/PS)		MK
1 Wiring Harness	QC-CxxxP (door - length as req'd)		MK
1 Card Reader x Keypad	By Security Contractor		OT
1 Card Reader	By Security Contractor		OT
1 Position Switch	DPS-M-GY		SU

1 Shared Power Supply

AQ series as req'd

Notes:

Entry / Egress (either side) by valid input at reader or manual key.

Electrifed locksets are "Fail Safe" and must unlock upon signal from fire alarm system or remote release from Fire Command location.

Coordinate with electrical and security contractors.

Set: 18.0

Doors: 159.2, 162.2, 165.2, 168.2, 171.2, 174.2, 177.2, 200, 201, 202, 203, 204, 206, 207, 2617.1 Description: Access Control Function w/ Remote Release x Seals

2 Hinge, Full Mortise, Hvy Wt	MPB68 (size per spec)	US26D	MK
1 Electric Hinge, Hvy Wt	MPB68-QC (size per spec)	US26D	MK
1 Fail Secure Lock - Both Levers	CRR 8895-2FL A620 Temp Core CMK	626	YA
1 Small Format Inter Core	33700007N P MK	26	MC
1 Surface Closer w/ Stop	3531	689	YA
1 Threshold w/ Seal	2005AT FHSL14SS		PE
1 Gasketing	S88D		PE
1 Sweep	321DN		PE
1 Wiring Harness	QC-C3000P (frame to JB/PS)		MK
1 Wiring Harness	QC-CxxxP (door - length as req'd)		MK
1 Shared Power Supply	AQ series as req'd		SU
1 Call Station / Remote Release	System by Others		OT

Notes:

Door normally closed and locked. Egress / Entry by remote release or manual key. Coordinate with electrical and security contractors.

Set: 18.5

Doors: 1301.1

Description: Access Control Function Pair - Panic Egress- Hold Open

4	Hinge, Full Mortise, Hvy Wt	MPB68 (size per spec)	US26D	MK
2	Electric Hinge, Hvy Wt	MPB68-QC (size per spec)	US26D	MK
1	Elec CVR Exit Device (EL/RX/EO)	7160 B MELR EO	630	YA
1	Elec. CVR Exit Device (EL/NL/LX/RX)	7160 B S MELR CR627F A640 CMK	630	YA
2	Surface Closer	3501	689	YA
2	Kick Plate	K1050 10" HGT x CSK x BEV	US32D	RO
2	Electromagnetic Holder	99xM for wall condition	689	RF
1	Gasketing	S88D		PE

1 Astragal	S772BL	PE
2 Wiring Harness	QC-C3000P (frame to JB/PS)	MK
2 Wiring Harness	QC-CxxxP (door - length as req'd)	MK
1 Card Reader	By Security Contractor	OT
2 Position Switch	DPS-M-GY	SU
1 Shared Power Supply	AQ series as req'd	SU

Doors can be placed in hold-open position as needed by electronic wall magnets. Magnets must be integrated with fire alarm system and release in alarmed state.

When locked, entry to Unit D by valid input at reader to retract latch or manual key (active leaf). Free egress (both leafs) at all times.

Door position switches to monitor opening status. Exit devices have integral RX feature to signal egress. Coordinate with electrical and security contractors.

Set: 19.0

Doors: 155.1, 156.1

Description: Storeroom Function Egress x Closer w/ Stop

3	Hinge, Full Mortise	MPB79 x NRP (size per spec)	US26D	MK
1	Rim Exit Device (NL Lever)	6100 CR627F A600 Temp Core CMK	630	YA
1	Surface Closer w/ Stop	5821	689	YA
1	Kick Plate	K1050 10" HGT x CSK x BEV	US32D	RO
1	Gasketing	S88D		PE

Set: 20.0

Doors: 1246.1, 153.3

Description: Storeroom Function x Door Contact - Inswing

3 Hinge, Full Mortise	MPB79 (size per spec)	US26D	MK
1 Storeroom Lock	CRR 8805FL A620 Temp Core CMK	626	YA
1 Door Stop	400 series as req'd	US4	RO
3 Silencer	608 / 608CA as req'd		RO
1 Position Switch	DPS-M-GY		SU

Notes:

Door position switch to monitor opening status as required.

Set: 21.5

Doors: 1542, 1659.1

Description: Storeroom Function - Inswing - Fire Rated

6 Hinge, Full Mortise, Hvy Wt	MPB68 (size per spec)	US26D	MK
1 Storeroom Lock	CRR 8805FL A620 Temp Core CMK	626	YA
2 Surface Closer	3501 / PR3501 as req'd	689	YA
2 Door Stop	400 series as req'd	US4	RO
1 Gasketing	S88D		PE

Set: 21.0

Doors: 105, 109, 1127, 132, 137, 140, 142, 1503, 154.1, 1604, 1611, 1650 ALT D1 Description: Storeroom Function - Inswing

3 Hinge, Full Mortise	MPB79 (size per spec)	US26D	MK
1 Storeroom Lock	CRR 8805FL A620 Temp Core CMK	626	YA
1 Door Stop	400 series as req'd	US4	RO
3 Silencer	608 / 608CA as req'd		RO

Set: 21.5

Doors: 1542, 1659.1 Description: Storeroom Function - Inswing - Fire Rated

6 Hinge, Full Mortise, Hvy Wt	MPB68 (size per spec)	US26D	MK
1 Storeroom Lock	CRR 8805FL A620 Temp Core CMK	626	YA
2 Surface Closer	3501 / PR3501 as req'd	689	YA
2 Door Stop	400 series as req'd	US4	RO
1 Gasketing	S88D		PE

Set: 22.0

Doors: 1533

Description: Storeroom Function x Armor Plate - Inswing

3 Hinge, Full Mortise	MPB79 (size per spec)	US26D	MK
1 Storeroom Lock	CRR 8805FL A620 Temp Core CMK	626	YA
1 Armor Plate	K1050 34" HGT x CSK x BEV	US32D	RO
1 Door Stop	400 series as req'd	US4	RO
3 Silencer	608 / 608CA as req'd		RO

Set: 23.0

Doors: 152.1, 157.2

Description: Storeroom Function x Door Contact - Outswing

3 Hinge, Full Mortise	MPB79 x NRP (size per spec)	US26D	MK
1 Storeroom Lock	CRR 8805FL A620 Temp Core CMK	626	YA
1 Door Stop	400 series as req'd	US4	RO
3 Silencer	608 / 608CA as req'd		RO
1 Position Switch	DPS-M-GY		SU

Notes:

Door position switch to monitor opening status as required.

Set: 23.5

Doors: 152.3, 153.1, 158.2, 1661.2, 1661.3

Description: Storeroom Function x Door Contact - Fire Rated

3 Hinge, Full Mortise	MPB79 x NRP (size per spec)	US26D	MK
1 Storeroom Lock	CRR 8805FL A620 Temp Core CMK	626	YA
1 Surface Closer	3501 / PR3501 as req'd	689	YA
1 Kick Plate	K1050 10" HGT x CSK x BEV	US32D	RO
1 Door Stop	400 series as req'd	US4	RO
1 Gasketing	S88D		PE
1 Position Switch	DPS-M-GY		SU

Notes: Door position switch to monitor opening status as required.

Set: 24.0

Doors: 1128A, 1128B, 113, 1520, 1524, 1527, 1531A, 1535, 1540, 1606, 1607, 1612.3 Description: Storeroom Function - Outswing

3 Hinge, Full Mortise	MPB79 x NRP (size per spec)	US26D	MK
1 Storeroom Lock	CRR 8805FL A620 Temp Core CMK	626	YA
1 Door Stop	400 series as req'd	US4	RO
3 Silencer	608 / 608CA as req'd		RO

Set: 24.5

Doors: 1658 ALT D1, 1659, 2601A, 2602

Description: Storeroom Function x Closer

3 Hinge, Full Mortise	MPB79 x NRP (size per spec)	US26D	MK
1 Storeroom Lock	CRR 8805FL A620 Temp Core CMK	626	YA
1 Surface Closer	3501 / PR3501 as req'd	689	YA
1 Door Stop	400 series as req'd	US4	RO
3 Silencer	608 / 608CA as req'd		RO

Set: 25.0

Doors: 1509, 1514

Description: Storeroom Function x Overhead Stop - Outswing

3 Hinge, Full Mortise	MPB79 x NRP (size per spec)	US26D	MK
1 Storeroom Lock	CRR 8805FL A620 Temp Core CMK	626	YA
1 Surf Overhead Stop	10-336	652	RF
3 Silencer	608 / 608CA as req'd		RO

Set: 26.0

Description: Storeroom Function x Overhead Stop

3 Hinge, Full Mortise	MPB79 x NRP (size per spec)	US26D	MK
1 Storeroom Lock	CRR 8805FL A620 Temp Core CMK	626	YA
1 Surf Overhead Stop	10-336	652	RF
3 Silencer	608 / 608CA as req'd		RO

Set: 27.0

Doors: 1502, 1659.5

Description: Storeroom Function Pair x Coordinator x Closers w/ Stop - Fire Rated

6 Hinge, Full Mortise	MPB79 (size per spec)	US26D	MK
1 Flush Bolt w/Fire Bolt	2848/2948 as req'd	US26D	RO
1 Storeroom Lock	CRR 8805FL A620 Temp Core CMK	626	YA
1 Coordinator	26XX for width x FB x WP	Black	RO
2 Mounting Brackets	2601	Black	RO
2 Surface Closer w/ Stop	3531	689	YA
1 Gasketing	S88D		PE
1 Metal Edge Astragal	By Door Mfr.		OT

Set: 27.5

Doors: 1612.1, 1612.2, 1644A.1, 1644A.2, 171.3 Description: Storeroom Function Pair

6 Hinge, Full Mortise	MPB79 (size per spec)	US26D	MK
2 Flush Bolt	555 / 557 as req'd	US26D	RO
1 Dust Proof Strike	570	US26D	RO
1 Storeroom Lock	CRR 8805FL A620 Temp Core CMK	626	YA
2 Door Stop	400 series as req'd	US4	RO
2 Silencer	608 / 608CA as req'd		RO
1 Metal Edge Astragal	By Door Mfr.		OT

Set: 28.0

Doors: 106, 106.2, 108, 110, 111, 116, 118, 118.2, 119, 1504 Description: Office Function

3 Hinge, Full Mortise	MPB79 (size per spec)	US26D	MK
1 Classroom or Office Lock	CRR 8809FL A620	626	YA
1 Door Stop	400 series as req'd	US4	RO
3 Silencer	608 / 608CA as req'd		RO

Set: 29.0

Description: Office Function x Overhead Stop

3 Hinge, Full Mortise	MPB79 (size per spec)	US26D	MK
1 Classroom or Office Lock	CRR 8809FL A620	626	YA
1 Surf Overhead Stop	10-336	652	RF
3 Silencer	608 / 608CA as req'd		RO

<u>Set: 29.5</u>

Doors: 1643, 1644.1, 1644.2 Description: Office Function - Fire Rated

3 Hinge, Full Mortise	MPB79 (size per spec)	US26D	MK
1 Classroom or Office Lock	CRR 8809FL A620	626	YA
1 Surface Closer	3501 / PR3501 as req'd	689	YA
1 Kick Plate	K1050 10" HGT x CSK x BEV	US32D	RO
1 Door Stop	400 series as req'd	US4	RO
1 Gasketing	S88D		PE

Set: 30.0

Doors: 117.2, 124, 125.2 Description: Classroom Function

3 Hinge, Full Mortise	MPB79 (size per spec)	US26D	MK
1 Classroom Lock	CRR 8808FL A620 Temp Core CMK	626	YA
1 Door Stop	400 series as req'd	US4	RO
3 Silencer	608 / 608CA as req'd		RO

<u>Set: 30.5</u>

Doors: 144.1, 144.2 Description: Classroom Function x Door Contact

3 Hinge, Full Mortise	MPB79 (size per spec)	US26D	MK
1 Classroom Lock	CRR 8808FL A620 Temp Core CMK	626	YA
1 Door Stop	400 series as req'd	US4	RO
3 Silencer	608 / 608CA as req'd		RO
1 Position Switch	DPS-M-GY		SU

Notes: Door position switch to monitor opening status.

Set: 30.7

Doors: 128.1, 128.2, 131.1, 131.2

Description: Classroom Function x Closer

3 Hinge, Full Mortise	MPB79 (size per spec)	US26D	MK
1 Classroom Lock	CRR 8808FL A620 Temp Core CMK	626	YA
1 Surface Closer	3501 / PR3501 as req'd	689	YA
1 Door Stop	400 series as req'd	US4	RO
3 Silencer	608 / 608CA as req'd		RO

Set: 31.0

Doors: 101, 102, 104, 114, 122, 123, 133, 148, 1515, 2604

Description: Privacy Function w/ Indicator x Closer

3 Hinge, Full Mortise	MPB79 (size per spec)	US26D	MK
1 Privacy Lock	CRR 8802FL IND	626	YA
1 Surface Closer	3501 / PR3501 as req'd	689	YA
1 Kick Plate	K1050 10" HGT x CSK x BEV	US32D	RO
1 Door Stop	400 series as req'd	US4	RO
1 Gasketing	S88D		PE

Notes: Supply qty (4) hinges on doors taller than 7'10".

Set: 32.0

Doors: 156.2 Description: Passage Function x Closer x HW Hinges

3 Hinge, Full Mortise, Hvy Wt	MPB68 (size per spec)	US26D	MK
1 Passage Latch	CRR 8801FL	626	YA
1 Surface Closer	3501 / PR3501 as req'd	689	YA
1 Door Stop	400 series as req'd	US4	RO
3 Silencer	608 / 608CA as req'd		RO

Set: 33.0

Doors: 107, 115 Description: Passage Function

3 Hinge, Full Mortise	MPB79 (size per spec)	US26D	MK
1 Passage Latch	CRR 8801FL	626	YA
1 Door Stop	400 series as req'd	US4	RO
3 Silencer	608 / 608CA as req'd		RO

<u>Set: 33.5</u>

Doors: 100A.2

Description: Interior Aluminum Storefront - Push / Pull Function x Auto-Door

2 Continuous Hinge (AL)	CFMxxSLF-HD1		PE
2 Push Pull Set	RM251	US32D	RO
2 Conc Overhead Stop	6-336	630	RF
1 Surface Closer	TJ3301	689	YA
1 Automatic Opener	6061 D SN-134	689	NO
1 ADA Switch / Jamb Mount	503		NO
1 ADA Switch / Wall Mount	505		NO
1 Seals, Sweeps & Astragal(s)	by Aluminum Door Supplier		OT

Notes: Push / Pull operation. Auto door (active leaf) by ADA switches. Coordinate with electrical contractor.

Set: 34.0

Description: Push / Pull Function

3 Hinge, Full Mortise	MPB79 (size per spec)	US26D	MK
1 Pull Plate	BF 111x70C	US32D	RO
1 Push Plate	70F (flush) / 70C (lite)	US32D	RO
1 Surface Closer	3501 / PR3501 as req'd	689	YA
1 Kick Plate	K1050 10" HGT x CSK x BEV	US32D	RO
1 Door Stop	400 series as req'd	US4	RO
3 Silencer	608 / 608CA as req'd		RO

<u>Set: 35.0</u>

Description: Push / Pull Function x Door Contact

3 Hinge, Full Mortise	MPB79 (size per spec)	US26D	MK
1 Pull Plate	BF 111x70C	US32D	RO
1 Push Plate	70F (flush) / 70C (lite)	US32D	RO
1 Surface Closer	3501 / PR3501 as req'd	689	YA
1 Kick Plate	K1050 10" HGT x CSK x BEV	US32D	RO
1 Door Stop	400 series as req'd	US4	RO
3 Silencer	608 / 608CA as req'd		RO

Notes: Door position switch to monitor opening status as required.

END OF SECTION 087100

SECTION 09 97 26

CEMENTITIOUS COATINGS

PART 1 - GENERAL

1.1 RELATED DOCUMENTS

A. Drawings and general provisions of the Contract, including General and Supplementary Conditions and Division 01 Specification Sections, apply to this Section.

1.2 SUMMARY

- A. Section includes surface preparation and application of cementitious coating systems on the following substrates:
 - 1. Exterior Interior concrete.
 - 2. Exterior Interior concrete masonry units.
 - 3. Exterior Interior brick.

1.3 ACTION SUBMITTALS

- A. Product Data: For each type of product indicated.
- B. Samples for Initial Selection: For each finish coat indicated.
- C. Samples for Verification: In each color and gloss of finish coat indicated.
 - 1. Submit Samples on actual substrate, not less than 4 by 8 inches
 - 2. Step coats on Samples to show each coat required for system.
 - 3. Label each coat of each Sample.

1.4 INFORMATIONAL SUBMITTALS

- A. Material Certificates: For each cementitious coating, from manufacturer.
- B. Product Test Reports: Based on evaluation of comprehensive tests performed by manufacturer and witnessed by a qualified testing agency or by a qualified testing agency, for each product formulation.

1.5 MAINTENANCE MATERIAL SUBMITTALS

A. Furnish extra materials that are from same production run (batch mix) as materials applied and that are packaged with protective covering for storage and identified with labels describing contents.

1. Quantity: Furnish an additional 5 percent of each color applied.

1.6 QUALITY ASSURANCE

- A. Source Limitations: Obtain cementitious coating materials from single source from single manufacturer.
- B. Mockups: Apply benchmark samples of coating system indicated and each color and finish selected to verify preliminary selections made under sample submittals and to demonstrate aesthetic effects and set quality standards for materials and execution.
 - 1. Architect will select one actual substrate of each type to represent surfaces and conditions for application of coating.
 - a. Wall Surfaces: Prepare samples of at least 100 sq. ft.
 - 2. Apply benchmark samples after permanent lighting and other environmental services have been activated.
 - 3. Final approval of color selections will be based on benchmark samples.
 - a. If preliminary color selections are not approved, apply additional benchmark samples of additional colors selected by Architect at no added cost to Owner.

1.7 DELIVERY, STORAGE, AND HANDLING

- A. Deliver materials to Project site in manufacturer's original, new, unopened packages and containers bearing manufacturer's name and label, and the following information:
 - 1. Product name or title of material.
 - 2. Manufacturer's stock number and date of manufacture.
 - 3. Contents by volume, for pigment and vehicle constituents.
 - 4. Application instructions.
 - 5. Color name and number.
 - 6. Handling instructions and precautions.
- B. Store materials not in use in tightly covered containers in a well-ventilated area at a minimum ambient temperature of 45 deg F. Maintain containers used in storage of coatings in a clean condition, free of foreign materials and residue.
 - 1. Protect cementitious coating materials from freezing. Keep materials dry and storage area neat and orderly. Remove waste daily. Take necessary measures to ensure that workers and work areas are protected from health hazards resulting from handling, mixing, and applying the coating.

1.8 PROJECT CONDITIONS

A. Apply coatings only when temperature of surfaces to be painted and ambient air temperatures are between 50 and 95 deg F.

B. Do not apply coatings when relative humidity exceeds 85 percent; at temperatures less than 5 deg F above the dew point; or to damp or wet surfaces.

PART 2 - PRODUCTS

2.1 CEMENTITIOUS COATINGS

- A. Polymer-Modified Cementitious Coating: Containing portland cement, polymer, and hydrated lime or aggregates.
 - 1. Products: Subject to compliance with requirements, provide the following:
 - a. BASF Building Systems; Thoroseal with Acryl 60.
 - b. Bonsal American, an Oldcastle company; Sure-Coat.
 - c. Euclid Chemical Company, Tamms Industries; Tamoseal.
 - d. Fox Industries, Inc.; FX-214.
 - e. Gemite Products, Inc.; Cem-Kote ST.
 - f. Silpro Corporation; Seal Cote.
- B. Performance Requirements: Comply with the following:
 - 1. Compressive Strength: Not less than 3500 psi at 28 days according to ASTM C 109/C 109M.
 - 2. Tensile Strength: Not less than 350 psi at 28 days according to ASTM C 109/C 109M.
 - 3. Salt-Spray Resistance: ASTM B 117. No blistering, cracking or delamination of film. No visible damage to coating or substrate after 5,000 hours.
- C. Other Materials: Provide crack fillers, block fillers, and related materials that are compatible with cementitious finish-coat materials and substrates indicated, under conditions of service and application as demonstrated by manufacturer, based on testing and field experience.
- D. VOC Content: Products shall comply with VOC limits of authorities having jurisdiction and, for coatings applied at Project site, the following VOC limits, exclusive of colorants added to a tint base, when calculated according to 40 CFR 59, Subpart D (EPA Method 24).
 - 1. Flat Paints and Coatings: 50 g/L.
 - 2. Nonflat Paints and Coatings: 150 g/L.
 - 3. Primers, Sealers, and Undercoaters: 200 g/L.
- E. Low-Emitting Materials: Interior paints and coatings shall comply with the testing and product requirements of the California Department of Health Services' "Standard Practice for the Testing of Volatile Organic Emissions from Various Sources Using Small-Scale Environmental Chambers."
- F. Colors: As selected by Architect from manufacturer's full range.

PART 3 - EXECUTION

3.1 EXAMINATION

- A. Examine substrates and conditions, with Applicator present, for compliance with requirements and other conditions affecting performance of the Work.
- B. Verify suitability of substrates, including surface conditions and compatibility.
- C. Begin coating application only after unsatisfactory conditions have been corrected and surfaces are dry.
 - 1. Beginning coating application constitutes Contractor's acceptance of substrates and conditions.

3.2 PREPARATION

- A. Comply with manufacturer's written instructions for mixing and preparing materials and as applicable to substrates indicated.
- B. Remove plates, machined surfaces, and similar items already in place that are not to be coated. If removal is impractical or impossible because of size or weight of item, provide surface-applied protection before surface preparation and coating.
 - 1. After completing coating operations, use workers skilled in the trades involved to reinstall items that were removed. Remove surface-applied protection if any.
- C. Clean substrates of substances that could impair bond of coatings, including dirt, oil, grease, incompatible coatings, and loose substrate materials.
- D. Cementitious and Masonry Surfaes: Remove release agents, curing compounds, efflorescence, and chalk. Do not paint surfaces if moisture content or alkalinity of surfaces to be painted exceeds that permitted in manufacturer's written instructions.
- E. Crack Repair: Fill cracks according to manufacturer's written instructions before coating surfaces.
 - 1. Cracks Larger Than 1/32 Inch: Cut out static cracks, voids, or honeycombing larger than 1/32 inch and patch with materials recommended in writing by coating manufacturer. Identify dynamic cracks and treat according to manufacturer's written instructions before beginning application.

3.3 APPLICATION

A. Apply coatings according to manufacturer's written instructions. Use applicators and techniques suited for coating and substrate indicated.

- 1. Dampen substrate of surfaces to receive cementitious coatings one hour before beginning application to prevent surface drag. Immediately before applying coatings, redampen substrate. Substrates shall be saturated surface dry at time of application.
- 2. Brushes: Use tampico or masonry brushes best suited for material being applied.
- 3. Spray Equipment: Use spray equipment recommended in writing by manufacturer for material and texture required.
- B. Apply each material at not less than manufacturer's recommended spreading rate. Provide total cured material thickness indicated or as recommended in writing by manufacturer.
- C. Brush Application: Brush-out and work brush coats into surfaces in an even film, filling all pores and voids at rate recommended in writing by manufacturer to achieve cured material thickness indicated. Finish coat with smooth, horizontal strokes.
- D. Spray Application: Apply each coat according to manufacturer's written instructions to provide the equivalent hiding of brush-applied coats. Follow spray application with a general light brooming of coated surface to impart a slight texture.

3.4 FIELD QUALITY CONTROL

- A. Testing of Coating Materials: Owner reserves the right to invoke the following procedure at any time and as often as Owner deems necessary during the period when coating operations are being conducted:
 - 1. Owner will engage the services of a qualified testing agency to sample coating materials being used. Samples of material delivered to Project site will be taken, identified, sealed, and certified in presence of Contractor.
 - 2. Testing agency will perform tests for compliance with the following product requirements.
 - a. Quantitative material analysis.
 - b. Compressive strength.
 - c. Tensile strength.
 - d. Flexural strength.
 - e. Permeance.
 - f. Accelerated weathering.
 - 3. Owner may direct Contractor to stop coating application if test results show materials being used do not comply with requirements. Contractor shall remove noncomplying materials from Project site, pay for testing, and recoat surfaces coated with rejected materials. Contractor will be required to remove rejected materials from previously coated surfaces if, on recoating with complying materials, the two coatings are incompatible.

3.5 CLEANING AND PROTECTION

- A. At end of each workday, remove rubbish, empty cans, rags, and other discarded materials from Project site.
- B. After completing coating application, clean spattered surfaces. Remove spattered coatings by washing, scraping, or other methods. Do not scratch or damage adjacent finished surfaces.
- C. Protect work of other trades against damage from coating application. Correct damage to work of other trades by cleaning, repairing, replacing, and refinishing, as approved by Architect, and leave in an undamaged condition.
- D. At completion of construction activities of other trades, touch up and restore damaged or defaced coated surfaces.

3.6 COATING SCHEDULE

- A. General: Apply additional coats when undercoats or other conditions show through final coat until cured film is of uniform coating finish, color, and appearance.
- B. Above-Grade Concrete and Masonry: Two finish coats with total cured thickness not less than 40 mils.
 - 1. First Coat: Apply polymer-modified cementitious coating material at the rate of 2 lb/sq. yd. to achieve a total cured thickness of 25 mils.
 - 2. Second Coat: Apply polymer-modified cementitious coating material at the rate of 1 lb/sq. yd. to achieve a total cured thickness of 15 mils.
- C. Surfaces Previously Coated with Polymer-Modified Cementitious Coating: One finish coat with a total cured thickness of not less than 15 mils.
 - 1. Apply polymer-modified cementitious coating material at the rate of 1 lb/sq. yd. to achieve a total cured thickness of 15 mils.

END OF SECTION 099726

SECTION 10 51 13

METAL LOCKERS

PART 1 - GENERAL

1.1 RELATED DOCUMENTS

A. Drawings and general provisions of the Contract, including General and Supplementary Conditions and Division 01 Specification Sections, apply to this Section.

1.2 SUMMARY

- A. Section Includes:
 - 1. Welded lockers.
 - 2. Locker benches.

1.3 ACTION SUBMITTALS

- A. Product Data: For each type of metal locker.
 - 1. Include construction details, material descriptions, dimensions of individual components and profiles, and finishes for each type of metal locker and bench.
- B. Shop Drawings: For metal lockers.
 - 1. Include plans, elevations, sections, details, and attachments to other work.
 - 2. Show locker trim and accessories.
 - 3. Include locker identification system and numbering sequence.
- C. Samples for Initial Selection: Manufacturer's color charts showing the full range of colors available.

1.4 CLOSEOUT SUBMITTALS

A. Maintenance Data: For adjusting, repairing, and replacing locker doors and latching mechanisms to include in maintenance manuals.

1.5 MAINTENANCE MATERIAL SUBMITTALS

A. Furnish extra materials that match products installed and that are packaged with protective covering for storage and identified with labels describing contents.

- 1. Full-size units of the following metal locker hardware items equal to 10 percent of amount installed for each type and finish installed, but no fewer than five units:
 - a. Identification plates.
 - b. Hooks.

1.6 DELIVERY, STORAGE, AND HANDLING

A. Do not deliver metal lockers until spaces to receive them are clean, dry, and ready for their installation.

1.7 FIELD CONDITIONS

A. Field Measurements: Verify actual dimensions of recessed openings by field measurements before fabrication.

1.8 COORDINATION

- A. Coordinate sizes and locations of wood bases for metal lockers.
- B. Coordinate sizes and locations of framing, blocking, furring, reinforcements, and other related units of work specified in other Sections to ensure that metal lockers can be supported and installed as indicated.

1.9 WARRANTY

- A. Special Warranty: Manufacturer agrees to repair or replace components of metal lockers that fail in materials or workmanship, excluding finish, within specified warranty period.
 - 1. Failures include, but are not limited to, the following:
 - a. Structural failures.
 - b. Faulty operation of latches and other door hardware.
 - 2. Damage from deliberate destruction and vandalism is excluded.
 - 3. Warranty Period for Welded Metal Lockers: Lifetime from date of Substantial Completion.

PART 2 - PRODUCTS

2.1 PERFORMANCE REQUIREMENTS

A. Accessibility Requirements: For lockers indicated to be accessible, comply with applicable provisions in the U.S. Architectural & Transportation Barriers Compliance Board's ADA-ABA Accessibility Guidelines.

2.2 WELDED LOCKERS

- A. Products: Subject to compliance with requirements, provide one of the following:
 - 1. DeBourgh Mfg. Co.
 - 2. List Industries Inc; Task Force XP.
 - 3. Penco Products, Inc; Patriot Duty Lockers All-Welded All-Welded Defiant Angle Iron Pro Tough Pro Tough Defiant.
 - 4. Tiffin Metal Products Company
 - 5. Scranton Tufftec Lockers
 - 6. Lyon All Welded Lockers
- B. Expanded-Metal Doors: Fabricated from 0.090-inch nominal-thickness expanded metal; welded to 0.105-inch nominal-thickness steel angle frame; with 0.090-inch nominal-thickness, steel sheet lock panel backed by 0.060-inch nominal-thickness, steel sheet retainer welded to door frame.
 - 1. Ventilation: 6inch wide by 3/4inch high horizontal louvers arranged in two groups of six.
- C. Body: Assembled by welding body components together. Fabricate from unperforated steel sheet with thicknesses as follows:
 - 1. Tops and Bottoms: 0.060-inch nominal thickness, with single bend at edges.
 - 2. Backs: 0.048-inch nominal thickness.
 - 3. Shelves: 0.060-inch nominal thickness, with double bend at front and single bend at sides and back.
- D. Unperforated Sides: Fabricated from 0.048-inch nominal-thickness steel sheet.
- E. Frames: Channel formed; fabricated from 0.060-inch nominal-thickness steel sheet or 0.097-inch nominal-thickness steel angles; lapped and factory welded at corners; with top and bottom main frames factory welded into vertical main frames. Form continuous, integral, full-height door strikes on vertical main frames.
- F. Reinforced Bottoms: Structural channels, formed from nominal-thickness steel sheet; welded to front and rear of side-panel frames.
- G. Hinges: Welded to door and attached to door frame with no fewer than two factoryinstalled rivets per hinge that are completely concealed and tamper resistant when door is closed; fabricated to swing 180 degrees.

- 1. Continuous Hinges: Manufacturer's standard, steel; side or top mounted as required by locker configuration.
- H. Projecting Turn-Handle and Latch: Steel handle welded to manufacturer's standard, three-point, cremone-type latching mechanism consisting of steel rods or bars that engage locker frame at top and bottom of door, and center latch that engages strike jamb; with steel padlock loop.
- I. Identification Plates: Manufacturer's standard, etched, embossed, or stamped plates, with numbers and letters at least 3/8 inch high.
- J. Hooks: Manufacturer's standard ball-pointed type, aluminum or steel; zinc plated.
- K. Coat Rods: Manufacturer's standard.
- L. Coat Rods: diameter steel, .
- M. Filler Panels: Fabricated from 0.048-inch nominal-thickness steel sheet.
- N. Materials:
 - 1. Cold-Rolled Steel Sheet: ASTM A 1008/A 1008M, Commercial Steel (CS), Type B, suitable for exposed applications.
- O. Finish: Baked enamel or powder coat.
 - 1. Color: As selected by Architect from manufacturer's full range.

2.3 LOCKER BENCHES

- A. Provide bench units with overall assembly height of 17-1/2 inches.
- B. Bench Tops: Manufacturer's standard one-piece units, with rounded corners and edges.
 - 1. Size: Minimum 9-1/2 inches wide by 1-1/4 inches thick except provide minimum 20-inch- wide tops where accessible benches are indicated.
 - 2. Laminated clear hardwood with one coat of clear sealer on all surfaces and one coat of clear lacquer on top and sides.
- C. Fixed Pedestals: Manufacturer's standard supports, with predrilled fastener holes for attaching bench top and anchoring to floor, complete with fasteners and anchors, and as follows:
 - 1. Tubular Steel: 1-1/2-inch- diameter steel tubing threaded on both ends, with standard pipe flange at top and bell-shaped cast-iron base; with baked-enamel or powder-coat finish; anchored with exposed fasteners.
 - a. Color: Match metal lockers.

2.4 FABRICATION

- A. Fabricate metal lockers square, rigid, without warp, and with metal faces flat and free of dents or distortion. Make exposed metal edges safe to touch and free of sharp edges and burrs.
 - 1. Form body panels, doors, shelves, and accessories from one-piece steel sheet unless otherwise indicated.
 - 2. Provide fasteners, filler plates, supports, clips, and closures as required for complete installation.
- B. Fabricate each metal locker with an individual door and frame; individual top, bottom, and back; and common intermediate uprights separating compartments. Factory weld frame members of each metal locker together to form a rigid, one-piece assembly.
- C. Locker Configuration: As indicated on Drawings.
- D. Welded Construction: Factory preassemble metal lockers by welding all joints, seams, and connections; with no bolts, nuts, screws, or rivets used in assembly of main locker groups. Factory weld main locker groups into one-piece structures. Grind exposed welds flush.
- E. Continuous Base: Formed into channel or zee profile for stiffness, and fabricated in lengths as long as practical to enclose base and base ends of metal lockers; finished to match lockers.
- F. Filler Panels: Fabricated in an unequal leg angle shape; finished to match lockers. Provide slip-joint filler angle formed to receive filler panel.
- G. Finished End Panels: Designed for concealing unused penetrations and fasteners, except for perimeter fasteners, at exposed ends of nonrecessed metal lockers; finished to match lockers.
 - 1. Provide one-piece panels for double-row (back-to-back) locker ends.

2.5 ACCESSORIES

- A. Fasteners: Zinc- or nickel-plated steel, slotless-type, exposed bolt heads; with self-locking nuts or lock washers for nuts on moving parts.
- B. Anchors: Material, type, and size required for secure anchorage to each substrate.
 - 1. Provide nonferrous-metal or hot-dip galvanized anchors and inserts on inside face of exterior walls for corrosion resistance.
 - 2. Provide toothed-steel or lead expansion sleeves for drilled-in-place anchors.

PART 3 - EXECUTION

3.1 EXAMINATION

- A. Examine walls, floors, and support bases, with Installer present, for compliance with requirements for installation tolerances and other conditions affecting performance of the Work.
- B. Prepare written report, endorsed by Installer, listing conditions detrimental to performance of the Work.
- C. Proceed with installation only after unsatisfactory conditions have been corrected.

3.2 INSTALLATION

- A. General: Install lockers level, plumb, and true; shim as required, using concealed shims.
 - 1. Anchor locker runs at ends and at intervals recommended by manufacturer, but not more than 36 inches o.c. Using concealed fasteners, install anchors through backup reinforcing plates, channels, or blocking as required to prevent metal distortion.
 - 2. Anchor single rows of metal lockers to walls near top and bottom of lockers.
 - 3. Anchor back-to-back metal lockers to floor.
- B. Welded Lockers: Connect groups together with standard fasteners, with no exposed fasteners on face frames.
- C. Equipment:
 - 1. Attach hooks with at least two fasteners.
 - 2. Attach door locks on doors using security-type fasteners.
 - 3. Identification Plates: Identify metal lockers with identification indicated on Drawings.
 - a. Attach plates to each locker door, near top, centered, with at least two aluminum rivets.
 - b. Attach plates to upper shelf of each open-front metal locker, centered, with a least two aluminum rivets.
- D. Trim: Fit exposed connections of trim, fillers, and closures accurately together to form tight, hairline joints, with concealed fasteners and splice plates.
 - 1. Attach recess trim to recessed metal lockers with concealed clips.
 - 2. Attach filler panels with concealed fasteners. Locate filler panels where indicated on Drawings.
 - 3. Attach sloping-top units to metal lockers, with closures at exposed ends.
 - 4. Attach boxed end panels using concealed fasteners to conceal exposed ends of nonrecessed metal lockers.

- 5. Attach finished end panels using fasteners only at perimeter to conceal exposed ends of nonrecessed metal lockers.
- E. Fixed Locker Benches: Provide no fewer than two pedestals for each bench, uniformly spaced not more than 72 inches apart. Securely fasten tops of pedestals to undersides of bench tops, and anchor bases to floor.
- F. Freestanding Locker Benches: Place benches in locations indicated on Drawings.

3.3 ADJUSTING

A. Clean, lubricate, and adjust hardware. Adjust doors and latches to operate easily without binding.

3.4 PROTECTION

- A. Protect metal lockers from damage, abuse, dust, dirt, stain, or paint. Do not permit use during construction.
- B. Touch up marred finishes or replace metal lockers that cannot be restored to factoryfinished appearance. Use only materials and procedures recommended or furnished by locker manufacturer.

END OF SECTION

SECTION 11 19 30

SECURITY HARDWARE AND SLIDING DOOR DEVICES

PART 1 - GENERAL

1.1 SUMMARY

- A. Detention Equipment Contractor (DEC) shall furnish plant and field labor, equipment, appliances, services and materials, perform work and otherwise assume all responsibility related to fabrication and installation of detention equipment indicated in this section.
- B. DEC shall coordinate with installation of electronic security automation systems provided under Division 8 in strict compliance with Contract Documents.

1.2 SECTION INCLUDES ALL HARDWARE REQUIRED FOR PROPER OPERATION OF SECURITY AND DETENTION DOORS

- A. Detention hardware and locking devices.
 - 1. Swinging detention doors.
 - 2. Sliding detention doors.
 - 3. Security access panels.
 - 4. Security roof hatches.
 - 5. Key cabinets.
 - 6. As required by the contract documents.
- B. Builders' hardware and accessories for detention doors and frames.
- C. Appurtenances for detention doors, frames and partitions.
- D. Coordinate with installation of electronic security automation systems provided under Division 28.

1.3 RELATED WORK TO BE PERFORMED BY OTHERS

- A. Division 9 Finishes
 - 1. Remove foreign materials such as mortar, plaster, concrete, waterproofing and dust from surfaces of hardware prior to finish painting.
 - 2. Retouch shop coat of rust inhibiting primer paint and finish paint hardware after installation and final adjustment.
 - 3. Complete floor finishes, waterproofing, plastering and painting on or near detention equipment after installation and final adjustment.
- B. Division 11
 1. 11 19 20 Detention Hollow Metal Doors and Frames

- 2. 11 19 40 Detention Security Windows
- 3. 11 19 50 Detention and Security Glass and Glazing
- C. Division 28 Security Electronics

1.4 SUBMITTALS

- A. Submit shop drawings for approval prior to fabrication and delivery of materials or products.
- B. Provide CADD-generated drawings:
 - 1. Include dimensions, configurations of materials, and connection details required to clearly convey the proper relationship of detention equipment to work being performed by others.
 - 4. Show sizes, details of construction, assembly methods, hardware, and other details of items specified in this Section.
 - 3. Draw to scale of not less than 1/4 inch equals 1 foot for plans and 1 inch equals 1 foot for sections.
- C. Include following minimum requirements in initial submittal package:
 - 1. Keying plan:
 - a. Submit proposed keying plan for each floor of each building.
 - b. Identify room numbers and each detention door or piece of equipment to be operated by key.
 - c. Identify electrically controlled or operated doors with an "E" symbol.
 - d. Prefix lock types as follows: "P" for Paracentric, "M" for mogul, "C" for commercial and "HS" for high security.
 - e. Exclude dimensions and other equipment information from this plan.
 - 2. Hardware schedule:
 - a. Submit eight (8) copies. Include specification references and product comparisons.
 - b. Submit hardware on vertical schedule.
 - c. Indicate project name, location, Architect, GC, hardware suppliers and AHC preparing schedule.
 - d. Include hardware items proposed for use at each opening, as well as other hardware necessary to complete work of this Section.
 - e. Include for each item:
 - 1. Manufacturer's name, catalog number and type designation
 - 2. Quantities
 - 3. Size
 - 4. Finish
 - f. Indicate degree of opening for each door, Architect's hardware set number, finishes and substitutions proposed for specified items.
 - g. List doors required in this Section in numerical order and show keying proposed for each in accordance with keying plans.
 - h. Provide single samples of each item of hardware specified for use on this project. Samples will not be returned.

- 3. Failure to provide any part of minimum requirements described above will result in rejection of total submittal package.
- D. Discrepancies:
 - 1. Direct Architect's attention to any discrepancies between detention equipment drawings and Contract Drawings.
 - 2. Subsequent discrepancies that may be discovered by other contractors during construction are to be immediately reported to Architect and DEC for resolution.
 - 3. Other contractors shall not proceed with any work affecting detention equipment until such discrepancies are completely resolved.
- E. Architect will not coordinate drawings for composite parts of joint-venture efforts under this Section. Partial or separate drawing submittals for various components required herein will result in rejection of total submittal package.
- F. Provide drawings for field distribution and contract records after approval of all submittals.

1.5 TEST REPORTS

- A. Testing Laboratory:
 - 1. Independent testing laboratory capable of compliance with specifications of American Society for Testing and Materials (ASTM).
 - 2. Selected by DEC.
 - 3. Approved by Architect.
 - 4. Furnish certification and reports directly to DEC with copies for transmittal to Architect.
- B. DEC responsibilities:
 - 1. Absorb costs associated with testing.
 - Submit test reports to Architect prior to delivery of following materials to job site:
 a. Hardware.

1.6 REGULATORY REQUIREMENTS

- A. Perform work in compliance with latest editions of:
 - 1. Federal, state, and local codes and ordinances, or agencies having jurisdiction.
 - 2. National Electric Code, NFPA 70.

- 3. Standard for Fire Doors and Windows, NFPA 80.
- 4. Life Safety Code, NFPA 101-88.
- B. In cases where Specifications call for materials or construction of better quality or larger size than codes require, Specifications shall take preference. Codes shall govern in cases of direct conflict with Specifications or Contract Drawings.

1.7 DELIVERY, STORAGE AND HANDLING

- A. Packing and shipping:
 - 1. Wrap and crate finished components and assemblies at factory to prevent damage or marring of surface finishes during shipping and handling.
 - 2. Stretch-wrap locking and operating devices and control consoles to protect from dust and debris.
 - 3. Handle and transport detention equipment to job site carefully to prevent damage.
- B. Acceptance at site:
 - 1. Coordinate delivery of detention equipment embedded items with GC in accordance with construction progress and schedule to avoid delays.
 - 2. Coordinate size of building access and route to location of equipment installation with GC.
 - 3. Upon delivery, immediately inspect components and assemblies for damage and remove damaged items from job site. Damaged components will be rejected and will not be incorporated into the work.
 - 4. General Contractor:
 - a. Receive from carrier, unload, and store materials furnished under this section but not installed by DEC.
 - b. Install embedded items in correct locations, plumb, true, and to tolerances prescribed by DEC.
- C. Storage and protection:
 - 1. Provide adequate protection for products and materials during storage and installation.
 - 2. General Contractor:
 - a. Provide adequate protection for materials furnished under this section but not installed by DEC during storage and after installation.
 - b. Provide secure, dry storage area or room for DEC storage in each building and on each floor.

1.8 SEQUENCING AND SCHEDULING

- A. Submit detailed schedule of field installation activities to Architect or GC, as applicable at least two months before field installation is to begin. Include activities to describe all aspects of field installation.
- B. Submit revised schedule to Architect or GC, as applicable each month showing status of each activity and revised project completion date.

1.9 WARRANTY

- A. Prior to final acceptance, provide Owner with written warranty covering locking and operating devices furnished under this section for period of one (1) year from date of substantial completion. During this period, make necessary repairs and corrections to defects in Work and replace defective parts at no cost to Owner.
- B. Warranty does not cover consequential or incidental damages. Work made necessary by abuse, misuse, accidents, or negligence of using personnel is excluded from this agreement.
- B. Provide emergency service during warranty period, including maximum twenty-four (24) hour response time for emergency calls requiring visits to facility.
- C. Special Warranty: Manufacturer agrees to repair or replace components of detention door hardware that fail in materials or workmanship within specified warranty period.
 - 1. Failures include, but are not limited to, the following:
 - a. Structural failures including excessive deflection, cracking, or breakage.
 - b. Faulty operation of electrical and/or mechanical components.
 - c. Deterioration of metals, metal finishes, and other materials beyond normal weathering or detention use.
 - 2. Warranty Period for Security Door Closers: Ten (10) years from date of Substantial Completion.

1.10 MAINTENANCE MANUALS/SPARE PARTS

- A. Operating and maintenance manuals: Provide Owner with two (2) operating and maintenance manuals for locking and operating devices furnished and installed under this section. Clearly identify all parts and include manufacturer's standard part number for each component of various mechanisms.
- B. Spare Parts:
 - 1. Furnish one (1) complete spare set of right and left hand motors, gears, locks and switches for each type specified per hardware schedule.
 - 2. Pack parts in suitable containers and label clearly.
 - 3. Provide building maintenance department with two (2) of each type of special tools required

for installation, removal, or adjustment of hardware and equipment provided under this section.

1.11 KEYS FOR DETENTION LOCKS

- A. Provide for safekeeping of keys for locks provided under this section. Ensure that building security is not breached through job site loss or theft of keys being used for hardware installation or "fit-up" purposes.
- B. Die-stamp each key for detention locks with identification designated on approved keying schedule.
- C. Upon completion of Work and prior to final acceptance, present one (1) complete set of keys to Owner's designated representative and obtain a signed receipt. Send subsequent keys ordered to same individual via registered mail, return receipt requested.
- E. By no means shall any keys be turned over directly to the Contractor.
- F. Submit a total of five (5) sets of keys.

PART 2 - PRODUCTS

2.1 DETENTION HARDWARE AND LOCKING DEVICES

- A. Pre-qualified manufacturers:
 - 1. R.R. Brink Locking Systems, Shorewood, Illinois
 - 2. Southern Folger Detention Equipment Company, San Antonio, Texas
 - 3. Other Acceptable Manufacturers by product:

1.	Hinges:	Specified – NW Specialty Hardware Acceptable – Hager, Stanley	(NW)
2.	Electric Strikes:	Specified – HES Acceptable – Approved equal	(SU)
4.	Sliding Door Operators:	Specified – RR Brink Acceptable – Approved equal	(BR)
5.	Concealed Door Closers:	Specified – LCN Acceptable – Approved equal	(LC)
6.	Door Pulls:	Specified – NW Specialty Hardware Acceptable – Hager, Stanley	(NW)

7.	Thresholds and Gasket:	Specified – National Guard Products Acceptable – Hager, Design Hardware	(NG)
8.	Floor/Wall Stops:	Specified – NW Specialty Hardware Acceptable – Hager, Design Hardware	(NW)
9.	Switches:	Specified – RR Brink Acceptable – Approved equal	(BR)

B. Non-Prequalified Manufacturers:

- 1. Any Non-Prequalified Manufacturer who intends to submit a bid on this section of the Specifications shall submit the following data to the Architect in writing fourteen (14) days prior to bid date and shall be approved by addendum seven (7) days prior to bid date. Verbal approval will not satisfy this requirement. Grounds for disqualification shall exist if it is proven that the information submitted is inaccurate or, in the opinion of the Architect, does not satisfy the requirements.
 - a. Provide a narrative and historical description of the firm from inception, including history of ownership, partnership, incorporation, and/or other organizational information. Include information on the growth of the firm over time to include the number of employees, relocation(s) of the firm, major production equipment purchases and replacements.
 - b. List the firm's business volume (dollar amount) for the last five (5) fiscal years.
 - c. Provide a statement that the firm has been in business for a minimum of ten (10) continuous years, and the principals and key personnel that have been engaged in successfully providing procurement, management, installation and commissioning of security detention projects.
 - d. Provide a list of all employees in a supervisory capacity, stating their area of responsibility and their years of experience in that capacity.
 - e. Submit a list of all projects completed in the last ten (10) years.
 - f. Submit a list of five (5) projects that this corporation, under its current name, has built in the last five (5) years comparable in size and construction. Include in this list:
 - 1. Project Name, Owner, Contract Name, Address and Phone Number.
 - 2. Project Manager Name, Address and Phone Number.
 - 3. Using Agency Name, Address and Phone Number.
 - 4. Architect and Engineer of Record Name, Address and Phone Number.
 - 5. General Contractor and/or Construction Manager Name, Address and Telephone Number.
 - For each project listed provide the following:
 - 1. Name and location of project.

-7-

- 2. Type of project (state or federal prison, county or city jail)
- 3. Project delivery method (traditional, design/build, design/build, design/build/manage, general construction, construction manager, etc.)
- 4. Scope of the Project including total number of cells, total project

square footage, type of product and service provided on that project, and the total quantity of the contract.

5. Date of final completion and occupancy.

g. Submit a list of five (5) projects that this corporation, under its current name, has built in the last ten (10) years comparable in size and construction that have been in continuous operation for a minimum of five (5) years. Include in this list:

- 1. Project Name, Owner, Contact Name, Address and phone number.
- 2. Project Manager Name, Address and Phone Number.
- 3. Using Agency Name, Address and Phone Number.
- 4. Architect and Engineer of Record Name, Address and Phone Number.
- 5. General Contractor and/or Construction Manager Name, Address and Telephone Number.

For each project listed provide the following:

- 1. Name and location of project.
- 2. Type of project (state or federal prison, county or city jail)
- 3. Project delivery method (traditional, design/build, design/build, design/build/manage, general construction, construction manager, etc.)
- h. Provide an audited financial statement from a recognized accounting firm for the most recent fiscal year.
- i. Submit a listing of all projects in which the detention equipment contractor is presently or has been involved in litigation and the status thereof. In addition to this statement, please respond to the following questions A through G. For any "YES" answer to the following questions, please attach a separate sheet, which provides a brief explanation of the facts, names of the parties involved, dollar amount being claimed from your firm, and the present status of the case. Attach explanations of any lawsuit alleging negligent of defective work, or breach of contract on part of the firm. Do not include lien matters, automobile accident cases, or workman's compensation cases:
 - 1. Has a court issued a judgment of \$50,000.00 of more against the firm or its predecessors in the past five (5) years?
 - YES _____NO
 Has the firm or its predecessors been party to the settlement of a lawsuit with a potential value of \$50,000.00 or more? _____NO
 Is the firm or its predecessors currently a party to a pending lawsuit with a potential value of \$50,000.00 or more?
 - 4. YES NO In the past five years, has any key person, the firm or its predecessors
 - defaulted on a loan?
 YES NO
 5. Has the firm of its predecessors or any person of the firm or its predecessors
 - Final the firm of its predecessors of any person of the firm of its predecessors ever been suspended or debarred by a state, federal or municipal agency? $\frac{\text{YES}}{1-d} = \frac{\text{NO}}{1-d} = \frac{1}{2} \frac$
 - In the past five (5) years, has the firm or its predecessors been terminated on or failed to complete any contract? YES NO

- j. Submit a statement that you will conform with the following in regard to project coordination, procurement, schedules, and delivery of materials necessary to complete your scope of work.
 - 1. The Manufacturer must complete the submittal package of all items listed below within six weeks of written notice to proceed.
 - a. Hardware Schedule including wiring diagram and templates.
 - The submitted manufacturers must commit in writing to the following schedule. The Architect or Construction Manager maintains the right to make adjustments to the schedule prior to contract execution.
 Shipment of all detention door hardware within twelve (12) week
 - a. Shipment of all detention door hardware within twelve (12) weeks.
- C. Key cylinders and tumbler sets:
 - 1. Each paracentric key lock will include six (6) lever tumblers. Maximum clearance between tumbler gate and locking fence is 0.31 inches. Fit tumblers to allow for .025 inches of wear before the replacement of a key is required. Tumblers shall be spring temper bronze alloy C-26000 with notched gate edge.
 - 2. Mogul pin tumbler cylinder shall be brass, 2 inches in diameter, with stainless steel balls, tumblers and springs. Cylinders to comply with UL 437 and be labeled by nationally recognized independent testing laboratory.
- D. Paracentric keys:
 - 1. Material: Silicon bronze/copper alloy with tensile strength of 60,000 psi, yield strength of 20,000 psi and Rockwell hardness of B-73/75.
 - 2. Stamp with key code as directed.
 - 3. Furnish five (5) keys for each code.
- E. Mogul keys:
 - 1. Material: Stamp from CDA-78200 hard temper alloy with Rockwell hardness of B-85.
 - 2. Stamp with key code as directed.
 - 3. Furnish five (5) keys per code.
- F. Detention hinges:
 - 1. Type: Door Hinges Basis of design: NW 645FMST
 - 1. Full mortise with hospital tip and security studs.
 - 2. Material: Investment cast stainless steel.
 - 3. Size: 4-1/2" x 4-1/2" x 3/16" thick.
 - 4. Pin: Stainless Steel; Concealed & Non-Removable; cross-pinned after assembly to make disassembly impossible.
 - 5. Bearings: Self-lubricating, engineered thermo-plastic, flange type design to support

thrust and radial loads.

- 6. Capacity: 300lb Door (3 Hinges).
- Quantity: 3 each up to 3'0" x 7'4"; Furnish one additional hinge for openings over 7'-4" high and for each additional 2'-6" of opening height and for openings over 3'-0" wide.
- 8. Fasteners: $\frac{1}{4}$ -20 x $\frac{1}{2}$ " #30 Torx head.
- 9. Certification: ANSI/BHMA A156.7 and ASTM F1758-03 Grade 1 criteria.
- 2. Type: Food Pass/Cuff Port Hinges Basis of design NW 631FPB
 - 1. Material: Formed Steel Plate.
 - 2. Size: 3" x 4" x 1/4" thick.
 - 3. Pin: Fully welded and ground to appear solid.
 - 4. Bearings: Plain bearing.
 - 5. Fasteners: Security Flat Hd, 3/8-16 x 3/4".
- G. Door closers Basis of design: LCN 2210 Series
 - 1. Vandal resistant design for concealed mounting.
 - 2. Handed for right or left swinging doors.
 - 3. Closers to meet ADA reduced opening force requirements.
 - 4. All closers furnished with Torx tamper resistant machine screws
 - 5. Full rack and pinion hydraulic action.
 - 6. UL certified for three hours in compliance with UL10C.
 - 7. 15-year warranty.
- H. Door position indicator switch: (Basis of Design RR Brink #201020 or 201023)
 - 1. Furnish magnetic concealed door position switches, Triple-Biased (201023) where specified. Switch is single pole double throw type with rating of .5 amps at 24V maximum.
- I. Door Pulls:
 - 1. Combo Pull: As specified in the hardware sets: NWSH NW701
 - 2. Loop Pull: As specified in the hardware sets: NWSH NW 601
 - 3. Recessed Pull: By SHM Mfr. Same material as skin.
- J. Miscellaneous Hardware:
 - 1. Provide silencers in metal door frames, unless not permitted for fire rating, or unless bumper-type weatherstripping is provided; three per single door frame, two per double door frame. All exterior doors to have bumper type weatherstripping.
 - 2. Threshold and weather seal: As specified in hardware sets.
- K. Mechanical lever tumbler locks:

- 1. General: Lever tumbler locks shall operate with paracentric key. Key all lever tumbler locks into one keying system. Key locks alike in groups or key differently to approved keying schedule. Master keying is not permitted for lever tumbler locks. Include lock mounting, escutcheons, strike and mounting screws for complete application. Use break off head security screws on lock mounting and strike. Use Torx tamper resistant screws on cylinder escutcheons.
- 2. Maximum security deadlock: (RR Brink 7080 Series)
 - a. Material:
 - 1. Case: Investment cast steel, zinc plated.
 - 2. Deadbolt: Cold finished steel, electro-galvanized, 3/4 inch thick with three 1/4 inch diameter hardened steel roller pins, 3/4 inch throw.
 - 3. Cylinder: Investment cast, bronze alloy, for key one side (#82) or key both sides (#86).
 - b. Performance:
 - 1. Include anti-bind feature to prevent tumblers from binding with side pressure applied to deadbolt. Lock shall operate under 300 pound side load test.
 - 2. Key operated deadlock. Key removable in locked and unlocked positions.
 - c. Accessories:
 - 1. Lock mountings: HM for hollow metal doors, G for grill doors and P for plate doors.
 - 2. Strike 7080kd: 3/16 inch steel with dust box to protect bolt and mounting screws.
 - 3. Strike 7080ks: 3/16 inch steel with dust box and switch to monitor bolt position.
- 3. Maximum security dead latch: (RR Brink #7070 Series)
 - a. Material:
 - 1. Case: Investment cast iron, zinc plated.
 - 2. Latch bolt: Cold finished steel, electro-galvanized, 3/4 inch thick with two 1/4 inch diameter hardened steel roller pins, 3/4 inch throw.
 - 3. Deadlock actuator: Cold finished steel, electro-galvanized, 1/2 inch thick, 1/2 inch travel.
 - 4. Cylinder: Investment cast, silicon brass alloy, for key one side (#72) or key both sides (#76).
 - b. Performance:
 - 1. Lock shall comply with UL10B Fire Tests of Door Assemblies, Class A 3 hour rating.
 - 2. Key unlocks and retracts latch bolt. Deadlocked by actuator when closed. Key removable in latched and deadlocked position.
 - c. Accessories:
 - 1. Lock mountings: G for grille doors, HM for hollow metal doors and P for plate doors.
 - 2. Strike 7070KD: 3/16 inch steel with dust box to protect bolt and mounting screws.
 - 3. Strike 7070KS: 3/16 inch steel with dust box and switch to monitor latch bolt position.

- 4. Maximum security latch and key operated deadlock:
 - (RR Brink #7060 Series)
 - a. Material:
 - 1. Case: Cast ductile iron, zinc plated
 - 2. Latch bolt: Cold finished steel, electro-galvanized, 3/4" thick with two 1/4"inch diameter hardened steel roller pins, 3/4 inch throw.
 - 3. Deadlock slide: Cold finished steel, electro-galvanized, with fence and deadlock cam.
 - 4. Cylinder: Investment cast, silicon brass alloy, for key one side #62 or key both sides #66.
 - b. Performance:
 - 1. Lock shall comply with UL10B Fire Tests of Door Assemblies, Class A 3 hour rating.
 - 2. Unlocks with half turn of key. Deadlocks with full turn of key in opposite direction. Key removable in locked and deadlocked positions.
 - c. Accessories:
 - 1. Lock mountings: G for grille doors, HM for hollow metal doors and for P plate doors.
 - 2. Strike 7060KD: 3/16 inch steel with dust box to protect bolt and mounting screws.
 - 3. Strike 7060KS: 3/16 inch steel with dust box and switch to monitor latch bolt position.
- 5. Maximum security sliding door dead latch: (RR Brink #7030 Series.
 - a. Material:
 - 1. Case: Cast ductile iron, zinc plated.
 - 2. Hook bolt: Hot finished steel, flame cut shape, hardened, electrogalvanized, 1/2 inch thick with bevel for snap-locking.
 - 3. Slide: Cold finished steel, electro-galvanized, with fence and deadlock.
 - 4. Deadlock pin: 1/2 inch diameter cold finished steel, hardened, electrogalvanized.
 - 5. Cylinder: Investment cast, silicon brass alloy, for key one side (#32) or key both sides (#36).
 - b. Performance:
 - 1. Key operated deadlock. Key removable in locked and latch positions.
 - c. Accessories:
 - 1. Lock mountings: G for grille doors, HM for hollow metal doors and P for plate doors.
 - 2. Strike 7030BKD: 3/16 inch steel with dust box to protect bolt and mounting screws.
- 6. Latch for food passes: (RR Brink #7017 Series)
 - a. Material:
 - 1. Case: Investment cast steel, zinc plated.
 - 2. Latch bolt: Investment cast stainless steel, 7/16 inch throw.
 - 3. Cylinder: Investment cast, silicon brass alloy, for key one side (#17).
 - b. Performance:
 - 1. Key operated latch. Key removable in latched position.

- c. Latch Size: 1-1/2" x 3/4"
- 7. Deadlock for access panels, key cabinets and electrical panels: (RR Brink #7010 Series)
 - a. Material:
 - 1. Case: Investment cast steel case, zinc plated.
 - 2. Deadbolt: Cold finished steel, electro-galvanized, 3/4 inch thick, 5/8 inch throw.
 - 3. Cylinder: Investment cast, silicon brass alloy, for key one side (#12) or key both sides (#16).
 - b. Performance:
 - 1. Key operated deadlock. Key removable in locked and unlocked positions.
 - c. Accessories:
 - 1. Lock mountings: HM for hollow metal doors and P for plate doors.
 - 2. Strike 7010KD: 3/16 inch steel with dust box to protect bolt and mounting screws.
- L. Institutional mortise mechanical lock set for swinging doors: (RR Brink #1020/1030/1040/1060/1070 Series)
 - 1. Includes:
 - a. Lock
 - b. Mogul cylinder
 - c. Strike
 - d. Knob Set/Lever Eskort
 - e. Mounting screws
 - 2. Lock Functions:
 - a. Refer to Hardware Set.
 - 3. Material:
 - a. Case and cover: Stainless steel.
 - b. Faceplate: Stainless steel.
 - c. Strike: 10 gauge Stainless steel.
 - d. Dead bolt: Stainless steel, 1-1/4 inches x 11/16 inch with 1 inch throw, field reversible.
 - e. Internal parts and springs: Stainless steel.
 - f. Lever set: Stainless steel self centering lever. Lever handles to be self locking in case of fire. Provide safety knob and rose set where required.
 - g. Mogul cylinder
 - 4. Performance:
 - a. Locks shall comply with UL10B Fire Tests of Door Assemblies; Class A 4-hour rating.
 - b. Cylinder shall comply with UL437 Key Locks.
- M. Institutional mortise electric lock set for swinging doors: (RR Brink #1050 Series)
 - 1. Includes:
 - a. Lock

- b. Mogul Cylinder
- c. Strike
- d. Knob Set/Lever Eskort
- e. Mounting screws. Exposed screws shall be Torx tamper resistant.
- 2. Lock Functions:
 - a. Refer to Hardware Set
- 3. Series Functions:
 - a. FSE Fail Secure electric knob operation.
 - b. FS Fail-safe electric knob operation.
- 4. Material:
 - a. Case and cover: Stainless steel.
 - b. Faceplate: 16 gauge stainless steel.
 - c. Strike: 12 gauge stainless steel.
 - d. Latch bolt: Stainless steel, 1-3/8 inches x 5/8 inch with 3/4 inch throw.
 - e. Internal parts and springs: Stainless steel.
 - f. Trim set: Knob set/Lever eskort. Provide safety knob and rose set where required.
 - g. Mogul cylinder
- 5. Performance:
 - a. Locks shall comply with UL1034 Burglary Resistant Electric Locking Mechanisms.
 - b. Locks shall comply with UL10B Fire Tests of Door Assemblies, Class A 3 hour rating.
 - c. Cylinder shall comply with UL437 Key Locks.
- N. Narrow jamb mounted pin tumbler electric dead latch for swing doors: (RR Brink #3520-300 Series)
 - 1. Includes:
 - a. Lock mechanism
 - b. Plug connector
 - c. Stainless steel strike
 - 2. Lock functions:
 - a. MSLH Maintained Switch Latch Holdback half-cycle lock.
 - b. See RR Brink catalog for other options.
 - 3. Material and size:
 - a. Lock size: 9-1/2" high x 1-1/2" wide x 1-5/8" deep.
 - b. Case: Investment-cast stainless steel.
 - c. Latch bolt: Investment-cast 17-4 stainless steel hardened to Rockwell C-36/38.
 - d. Latch bolt throw: .75 inch.
 - e. Operating lever: Stainless steel.
 - 4. Electrical characteristics:
 - a. Motor: High torque, permanently lubricated, permanent magnet, planetary gear motor, UL listed.

- 1. Voltage: 24 VDC, 1.0 amps running.
- 2. 300 lb. side load capability (minimum).
- 5. Keying location:
 - a. 3522-300: Keyed one side.
 - b. 3526-300: Keyed both sides.
 - c. Provide cylinder extensions stop side. (KCE)
- 6. Mode of operation:
 - a. NFS: Non fail-safe.
- 7. Finish:
 - a. Faceplate: US4 or US32D.
 - b. Strike: US32D.
 - c. Cylinder: Builders, Mortise type (FKC) if supplied by RR Brink
- O. Jamb mounted pin tumbler electric lock for swinging doors: (RR Brink Series 5020M)
 - 1. Includes:
 - a. Lock
 - b. Plug connector
 - c. Strike
 - d. Mogul cylinder for mechanical release
 - 2. Lock Functions:
 - b. 5020M lock Motor operated deadlatch with latchback and deadlock indication switch.
 - 3. Series of Operation:
 - a. Remote electrical control of operation with local mechanical operation by key cylinder.
 - b. Remote electrical control of operation with local mechanical operation by key cylinder one side and knob operation other side.
 - c. Remote electrical control of operation with local mechanical operation capable of locking bolt in retracted position by key cylinder.
 - d. CKS Provide local electric key option for operational modes 1 and 2. Key shall electrically operate lock when selected at control console.
 - e. Provide locks that are compatible with a stop (push) side cylinder access pocket. Key cylinder extensions (KCE) are not acceptable.
 - 4. Material:
 - a. Case and cover: 10 gauge steel, electroplated for corrosion resistance.
 - b. Latch Bolt: Saw-resistant hardened steel, 1 inch throw dead latch.
 - c. Bolt opening in case shall not allow access to internal mechanism.
 - d. Deadlock Lever: Stainless steel, adjustable for variations in door gap.
 - e. Roller Bolt: Investment cast stainless steel with stainless steel roller.
 - f. Operating Lever: Stainless steel to operate with solenoid, motor, dead latch or deadbolt.
 - g. Strike: Cast stainless steel attached with screws.
 - i. Motor: 24VDC, 1.0 Ampere permanently lubricated fractional HP

- j. Springs: Stainless steel.
- k. Cylinder: Mogul
- 1. Fitted for mechanical operation via either RRBLS proprietary "Mogul" or user's commercial key cylinder.
- m. Internal lock status switch (LSS) monitors status of bolt. Provide model number 201020 door position switch (DPS) to ensure positive, tamper resistant signaling of a closed and deadlocked door.
- n. Provide locks with Maintained Latch Holdback (MSLH) function.
- o. Exposed fasteners: Pinned "Torx" head.
- p. Latch size: 1-1/2" x 3/4"
- 5. Performance:
 - a. Locks shall comply with UL 1034 Burglary Resistant Electric Locking Mechanisms.
 - b. Dead latch model 1, shall comply with UL 10B Fire Tests of Door Assemblies, Class A - 3 Hour Rating.
 - c. Cylinder shall comply with UL 437 Key Locks.
 - d. Design locks to operate one million operations with minimal wear to parts.
 - e. Certification: ASTM F1577 Grade 1 criteria.
- P. Fully selective electric locking, unlocking and operating device for sliding doors: (RR Brink 57700)
 - 1. Manufacturer of sliding door locking devices shall be totally responsible for quality of materials and workmanship utilized during assembly.
 - 2. Electrical control and operation of cell doors:
 - a. Primary remote control and operation of doors shall be accomplished by electrical means from control cabinets or remote control consoles as indicated on Contract Drawings.
 - b. Provide one (1) three-position door control switch and two (2) indicator lights for each door on appropriate control panel.
 - 1. Each door control switch shall provide following operation at appropriate door:
 - a. Position #1, "OPEN": Door unlocks, travels opens and is deadlocked in the open position.
 - b. Position #2, "GROUP": Door stops if in transit and is operable from group control switch.
 - c. Position #3, "CLOSE": Door unlocks, travels closed and is deadlocked in the closed position.
 - 2. Indicator lights shall monitor door positions as follows:
 - a. Green: Illuminated only when door is deadlocked closed.
 - b. Red: Illuminated in any condition other than deadlocked closed.
 - c. Amber: <u>Optional</u> third indication light. When the third light is used, the amber light will indicate the door is moving or stopped in mid-travel.
 - 3. Provide a single push-button for testing all indicator lights.
 - Provide one (1) three-position selector switch to effect group control of doors.
 - 1. Group control selector switch shall provide following operation for

c.

appropriate group of doors:

- a. Position #1, "OPEN": All doors within group selected for group operation unlock, travel open and are deadlocked in the open position.
- b. Position #2, "OFF": All doors within group selected for group operation remain deadlocked closed, deadlocked open or stop if in transit.
- c. Position #3, "CLOSE": All doors within group selected for group operation unlock, travel closed and are deadlocked in the closed position.
- 3. Electrical control and operation of corridor doors:
 - a. Primary remote control and operation of doors shall be accomplished by electrical means from control cabinets or remote control consoles as indicated on Contract Drawings.
 - b. Provide one (1) three-position door control switch and two (2) indicator lights for each door on appropriate control panel.
 - 1. Each door control switch shall provide following operation at appropriate door:
 - a. Position #1, "OPEN": Door unlocks, travels opens and is deadlocked in the fully open.
 - b. Position #2, "STOP": Door stops if in transit.
 - c. Position #3, "CLOSE": Door unlocks, travels closed and is deadlocked in the closed position.
 - Indicator lights shall monitor door positions as follows:
 - a. Green: Illuminated only when door is deadlocked closed.
 - b. Red: Illuminated in any condition other than deadlocked closed.
 - c. Amber: <u>Optional</u> third indication light. When the third light is used, the amber light will indicate the door is moving or stopped in mid-travel.
 - 3. Provide a single pushbutton for testing all indicator lights.
- 4. Manual control and operation of cell doors:

2.

- a. Manual operation of doors affected by means of three-position lever, crank or wheel located within control cabinet or emergency release cabinet, as indicated on Contract Drawings.
- b. Release lever, crank or wheel unlocked by means of paracentric key. When unlocked, can be placed in one of three (3) possible positions:
 - 1. "ELECTRIC": Enables electric operation of appropriate doors.
 - 2. "KEY RELEASE": Permits individual manual unlocking of each cell door at door by means of special lever or tool which is inserted into track box. After unlocking, doors may be opened and closed by hand. Upon reaching either fully open or fully closed position, doors will snaplock and automatically deadlock.
 - 3. "RELEASE ALL DOORS": All cell doors in group simultaneously unlock and may be moved by hand. Doors remain free-wheeling and will not relock while in this position.
- 5. Manual control and operation of corridor doors:

- a. Release is unlocked by means of paracentric key. When unlocked, door can be pushed open.
- b. Deadlocking is automatic not requiring user intervention.
- 6. Locking, unlocking and door carriage assembly:
 - a. Mechanical locking, unlocking and door operation shall be effected through movement of assembly comprised of door hanger, roller bar and lockhead assembly.
 - b. Linear movement of lockhead assembly shall perform unlocking, door movement, locking and deadlocking in sequence beginning with either deadlocked open or deadlocked closed position of door.
 - c. Door shall be electrically interlocked and deadlocked in closed position.
 - d. Master bar shall be designed to mechanically force vertical lock rod into unlocked position.
 - e. Positive deadlock shall be provided in locked position by deadlock cam overriding vertical lock rod, mechanically preventing unlocking without reverse movement of travel bar.
 - f. Each door shall automatically deadlock closed at two concealed points at the rear of the door. Front locking will not be acceptable.
 - g. The locking mechanism shall be completely concealed and there shall be no openings in the locking pilaster or lugs.
 - h. Door carriage and hanger shall be positively joined together so they move in unison.
 - i. Provide two (2) door rollers not less than 3 inches in diameter. Equip with sealed roller bearings operating on hardened steel shoulder bolts that do not require lubrication.
 - j. Door rollers shall be properly machined to engage track sufficiently to prevent displacement by racking or lifting of door.
 - k. Door hanger shall be not less than 1/4 inch thick and of sufficient width to prevent flexing and bending through inmate resistance to door movement.
 - 1. Rack-n-Pinion $-14\frac{1}{2}$ degree spur gear with #10 Pitch x 1" x 5/8" Gear Rack.
- 7. Power package assembly:
 - a. Includes motor, Rack-n-Pinion drive unit and mountings.
 - b. Electric motor: 1/8 HP, 90VDC variable speed,, permanent magnet, right angle gear motor with current limiting DC Driver.
 - c. Gear reducer: Motor reducer drive, 30:1 ratio, 54 RPM.
- 8. Safety design features:
 - a. Door shall stall and sustain stalling without damage to power transmission or other assemblies when opposed by force of approximately 40 pounds. This force is adjustable from 20 to 50 pounds. Door shall automatically resume travel upon removal of obstruction.
 - b. Should power failure leave door in mid-travel, it may be manually opened or closed by applying not less than 20 pounds pressure on door.
 - c. Interlock sallyport or vestibule doors to where only one door can be electrically be opened at a time.
 - d. Normal force exerted by a corridor door in travel is 55 lbs. Pressure must be adjustable to suit door size and weight.

- 9. Mechanism housing:
 - a. Mechanism housing shall be not greater than 14 inches high and shall project no more than 10 1/2 inches from supporting wall.
 - b. Back and bottom shall be formed from one piece of not less than 7 gauge mild steel sheet and properly stiffened to provide mounting for all fixed components of mechanism.
 - c. Door track: Shop-fixed in place to bottom of mechanism housing. Fabricate door track from cold rolled steel, not less than 1/2 inch wide on bearing surface.
 - d. Provide slot in bottom of mechanism housing to permit passage of door hanger and lateral movement of door.
 - e. Front housing cover is made from #10 GA material, is hinged at the top with a continuous piano hinge and is fastened with security Torx screws spaced at 14" on center. Cover will be split into 2 sections if overall cover length exceeds 90"
- 10. Locking pilasters, guides and strikes:
 - a. Provide full-height vertical lock bar in locking pilaster fixed in place to door frame at rear of door opening. This pilaster shall be designed to conceal locking point provided for vertical lock bar at bottom of door.
 - b. Provide fixed door guide member to be attached to partition wall in compliance with details shown on Contract Drawings.
 - 1. Door guide shall be designed to prevent access to locking point at bottom of door and accumulation of dirt and debris within guide.
 - 2. Door guide shall be formed of not less than ten (10) gauge steel sheet and shall extend full width of open door.
 - c. Provide vertical strike at front of door opening to engage leading edge of door when closed.
 - 1. Strike shall be formed of not less than 10 gauge steel sheet and shall extend from bottom of mechanism housing to bottom of door.
 - 2. Securely fix in place in compliance with details shown on Contract Drawings.
- R. Fully selective electric unlocking device for manually operated sliding doors: (RR Brink 57300 Series)
 - 1. Manufacturer of sliding door locking devices shall be totally responsible for quality of materials and workmanship utilized during assembly.
 - 2. Electrical control and operation of cell doors:
 - a. Primary remote unlocking and monitoring of doors shall be accomplished by electrical means from control cabinets or remote control consoles as indicated on Contract Drawings.
 - b. Provide one (1) three-position door control switch and two (2) indicator lights for each door on appropriate control panel.
 - 1. Each door control switch shall provide following operation at appropriate door:
 - a. Position #1, "UNLOCK": Door unlocks and springs slightly toward open position. Further movement is accomplished manually at door.

- b. Position #2, "GROUP": Door may be unlocked by group door control selector switch.
- c. Position #3, "LOCK": Door locks and deadlocks when moved to fully closed position.
- 2. Indicator lights shall monitor door positions as follows:
 - a. Green: Illuminated only when door is deadlocked closed.
 - b. Red: Illuminated only when door is deadlocked open.
 - c. Amber: <u>Optional</u> third indication light. When the third light is used, the amber light will indicate the door is moving or stopped in mid-travel.
- 3. Provide a single pushbutton for testing all indicator lights.
- c. Provide one (1) three-position selector switch to effect group control of doors.
 - 1. Group control selector switch shall provide following operation for appropriate group of doors:
 - a. Position #1, "UNLOCK": All doors within selected group unlock and spring slightly toward open position. Further movement is accomplished manually at doors.
 - b. Position #2, "OFF": All doors in group operable from individual door control selector switches only.
 - c. Position #3, "LOCK": All doors in selected group lock and deadlock when moved to fully closed position.
- 3. Electrical control and operation of corridor doors:
 - a. Primary remote control and operation of doors shall be accomplished by electrical means from control cabinets or remote control consoles as indicated on Contract Drawings.
 - b. Provide one (1) three-position door control switch and two (2) indicator lights for each door on appropriate control panel.
 - 1. Each door control switch shall provide following operation at appropriate door:
 - a. Position #1, "UNLOCK": Door unlocks and springs slightly toward open position. Further movement is accomplished manually at door.
 - b. Position #2, "GROUP": Door may be unlocked by group door control selector switch.
 - c. Position #3, "LOCK": Door locks and deadlocks when moved to fully closed position.
 - 2. Indicator lights shall monitor door positions as follows:
 - a. Green: Illuminated only when door is deadlocked closed.
 - b. Red: Illuminated only when door is deadlocked open.
 - c. Amber: <u>Optional</u> third indication light. When the third light is used, the amber light will indicate the door is moving or stopped in mid-travel.
 - 3. Provide a single pushbutton for testing all indicator lights.
- 4. Manual control and operation of cell doors:
 - a. manual operation of doors affected by means of three-position lever, crank or wheel located within control cabinet or emergency release cabinet as indicated on Contract

Drawings.

- b. Release lever, crank or wheel unlocked by means of paracentric key. When unlocked, can be placed in one of three (3) possible positions:
 - 1. "ELECTRIC": Permits electric unlocking of all doors within group.
 - 2. "KEY RELEASE": Permits individual manual unlocking at door by means of special lever or tool which is inserted into track box. After unlocking, doors may be opened and closed by hand. When moved to either fully open or fully closed position, doors will snaplock and automatically deadlock.
 - 3. "RELEASE ALL DOORS": All cell doors in group simultaneously unlock and may be moved by hand. Doors will not relock while in this position.
- 5. Manual control and operation of corridor doors:
 - a. Manual operation of door affected by means of paracentric key cylinder in release column located vertically at closed side of door.
 - b. When paracentric key is inserted into cylinder and turned to "UNLOCKED" position, power to door is interrupted and door automatically unlocks and springs slightly toward open position. Door will not relock until key is returned to "ELECTRIC" position.
- 6. Locking, unlocking and door carriage assembly:
 - a. Locking, deadlocking and unlocking of doors shall be effected separately from, but in mechanically coordinated sequence with movement of door. Movement of door accomplished manually at door.
 - b. Doors shall be positively locked and deadlocked with equal security in either open or closed position.
 - c. Each door shall be locked in at least three (3) places in both fully open and fully closed positions.
 - d. First lock point shall be provided at bottom of door, second lock point shall be provided at top of door and third lock point shall be concealed within track box.
 - e. Door carriage assembly and door hanger shall be positively joined together to move in unison.
 - f. Provide two (2) wheels for each door carriage assembly, not less than 2-3/8 inches in diameter. Equipped with roller bearings operating on hardened steel shoulder bolts. Furnish sealed bearings that do not require lubrication.
 - g. Door carriage rollers shall be machined to engage track sufficiently to prevent displacement by racking or lifting of door.
 - h. Door hanger shall be not less than 1/4 inch thick and of sufficient width to prevent flexing and bending through inmate resistance to door movement.
- 7. Electric motor assembly:
 - a. Electric motor shall be not less than 1/60 HP, 120V AC, 60 HZ, 1 PH, equipped with thermal overload device, sealed bearings and self lubricating provisions.
 - b. Thermal overload device shall protect motor against burn-out by interrupting power supply when overheating occurs. Device shall reset itself automatically and restore power supply to motor when temperature returns to normal operating range.
- 8. Mechanism housings:
 - a. All mechanisms utilized in operation of cell doors shall be securely enclosed in

protective steel housing extending horizontally above doors. Housing shall be provided from control cabinet (CC) or emergency release cabinet (ERC) and shall run continuously over all doors in control group.

- b. Back and bottom of housing assembly shall be formed from one piece of not less than 7 gauge mild steel sheet, properly stiffened to provide mounting for all fixed components of mechanism. Back of housing shall be securely and permanently anchored to cell fronts in accordance with details shown on Contract Drawings.
- c. Door track shall be securely fixed in place to bottom of mechanism housing. Track shall be fabricated from cold rolled steel, not less than 1/2 inch wide on bearing surface and of sufficient depth to prevent deflection during operation of door.
- d. Provide slot in bottom of mechanism housing to permit passage of door hanger and lateral movement of the door.
- e. Front cover of mechanism housing shall be made in one piece sections of not less than 10 gauge steel sheet, and continuously hinged at top to housing.
- f. Front housing cover shall be fastened with security Torx screws, spaced not more than 14" on center and is split into 2 sections if the overall cover length exceeds 90".
- 9. Locking pilasters, guides and strikes:
 - a. Provide vertical, full-height lock bar for each door. Conceal and securely protect against tampering by vertical locking pilaster fixed in place to door frame and positioned at rear of door opening. Locking pilaster shall be designed to conceal locking point provided for vertical lock bar at bottom of door in addition to primary lock points inside track box.
 - b. Provide fixed door guide securely attached to cell front in compliance with details shown on Contract Drawings. Fixed guide shall be designed to engage guide member at bottom of door in a manner preventing access to bottom door lock point and accumulation of dirt and debris within guide.
 Guide shall be formed of not less than 7 gauge steel sheet and shall extend full width of open door.
 - c. Fixed vertical strike shall be provided at front of door opening to engage leading edge of door when closed. Strike shall be formed of not less than 7 gauge steel sheet and shall extend from mechanism housing for full height of door. Strike shall be securely and permanently fixed in place in compliance with details shown on Contract Drawings.
- 10. Interchangeability and upgradeability:
 - a. Various parts and components making up assemblies of this system shall be interchangeable with parts of like assemblies, and assemblies themselves shall be completely interchangeable between like doors.
 - b. Upgrading shall only require addition of power package assembly to be bolted onto existing studs in mechanism housing.
 - c. Detention Equipment Contractor shall provide for compatibility of upgrade at control panels and emergency release cabinets, as well as sufficient wiring for future use.

2.2 – FINISHES:

A. Unless noted in the hardware groups, finished are to be furnished as follows:

1.	Hinges	Stainless Steel	630/US32D
2.	Cylinders	Brushed Chrome	626/US26D
3.	Closers	Painted Aluminum	689
4.	Pulls	Stainless Steel	630/US32D
5.	Thresholds/Rigid Gasket	Anodized Aluminum	628
6.	Self-Adhesive Gasket	Charcoal	
7.	Floor/Wall Stops	Black	

PART 3 - EXECUTION

3.1 VERIFICATION OF CONDITIONS

- A. Examine areas and surfaces to receive materials, assemblies and equipment furnished and installed under this section:
 - 1. Verify proper location of embeds, frames and items installed by others.
 - 2. Check rough-ins and field dimensions of building construction.
 - 3. Inspect concrete and masonry to ensure construction within required tolerances.
 - 4. Confirm locations of materials ingress openings in building.
- B. Report unsatisfactory conditions to Architect in writing. Do not begin installation of detention equipment until unsatisfactory conditions have been corrected.

3.2 PREPARATION

- A. General Contractor:
 - 1. Provide openings through exterior and interior building walls to accommodate ingress of detention equipment. Coordinate sizes and locations of openings with DEC.
 - 2. Ensure accuracy of building construction, including sizes and locations of beams and columns, concrete and masonry walls, evenness of concrete and dimensional consistency.
 - a. Concrete floors and ceilings should be level and true.
 - b. Where concrete is uneven, chip or grout as required for proper fit between detention equipment steel and concrete.
 - 3. Broom clean, properly light and heat areas of building where detention equipment is to be installed.
 - 4. Prior to installation of electrical and mechanical hardware or locking and operating devices and controls, exterior closing walls should be in place, exterior windows glazed, and roof completely installed to prevent weather damage to components. Provide DEC written notification to proceed with installation once these conditions have been met. Installation

will not commence until DEC receives written notification.

- 5. Provide 220 volt AC, 60 cycle, 3 phase power for use by DEC in connection with installation of detention equipment.
 - a. If permanent power service is not available within reasonable access to detention areas when installation of detention equipment begins, provide temporary power (50 amps per welding machine) and bear expense.
 - b. If sufficient temporary power is not available, reimburse DEC for extra labor and fuel required for use of gasoline welding machines.

3.3 INSTALLATION

- A. General:
 - 1. Install fixtures, materials, assemblies and equipment listed in Articles 1.2 and 1.4 in strict compliance with Specifications, Contract Drawings and manufacturers' recommendations and instructions.
 - 2. Provide necessary drawings, setting diagrams or other information required to Contractor responsible for installation of DEC-furnished items to be installed by others.
 - 3. Supervise installation of electronic security systems provided under Division 28.
- B. Attachment and connection of detention equipment:
 - 1. Secure detention equipment permanently in place with minimum of exposed fasteners and free from warp, twists, bends, rough edges, cracks or open joints. Exposed fasteners shall be uniform in size, spacing and appearance and shall be tamper-resistant.
 - 2. Punch bolt holes not more than 1/16 inch larger in diameter than bolts to be used. Accurately space and align holes to permit insertion of bolts. When bolts are used, nuts shall be tightly drawn and bolt threads battered to prevent removal.
 - 3. Remove loose scale, rust, oil and other foreign matter from surfaces to be welded. Welds shall show uniform cross-sections, good penetration of base metals, smoothness of weld metal with a minimum of craters, porosity and clinkers.
 - 4. Thoroughly clean burns, welds and welding spatter on detention equipment resulting from fabrication and installation.
 - 5. Welds which are neat in appearance and evenly spaced shall not require grinding.
- C. Supervision:
 - 1. Work shall be performed under direct supervision of competent, experienced, factory-trained project superintendent who shall be full-time employee of DEC.
 - 2. DEC's superintendent shall be present at job site during all phases of installation of detention equipment.

3. DEC shall be responsible for conduct and performance of jobsite personnel and shall ensure that Work progresses without serious conflict with related work being performed simultaneously by other trades.

3.4 ADJUSTING

- 1. Adjust and check each operating item of detention door hardware and each detention door to ensure proper operation or function of every unit. Replace units that cannot be adjusted to operate as intended. Adjust detention door control devices to compensate for final operation of heating and ventilating equipment and to comply with referenced accessibility requirements.
- 2. Strikes: Adjust horizontal and vertical alignment of keeper to properly engage lock bolt.

3.5 CLEANING AND PROTECTION

- 1. Clean adjacent surfaces soiled by detention door hardware installation.
- 2. Clean operating items as necessary to restore proper function and finish.
- 3. Provide final protection and maintain conditions that ensure that detention door hardware is without damage or deterioration at time of substantial completion.

3.6 DEMONSTRATION

- A. Provide designated custodial personnel instruction in proper operation of detention equipment and electronic security systems for a period of time not less than three (3) working days.
- C. Provide designated maintenance personnel instruction in proper maintenance of detention equipment and electronic security systems for a period of time not less than three (3) working days.

3.7 HARDWARE SCHEDULE

Security Hardware Sets:

Hardware Set S01.1 - Cell Swinging Door w/Food Pass

Each to Receive:

3	ea	Hinge	NW645 FMST x #30 Torx	US32D	NW
2	ea	Food Pass Hinge	NW631 FPB	USP	NW
1	ea	Elec Jamb Lock	5022M-MSLH-24VDC	USP	BR
1	ea	Food Pass Lock	7017	USP	BR
1	ea	Loop Pull	NW601	US32D	NW
1	ea	Flush Pull	Titan #2 (by door mfg.)	SP	ΤI
1	ea	Wall Stop	NW706	Black	NW
3	ea	Silencers	608	Grey	RO
1	ea	Magnetic DPS	201020	US32D	BR

Hardware Set S01.2 - Cell Swinging Door w/Food Pass & CKS

Each to Receive:

3	ea	Hinge	NW645 FMST x #30 Torx	US32D	NW
2	ea	Food Pass Hinge	NW631 FPB	USP	NW
1	ea	Elec Jamb Lock	5022M-MSLH-CKS 24VDC	USP	BR
1	ea	Food Pass Lock	7017	USP	BR
1	ea	Loop Pull	NW601	US32D	NW
1	ea	Flush Pull	Titan #2 (by door mfg.)	USP	ΤI
1	ea	Wall Stop	NW706	Black	NW
3	ea	Silencers	608	Grey	RO
1	ea	Magnetic DPS	201020	US32D	BR

Hardware Set S01.3 - SteelCell

Each to Receive:

3	ea	Hinge	by Cell Mfr.		
2	ea	Food Pass Hinge	by Cell Mfr.		
1	ea	Elec Jamb Lock	5022M-MSLH 24VDC	USP	BR
1	ea	Food Pass Lock	7017	USP	BR
1	ea	Loop Pull	NW601	US32D	NW
1	ea	Flush Pull	Titan #2 (by door mfg.)	USP	ΤI
1	ea	Wall Stop	NW706SC	Black	NW
3	ea	Silencers	608	Grey	RO
1	ea	Magnetic DPS	201020	US32D	BR

Hardware Set S01.4 – Inmate Toilet from Padded

Each to Receive:

3	ea	Hinge	NW645 FMST x #30 Torx	US32D	NW
1	ea	Elec Jamb Lock	5022M-MSLH 24VDC	USP	BR
1	ea	Loop Pull	NW601	US32D	NW
1	ea	Flush Pull	Titan #2 (by door mfg.)	USP	ΤI
1	ea	Concealed Closer	2214	AL	LC
1	ea	Wall Stop	NW706	Black	NW
3	ea	Silencers	608	Grey	RO
1	ea	Magnetic DPS	201020	US32D	BR

Hardware Set S01.5 – Padded Cell

Each to Receive:

3	ea	Hinge	NW645 FMST x #30 Torx	US32D	NW
2	ea	Food Pass Hinge	NW631 FPB	USP	NW
1	ea	Elec Jamb Lock	5022M-MSLH 24VDC	USP	BR
1	ea	Food Pass Lock	7017	USP	BR
1	ea	Loop Pull	NW601	US32D	NW
1	ea	Flush Pull	Titan #2 (by door mfg.)	USP	ΤI
1	ea	Concealed Closer	2214	AL	LC
1	ea	Wall Stop	NW706	Black	NW
3	ea	Silencers	608	Grey	RO
1	ea	Magnetic DPS	201020	US32D	BR

Hardware Set S01.6 - Padded Cell

Each to Receive:

4	ea	Hinge	NW645 FMST x #30 Torx	US32D	NW
2	ea	Food Pass Hinge	NW631 FPB	USP	NW
1	ea	Elec Jamb Lock	5022M-MSLH 24VDC	USP	BR
1	ea	Food Pass Lock	7017	USP	BR
1	ea	Loop Pull	NW601	US32D	NW
1	ea	Flush Pull	Titan #2 (by door mfg.)	USP	ΤI
1	ea	Concealed Closer	2214	AL	LC
1	ea	Wall Stop	NW706	Black	NW
3	ea	Silencers	608	Grey	RO
1	ea	Magnetic DPS	201020	US32D	BR

Hardware Set S04.1 – Corridor/General Use

Each to Receive:

3	ea	Hinge	NW645 FMST x #30 Torx	US32D	NW
1	ea	Elec Jamb Lock	5026M-MSLH 24VDC	USP	BR
1	ea	Loop Pull	NW601	US32D	NW
1	ea	Combo Pull	NW701	US32D	NW
1	ea	Concealed Closer	2214	AL	LC
1	ea	Wall Stop	NW706	Black	NW
3	ea	Silencers	608	Grey	RO
1	ea	Magnetic DPS	201020	US32D	BR

Hardware Set S04.2 - S04.1 w/CKS

Each to Receive:

3	ea	Hinge	NW645 FMST x #30 Torx	US32D	NW
1	ea	Elec Jamb Lock	5026M-MSLH-CKS 24VDC	USP	BR
1	ea	Loop Pull	NW601	US32D	NW
1	ea	Combo Pull	NW701	US32D	NW
1	ea	Concealed Closer	2214	AL	LC
ty Har	dware a	nd Sliding Door Devices	- 27 -	11	19 30

Security Hardware and Sliding Door Devices - 27 - Copyright © 2020 by RQAW Corporation

1	ea	Wall Stop	NW706	Black	NW
3	ea	Silencers	608	Grey	RO
1	ea	Magnetic DPS	201020	US32D	BR

Hardware Set S04.3 - Dayroom Door

Each to Receive:

3	ea	Hinge	NW645 FMST x #30 Torx	US32D	NW
2	ea	Food Pass Hinge	NW631 FPB	USP	NW
1	ea	Elec Jamb Lock	5026M-MSLH 24VDC	USP	BR
1	ea	Food Pass Lock	7017	USP	BR
1	ea	Loop Pull	NW601	US32D	NW
1	ea	Combo Pull	NW701	US32D	NW
1	ea	Concealed Closer	2214	AL	LC
1	ea	Wall Stop	NW706	Black	NW
3	ea	Silencers	608	Grey	RO
1	ea	Magnetic DPS	201020	US32D	BR

Hardware Set S04.4 – Inmate Toilet

Each to Receive:

3	ea	Hinge	NW645 FMST x #30 Torx	US32D	NW
1	ea	Elec Jamb Lock	5026M-MSLH 24VDC	USP	BR
1	ea	Loop Pull	NW601	US32D	NW
1	ea	Flush Pull	Titan #2 (by door mfr.)	USP	TN
1	ea	Wall Stop	NW706	Black	NW
3	ea	Silencers	608	Grey	RO
1	ea	Magnetic DPS	201020	US32D	BR

Hardware Set S04.5 – Inmate Toilet w/FP

Each to Receive:

3	ea	Hinge	NW645 FMST x #30 Torx	US32D	NW
2	ea	Food Pass Hinge	NW631 FPB	USP	NW
1	ea	Elec Jamb Lock	5026M-MSLH 24VDC	USP	BR
1	ea	Food Pass Lock	7017	USP	BR
1	ea	Loop Pull	NW601	US32D	NW
1	ea	Flush Pull	Titan #2 (by door mfr.)	USP	TN
1	ea	Wall Stop	NW706	Black	NW
3	ea	Silencers	608	Grey	RO
1	ea	Magnetic DPS	201020	US32D	BR

Hardware Set S06.1 – Dayroom to Dayroom

Each to Receive:

3 e	ea	Hinge	NW645 FMST x #30 Torx	US32D	NW
1 e	ea	Elec Jamb Lock	5026M-MSLH 24VDC	USP	BR
2 e	ea	Combo Pull	NW701	US32D	NW
1 e	ea	Concealed Closer	2214	AL	LC
1 e	ea	Wall Stop	NW706	Black	NW
1 e	ea	Threshold	8135S 36" x TORX x PA	AL	NG
1 e	ea	Gasket	5050C x 17'	Char	NG
1 e	ea	Magnetic DPS	201020	US32D	BR

Hardware Set S06.2 - Dayroom to Dayroom w/FP

Each to Receive:

3 ea	Hinge	NW645 FMST x #30 Torx	US32D	NW
2 ea	Food Pass Hinge	NW631 FPB	USP	NW
1 ea	Elec Jamb Lock	5026M-MSLH 24VDC	USP	BR
1 ea	Food Pass Lock	7017	USP	BR
2 ea	Combo Pull	NW701	US32D	NW
1 ea	Concealed Closer	2214	AL	LC
1 ea	Wall Stop	NW706	Black	NW
1 ea	Threshold	8135S 36" x TORX x PA	AL	NG
1 ea	Gasket	5050C x 17'	Char	NG
1 ea	Magnetic DPS	201020	US32D	BR

Hardware Set S09.1 – Exterior Door

Each to Receive:

3	ea	Hinge	NW645 FMST x #30 Torx	US32D	NW
1	ea	Elec Jamb Lock	5026M-MSLH 24VDC	USP	BR
1	ea	Loop Pull	NW601	US32D	NW
1	ea	Combo Pull	NW701	US32D	NW
1	ea	Concealed Closer	2214	AL	LC
1	ea	Floor Stop	NW606	Black	NW
1	ea	Threshold	896S 36" x TORX x PA	AL	NG
1	ea	Weatherseal	161SA 36" x 84"	AL	NG
1	ea	Magnetic DPS	201020	US32D	BR

<u>Hardware Set S20 – Spare Parts</u>

6	ea	Hinge	NW645 FMST x #30 Torx	US32D	NW
2	ea	Elec Jamb Lock	5020M-MSLH-24VDC	USP	BR
20	ea	Cut Keys	Paracentric	-	BR
50	ea	Cut Keys	Mogul	-	BR
4	ea	Motor	5020M-24VDC	-	BR
2	ea	Concealed Closer	2214	AL	LC
2	ea	Magnetic DPS	201020	US32D	BR
1	ea	Switch	4 ea Type Used	-	BR
1	ea	Device Test Box	B00068-A 24VDC	-	BR

END OF SECTION 11 19 30

SECTION 22 13 00

SANITARY SEWER SYSTEMS

PART 1 - GENERAL

1.1 **SCOPE**

- This section includes specifications for: A.
 - Floor Drains Trap Guards 1.
 - 2. 3.
 - Floor Sinks
 - 4. Hub Drains
 - 6. **Trench Drains**
 - 7. Cleanouts
 - 8. Backwater Valves

B. **Related Documents:**

- 1.
- Section 22 11 00 Water Distribution Section 22 13 00 Sanitary Sewerage (Sanitary Waste and Vent Piping) 2. 3.
- Section 22 14 00 Storm Drainage

1.2 REFERENCE

Applicable provisions of all Sections 22 shall govern work under this section. Α.

1.3 **REFERENCE STANDARDS**

- ANSI A112.14.1 Backwater Valves Α.
- B. ANSI A112.21.1 - Floor Drains.
- C. ANSI A112.21.2 - Roof Drains.
- ANSI A112.26.1/PDI WH-201 Water Hammer Arrestors. D.
- E. ASSE 1001 - Pipe Applied Atmospheric Type Vacuum Breakers.
- F. ASSE 1010 - Water Hammer Arrestors.
- ASSE 1011 Hose Connection Vacuum Breakers. G.
- H. ASSE 1012 - Backflow Preventers with Intermediate Atmospheric Vent.
- ASSE 1013 Reduced Pressure Principle Backflow Preventers. I.
- J.
- ASSE 1018 Trap Seal Primer Valves. ASSE 1019 Wall Hydrants, Frost Proof Automatic Draining, Anti-Backflow Type. Κ.

1.4 QUALITY ASSURANCE

- Substitution of Materials: Refer to Section GC General Conditions of the Contract, A. Equals and Substitutions..
- Plumbing products requiring approval by the State of Indiana. B.

1.5 SHOP DRAWINGS

Include data concerning dimensions, capacities, materials of construction, ratings, A. certifications, weights, manufacturer's installation requirements, manufacturer's performance limitations, and appropriate identification.

1.6 OPERATION AND MAINTENANCE DATA

A. All operations and maintenance data shall comply with the submission and content requirements specified under section GENERAL REQUIREMENTS.

PART 2 - PRODUCTS

2.1 FLOOR DRAINS

Manufacturer: J.R. Smith, Wade, Zurn.

- A. Grates and Covers:
 - 1. Medium duty unless specified otherwise) in areas not subject to equipment loads. Secure with vandal resistant screws.
 - 2. Heavy duty (or reinforced) in areas which are subject to heavy equipment loads.
 - 3. Contractor shall coordinate location of drains indicated on plumbing drawings with structural / general contractor.
 - 4. Jails: Areas of inmate access shall have drain strainers secured with tamper resistant screws.
 - 5. See Floor Drain Schedule on drawings for model numbers and drain descriptions.

2.2. PLUMBING DRAINS

- A. <u>FD-1</u>: Floor Drain. <u>General Duty</u>: (On / Above Grade)
 - 1. Duco cast iron bottom outlet body, with double drainage flashing flange and reversible clamping collar, with 5" round adjustable nickel bronze strainer assembly. Strainer diameter to be a minimum twice the outlet size of the outlet connection.
 - 2. Provide with cast iron p-trap or approved equal.
 - 3. Provide with trap-primer connection.
 - 4. Shower Drains connected to a PVC piping system maybe ProFlo (# PF140nc) no caulk shower drain and snap-in stainless steel strainer, install with drain trap.
 - 5. Floor drain is to be provided with either a J.R Smith Stink-Stopper # 2692 or SureSeal-backcheck for sewer gas control.
- B. <u>FD-2</u>: Floor Drain. Ice Machine Drain with anti-floor rim
 - 1. Duco cast iron bottom outlet body, with double drainage flashing flange and reversible clamping collar, with round adjustable nickel bronze strainer assembly. <u>Note</u>: Strainer diameter to be a minimum twice the outlet size of the outlet connection. Provide with trap-primer connection.
 - 2. Provide with cast iron p-trap or approved equal.
- C. <u>FD-3</u>: Floor Drain: (On Grade)
 - 1. Duco cast iron body with integral deep seal cast iron p-trap, with flashing flange and clamping collar, with round adjustable nickel bronze strainer, with round 5"

adjustable nickel bronze strainer.

- 2. Strainer to be secured with vandal-resistant "torx-screws"
- 3. Provide with trap-primer connection.
- D. <u>FD-4</u>: Equipment Drain with Funnel: (On Grade)
 - 1. Duco cast iron body with integral deep seal cast iron p-trap, with flashing flange and clamping collar, with round adjustable nickel bronze strainer, with round adjustable nickel bronze cleanout plug with solid secured cover.
 - 2. Install 4" diameter nickel bronze funnel assembly.
 - 3. Provide with trap-primer connection.
- E. <u>FD-5</u>: Large Capacity Drain:
 - 1. Cast iron flanged receptor, bottom outlet body, with nickel bronze dome strainer.
 - 2. Install half-grate unit.
 - 3. Provide with trap-primer connection.
 - 4. Outlet size shall be 4"
- F. <u>FD-6</u>: Large Capacity Drain:
 - 1. Duco cast iron bottom outlet body with double drainage flange and reversible clamping collar.
 - 2. Install with 8" dia. strainer
 - 3. Provide with trap-primer connection.
 - 4. Outlet size shall be 4"
- G. <u>AD-1</u>: Area Drain:
 - 1. Cast iron body with hinged, lockable grate and flashing clamp
 - 2. Outlet size shall be 3"
 - 3. Sediment bucket not required.
- H. <u>FS-1</u> Floor Sink:
 - 1. Acid Resistant Coated interior and grate.
 - 2. Flashing Clamp.
 - 3. Aluminum Dome strainer.
 - 4. A.R.C. 1/2 Grate.
 - 5. 12" square x 10" deep receptor
 - 6. Outlet size shall be 3[°].

2.3 TRAP PRIMERS

When required by local Plumbing / Building Codes, contractor shall install trap-primers to all floor drains. Manufacturers: J.R.Smith Fig # 2694-NP and # 2683-3 Distribution Unit, Watts 3 LFTP300.

2.4 TRAP GUARDS

Manufacturer: Manufacturer: JR Smith Quad Close, model #2692 Series, or Sure-Seal #

SS2009V with new back-check cover.

Flexible elastomeric PVC construction diaphragm trap guard for installation in new and existing floor drains, hub drains, and trench drains. Trap guard to prevent trap evaporation and waste backflow. Size as applicable to the drain outlet size, up to 4" size. This product to be tested and certified to the requirements of ASSE 1072 & IAPMO Research and Testing, Inc., and any subsequent submittal must contain a certificate of compliance listing all the approved sizes.

Contractor to verify with local plumbing inspector that flexible type trap guard devices are allowed. When the use of trap guard devices are not allowed, install a "Watts" Series A200, flow-thru trap primer.

2.5 HUB DRAINS (Where Indicted)

- A. Manufacturer: Josam, Smith, Wade, Watts, Zurn.
 - 1. <u>HD-1</u>: <u>3</u>" min. cast iron hub section up 2" min. above floor level, with full-sized P-trap.
 - 2. <u>HD-2</u>: same as HD-2 except with the addition of a ball float type backwater valve. Zurn Z-415-U (modified) / Z-1099 (no-hub).

2.6 TRENCH DRAINS Manufacturers: Duratrench, J.R. Smith 9666, Zurn, ABT, Inc. Polydrain. A. TD-1: 36" TRENCH DRAIN: DuraTrench DTSS2-03BW48SSA-INTEGRAL-GLWCB2-SLWD-2b TD-2: 42" TRENCH DRAIN: DuraTrench DTSS2-03BW48SSA-INTEGRAL-GLWCB2-SLWD-2b TRENCH BODY Trench drain shall be DuraTrench as manufactured by Eric'sons, 574C Industrial Way N. Dallas, GA 30132 - (770-505-6575). The trench drain body shall be straight and constructed from 14ga T304 stainless steel per ASTM-A240 and have a minimum clear opening of 2". Sections shall be 120" long (typical), but can be fabricated in longer lengths as required (up to 50' lengths possible) and have a built in slope of 1/8" per foot (typical). The sections shall bolt together via a flange and can be sealed with a gasket or by on site welding. Each of the sections shall be labeled to indicate proper flow and placement. Trench body shall have a class 2b finish standard. Optional mill or bead blast finish as required on the contract documents. This run has a VEE bottom profile. GRATING Grating shall be 03BW48SSA basket weave grate. The grate shall be ADA compliant and heel proof and is fabricated using T304 stainless steel per ASTM-A240. The grate shall be 2.875" wide x 48" long x 0.5" thick and have a minimum load rating of DIN Class A.

FRAME Frame is integrally formed with the body of the trench.

GRATE LOCKS

Grates shall be securely bolted down directly to a welded cross bar on the frame. Note: this lock is not designed traffic turning, braking, or longitudinal travel exceeding 20 mph.

OUTLETS Trench shall outlet into a 2" SS (Stainless) pipe in the bottom of the trench.

SEALANT

Joints shall be fully welded shut to provide a continuous water-tight seal from top of joint through the bottom and back to the top on the other side. If field joint is required, it should be cleaned with a stainless-steel bristle wire brush or acid pickling agent to return the corrosion resistance of the base metal upon completion of the welding process.

2.7 CLEANOUTS

Manufacturer: Josam, J.R. Smith, Wade, Watts, Zurn.

EXTERIOR UNPAVED AREAS: CO-1, Cast iron hub or plug with tapered threaded PVC closure plug, cast iron or PVC frost sleeve and cover set in 24" square by 4" min. thick reinforced concrete pad top. Neenah R-1976 with non-ferrous securing screw.

INTERIOR CONCRETE FLOOR AREAS: CO-2, Enameled cast iron body with round adjustable scoriated polished nickel bronze cover, tapered threaded ABS closure plug. Zurn ZN-1400- / ZN-1400-T.

INTERIOR FINISHED WALL AREAS: Line type cleanout tee with tapered threaded ABS cleanout plug, round polished stainless steel access cover secured with machine screw. Zurn Z-1446- (Note: Screw shall not pass completely through the ABS plug, trim screw as necessary)

INTERIOR EXPOSED VERTICAL STACKS: Line type cleanout tee with tapered threaded ABS closure plug. Zurn Z-1445.

INTERIOR HORIZONTAL LINES: Cast iron hub with tapped ferrule and tapered threaded ABS or PVC closure plug, or no-hub coupling and blind plug.

2.8 SEWER CAMERA INSPECTION

- 1. The cost of the camera inspection shall be at the expense of the Contractor.
- 2. The camera inspection shall be performed within 14 days after the sanitary sewer mains have been cleaned and/or rodded out.

- 3. The camera inspection shall be performed on all sanitary sewer mains 4" and larger before any new work is performed on the sewer piping.
- 4. Record inspection data using high-quality video media such as DVD or other approved media.

PART 3 - EXECUTION

3.1 INSTALLATION

Coordinate location and setting of plumbing specialties with adjacent construction. Install in accordance with manufacturers recommendations.

Set floor drains, roof drains, trench drains and cleanouts level and plumb adjusted to finished floor elevation, roof elevation or finished wall location. Locate where serviceable. Allow minimum of 18" clearance around cleanouts for rodding. Lubricate threaded cleanout plugs with graphite and oil, teflon tape or waterproof grease. Install trap primer connections where indicated. Provide deep seal traps on floor drains and hub drains installed in mechanical rooms, penthouses or rooms with excessive positive or negative pressure.

Floor drains and hub drains installed in public restrooms, locker rooms, seldom used rooms, and areas with minute drainage flow shall have a trap guard device installed.

During construction, floor drains and drench drains shall be protected from dirt and debris. Contractor shall cover drains with temporary tape or coverings to be removed once construction is complete.

Adjust receiver height to drain tile inlet and outlet elevations and cleanout to finished floor elevation.

Floor Drains shall be installed to allow the strainer to be recessed 1/4" below finished floor. Drain shall have a slopped 12" sweep around outside diameter of strainer.

END OF SECTION

SECTION 23 25 13

WATER TREATMENT FOR CLOSED-LOOP HYDRONIC SYSTEMS

1.1 SUMMARY

- A. Section Includes:
 - 1. Manual chemical-feed equipment.
 - 2. Chemicals.

1.2 SUBMITTALS

- A. Action Submittals:
 - 1. Product Data: Include rated capacities, operating characteristics, and furnished specialties and accessories for the following products.
 - a. Bypass feeders.
 - b. Water meters.
 - c. Inhibitor injection timers.
 - d. pH controllers.
 - e. TSS controllers.
 - f. Chemical solution tanks.
 - g. Injection pumps.
 - h. Chemical test equipment.
 - i. Chemical material safety data sheets.
 - 2. Shop Drawings: Pretreatment and chemical treatment equipment showing tanks, maintenance space required, and piping connections to hydronic systems.
 - a. Anchor Det Include plans, elevations, sections, and attachment details.
 - b. Include diagrams for power, signal, and control wiring.
- B. Informational Submittals:
 - 1. Seismic Qualification Certificates: For components, from manufacturer.
 - a. Basis for Certification: Indicate whether withstand certification is based on actual test of assembled components or on calculation.
 - b. Dimensioned Outline Drawings of Equipment Unit: Identify center of gravity and locate and describe mounting and anchorage provisions.
 - c. Detailed description of equipment anchorage devices on which the certification is based and their installation requirements.
 - 2. Water Analysis Provider Qualifications: Verification of experience and capability of HVAC water- treatment service provider.
 - 3. Field quality-control reports.
 - 4. Other Informational Submittals.

- a. Water-Treatment Program: Written sequence of operation on an annual basis for the application equipment required to achieve water quality defined in "Performance Requirements" Article.
- b. Water Analysis: Illustrate water quality available at Project site.
- C. Closeout Submittals
 - 1. Operation and Maintenance Data: For sensors, injection pumps, and controllers to include in emergency, operation, and maintenance manuals.

1.3 QUALITY ASSURANCE

A. HVAC Water-Treatment Service Provider Qualifications: An experienced HVAC watertreatment service provider capable of analyzing water qualities, installing water-treatment equipment, and applying water treatment as specified in this Section.

1.4 MAINTENANCE SERVICE

- A. HVAC Scope of Maintenance Service: Provide chemicals and service program to maintain water conditions required above to inhibit corrosion and scale formation for hydronic piping and equipment. Services and chemicals shall be provided for a period of one year from date of Substantial Completion and shall include the following:
 - 1. Initial water analysis and HVAC water-treatment recommendations.
 - 2. Startup assistance for Contractor to flush the systems, clean with detergents, and initially fill systems with required chemical treatment prior to operation.
 - 3. Periodic field service and consultation.
 - 4. Customer report charts and log sheets.
 - 5. Laboratory technical analysis.
 - 6. Analyses and reports of all chemical items concerning safety and compliance with government regulations.

PART 2 - PRODUCTS

2.1 PERFORMANCE REQUIREMENTS

- A. Water quality for hydronic systems shall minimize corrosion, scale buildup, and biological growth for optimum efficiency of hydronic equipment without creating a hazard to operating personnel or the environment.
- B. Base HVAC water treatment on quality of water available at Project site, hydronic system equipment material characteristics and functional performance characteristics, operating personnel capabilities, and requirements and guidelines of authorities having jurisdiction.
- C. Closed hydronic systems, including hot-water heating, shall have the following water qualities:
 - 1. pH: Greater than 7 and less than 9.

- 2. "P" Alkalinity: Maintain a value within 30 to 500 ppm.
- 3. Boron: Maintain a value within 100 to 200 ppm
- 4. Chemical Oxygen Demand: Maintain a maximum value of 100 ppm.
- 5. Soluble Copper: Maintain a maximum value of 0.2 ppm.
- 6. TSS: Maintain a maximum value of 10 ppm.
- 7. Ammonia: Maintain a maximum value of 20 ppm.
- 8. Free Caustic Alkalinity: Maintain a maximum value of 20 ppm.
- 9. Microbiological Limits:
 - a. Total Aerobic Plate Count: Maintain a maximum value of 1000 organisms/mL.
 - b. Total Anaerobic Plate Count: Maintain a maximum value of 100 organisms/mL.
 - c. Nitrate Reducers: Maintain a maximum value of 100 organisms/mL.
 - d. Sulfate Reducers: Maintain a maximum value of zero organisms/mL.
 - e. Iron Bacteria: Maintain a maximum value of zero organisms/mL.

2.2 MANUAL CHEMICAL-FEED EQUIPMENT

- A. Bypass Feeders: Steel, with corrosion-resistant exterior coating, minimum 3-1/2-inch fill opening in the top, and NPS 3/4 bottom inlet and top side outlet. Quarter turn or threaded fill cap with gasket seal and diaphragm to lock the top on the feeder when exposed to system pressure in the vessel.
 - 1. Capacity: 5 gal
 - 2. Minimum Working Pressure: 125 psig

2.3 CHEMICALS

A. Chemicals shall be as recommended by water-treatment system manufacturer that are compatible with piping system components and connected equipment and that can attain water quality specified in "Performance Requirements" Article.

PART 3 - EXECUTION

3.1 WATER ANALYSIS

A. Perform an analysis of supply water to determine quality of water available at Project site.

3.2 INSTALLATION

- A. Install chemical application equipment on concrete bases, level and plumb. Maintain manufacturer's recommended clearances. Arrange units so controls and devices that require servicing are accessible. Anchor chemical tanks and floor-mounting accessories to substrate.
- B. Install water testing equipment on wall near water chemical application equipment.
- C. Install interconnecting control wiring for chemical treatment controls and sensors.

- D. Mount sensors and injectors in piping circuits.
- E. Bypass Feeders: Install in closed hydronic systems, including hot-water heating, and equipped with the following:
 - 1. Install bypass feeder in a bypass circuit around circulating pumps unless otherwise indicated on Drawings.
 - 2. Install water meter in makeup-water supply.
 - 3. Install test-coupon assembly in bypass circuit around circulating pumps unless otherwise indicated on Drawings.
 - 4. Install a gate or full-port ball isolation valves on inlet, outlet, and drain below the feeder inlet.
 - 5. Install a swing check on the inlet after the isolation valve.

3.3 CONNECTIONS

- A. Where installing piping adjacent to equipment, allow space for service and maintenance.
- B. Make piping connections between HVAC water-treatment equipment and dissimilar-metal piping with dielectric fittings. Comply with requirements in Section 23 21 16 "Hydronic Piping Specialties."
- C. Install shutoff valves on HVAC water-treatment equipment inlet and outlet.
- D. Comply with requirements in Section 22 11 19 "Domestic Water Piping Specialties" for backflow preventers required in makeup-water connections to potable-water systems.
- E. Confirm applicable electrical requirements in electrical Sections for connecting electrical equipment.
- F. Ground equipment according to Section 26 05 26 "Grounding and Bonding for Electrical Systems."
- G. Connect wiring according to Section 26 05 19 "Low-Voltage Electrical Power Conductors and Cables."

3.4 FIELD QUALITY CONTROL

- A. Manufacturer's Field Service: Engage a factory-authorized service representative to test and inspect components, assemblies, and equipment installations, including connections.
- B. Perform the following tests and inspections with the assistance of a factory-authorized service representative:
 - 1. Inspect field-assembled components and equipment installation, including piping and electrical connections.
 - 2. Inspect piping and equipment to determine that systems and equipment have been cleaned, flushed, and filled with water, and are fully operational before introducing chemicals for water- treatment system.

- 3. Place HVAC water-treatment system into operation and calibrate controls during the preliminary phase of hydronic systems' startup procedures.
- 4. Do not enclose, cover, or put piping into operation until it is tested and satisfactory test results are achieved.
- 5. Test for leaks and defects. If testing is performed in segments, submit separate report for each test, complete with diagram of portion of piping tested.
- 6. Leave uncovered and unconcealed new, altered, extended, and replaced water piping until it has been tested and approved. Expose work that has been covered or concealed before it has been tested and approved.
- 7. Cap and subject piping to static water pressure of 50 psig above operating pressure, without exceeding pressure rating of piping system materials. Isolate test source and allow test pressure to stand for four hours. Leaks and loss in test pressure constitute defects.
- 8. Repair leaks and defects with new materials and retest piping until no leaks exist.
- C. Equipment will be considered defective if it does not pass tests and inspections.
- D. Prepare test and inspection reports.
- E. At six week intervals following Substantial Completion, perform separate water analyses on hydronic systems to show that automatic chemical-feed systems are maintaining water quality within performance requirements specified in this Section. Submit written reports of water analysis advising Owner of changes necessary to adhere to "Performance Requirements" Article.
- F. Comply with ASTM D 3370 and with the following standards:
 - 1. Silica: ASTM D 859.
 - 2. Acidity and Alkalinity: ASTM D 1067.
 - 3. Iron: ASTM D 1068.
 - 4. Water Hardness: ASTM D 1126.

3.5 DEMONSTRATION

- A. Train Owner's maintenance personnel to adjust, operate, and maintain HVAC water-treatment systems and equipment.
- B. Training: Provide a "how-to-use" self-contained breathing apparatus video that details exact operating procedures of equipment.

END OF SECTION 23 25 13

SECTION 23 64 23.13

AIR-COOLED, SCROLL WATER CHILLERS

PART 1 - GENERAL

1.1 SUMMARY

A. Section includes packaged, air-cooled, electric-motor-driven, scroll water chillers.

1.2 SUBMITTALS

- A. Action Submittals:
 - 1. Product Data: For each type of product.
 - a. Include refrigerant, rated capacities, operating characteristics, and furnished specialties and accessories.
 - b. Performance at AHRI standard conditions and at conditions indicated.
 - c. Performance at AHRI standard unloading conditions.
 - d. Minimum evaporator flow rate.
 - e. Refrigerant capacity of water chiller.
 - f. Oil capacity of water chiller.
 - g. Fluid capacity of evaporator.
 - h. Characteristics of safety relief valves.
 - i. Force and moment capacity of each piping connection.
 - j. Minimum entering condenser-water temperature.
 - k. Performance at varying capacity with constant design condenser-water temperature. Repeat performance at varying capacity for different condenser-water temperatures from design to minimum in 5 deg F increments.
 - 2. Shop Drawings: Complete set of manufacturer's prints of water chiller assemblies, control panels, sections and elevations, and unit isolation. Include the following:
 - a. Assembled unit dimensions.
 - b. Weight and load distribution.
 - c. Required clearances for maintenance and operation.
 - d. Size and location of piping and wiring connections.
 - e. Diagrams for power, signal, and control wiring.
- B. Informational Submittals:
 - 1. Certificates: For certification required in "Quality Assurance" Article.
 - 2. Seismic Qualification Data: Certificates, for water chillers, accessories, and components, from manufacturers.
 - a. Basis for Certification: Indicate whether withstand certification is based on actual test of assembled components or on calculation.

- b. Dimensioned Outline Drawings of Equipment Unit: Identify center of gravity and locate and describe mounting and anchorage provisions.
- c. Detailed description of equipment anchorage devices on which the certification is based and their installation requirements.
- 3. Installation instructions.
- 4. Source quality-control reports.
- 5. Startup service reports.
- 6. Sample Warranty: For special warranty.
- C. Closeout Submittals:
 - 1. Operation and Maintenance Data: For each water chiller to include in emergency, operation, and maintenance manuals.
 - 2. Spare Parts List: Recommended spare parts list with quantity for each.
 - 3. Touchup Paint Description: Detailed description of paint used in application of finish coat to allow for procurement of a matching paint.
 - 4. Instructional Videos: Including those that are prerecorded and those that are recorded during training.

1.3 EXTRA MATERIALS

- A. Tool kit to include the following:
 - 1. A tool kit specially designed by chiller manufacturer for use in servicing chiller(s) furnished.
 - 2. Special tools required to service chiller components not readily available to Owner service personnel in performing routine maintenance.
 - 3. Lockable case with hinged cover, marked with large and permanent text to indicate the special purpose of tool kit, such as "Chiller Tool Kit." Text size shall be at least 1 inch high.
 - 4. A list of each tool furnished. Permanently attach the list to underside of case cover. Text size shall be at least 1/2 inch high.
- B. Touchup Paint: 32 oz. container of paint used for finish coat. Label outside of container with detailed description of paint to allow for procurement of a matching paint in the future.

1.4 QUALITY ASSURANCE

- A. AHRI Certification: Rate and certify chiller according to AHRI 550/590 certification program.
- B. ASHRAE Compliance:
 - 1. ASHRAE 15.
 - 2. ASHRAE 90.1.
 - 3. ASHRAE 147.

- C. ASME Compliance: Fabricate and label chillers to comply with ASME Boiler and Pressure Vessel Code: Section VIII, Division 1, as applicable to chiller design. For chillers charged with R-134a refrigerant, include and ASME U-stamp and nameplate certifying compliance.
- D. Comply with NFPA 70.
- E. Comply with UL 465 at the specified short circuit rating.
- F. Comply with requirements of UL 1995, "Heating and Cooling Equipment," and include label by a qualified testing agency showing compliance.

1.5 DELIVERY, STORAGE, AND HANDLING

- A. Ship water chillers from the factory fully charged with refrigerant and oil.
- B. Deliver chiller with protective crating or other covering.

1.6 WARRANTY

- 1. Extended warranties include, but are not limited to, the following:
 - a. Complete chiller including refrigerant and oil charge.
 - b. Parts and labor.
- 2. Warranty Period: Five (5) years from the date of substantial completion.

PART 2 - PRODUCTS

2.1 PERFORMANCE REQUIREMENTS

- A. Outdoor Installations:
 - 1. Chiller shall be suitable for outdoor installation indicated. Provide adequate weather protection to ensure reliable service life over a 25-year period with minimal degradation due to exposure to outdoor ambient conditions.
 - 2. Chillers equipped to provide safe and stable operation while achieving performance indicated when operating at extreme outdoor temperatures encountered by the installation. Review historical weather database and provide equipment that can operate at extreme outdoor temperatures recorded over past 30-year period.
- B. Seismic Fabrication Requirements: Chillers shall withstand the effects of earthquake motions determined according to ASCE/SEI 7.
 1. The term "withstand" means "the unit will remain in place without separation of any
 - The term withstand means the unit will remain in place without separation of any parts when subjected to the seismic forces specified."
 Component Importance Factor: [1,0]
 - 2. Component Importance Factor: [1.0].

2.2 MANUFACTURERS

- A. Manufacturer: Subject to compliance with requirements, provide products by one of the following. Where a specific manufacturer is listed in the Drawings, this shall be considered the Basis-of-Design.
 - 1. Carrier.
 - 2. Daikin Applied.
 - 3. MultiStack.
 - 4. Quantech.
 - 5. Trane.
 - 6. York; a Johnson Controls company.

2.3 MANUFACTURED UNITS

- A. Description: Factory-assembled and run-tested water chiller complete with compressor(s), compressor motors and motor controllers, evaporator, condenser with fans, electrical power, controls, and indicated accessories.
- B. Fabricate water chiller mounting base with reinforcement strong enough to resist water chiller movement during a seismic event when water chiller is anchored to field support structure.

2.4 CABINET

- A. Base: Galvanized- or stainless-steel base extending the perimeter of water chiller. Secure frame, compressors, and evaporator to base to provide a single-piece unit.
- B. Frame: Rigid galvanized- or stainless-steel frame secured to base and designed to support cabinet, condenser, control panel, and other chiller components not directly supported from base.
- C. Casing: Galvanized- or stainless-steel.
- D. Finish: Coat galvanized-steel base, frame, and casing with a corrosion-resistant coating capable of withstanding a 500-hour salt-spray test according to ASTM B 117.

2.5 COMPRESSOR-DRIVE ASSEMBLIES

- A. Compressors:
 - 1. Description: Positive-displacement direct drive with hermetically sealed casing.
 - 2. Each compressor provided with suction and discharge service valves, crankcase oil heater, and suction strainer. For multiple compressor assemblies, it is acceptable to isolate each compressor assembly in lieu of each compressor.
 - 3. Operating Speed: Nominal 3600 rpm for 60-Hz applications.
 - 4. Capacity Control: On-off compressor cycling with hot-gas bypass, if necessary, to achieve performance indicated. Digital compressor unloading is an acceptable alternative to achieve capacity control.

- 5. Oil Lubrication System: Automatic pump with strainer, sight glass, filling connection, filter with magnetic plug or removable magnet in sump, and initial oil charge. Manufacturer's other standard methods of providing positive lubrication are acceptable in lieu of an automatic pump.
- 6. Vibration Isolation: Mount individual compressors on vibration isolators. For multiple compressor assemblies, it is acceptable to isolate each compressor assembly in lieu of each compressor.
- B. Compressor Motors:
 - 1. Hermetically sealed and cooled by refrigerant suction gas.
 - 2. High-torque, two-pole induction type with inherent thermal-overload protection on each phase.
- C. Compressor Motor Controllers:
 - 1. Across the Line: NEMA ICS 2, Class A, full voltage, non-reversing.

2.6 REFRIGERATION

- A. Refrigerant: R-410A. Classified as Safety Group A1 according to ASHRAE 34.
- B. Refrigerant Compatibility: Parts exposed to refrigerants shall be fully compatible with refrigerants, and pressure components shall be rated for refrigerant pressures.
- C. Refrigerant Circuit: Each circuit shall include an electronic-expansion valve, refrigerant charging connections, a hot-gas muffler, compressor suction and discharge shutoff valves, a liquid-line shutoff valve, a replaceable-core filter-dryer, a sight glass with moisture indicator, a liquid-line solenoid valve, and an insulated suction line.
- D. Refrigerant Isolation: Factory install positive shutoff isolation valves in the compressor discharge line and the refrigerant liquid-line to allow the isolation and storage of the refrigerant charge in the chiller condenser.
 - 1. For multiple compressor assemblies, it is acceptable to isolate each compressor assembly in each circuit in lieu of each compressor.
- E. Pressure Relief Device:
 - 1. Comply with requirements in ASHRAE 15, ASHRAE 147, and applicable portions of ASME Boiler and Pressure Vessel Code: Section VIII, Division 1.
 - 2. Select and configure pressure relief devices to protect against corrosion and inadvertent release of refrigerant.
 - 3. ASME-rated, spring-loaded, pressure relief valve; single- or multiple-reseating type. Pressure relief valve(s) shall be provided for each heat exchanger.

2.7 EVAPORATOR

A. Brazed-plate or shell-and-tube design, as indicated.

- B. Shell and Tube:
 - 1. Description: Direct-expansion, shell-and-tube design with fluid flowing through the shell and refrigerant flowing through the tubes within the shell.
 - 2. Code Compliance: Tested and stamped according to ASME Boiler and Pressure Vessel Code.
 - 3. Shell Material: Carbon steel.
 - 4. Shell Heads: Removable carbon-steel heads with multi-pass baffles designed to ensure positive oil return and located at each end of the tube bundle.
 - 5. Shell Nozzles: Fluid nozzles located along the side of the shell and terminated with mechanical-coupling end connections for connection to field piping. Furnish flange adapters to mate to flanged piping.
 - 6. Tube Construction: Individually replaceable copper tubes with enhanced fin design, expanded into tube sheets.
- C. Brazed Plate:
 - 1. Direct-expansion, single-pass, brazed-plate design.
 - 2. Type 304 or 316 stainless-steel construction.
 - 3. Code Compliance: Tested according to ASME Boiler and Pressure Vessel Code.
 - 4. Fluid Nozzles: Terminate with flange or mechanical-coupling end connections for connection to field piping.
 - 5. Inlet Strainer: Factory-furnished, 40 mesh strainer for field installation in supply piping to evaporator. Manufacturer has option to factory install strainer.
- D. Flow Switch: Factory-furnished, thermal-type flow switch wired to chiller operating controls.
- E. Heater: Factory-installed and -wired electric heater with integral controls designed to protect the evaporator to minus 20 deg F.
- F. Remote-Mounting Kit: Designed for remote field mounting where indicated. Provide kit for field installation.

2.8 AIR-COOLED CONDENSER

- A. Coils with integral subcooling on each circuit.
- B. Plate Fin Coils: Construct coils of copper tubes mechanically bonded to aluminum fins.
- C. Aluminum Microchannel Coils:
 - 1. Series of flat tubes containing a series of multiple, parallel-flow microchannels layered between refrigerant header manifolds.
 - 2. Single- or multiple-pass arrangement.
 - 3. Construct fins, tubes, and header manifolds of aluminum alloy treated with a corrosion-resistant coating.
- D. Hail Protection: Provide condenser coils with louvers, baffles, or hoods to protect against hail damage.

- E. Fans: Direct-drive propeller type with statically and dynamically balanced fan blades, arranged for vertical air discharge.
- F. Fan Motors: Totally enclosed non-ventilated or totally enclosed air over enclosure, with sealed and permanently lubricated bearings, and having built-in overcurrent- and thermal-overload protection.
 - 1. Overcurrent- and thermal-overload protection not integral to motor is acceptable if provided with chiller electrical power package.
- G. Fan Guards: Removable steel safety guards with corrosion-resistant coating.

2.9 INSULATION

- A. Closed-cell, flexible, elastomeric thermal insulation complying with ASTM C 534/C 534M, Type I for tubular materials and Type II for sheet materials.
 - 1. Thickness: 3/4 inches.
- B. Adhesive: As recommended by insulation manufacturer.
- C. Factory-applied insulation over all cold surfaces of chiller capable of forming condensation. Components shall include, but not be limited to, evaporator, evaporator water boxes including nozzles, refrigerant suction pipe from evaporator to compressor, cold surfaces of compressor, refrigerant-cooled motor, and auxiliary piping.
 - 1. Apply adhesive to 100 percent of insulation contact surface.
 - 2. Before insulating steel surfaces, prepare surfaces for paint, and prime and paint as indicated for other painted components. Do not insulate unpainted steel surfaces.
 - 3. Seal seams and joints to provide a vapor barrier.
 - 4. After adhesive has fully cured, paint exposed surfaces of insulation to match other painted parts.
 - 5. Manufacturer has option to factory or field insulate chiller components to reduce potential for damage during installation.
 - 6. Field-Applied Insulation:
 - a. Components that are not factory insulated shall be field insulated to comply with requirements indicated.
 - b. Manufacturer shall be responsible for chiller insulation whether factory or field installed to ensure that manufacturer is the single point of responsibility for chillers.
 - c. Manufacturer's factory-authorized service representative shall instruct and supervise installation of field-applied insulation.
 - d. After field-applied insulation is complete, paint insulation to match factory-applied finish.

2.10 ELECTRICAL

A. Factory installed and wired, and functionally tested at factory before shipment.

- B. Factory-installed and -wired switches, motor controllers, transformers, and other electrical devices necessary shall provide a single-point field power connection to water chiller.
- C. House in a unit-mounted, NEMA 250, Type 3R enclosure with hinged access door with lock and key.
- D. Wiring shall be numbered and color-coded to match wiring diagram.
- E. Factory wiring outside of an enclosure shall be in raceway. Terminal connections shall be made with not more than a 24-inch length of liquid-tight or flexible metallic conduit.
- F. Single-Point Circuit Breaker A unit mounted circuit breaker with external, lockable handle (in compliance with NEC Article 440-14), can be supplied to isolate the power voltage for servicing. This option includes the Single-Point Power connection. Minimum short-circuit current rating (SCCR) according to UL 508 shall be as required by electrical power distribution system, but not less than 65,000 A.
- G. Each motor shall have branch power circuit and controls with one of the following disconnecting means having SCCR to match main disconnecting means:
 - 1. NEMA KS 1, heavy-duty, non-fusible switch.
- H. Each motor shall have overcurrent protection.
- I. Overload relay sized according to UL 1995, or an integral component of water chiller control microprocessor.
- J. Phase-Failure and Undervoltage: Solid-state sensing with adjustable settings.
- K. Controls Transformer: Unit-mounted transformer with primary and secondary fuses and sized with enough capacity to operate electrical load plus spare capacity.
- L. Control Relays: Auxiliary and adjustable time-delay relays, or an integral to water chiller microprocessor.

2.11 CONTROLS

- A. Factory installed and wired, and functionally tested at factory before shipment.
- B. The chiller shall be equipped with a micro-processor based controller. The chiller shall have the capability to operate in response to either heating water or cooling water set points. The selection of these two modes of operation shall be made by the chiller's Master Controller or, alternatively, this mode may be set manually, or through a binary input to the controller. The Chiller shall operate based on constant primary flow via the manufacturer provided, field installed and wired, pumps for the chiller's condenser and evaporator flow.
- C. Enclosure: Share enclosure with electrical power devices or provide a separate enclosure of matching construction.
- D. Operator Interface: Keypad or pressure-sensitive touch screen. Multiple-character, digital display. Display the following:

- 1. Date and time.
- 2. Operating or alarm status.
- 3. Operating hours.
- 4. Outside-air temperature if required for chilled-water reset.
- 5. Temperature and pressure of operating set points.
- 6. Chilled-water entering and leaving temperatures.
- 7. Heating Hot-water entering and leaving temperatures.
- 8. Refrigerant pressures in evaporator and condenser.
- 9. Saturation temperature in evaporator and condenser.
- 10. No cooling load condition.
- 11. Elapsed time meter (compressor run status).
- 12. Antirecycling timer status.
- 13. Percent of maximum motor amperage.
- 14. Current-limit set point.
- 15. Number of compressor starts.
- 16. Alarm history with retention of operational data before unit shutdown.
- 17. Superheat.
- E. Control Functions:
 - 1. Manual or automatic startup and shutdown time schedule.
 - 2. Capacity control based on evaporator leaving-fluid temperature.
 - 3. Capacity control compensated by rate of change of evaporator entering-fluid temperature.
 - 4. Chilled-water entering and leaving temperatures, control set points, and motor load limit.
 - 5. Heating Hot-water entering and leaving temperatures, control set points, and motor load limit.
 - 6. Current limit and demand limit.
 - 7. Condenser-water temperature.
 - 8. External water chiller emergency stop.
 - 9. Antirecycling timer.
 - 10. Automatic lead-lag switching.
- F. Manual-Reset Safety Controls: The following conditions shall shut down water chiller and require manual reset:
 - 1. Low evaporator pressure or high condenser pressure.
 - 2. Low chilled-water temperature.
 - 3. Refrigerant high pressure.
 - 4. High or low oil pressure.
 - 5. High oil temperature.
 - 6. Loss of chilled-water flow.
 - 7. Loss of heating hot-water flow.
 - 8. Control device failure.
- G. BAS/DDC System Interface: Factory-install hardware and software to enable system to monitor, control, and display chiller status and alarms.
 - 1. Communication Interface: ASHRAE 135 (BACnet) communication interface shall enable control system operator to remotely control and monitor the water chiller from an operator workstation. Control features and monitoring points displayed locally at water chiller control panel shall be available through DDC system for HVAC.

H. Factory-installed wiring outside of enclosures shall be in NFPA 70-compliant raceway. Make terminal connections with liquid-tight or flexible metallic conduit.

2.12 ACCESSORIES

A. Factory-furnished vibration isolators with seismic restraints for field installation.

2.13 SOURCE QUALITY CONTROL

- A. Perform functional test of water chillers before shipping.
- B. Factory performance test water chillers before shipping.
- C. Factory test and inspect evaporator according to ASME Boiler and Pressure Vessel Code: Section VIII, Division 1. Stamp with ASME label.
- D. Rate sound power level according to AHRI 370 procedure.

PART 3 - EXECUTION

3.1 EXAMINATION

- A. Examine chillers before installation. Reject chillers that are damaged.
- B. Before water chiller installation, examine roughing-in for equipment support, anchor-bolt sizes and locations, piping, controls, and electrical connections to verify actual locations, sizes, and other conditions affecting water chiller performance, maintenance, and operations.
 - 1. Water chiller locations indicated on Drawings are approximate. Determine exact locations before roughing-in for piping, controls, and electrical connections.
- C. Proceed with installation only after unsatisfactory conditions have been corrected.

3.2 WATER CHILLER INSTALLATION

- A. Coordinate sizes and locations of bases with actual equipment provided. Cast anchor-bolt inserts into concrete bases.
- B. Coordinate sizes, locations, and anchoring attachments of structural-steel support structures with actual equipment provided.
- C. Install water chillers on support structure indicated.
- D. Equipment Mounting:
 - 1. Install water chillers on cast-in-place concrete equipment bases. Comply with requirements for equipment bases and foundations specified in Division 03.

- 2. Comply with requirements for vibration isolation and seismic-control devices specified in Division 23.
- E. Maintain manufacturer's recommended clearances for service and maintenance.
- F. Maintain clearances required by governing code.
- G. Chiller manufacturer's factory-trained service personnel shall charge water chiller with refrigerant if not factory charged and fill with oil if not factory installed.
- H. Install separate devices furnished by manufacturer and not factory installed.
 - 1. Chillers shipped in multiple major assemblies shall be field assembled under the direct supervision of chiller manufacturer's factory-trained service personnel.

3.3 WATER TREATMENT REQUIREMENTS

- A. Cycles of concentration shall be controlled such that recirculated water quality for modular Air- Chillers using 316 stainless steel brazed plate heat exchangers and carbon steel headers is maintained within the following parameters:
 - 1. pH
 - 2. Total Dissolved Solids (TDS)
 - 3. Hardness as CaCO₃
 - 4. Alkalinity as Ca CO₃
 - 5. Chlorides
 - 6. Sulfates

Greater than 7 and less than 9 Less than 1000 ppm 30 to 500 ppm Jo to 500 ppm Less than 200 ppm Less than 200 ppm

3.4 PIPING CONNECTIONS

- A. Comply with requirements in Division 23 "Hydronic Piping". Drawings indicate general arrangement of piping, fittings, and specialties.
- B. Where installing piping adjacent to chillers, allow space for service and maintenance.
- C. Make connections to water chiller with flanges or mechanical couplings.

3.5 ELECTRICAL POWER CONNECTIONS

- A. Connect wiring according to Division 26 "Low-Voltage Electrical Power Conductors and Cables."
- B. Ground equipment according to Division 26 "Grounding and Bonding for Electrical Systems."
- C. Provide nameplate for each electrical connection indicating electrical equipment designation and circuit number feeding connection. Nameplate shall be laminated phenolic layers of black with engraved white letters at least 1/2 inch high. Locate nameplate where easily visible.

3.6 CONTROLS CONNECTIONS

- A. Install control and electrical power wiring to field-mounted control devices.
- B. Connect control wiring between chillers and other equipment to interlock operation as required to provide a complete and functioning system.
- C. Connect control wiring between chiller control interface and DDC system for remote monitoring and control of chillers. Comply with requirements in Division 23 "Direct Digital Control (DDC) System for HVAC."
- D. Provide nameplate on face of chiller control panel indicating control equipment designation serving chiller and the I/O point designation for each control connection. Nameplate shall be laminated phenolic layers of black with engraved white letters at least 1/2 inch high.

3.7 STARTUP SERVICE

- A. Engage a factory-authorized service representative to perform startup service.
- B. Visually inspect chiller for damage before starting. Repair or replace damaged components, including insulation. Do not start chiller until damage that is detrimental to operation has been corrected.
- C. Complete installation and startup checks according to manufacturer's written instructions and perform the following:
 - 1. Verify that refrigerant charge is sufficient and water chiller has been leak-tested.
 - 2. Verify that pumps are installed and functional.
 - 3. Verify that thermometers and gages are installed.
 - 4. Operate water chiller for run-in period.
 - 5. Check bearing lubrication and oil levels.
 - 6. Verify that refrigerant pressure relief device is properly vented outside.
 - 7. Verify proper motor rotation.
 - 8. Verify static deflection of vibration isolators, including deflection during water chiller startup and shutdown.
 - 9. Verify and record performance of chilled-water flow and low-temperature interlocks.
 - 10. Verify and record performance of water chiller protection devices.
 - 11. Test and adjust controls and safeties. Replace damaged or malfunctioning controls and equipment.
- D. Prepare a written startup report that records results of tests and inspections.

3.8 DEMONSTRATION

A. Engage a factory-authorized service representative to train Owner's maintenance personnel to adjust, operate, and maintain water chillers. Video record the training sessions and provide electronic copy to Owner. Provide not less than eight hours of training.

END OF SECTION 23 64 23.13

SECTION 23 64 23

DEDICATED HEAT RECOVERY SCROLL WATER CHILLERS

PART 1 - GENERAL

1.1 RELATED DOCUMENTS

A. Drawings and general provisions of the Contract, including General and Supplementary Conditions and Division 01 Specification Sections, apply to this Section.

1.2 SUMMARY

- A. Section Includes:
 - 1. Packaged, water-cooled, electric-motor-driven, dedicated heat recovery scroll water chillers.

1.3 DEFINITIONS

- A. DHRC: Dedicated Heat Recovery Chiller
- B. COP: Coefficient of performance. The ratio of the rate of heat removal to the rate of energy input using consistent units for any given set of rating conditions.
- C. EER: Energy-efficiency ratio. The ratio of the cooling capacity given in terms of Btu/h to the total power input given in terms of watts at any given set of rating conditions.
- D. IPLV: Integrated part-load value. A single number part-load efficiency figure of merit calculated per the method defined by ARI 550/590 and referenced to ARI standard rating conditions.
- E. kW/Ton: The ratio of total power input of the chiller in kilowatts to the net refrigerating capacity in tons at any given set of rating conditions.
- F. NPLV: Nonstandard part-load value. A single number part-load efficiency figure of merit calculated per the method defined by ARI 550/590 and intended for operating conditions other than the ARI standard rating conditions.

1.4 SUBMITTALS

- A. Product Data: Include refrigerant, rated capacities, operating characteristics, furnished specialties, and accessories.
 - 1. Performance at ARI standard conditions and at conditions indicated.

- 2. Performance at ARI standard unloading conditions.
- 3. Minimum evaporator flow rate.
- 4. Refrigerant capacity of water chiller.
- 5. Oil capacity of water chiller.
- 6. Fluid capacity of evaporator.
- 7. Fluid capacity of condenser.
- 8. Characteristics of safety relief valves.
- 9. Minimum entering condenser-water temperature.
- 10. Performance at varying capacity with constant design condenser-water temperature. Repeat performance at varying capacity for different condenser-water temperatures from design to minimum in 5 deg F increments.
- B. Seismic Qualification Data: Certificates, for water chillers, accessories, and components, from manufacturers.

Basis for Certification: Indicate whether withstand certification is based on actual test of assembled components or on calculation. Dimensioned Outline Drawings of Equipment Unit: Identify center of gravity and locate and describe mounting and anchorage provisions. Detailed description of equipment anchorage devices on which the certification is based and their installation requirements.

- C. Shop Drawings: Complete set of manufacturer's prints of water chiller assemblies, control panels, sections and elevations, and unit isolation. Include the following:
 - 1. Assembled unit dimensions.
 - 2. Weight and load distribution.
 - 3. Required clearances for maintenance and operation.
 - 4. Size and location of piping and wiring connections.
 - 5. Wiring Diagrams: For power, signal, and control wiring.
- D. Coordination Drawings: Floor plans, drawn to scale, on which the following items are shown and coordinated with each other, using input from installers of the items involved:
 - 1. Structural supports.
 - 2. Piping roughing-in requirements.
 - 3. Wiring roughing-in requirements, including spaces reserved for electrical equipment.
 - 4. Access requirements, including working clearances for mechanical controls and electrical equipment, and tube pull and service clearances.
- E. Certificates: For certification required in "Quality Assurance" Article.
- F. Source quality-control test reports.
- G. Startup service reports.
- H. Operation and Maintenance Data: For each water chiller to include in emergency, operation, and maintenance manuals.
- I. Warranty: Sample of special warranty.

1.5 QUALITY ASSURANCE

- A. ARI Certification: Certify chiller according to ARI 590 certification program.
- B. ARI Rating: Rate water chiller performance according to requirements in ARI 550/590, "Water Chilling Packages Using the Vapor Compression Cycle."
- C. ASHRAE Compliance:
 - 1. ASHRAE 15 for safety code for mechanical refrigeration.
 - 2. ASHRAE Guideline 3 for refrigerant leaks, recovery, and handling and storage requirements.
- D. ASME Compliance: Fabricate and stamp water chiller heat exchangers to comply with ASME Boiler and Pressure Vessel Code.
- E. Comply with NFPA 70.
- 1.6 DELIVERY, STORAGE, AND HANDLING
 - A. Ship water chillers from the factory fully charged with refrigerant and filled with oil.

1.7 COORDINATION

A. Coordinate sizes and locations of concrete bases with actual equipment provided.

1.8 WARRANTY

- A. Special Warranty: Manufacturer's standard form in which manufacturer agrees to repair or replace components of water chillers that fail in materials or workmanship within specified period.
 - 1. Compressor Warranty Period: Five years from date of Substantial Completion.

PART 2 - PRODUCTS

2.1 PACKAGED DEDICATED HEAT RECOVERY WATER-COOLED CHILLERS

A. Seismic Performance: Scroll water chillers shall withstand the effects of earthquake motions determined according to ASCE/SEI 7.

- 1. The term "withstand" means "the unit will remain in place without separation of any parts when subjected to the seismic forces specified."
- 2. Component Importance Factor: [1.0].

- B. Manufacturers: Subject to compliance with requirements, or a comparable product by one of the following:
 - 1. ArctiChill.
 - 2. Carrier.
 - 3. Chillit Company.
 - 4. MultiStack.
 - 5. Quantech.
 - 6. Johnson Controls.
 - 7. Water Furnace.
- C. Description: Factory-assembled and run-tested water chiller complete with compressor(s), compressor motors and motor controllers, evaporator, condenser where indicated, electrical power, controls, and indicated accessories.
- D. Compressors:
 - 1. Description: Positive-displacement direct drive with hermetically sealed casing. Each compressor provided with suction and discharge service valves, crankcase oil heater, and suction strainer.
 - 2. Operating Speed: Nominal 3600 rpm for 60-Hz applications.
 - 3. Capacity Control: On-off compressor cycling.
 - 4. Oil Lubrication System: Automatic pump with strainer, sight glass, filling connection, filter with magnetic plug, and initial oil charge.
- E. Compressor Motors:
 - 1. Hermetically sealed and cooled by refrigerant suction gas.
 - 2. High-torque, two-pole induction type with inherent thermal-overload protection on each phase.
- F. Compressor Motor Controllers:
 - 1. Across the Line: NEMA ICS 2, Class A, full voltage, nonreversing.
- G. Refrigeration:
 - 1. Refrigerant: R-410a.
 - 2. Refrigerant Compatibility: Parts exposed to refrigerants shall be fully compatible with refrigerants, and pressure components shall be rated for refrigerant pressures.
 - 3. Refrigerant Circuit: Each circuit shall include a thermal-expansion valve, refrigerant charging connections, a hot-gas muffler, compressor suction and discharge shutoff valves, a liquid-line shutoff valve, a replaceable-core filter-dryer, a sight glass with moisture indicator, a liquid-line solenoid valve, and an insulated suction line.
 - 4. Refrigerant Isolation: Factory install positive shutoff isolation valves in the compressor discharge line and the refrigerant liquid-line to allow the isolation and storage of the refrigerant charge in the chiller condenser.
- H. Evaporator:

- 1. Brazed-plate or shell-and-tube design, as indicated.
- 2. Shell and Tube:
 - a. Description: Direct-expansion, shell-and-tube design with fluid flowing through the shell and refrigerant flowing through the tubes within the shell.
 - b. Code Compliance: Tested and stamped according to ASME Boiler and Pressure Vessel Code.
 - c. Shell Material: Carbon steel.
 - d. Shell Heads: Removable carbon-steel heads with multipass baffles designed to ensure positive oil return and located at each end of the tube bundle.
 - e. Shell Nozzles: Fluid nozzles located along the side of the shell and terminated with mechanical-coupling end connections for connection to field piping.
 - f. Tube Construction: Individually replaceable copper tubes with enhanced fin design, expanded into tube sheets.
- 3. Brazed Plate:
 - a. Direct-expansion, single-pass, brazed-plate design.
 - b. Type 316 stainless-steel construction.
 - c. Code Compliance: Tested and stamped according to ASME Boiler and Pressure Vessel Code.
 - d. Fluid Nozzles: Terminate with mechanical-coupling end connections for connection to field piping.
- I. Condenser:
 - 1. Shell and Tube:
 - a. Description: Shell-and-tube design with refrigerant flowing through the shell and fluid flowing through the tubes within the shell.
 - b. Provides positive subcooling of liquid refrigerant.
 - c. Code Compliance: Tested and stamped according to ASME Boiler and Pressure Vessel Code.
 - d. Shell Material: Carbon steel.
 - e. Water Boxes: Removable, of carbon-steel construction, located at each end of the tube bundle with fluid nozzles terminated with mechanical-coupling end connections for connection to field piping.
 - f. Tube Construction: Individually replaceable copper tubes with enhanced fin design, expanded into tube sheets.
 - g. Provide each condenser with a pressure relief device, purge cock, and liquidline shutoff valve.
- J. Electrical Power:
 - 1. Factory-installed and -wired switches, motor controllers, transformers, and other electrical devices necessary shall provide a single-point field power connection to water chiller.
 - 2. House in a unit-mounted, NEMA 250, Type 1 enclosure with hinged access door with lock and key or padlock and key.

- 3. Wiring shall be numbered and color-coded to match wiring diagram.
- 4. Install factory wiring outside of an enclosure in a raceway.
- 5. Field power interface shall be to NEMA KS 1, heavy-duty, non-fused disconnect switch. Minimum short-circuit current rating (SCCR) according to UL 508 shall be as required by electrical power distribution system, but not less than 65,000 A.
- 6. Provide branch power circuit to each motor and to controls with one of the following disconnecting means:
 - a. NEMA KS 1, heavy-duty, fusible switch with rejection-type fuse clips rated for fuses. Select and size fuses to provide Type 2 protection according to IEC 60947- 4-1.
 - b. NEMA KS 1, heavy-duty, nonfusible switch.
 - c. NEMA AB 1, motor-circuit protector (circuit breaker) with field-adjustable, short- circuit trip coordinated with motor locked-rotor amperes.
- 7. Provide each motor with overcurrent protection.
- 8. Overload relay sized according to UL 1995, or an integral component of water chiller control microprocessor.
- 9. Phase-Failure and Undervoltage: Solid-state sensing with adjustable settings.
- 10. Controls Transformer: Unit-mounted transformer with primary and secondary fuses and sized with enough capacity to operate electrical load plus spare capacity.
- 11. Control Relays: Auxiliary and adjustable time-delay relays.
- 12. Indicate the following for water chiller electrical power supply:
 - a. Current, phase to phase, for all three phases.
 - b. Voltage, phase to phase and phase to neutral for all three phases.
 - c. Three-phase real power (kilowatts).
 - d. Three-phase reactive power (kilovolt amperes reactive).
 - e. Power factor.
 - f. Running log of total power versus time (kilowatt hours).
 - g. Fault log, with time and date of each.
- K. Controls:
 - 1. The DHRC shall be equipped with a micro-processor based controller. The DHRC shall have the capability to operate in response to either heating water or cooling water set points. The selection of these two modes of operation shall be made by the DHRC's Master Controller or, alternatively, this mode may be set manually, or through a binary input to the controller. The Chiller shall operate based on constant primary flow via the manufacturer provided, field installed and wired, pumps for the DHRC's condenser and evaporator flow.
 - 2. Enclosure: Share enclosure with electrical power devices or provide a separate enclosure of matching construction.
 - 3. Operator Interface: Keypad or pressure-sensitive touch screen. Multiplecharacter, backlit, liquid-crystal display or light-emitting diodes. Display the following:
 - a. Date and time.
 - b. Operating or alarm status.
 - c. Operating hours.
 - d. Outside-air temperature if required for chilled-water reset.
 - e. Temperature and pressure of operating set points.

- f. Entering and leaving temperatures of chilled water.
- g. Entering and leaving temperatures of condenser water.
- h. Refrigerant pressures in evaporator and condenser.
- i. Saturation temperature in evaporator and condenser.
- j. No cooling load condition.
- k. Elapsed time meter (compressor run status).
- 1. Pump status.
- m. Antirecycling timer status.
- n. Percent of maximum motor amperage.
- o. Current-limit set point.
- p. Number of compressor starts.
- 4. Control Functions:
 - a. Manual or automatic startup and shutdown time schedule.
 - b. Entering and leaving chilled-water temperatures, control set points, and motor load limit. Chilled-water leaving temperature shall be reset based on return-water temperature.
 - c. Current limit and demand limit.
 - d. Condenser-water temperature.
 - e. External water chiller emergency stop.
 - f. Antirecycling timer.
 - g. Automatic lead-lag switching.
- 5. Manual-Reset Safety Controls: The following conditions shall shut down water chiller and require manual reset:
 - a. Low evaporator pressure or high condenser pressure.
 - b. Low chilled-water temperature.
 - c. Refrigerant high pressure.
 - d. High or low oil pressure.
 - e. High oil temperature.
 - f. Loss of chilled-water flow.
 - g. Loss of condenser-water flow.
 - h. Control device failure.
- 6. Failure to Run Mode (FRM): Chiller shall be capable of operation in the event that the Master Controller has lost communication. FRM provides the ability to switch the chiller into manual mode automatically keeping the chiller online until a replacement Master Controller can be provided. FRM requires a power phase monitor per module.
- 7. Building Management System Interface: Factory-installed hardware and software to enable building management system to monitor, control, and display water chiller status and alarms.
 - a. BACnet communication interface with building management system shall enable building management system operator to remotely control and monitor the water chiller from an operator workstation. Control features and monitoring points displayed locally at water chiller control panel shall be available through building management system.

- L. Insulation:
 - 1. Material: Closed-cell, flexible elastomeric, thermal insulation complying with ASTM C 534, Type I, for tubular materials and Type II, for sheet materials.
 - 2. Thickness: 1 inch
 - 3. Factory-applied insulation over cold surfaces of water chiller components.
 - a. Adhesive: As recommended by insulation manufacturer and applied to 100 percent of insulation contact surface. Seal seams and joints.
 - 4. Apply protective coating to exposed surfaces of insulation.
- M. Accessories:
 - 1. Each inlet water header shall incorporate a built in 30-mesh (maximum) in-line strainer system to prevent heat exchanger fouling and accommodate 100% flow filtration with a minimum surface area of 475 sq inches per module.
 - 2. Factory-furnished, chilled- and condenser-water flow switches for field installation.
 - 3. Individual compressor suction and discharge pressure gages with shutoff valves for each refrigeration circuit.
 - 4. Factory-furnished neoprene or spring isolators for field installation.
 - 5. Factory furnished field installed and wired condenser and evaporator pumps.
 - 6. Factory furnished field installed and wired head pressure control valves
- N. Capacities and Characteristics:
 - 1. Refer to drawing.

2.2 SOURCE QUALITY CONTROL

- A. Perform functional test of water chillers before shipping.
- B. Factory performance test water chillers, before shipping, according to ARI 550/590, "Water Chilling Packages Using the Vapor Compression Cycle."
- C. Factory test and inspect evaporator and water-cooled condenser according to ASME Boiler and Pressure Vessel Code: Section VIII, Division 1. Stamp with ASME label.
- D. For water chillers located indoors, rate sound power level according to ARI 575 procedure.

PART 3 - EXECUTION

3.1 EXAMINATION

A. Before water chiller installation, examine roughing-in for equipment support, anchor-bolt sizes and locations, piping, and electrical connections to verify actual locations, sizes, and other conditions affecting water chiller performance, maintenance, and operations.

- 1. Water chiller locations indicated on Drawings are approximate. Determine exact locations before roughing-in for piping and electrical connections.
- B. Proceed with installation only after unsatisfactory conditions have been corrected.

3.2 WATER CHILLER INSTALLATION

- A. Equipment Mounting: Comply with requirements for vibration isolation devices specified in Division 23.
 - 1. Minimum Deflection: 1/4 inch.
 - 2. Install dowel rods to connect concrete base to concrete floor. Unless otherwise indicated, install dowel rods on 18-inch centers around the full perimeter of concrete base.
 - 3. For supported equipment, install epoxy-coated anchor bolts that extend through concrete base and anchor into structural concrete floor.
 - 4. Place and secure anchorage devices. Use setting drawings, templates, diagrams, instructions, and directions furnished with items to be embedded.
 - 5. Install anchor bolts to elevations required for proper attachment to supported equipment.
- B. Maintain manufacturer's recommended clearances for service and maintenance.
- C. Charge water chiller with refrigerant if not factory charged and fill with oil if not factory installed.
- D. Comply with requirements for vibration isolation and seismic-control devices specified in Division 23.
- E. Install separate devices furnished by manufacturer and not factory installed.

3.3 WATER TREATMENT REQUIREMENTS

- A. Cycles of concentration shall be controlled such that recirculated water quality for modular Dedicated Heat Recovery Chillers using 316 stainless steel brazed plate heat exchangers and carbon steel headers is maintained within the following parameters:
 - 1. pH
 - 2. Total Dissolved Solids (TDS)
 - 3. Hardness as CaCO₃
 - 4. Alkalinity as Ca CO₃
 - 5. Chlorides
 - 6. Sulfates

Greater than 7 and less than 9 Less than 1000 ppm 30 to 500 ppm 30 to 500 ppm Less than 200 ppm Less than 200 ppm

3.4 CONNECTIONS

A. Comply with requirements in Division 23 Section "Hydronic Piping" Drawings indicate

general arrangement of piping, fittings, and specialties.

- B. Comply with requirements in Division 23 Section "Refrigerant Piping." Drawings indicate general arrangement of piping, fittings, and specialties.
- C. Install piping adjacent to chiller to allow service and maintenance.
- D. Evaporator Fluid Connections: Refer to detail on drawings.
- E. Condenser Fluid Connections Refer to detail on drawings.
- F. Refrigerant Pressure Relief Valve Connections: For water chillers installed indoors, extend vent piping to the outside without valves or restrictions. Comply with ASHRAE 15.
- G. Connect each drain connection with a union and drain pipe and extend pipe, full size of connection, to floor drain. Provide a shutoff valve at each connection if required.

3.5 STARTUP SERVICE

- A. Engage a factory-authorized service representative to perform startup service.
- B. Inspect field-assembled components, equipment installation, and piping and electrical connections for proper assemblies, installations, and connections.
- C. Complete installation and startup checks according to manufacturer's written instructions and perform the following:
 - 1. Verify that refrigerant charge is sufficient and water chiller has been leak tested.
 - 2. Verify that pumps are installed and functional.
 - 3. Verify that thermometers and gages are installed.
 - 4. Operate water chiller for run-in period.
 - 5. Check bearing lubrication and oil levels.
 - 6. Verify that refrigerant pressure relief device for chillers installed indoors is vented outside.
 - 7. Verify proper motor rotation.
 - 8. Verify static deflection of vibration isolators, including deflection during water chiller startup and shutdown.
 - 9. Verify and record performance of chilled-and condenser-water flow and low-temperature interlocks.
 - 10. Verify and record performance of water chiller protection devices.
 - 11. Test and adjust controls and safeties. Replace damaged or malfunctioning controls and equipment.
- D. Prepare a written startup report that records results of tests and inspections.

3.6 DEMONSTRATION

A. Engage a factory-authorized service representative to train Owner's maintenance personnel to

adjust, operate, and maintain water chillers. Video record the training sessions and provide electronic copy to Owner. Provide not less than eight hours of training.

END OF SECTION 23 64 23

SECTION 23 72 23

AIR-TO-AIR ENERGY RECOVERY EQUIPMENT

PART 1 - GENERAL

1.1 SUMMARY

- A. Section Includes:
 - 1. Packaged energy recovery units.

1.2 PERFORMANCE REQUIREMENTS

- **A.** Delegated Design: Design vibration isolation and seismic-restraint details, including comprehensive engineering analysis by a qualified professional engineer, using performance requirements and design criteria indicated.
- B. Seismic Performance: Air-to-air energy recovery equipment shall withstand the effects of earthquake motions determined according to ASCE/SEI 7.
 - 1. The term "withstand" means "the unit will remain in place without separation of any parts from the device when subjected to the seismic forces specified."
 - 2. Component Importance Factor: [1.0].

1.3 SUBMITTALS

- A. Action Submittals:
 - 1. Product Data: For each type of product indicated. Include rated capacities, operating characteristics, furnished specialties, and accessories.
 - 2. Shop Drawings: For air-to-air energy recovery equipment. Include plans, elevations, sections, details, and attachments to other work.
 - a. Detail equipment assemblies and indicate dimensions, weights, loads, required clearances, method of field assembly, components, and location and size of each field connection.
 - b. Wiring Diagrams: For power, signal, and control wiring.
 - 3. Delegated-Design Submittal: For air-to-air energy recovery equipment indicated to comply with performance requirements and design criteria, including analysis data signed and sealed by the qualified professional engineer responsible for their preparation.
 - a. Detail fabrication and assembly of air-to-air energy recovery equipment.

- b. Vibration Isolation Base Details: Detail fabrication including anchorages and attachments to structure and to supported equipment. Include adjustable motor bases, rails, and frames for equipment mounting.
- c. Design Calculations: Calculate requirements for selecting vibration isolators and seismic restraints and for designing vibration isolation bases.
- B. Informational Submittals:
 - 1. Seismic Qualification Data: Certificates, for air-to-air energy recovery equipment, accessories, and components, from manufacturer.
 - a. Basis for Certification: Indicate whether withstand certification is based on actual test of assembled components or on calculation.
 - b. Dimensioned Outline Drawings of Equipment Unit: Identify center of gravity and locate and describe mounting and anchorage provisions.
 - c. Detailed description of equipment anchorage devices on which the certification is based and their installation requirements.
 - 2. Field quality-control reports.
- C. Closeout Submittals:
 - 1. Operation and Maintenance Data: For air-to-air energy recovery equipment to include in maintenance manuals.
- D. Maintenance Material Submittals:
 - 1. Furnish extra materials that match products installed and that are packaged with protective covering for storage and identified with labels describing contents.
 - a. Filters: One set of each type of filter specified.
 - b. Fan Belts: One set of belts for each belt-driven fan in energy recovery units.
 - c. Wheel Belts: One set of belts for each heat wheel.

1.4 PERFORMANCE REQUIREMENTS

- A. AHRI Compliance: Comply with applicable sections of the following:
 - 1. AHRI 1060, "Performance Rating of Air-to-Air Heat Exchangers for Energy Recovery Ventilation Equipment."
 - 2. AHRI 410, "Forced-Circulation Air- Cooling and Air-Heating Coils."
- B. ASHRAE Compliance: Comply with applicable sections of the following:
 - 1. ASHRAE 52.1.
 - 2. ASHRAE 62.1.
 - 3. ASHRAE 84, "Method of Testing Air-to-Air Heat Exchangers."
 - 4. ASHRAE 90.1.
- C. NFPA Compliance: Comply with applicable section of the following:

- 1. NFPA 70, "National Electric Code."
- 2. NFPA 90A, "Standard for the Installation of Air-Conditioning and Ventilating Systems."
- D. UL Compliance: Comply with applicable sections of the following:
 - 1. UL 1812, "Ducted Heat Recovery Ventilators."
 - 2. UL 1815, "Nonducted Heat Recovery Ventilators."
 - 3. UL 1995, "Heating and Cooling Equipment."

1. The term "withstand" means "the unit will remain in place without separation of any parts from the device when subjected to the seismic forces specified."

1 1 1

2. Component Importance Factor: [1.0].

1.5 WARRANTY

A. Special Warranty: Manufacturer's standard form in which manufacturer agrees to repair or replace components of air-to-air energy recovery equipment that fail in materials or workmanship within specified warranty period.

Δ.

- 1. Warranty Period for Packaged Energy Recovery Units: Two years.
- 2. Warranty Period for Fixed-Plate Total Heat Exchangers: 10 years.

PART 2 - PRODUCTS

2.1 PACKAGED ENERGY RECOVERY UNITS

- A. Manufacturers: Subject to compliance with requirements, provide products by one of the following:
 - 1. Engineered Air.
 - 2. Greenheck Fan Corporation.
 - 3. Loren Cook Company.
 - 4. Multistack.
 - 5. RenewAire LLC.
 - 6. Trane.
- B. Surfaces in contact with the airstream shall comply with requirements in ASHRAE 62.1.
- C. Housing: Manufacturer's standard construction with corrosion-protection coating and exterior finish, hinged access doors with neoprene gaskets for inspection and access to internal parts, minimum 1-inch thick thermal insulation, knockouts for electrical and piping connections, exterior drain connection, and lifting lugs.

- 3 -

- 1. Inlet: Weatherproof hood, with damper for exhaust and supply.
 - a. Exhaust: Gravity backdraft damper.

E. Seismic Performance: Air-handling units shall withstand the effects of earthquake motions determined according to ASCE/SEI 7.

- b. Supply: Gravity backdraft damper.
- 2. Roof Curb: Refer to Division 7 for roof curbs and equipment supports.

D. ENTHALPIC CORE HEAT EXCHANGERS

- 1. Provide cross flow flat heat exchanger with performance as scheduled. Counter flow heat exchangers are not acceptable.
- 2. Plates: Heat Exchanger shall consist of solid enthalpic core material with no gaps.
 - a. Enthalpic core material shall be easily removed for cleaning or replacement.
 - b. Corners must be sealed both mechanically and with sealant to limit cross contamination.
 - c. Entire heat transfer surface shall be visible for inspection and cleaning without disassembling the heat exchanger.
 - d. Provide double sloped stainless steel drain pans under entire heat exchanger.
 - e. A (10) year non-prorated parts warranty shall be provided for all flat plate air to air heat exchangers. The warranty shall begin at start up, or six months after shipment, whichever comes first.
- E. Supply and Exhaust Fans: Direct Drive EC Motor, Backward Inclined Plenum Fans fan with spring isolators and flexible duct connections.
 - 1. Comply with NEMA designation, temperature rating, service factor, enclosure type, and efficiency requirements for motors specified in other Division 23 sections.
 - 2. Motor Sizes: Minimum size as indicated. If not indicated, large enough so driven load will not require motor to operate in service factor range above 1.0.
 - 3. Spring isolators on each fan having minimum 1-inch static deflection.
- F. Extended-Surface, Disposable Panel Filters:
 - 1. Comply with NFPA 90A.
 - 2. Filter Holding Frames: Arranged for flat or angular orientation, with access doors on both sides of unit. Filters shall be removable from one side or lift out from access plenum.
 - 3. Factory-fabricated, dry, extended-surface type.
 - 4. Thickness: 2 inches.
 - 5. MERV: 8, according to ASHRAE 52.2.
 - 6. Refer to other Division 23 sections for additional filter requirements.
- G. Piping and Wiring: Fabricate units with space within housing for piping and electrical conduits. Wire motors and controls so only external connections are required during installation.
 - 1. Indoor Enclosure: NEMA 250, Type 12 enclosure contains relays, starters, and terminal strip.
 - 2. Outdoor Enclosure: NEMA 250, Type 3R enclosure contains relays, starters, and terminal strip.
 - 3. Include nonfused disconnect switches.
- H. Accessories:
 - 1. Roof Curb: Galvanized steel with gasketing, and factory-installed wood nailer; complying with NRCA standards; minimum height of [14 inches].

- 2. Intake weather hood with birdscreen and 2-inch-thick filters.
- 3. Louvered intake weather hood with birdscreen and 2-inch-thick filters in V-bank configuration.
- 4. Exhaust weather hood with birdscreen.
- 5. Low-Leakage, Isolation Dampers: Double-skin, airfoil-blade, extruded-aluminum dampers with compressible jamb seals and extruded-vinyl blade edge seals, in opposed-blade arrangement with cadmium-plated steel operating rods rotating in stainless-steel sleeve, sintered bronze or nylon bearings mounted in a single extruded-aluminum frame, with operating rods connected with a common linkage, and electric damper operator factory wired. Leakage rate shall not exceed 5 cfm/sq. ft. at 1-inch wg and 9 cfm/sq. ft. at 4-inch wg.
- 6. Duct flanges.
- 7. Rubber-in-shear isolators for ceiling-mounted units.
- 8. Hinged access doors with quarter-turn latches.
- 9. Automatic, in-place, spray-wash system.
- 10. Weatherproofing for tilt-control system.

2.2 CONTROLS

- A. Control equipment and sequence of operation are specified in Division 23 and on Drawings.
- B. DDC Controller: Unitary DDC controller directing all RTU operations.
 - 1. Controller shall have volatile-memory backup.
 - 2. Safety Control Operation:
 - a. Smoke Detectors: Stop fan and close outdoor-air damper if smoke is detected. Provide additional contacts for alarm interface to fire-alarm control panel.
 - b. Firestats: Stop fan and close outdoor-air damper if air greater than 130 deg F enters unit. Provide additional contacts for alarm interface to fire-alarm control panel.
 - c. Fire-Alarm Control Panel Interface: Provide control interface to coordinate with operating sequence described in Division 28.
- C. Interface Requirements for HVAC Instrumentation and Control System:
 - 1. Interface relay for scheduled operation.
 - 2. Interface relay to provide indication of fault at the central workstation and diagnostic code storage.
 - 3. Provide BACnet-compatible interface for central HVAC control workstation for the following:
 - a. Adjusting set points.
 - b. Monitoring supply fan start, stop, and operation.
 - c. Inquiring data to include outdoor-air damper position, supply- and room-air temperature and humidity.
 - d. Monitoring occupied and unoccupied operations.
 - e. Monitoring constant and variable motor loads.
 - f. Monitoring variable-frequency drive operation.
 - g. Monitoring cooling load.
 - h. Monitoring heating load.

- i. Monitoring economizer cycles.
- j. Monitoring air-distribution static pressure and ventilation air volume.

PART 3 - EXECUTION

3.1 EXAMINATION

- A. Examine areas and conditions, with Installer present, for compliance with requirements for installation tolerances and other conditions affecting performance of the Work.
- B. Examine casing insulation materials and filter media before air-to-air energy recovery equipment installation. Reject insulation materials and filter media that are wet, moisture damaged, or mold damaged.
- C. Examine roughing-in for electrical services to verify actual locations of connections before installation.
- D. Proceed with installation only after unsatisfactory conditions have been corrected.

3.2 INSTALLATION

- A. Install fixed-plate heat exchangers so supply and exhaust airstreams flow in opposite directions.
 - 1. Install duct access doors in both supply and exhaust ducts, both upstream and downstream, for access to heat exchanger. Access doors and panels are specified in other Division 23 sections.
- B. Roof Curb: Install on roof structure or concrete base, level and secure, according to The NRCA "Roofing and Waterproofing Manual Volume 4: Construction Details Low-Slope Roofing," Illustration "Raised Curb Detail for Rooftop Air Handling Units and Ducts," ARI Guideline B. Install air-to-air energy recovery equipment on curbs and coordinate roof penetrations and flashing with roof construction specified in Division 7. Secure air-to-air energy recovery equipment to upper curb rail, and secure curb base to roof framing or concrete base with anchor bolts.
- C. Install wind and seismic restraints according to manufacturers' written instructions. Wind and seismically restrained vibration isolation roof-curb rails are specified in other Division 23 sections.
- D. Install units with clearances for service and maintenance.
- E. Install new filters at completion of equipment installation and before testing, adjusting, and balancing.
- F. Pipe drains from drain pans to nearest floor drain; use ASTM B 88, Type M, drawn-temper copper water tubing with soldered joints, same size as condensate drain connection.

3.3 PIPING AND DUCTWORK CONNECTIONS

- A. Piping and ductwork installation requirements are specified in other Sections. Drawings indicate general arrangement of piping, fittings, and specialties.
- B. Where installing piping or ductwork adjacent to air-handling unit, allow for service and maintenance.
- C. Connect piping and ductwork to air-handling units mounted on vibration isolators with flexible connectors.
- D. Connect condensate drain pans using ASTM B 88, Type M copper tubing. Extend to nearest equipment or floor drain. Construct deep trap at connection to drain pan and install cleanouts at changes in direction.

3.4 ELECTRICAL CONNECTIONS

- A. Connect wiring according to Division 26.
- B. Ground equipment according to Division 26.
- C. Install electrical devices furnished by manufacturer, but not factory mounted, according to NFPA 70 and NECA 1.
- D. Install nameplate for each electrical connection, indicating electrical equipment designation and circuit number feeding connection. Nameplates shall be laminated acrylic or melamine plastic signs with a black background and engraved white letters at least 1/2 inch high.

3.5 CONTROL CONNECTIONS

- A. Install control and electrical power wiring to field-mounted control devices.
- B. Connect control wiring according to Division 26.

3.6 FIELD QUALITY CONTROL

- A. Manufacturer's Field Service: Engage a factory-authorized service representative to inspect, test, and adjust components, assemblies, and equipment installations, including connections.
- B. Tests and Inspections:
 - 1. Operational Test: After electrical circuitry has been energized, start units to confirm proper motor rotation and unit operation.
 - 2. Adjust seals and purge.
 - 3. Test and adjust controls and safeties. Replace damaged and malfunctioning controls and equipment.
 - 4. Set initial temperature and humidity set points.
 - 5. Set field-adjustable switches and circuit-breaker trip ranges as indicated.

- C. Air-to-air energy recovery equipment will be considered defective if it does not pass tests and inspections.
- D. Prepare test and inspection reports.

3.7 DEMONSTRATION

A. Engage a factory-authorized service representative to train Owner's maintenance personnel to adjust, operate, and maintain air-to-air energy recovery units.

END OF SECTION 23 72 23

SECTION 23 73 13.13

BASIC AIR-HANDLING UNITS

PART 1 - GENERAL

1.1 SUMMARY

A. Section Includes: Factory-assembled, outdoor air-handling units with limited features.

1.2 SUBMITTALS

- A. Action Submittals:
 - 1. Product Data: For each air-handling unit.
 - a. Unit dimensions and weight. Include shipping splits and weight by segment. Include shipping and installed weights.
 - b. Cabinet material, metal thickness, finishes, insulation thickness and density, and accessories.
 - c. Fans:
 - 1) Certified fan-performance curves with system operating conditions indicated. Include flow, pressure drop, speed, brake HP, drive losses, and fan efficiency.
 - 2) Certified fan-sound power ratings.
 - 3) Fan construction and accessories (including belt guards, plenum fan cages, and piezometer rings).
 - 4) Motor ratings, electrical characteristics, and motor accessories. Include efficiencies and statement of VFD compatibility.
 - 5) Vibration isolation and restraint, including thrust restraints.
 - d. Certified coil-performance ratings with system operating conditions indicated, tube thickness, fin thickness, and materials.
 - e. Dampers, including housings, linkages, operators, and linkage ratings.
 - f. Filters with performance characteristics including initial and final pressure drops at rated airflow. Include information on differential pressure gages and filter clips.
 - g. Sound ratings for overall unit performance: Radiated sound, discharge air sound and entering air sound.
 - h. Pressure drop across each segment of the air handling unit.
 - i. Wiring diagrams: Power, signal and control wiring. Differentiate between factoryinstalled components and wiring and field-installed components and wiring.
 - j. Electrical component information, including lights, receptacle, conduit and junction boxes.
 - k. Access door construction, including door thickness, door operator type and material, handle locations and hinge information, thermal pane window information and test port locations.

- 1. Drain pan construction with invert of drain pan dimensioned from the bottom of unit. Identify drain piping with trap heights detailed.
- m. Airflow measuring probe calibration data.
- n. Test reports on leakage and vibration.
- o. All furnished specialties and accessories.
- p. Installation and startup instructions include fan bearing lubrication schedule and requirements.
- 2. Seismic Qualification Data: Certificates for indoor, basic air-handling units, accessories, and components, from manufacturer.
 - a. Basis for Certification: Indicate whether withstand certification is based on actual test of assembled components or on calculation.
 - b. Dimensioned Outline Drawings of Equipment Unit: Identify center of gravity and locate and describe mounting and anchorage provisions.
 - c. Detailed description of equipment anchorage devices on which the certification is based and their installation requirements.
- B. Informational Submittals:
 - 1. Source quality-control reports:
 - 2. Field quality-control reports.
- C. Closeout Submittals:
 - 1. Operation and Maintenance Data: For air-handling units to include in emergency, operation, and maintenance manuals.

1.3 MAINTENANCE MATERIALS

- A. Furnish additional materials that match products installed and that are packaged with protective covering for storage and identified with labels describing contents.
 - 1. Filters: One set for each unit.
 - 2. Gaskets: One set for each access door.
 - 3. Final Fan Belts and Fan Sheaves: One set for each air-handling unit belt-driven fan sized by the test and balance contractor as required to deliver the necessary airflow through the system accounting for all system losses.
 - 4. Paint: One quart-size can of touch-up paint for the exterior finish of each air handling unit provided.

1.4 COORDINATION

- A. Coordinate sizes and locations of concrete bases with actual equipment provided.
- B. Coordinate sizes and locations of structural-steel support members, if any, with actual equipment provided.

1.5 QUALITY ASSURANCE AND PERFORMANCE REQUIREMENTS

- A. Electrical Components, Devices, and Accessories: Listed and labeled as defined in NFPA 70, by a qualified testing agency, and marked for intended location and application.
- B. Comply with ARI 410 for components, construction and rating. Certify coils to ARI 410.
- C. NFPA Compliance: Comply with NFPA 90A for design, fabrication, and installation of airhandling units and components.
- D. ASHRAE Compliance: Comply with applicable sections of the following:
 - 1. ASHRAE 52.1.
 - 2. ASHRAE 62.1.
 - 3. ASHRAE 90.1.
- E. Structural Performance: Casing panels shall be self-supporting and capable of withstanding positive/negative 6-inch wg of internal static pressure, without exceeding a midpoint deflection of 0.005 inches/inch of panel span.

F. Seismic Performance: Air-handling units shall withstand the effects of earthquake motions determined according to ASCE/SEI 7.
1. The term "withstand" means "the unit will remain in place without separation of any parts from the device when subjected to the seismic forces specified."
2. Component Importance Factor: [1.0].

1.6 DELIVERY, STORAGE AND HANDLING

- A. Protect, pack, and secure loose-shipped items within the air-handling units. Include detailed packing list of loose-shipped items, including illustrations and instructions.
- B. Protect, pack and secure control devices, motor control devices, and other electronic equipment. Do not store electronic equipment in wet or damp areas even when they are sealed and secured.
- C. Enclose and protect control panels, electronic devices, and variable frequency drives. Do not store equipment in wet or damp areas even when they are sealed and secured.
- D. Seal openings to protect against damage during shipping, handling, and storage.
- E. Wrap indoor units with a tight sealing membrane. Wrapping membrane shall cover entire AHU during shipping and storage. Cover equipment, regardless of size or shape. Alternatively, AHU must be tarped for shipment and storage.
- F. Wrap equipment, including electrical components, for protection against rain, snow, wind, dirt, sun fading, road salt/chemicals, rust, and corrosion. Keep equipment clean and dry.
- G. Tarp outdoor units to protect against rain and road debris during shipping.
- H. Clearly mark AHU sections with unit tag number, segment sequence number, and direction of airflow. Securely affix safety-warning labels.

1.7 WARRANTY

- A. Special Warranty: Manufacturer agrees to replace components of units that fail in materials or workmanship within specified warranty period.
 - 1. Warranty Period: Five years from date of Substantial Completion.

PART 2 - PRODUCTS

2.1 OUTDOOR, BASIC AIR-HANDLING UNIT MANUFACTURERS

- A. Manufacturer: Subject to compliance with requirements, provide products by one of the following. Where a specific manufacturer is listed in the Drawings, this shall be considered the Basis-of-Design.
 - 1. AAON.
 - 2. Carrier Corporation; a unit of United Technologies Corp.
 - 3. Daikin Applied.
 - 4. Pace.
 - 5. Trane.
 - 6. York; a Johnson Controls company.

2.2 UNIT CASINGS

- A. General Fabrication Requirements for Casings;
 - A. Forming: Form walls, roofs, and floors with at least two breaks at each joint.
 - B. Joints: Sheet metal screws or pop rivets.
 - C. Sealing: Seal all joints with water-resistant sealant. Hermetically seal at each corner and around entire perimeter.
- B. Base Rail:
 - A. Material: Galvanized- or stainless-steel.
 - B. Height: 6 inches.
- C. Roof: Standing seam or membrane; sloped to drain water.
- D. Double Wall:
 - A. Outside Casing Wall: Galvanized- or stainless-steel, minimum 18-gauge thickness, with manufacturer's standard finish.
 - B. Inside Casing Wall: Galvanized- or stainless-steel sheet, minimum 18-gauge thickness. Solid **or** perforated with mylar lining between perforated sheet and insulation.
 - C. Option: 22-gauge external/internal casing thickness will be acceptable in lieu of the above requirements if applied as part of an engineered panel construction using closed-cell insulation, and if the assembly meets pressure and rigidity requirements specified elsewhere in this section.

- E. Floor Plate: Aluminum treadplate, minimum 0.1875" thick.
- F. Casing Insulation and Adhesive:
 - A. Materials:
 - 1. ASTM C 1071, fiberglass with coated surface exposed to the airstream to prevent erosion of glass fibers.
 - 2. Plastic insulation foamed-in-place between walls, urethane or polyisocyanurate.
 - B. Location and Application: Factory-applied insulation in all casing panels.
 - 1. Adhesive (For Fiberglass): Comply with ASTM C 916, Type I complying with NFPA 90A.
 - C. Thickness: 2" minimum.
 - D. Thermal Resistance (R-Value): 12 hr-ft²-°F/BTU minimum.
 - 1. Thermal Break: Provide continuity of insulation with no through-casing metal in casing walls, floors, or roofs of air-handling unit.
 - 2. Fire-Hazard Classification: Maximum flame-spread index of 25 and smoke developed index of 50 when tested according to ASTM 411.
- G. Static-Pressure Classifications:
 - A. For Unit Sections Upstream of Fans: Negative 4-inch wg.
 - B. For Unit Sections Downstream and Including Fans: Positive 6-inch wg.
- H. Panels and Doors:
 - A. Panels:
 - 1. Fabrication: Formed and reinforced with same materials and insulation thickness as casing.
 - 2. Fasteners: Two or more camlock type for panel lift-out operation. Arrangement shall allow panels to be opened against airflow.
 - 3. Gasket: Neoprene, applied around entire perimeters of panel frames.
 - 4. Size: Large enough to allow unobstructed access for inspection and maintenance of air-handling unit's internal components. At least 18 inches wide by full height of unit casing up to a maximum height of 72 inches.
 - B. Doors:
 - 1. Fabrication: Formed and reinforced with same materials and insulation thickness as casing.
 - 2. Hinges: A minimum of two ball-bearing hinges or stainless-steel piano hinge and two wedge-lever-type latches, operable from inside and outside. Arrange doors to be opened against airflow. Provide safety latch retainers on doors so that doors do not open uncontrollably.
 - 3. Gasket: Neoprene, applied around entire perimeters of frame.
 - 4. Size: Large enough to allow for unobstructed access for inspection and maintenance of air-handling unit's internal components. At least 24 inches

wide by full height of unit casing up to a maximum height of 72 inches.

- 5. Provide temperature and pressure test ports in access doors between coils.
- C. Locations and Applications:
 - 1. Fan Section: Doors.
 - 2. Coil Section: Panels.
 - 3. Access Section: Doors.
 - 4. Access Sections Immediately Upstream and Downstream of Coil Sections: Doors.
 - 5. Damper Section: Doors.
 - 6. Filter Section: Doors large enough to allow periodic removal and installation of filters.
 - 7. Mixing Section: Doors.
- I. Condensate Drain Pans:
 - A. Construction: Double walls of minimum 18-gauge stainless steel. Insulation between walls.
 - B. Drain Connection: Stainless steel drain connection located at lowest point of pan and sized to prevent overflow. Terminate with threaded nipple welded on one end of pan.
 - C. Slope: Minimum 0.125 in./ft. slope, to comply with ASHRAE 62.1, in at least two planes to collect condensate from cooling coils (including coil piping connections, coil headers, and return bends) and from humidifiers, and to direct water toward drain connection.
 - D. Length: Extend drain pan 18" downstream from leaving face of coil or to comply with ASHRAE 62.1.
 - E. Width: Entire width of water producing device.
 - F. Depth: 2 inches minimum.

2.3 FAN, DRIVE, AND MOTOR SECTION

- A. Fan and Drive Assemblies: Statically and dynamically balanced and designed for continuous operation at maximum-rated fan speed and motor horsepower.
 - A. Shafts: With field-adjustable alignment.
 - 1. Turned, ground, and polished hot-rolled steel with keyway. Ship with a protective coating of lubricating oil.
 - 2. Designed to operate at no more than 70 percent of first critical speed at fan's maximum speed.
- B. Centrifugal Fan Housings: Formed- and reinforced-steel panels to form curved scroll housings with shaped cutoff and spun-metal inlet bell.
 - A. Bracing: Steel angle or channel supports for mounting and supporting fan scroll, wheel, motor, and accessories.
 - B. Horizontal-Flanged, Split Housing: Bolted construction.
 - C. Housing for Supply Fan: Attach housing to fan-section casing with metal-edged

flexible duct connector.

- D. Flexible Connector: Factory fabricated with a fabric strip minimum 3-1/2 inches wide, attached to two strips of minimum 2-3/4-inch wide by 0.028-inch-thick, galvanized-steel or stainless-steel sheet.
 - 1. Flexible Connector Fabric: Glass fabric, double coated with neoprene. Fabrics, coatings, and adhesives shall comply with UL 181, Class 1.
 - 1) Fabric Minimum Weight: 26 oz./sq. yd.
 - 2) Fabric Minimum Tensile Strength: 480 lbf/inch in the warp and 360 lbf/inch in the filling.
 - 3) Fabric Minimum Service Temperature Range: Minus 40 to plus 200 deg F.
- C. Plenum Fan Housings: Steel frame and panel; fabricated without fan scroll and volute housing. Provide inlet screens for Type SWSI fans.
- D. Fan Shaft Bearings:
 - A. Self-aligning, pillow-block type with an L-50 rated life of minimum 200,000 hours according to ABMA 9.
- E. Discharge Dampers: Heavy-duty steel assembly with channel frame and sealed ball bearings, and opposed blades constructed of two plates formed around and welded to shaft, with blades linked out of airstream to single control lever.
- F. Internal Vibration Isolationand Seismic Control: Fans shall be factory mounted with manufacturer's standard restrained vibration isolation mounting devices having a minimum static deflection of 1 inch. Refer to other Division 23 sections for additional requirements. Internal Vibration Isolation: Fans shall be factory mounted with manufacturer's standard restrained vibration isolation mounting devices having a minimum static deflection of 1 inch. Refer to other Division 23 sections for additional requirements.
- G. Motor: Comply with NEMA designation, temperature rating, service factor, enclosure type, and efficiency requirements for motors specified in Division 23.
 - A. Enclosure Type: Totally enclosed, fan cooled.
 - B. NEMA Premium Efficient motors as defined in NEMA MG 1.
 - C. Motor Sizes: Minimum size as indicated. If not indicated, large enough so driven load will not require motor to operate in service factor range above 1.0.
 - D. Controllers, Electrical Devices, and Wiring: Comply with requirements for electrical devices and connections specified in electrical Sections.
 - E. Mount unit-mounted disconnect switches on exterior of unit.
- H. Variable-Frequency Motor Controller: Comply with Division 23.

2.4 COIL SECTION

- A. General Requirements for Coil Section:
 - A. Comply with AHRI 410.

- B. Fabricate coil section to allow removal and replacement of coil for maintenance and to allow in-place access for service and maintenance of coils.
- C. Coils shall not act as structural component of unit.
- B. Preheat/Reheat Coils:
 - A. Hot-Water Coils: Self-draining coil fabricated to ARI 410.
 - 1. Piping Connections: Non-ferrous, threaded, on same end of coil.
 - 2. Tube Material: Copper.
 - 3. Fin Type: Plate.
 - 4. Fin Material: Aluminum.
 - 5. Fin Thickness: 0.0075 inches.
 - 6. Fin and Tube Joint: Mechanical bond.
 - 7. Headers: Seamless copper tube with brazed joints, prime coated with cleaning plugs.
 - 8. Frames: Channel frame, minimum 0.052-inch-thick galvanized- or stainless-steel.
 - 9. Coil Working-Pressure Ratings: 200 psig, 325 deg F.
- C. Cooling Coils:
 - A. Chilled-Water Coil: Self-draining coil fabricated to ARI 410.
 - 1. Piping Connections: Non-ferrous, threaded, on same end and extended 4" through exterior of unit.
 - 2. Tube Material: Copper.
 - 3. Tube Thickness: 5/8-inch O.D. copper, minimum 0.025-inch wall thickness.
 - 4. Fin Type: Plate.
 - 5. Fin Material: Aluminum.
 - 6. Fin Thickness: 0.0075 inches.
 - 7. Fin and Tube Joint: Mechanical bond.
 - 8. Headers:
 - 1) Seamless copper tube with brazed joints, prime with cleaning plugs.
 - 2) Provide insulated cover to conceal exposed outside casings of headers.
 - 9. Frames: Channel frame, stainless steel.
 - 10. Working-Pressure Ratings: 200 psig, 325 deg F.

2.5 AIR FILTRATION SECTION

- A. Particulate air filtration is specified in other Division 23 sections.
- B. Panel Filters:
 - A. Description: Pleated factory-fabricated, self-supported disposable air filters with holding frames.
 - B. Filter Unit Class: UL 900.
 - C. Media: Interlaced glass, synthetic, or cotton fibers coated with nonflammable adhesive.
 - D. Filter-Media Frame: High wet-strength beverage board with perforated metal retainer, or metal grid, on outlet side.

- C. Side-Access Filter Mounting Frames:
 - A. Particulate Air Filter Frames: Match inner casing and outer casing material, and insulation thickness. Galvanized steel track. Side access doors.
 - 1. Sealing: Incorporate positive-sealing device to ensure seal between gasketed material on channels to seal top and bottom of filter cartridge frames to prevent bypass of unfiltered air.

2.6 DAMPERS

- General Requirements for Dampers: Leakage rate, according to AMCA 500, "Laboratory Methods for Testing Dampers for Rating," shall not exceed 4 cfm/sq. ft. at 1-inch wg and 8 cfm/sq. ft. at 4-inch wg.
- B. Damper Operators: Comply with requirements in other Division 23 sections.
- C. Outdoor-Air, Relief-Air, and Return-Air Dampers: Low-leakage, double-skin, airfoilblade, galvanized-steel dampers with compressible jamb seals and extruded-vinyl blade edge seals in opposed blade arrangement with zinc-plated steel operating rods rotating in nylon bearings mounted in a single galvanized-steel frame, and with operating rods connected with a common linkage. Leakage rate shall not exceed 4 cfm/sq. ft. at 1-inch wg and 8 cfm/sq. ft. at 4-inch wg.
- D. Blender Section: Multiple-blade, air-mixer assembly located immediately downstream of mixing section, designed to minimize temperature stratification.
- E. Combination Filter and Mixing Section:
 - A. Cabinet support members shall hold 2-inch- thick, pleated, flat throwaway filters.
 - B. Multiple-blade, air-mixer assembly shall mix air to prevent stratification, located immediately downstream of mixing box.

2.7 CONTROLS

A. Control equipment and sequence of operation are specified in Division 23.

2.8 MATERIALS

- A. Steel:
 - 1. ASTM A 36/A 36M for carbon structural steel.
 - 2. ASTM A 568/A 568M for steel sheet.
- B. Stainless Steel:
 - 1. Manufacturer's standard grade for casing.
 - 2. Manufacturer's standard type, ASTM A 240/A 240M for bare steel exposed to airstream or moisture.

- C. Galvanized Steel: ASTM A 653/A 653M.
- D. Aluminum: ASTM B 209.

2.9 ACCESSORIES

A. Service LED Lights and Switch: Factory installed in each accessible section with weatherproof cover.

2.10 SOURCE QUALITY CONTROL

- A. AHRI 430 Certification: Air-handling units and their components shall be factory tested according to AHRI 430 and shall be listed and labeled by AHRI.
 - 1. AMCA 210 Compliance: Fan performance according to AMCA 210.
- B. AMCA 300 and AMCA 301, or AHRI 260 Certification: Air-handling unit fan sound ratings shall comply with AMCA 300, "Methods for Calculating Fan Sound Ratings from Laboratory Test Data" and AMCA 301, "Methods for Calculating Fan Sound Ratings from Laboratory Test Data," or with AHRI 260, "Sound Rating of Ducted Air Moving and Conditioning Equipment."
- C. Water Coils: Factory tested to 300 psig according to AHRI 410 and ASHRAE 33.

PART 3 - EXECUTION

3.1 EXAMINATION

- A. Examine areas and conditions, with Installer present, for compliance with requirements for installation tolerances and other conditions affecting performance of the Work. Examine casing insulation materials and filter media before air-handling unit installation. Replace materials that are wet, moisture damaged, or mold damaged.
- B. Examine roughing-in for steam, hydronic, and condensate drainage piping systems and electrical services to verify actual locations of connections before installation.
- C. Proceed with installation only after unsatisfactory conditions have been corrected.

3.2 INSTALLATION

- A. Equipment Mounting:
 - 1. Install air-handling units on cast-in-place concrete equipment bases. Comply with requirements for equipment bases and foundations specified in Division 03.

- 2. Comply with requirements for vibration isolation and seismic-control devices specified in Division 23. Comply with requirements for vibration isolation control devices specified in Division 23.
- B. Arrange installation of units to provide access space around air-handling units for service and maintenance.
- C. Do not operate fan system until filters (temporary or permanent) are in place. Replace temporary filters used during construction and testing with new, clean filters.
- D. If air-handling unit fans are not internally vibration-isolated, connect ducts to air-handling units with flexible connections. Comply with requirements in Division 23.
- E. Connect duct to air-handling units with flexible connections unless fans are internally vibration- isolated. Comply with requirements in other Division 23 sections.

3.3 PIPING CONNECTIONS

- A. Piping installation requirements are specified in other Sections. Drawings indicate general arrangement of piping, fittings, and specialties.
- B. Where installing piping adjacent to air-handling unit, allow for service and maintenance.
- C. Connect piping to air-handling units mounted on vibration isolators with flexible connectors.
- D. Connect condensate drain pans using, ASTM B 88, Type M copper tubing. Extend to nearest equipment or floor drain. Construct deep trap at connection to drain pan and install cleanouts at changes in direction.

3.4 ELECTRICAL CONNECTIONS

- A. Connect wiring according to Division 26.
- B. Ground equipment according to Division 26.
- C. Install electrical devices furnished by manufacturer, but not factory mounted, according to NFPA 70 and NECA 1.
- D. Install nameplate for each electrical connection, indicating electrical equipment designation and circuit number feeding connection. Nameplates shall be laminated acrylic or melamine plastic signs with a black background and engraved white letters at least 1/2 inch high.

3.5 CONTROL CONNECTIONS

- A. Install control and electrical power wiring to field-mounted control devices.
- B. Connect control wiring according to Division 26.

3.6 FIELD QUALITY CONTROL

- A. Manufacturer's Field Service: Engage a factory-authorized service representative to test and inspect components, assemblies, and equipment installations, including connections.
- B. Perform the following tests and inspections with the assistance of a factory-authorized service representative:
 - 1. Leak Test: After installation, fill water and steam coils with water, and test coils and connections for leaks.
 - 2. Charge refrigerant coils with refrigerant and test for leaks.
 - 3. Fan Operational Test: After electrical circuitry has been energized, start units to confirm proper motor rotation and unit operation.
 - 4. Test and adjust controls and safeties. Replace damaged and malfunctioning controls and equipment.
- C. Air-handling unit or components will be considered defective if unit or components do not pass tests and inspections.
- D. Prepare test and inspection reports.

3.7 STARTUP SERVICE

- A. Engage a factory-authorized service representative to perform startup service.
 - 1. Complete installation and startup checks according to manufacturer's written instructions.
 - 2. Verify that shipping, blocking, and bracing are removed.
 - 3. Verify that unit is secure on mountings and supporting devices and that connections to piping, ducts, and electrical systems are complete.
 - 4. Verify that proper thermal-overload protection is installed in motors, controllers, and switches.
 - 5. Verify proper motor rotation direction, free fan wheel rotation, and smooth bearing operations. Reconnect fan drive system, align belts, and install belt guards.
 - 6. Verify that bearings, pulleys, belts, and other moving parts are lubricated with factory- recommended lubricants.
 - 7. Verify that dampers open and close, and maintain minimum outdoor-air setting.
 - 8. Comb coil fins for parallel orientation.
 - 9. Verify that proper thermal-overload protection is installed for electric coils.
 - 10. Install new, clean filters.
 - 11. Verify that manual and automatic volume control and fire and smoke dampers in connected duct systems are in fully open position.
- B. Starting procedures for air-handling units include the following:
 - 1. Energize motor; verify proper operation of motor, drive system, and fan wheel. Adjust fan to indicated rpm. Replace fan and motor pulleys as required to achieve design conditions.

- 2. Measure and record motor electrical values for voltage and amperage.
- 3. Manually operate dampers from fully closed to fully open position and record fan performance.

3.8 ADJUSTING

- A. Adjust damper linkages for proper damper operation.
- B. Comply with requirements in Division 23 for air-handling system testing, adjusting, and balancing.

3.9 CLEANING

A. After completing system installation and testing, adjusting, and balancing of air-handling unit and air-distribution systems, and after completing startup service, clean air-handling units internally to remove foreign material and construction dirt and dust. Clean fan wheels, cabinets, dampers, coils, and filter housings, and install new, clean filters.

3.10 DEMONSTRATION

A. Engage a factory-authorized service representative to train Owner's maintenance personnel to adjust, operate, and maintain air-handling units.

END OF SECTION 23 73 13.13

SECTION 23 74 33

CUSTOM DEDICATED OUTDOOR-AIR UNITS

PART 1 - GENERAL

1.1 SUMMARY

A. Section includes: Factory-assembled, indoor air-handling units with limited features.

1.2 SUBMITTALS

- A. Action Submittals:
 - 1. Product Data: For each type of product:
 - a. Unit dimensions and weight. Include shipping splits and weight by segment. Include shipping and installed weights.
 - b. Cabinet material, metal thickness, finishes, insulation, and accessories.
 - c. Fans:
 - 1) Certified fan-performance curves with system operating conditions indicated. Include flow, pressure drop, speed, brake HP, drive losses, and fan efficiency.
 - 2) Certified fan-sound power ratings.
 - 3) Fan construction and accessories (including belt guards, plenum fan cages, and piezometer rings).
 - 4) Motor ratings, electrical characteristics, and motor accessories. Include efficiencies and statement of VFD compatibility.
 - 5) Vibration isolation and restraint, including thrust restraints.
 - d. Certified coil-performance ratings with system operating conditions indicated, tube thickness, fin thickness, and materials.
 - e. Dampers, including housings, linkages, operators, and linkage ratings.
 - f. Filters with performance characteristics including initial and final pressure drops at rated airflow. Include information on differential pressure gages and filter clips.
 - g. Sound ratings for overall unit performance: Radiated sound, discharge air sound and entering air sound.
 - h. Pressure drop across each segment of the air handling unit.
 - i. Wiring diagrams: Power, signal and control wiring. Differentiate between factoryinstalled components and wiring and field-installed components and wiring.
 - j. Electrical component information, including lights, receptacle, conduit and junction boxes.
 - k. Access door construction, including door thickness, door operator type and material, handle locations and hinge information, thermal pane window information and test port locations.

- 1. Drain pan construction with invert of drain pan dimensioned from the bottom of unit. Identify drain piping with trap heights detailed.
- m. Airflow measuring probe calibration data.
- n. Test reports on leakage and vibration.
- o. All furnished specialties and accessories.
- p. Installation and startup instructions include fan bearing lubrication schedule and requirements.
- B. Informational Submittals:
 - 1. Seismic Qualification Certificates: For dedicated outdoor-air units, accessories, and components, from manufacturer.
 - a. Basis for Certification: Indicate whether withstand certification is based on actual test of assembled components or on calculation.
 - b. Dimensioned Outline Drawings of Equipment Unit: Identify center of gravity and locate and describe mounting and anchorage provisions.
 - c. Detailed description of equipment anchorage devices on which the certification is based and their installation requirements.
 - 2. Source quality-control reports.
 - 3. Field quality-control reports.
- C. Closeout Submittals:
 - 1. Operation and Maintenance Data: For units to include in emergency, operation, and maintenance manuals.
- D. Maintenance Material Submittals:
 - 1. Furnish additional materials that match products installed and that are packaged with protective covering for storage and identified with labels describing contents.
 - a. Filters: One set for each unit.
 - b. Gaskets: One set for each access door.
 - c. Final Fan Belts and Fan Sheaves: One set for each air-handling unit belt-driven fan sized by the test and balance contractor as required to deliver the necessary airflow through the system accounting for all system losses.
 - d. Paint: One quart-size can of touch-up paint for the exterior finish of each air handling unit provided.

1.3 COORDINATION

- A. Coordinate sizes and locations of concrete bases with actual equipment provided.
- B. Coordinate sizes and locations of structural-steel support members, if any, with actual equipment provided.

1.4 PERFORMANCE REQUIREMENTS

- A. Performance of individual DOAS components to be comparable to the performance characteristics defined on the drawing schedules.
- B. DOAS units to have similar size/shape as what is indicated on drawings to such an extent that the necessary clearances for service, walkway, and ductwork/piping routing are maintained.
- C. Electrical Components, Devices, and Accessories: Listed and labeled as defined in NFPA 70, by a qualified testing agency, and marked for intended location and application.
- D. Comply with AHRI 410 for components, construction and rating. Certify coils to AHRI 410.
- E. NFPA Compliance: Comply with NFPA 90A for design, fabrication, and installation of airhandling units and components.
- F. ASHRAE Compliance: Comply with applicable sections of the following:
 - 1. ASHRAE 52.1.
 - 2. ASHRAE 62.1.
 - 3. ASHRAE 90.1.
- G. Structural Performance: Casing panels shall be self-supporting and capable of withstanding positive/negative 6-inch wg of internal static pressure, without exceeding a midpoint deflection of 0.005 inches/inch of panel span.
- H. Seismic Performance: Air-handling units shall withstand the effects of earthquake motions determined according to ASCE/SEI 7.
 - 1. The term "withstand" means "the unit will remain in place without separation of any parts from the device when subjected to the seismic forces specified."


- 2. Component Importance Factor: [1.0].
- 1.5 SOURCE QUALITY CONTROL
 - A. AHRI 430 Certification: Air-handling units and their components shall be factory tested according to AHRI 430 and shall be listed and labeled by AHRI.
 - B. AHRI 1060 Certification: Air-handling units that include air-to-air energy recovery devices shall be factory tested according to AHRI 1060 and shall be listed and labeled by AHRI.
 - C. AMCA 301 or AHRI 260: Air-handling unit fan sound ratings shall comply with AMCA 301, "Methods for Calculating Fan Sound Ratings from Laboratory Test Data," or AHRI 260, "Sound Rating of Ducted Air Moving and Conditioning Equipment."
 - D. Fan Sound-Power Level Ratings: Comply with AMCA 301, "Methods for Calculating Fan Sound Ratings from Laboratory Test Data." Test fans according to AMCA 300, "Reverberant Room Method for Sound Testing of Fans." Fans shall bear AMCA-certified sound ratings seal.

- E. Fan Performance Rating: Factory test fan performance for airflow, pressure, power, air density, rotation speed, and efficiency. Rate performance according to AMCA 210, "Laboratory Methods of Testing Fans for Aerodynamic Performance Rating."
- F. Water Coils: Factory tested to 300 psig according to AHRI 410 and ASHRAE 33.
- G. Witnessed Casing Leakage Tests:
 - 1. Pay for all expenses, for one representative designated by Owner, to travel to the factory to witness cabinet air-leakage testing on the specific assembled unit(s) prior to release for delivery to Project site.
 - 2. If the unit(s) does not meet specified leakage requirements, perform factory modifications and retest. Do not release unit for shipment until tested leakage is measured to be within specified leakage and leakage testing report has been accepted by Owner's designated representative.

1.6 DELIVERY, STORAGE AND HANDLING

- A. Protect, pack, and secure loose-shipped items within the air-handling units. Include detailed packing list of loose-shipped items, including illustrations and instructions.
- B. Protect, pack and secure control devices, motor control devices, and other electronic equipment. Do not store electronic equipment in wet or damp areas even when they are sealed and secured.
- C. Enclose and protect control panels, electronic devices, and variable frequency drives. Do not store equipment in wet or damp areas even when they are sealed and secured.
- D. Seal openings to protect against damage during shipping, handling, and storage.
- E. Wrap indoor units with a tight sealing membrane. Wrapping membrane shall cover entire AHU during shipping and storage. Cover equipment, regardless of size or shape. Alternatively, AHU must be tarped for shipment and storage.
- F. Wrap equipment, including electrical components, for protection against rain, snow, wind, dirt, sun fading, road salt/chemicals, rust, and corrosion. Keep equipment clean and dry.
- G. Tarp outdoor units to protect against rain and road debris during shipping.
- H. Clearly mark AHU sections with unit tag number, segment sequence number, and direction of airflow. Securely affix safety-warning labels.

1.7 WARRANTY

- A. Special Warranty: Manufacturer agrees to replace components of units that fail in materials or workmanship within specified warranty period.
 - 1. Warranty Period: Five years from date of Substantial Completion.

PART 2 - PRODUCTS

2.1 MANUFACTURERS

- A. Manufacturers: Subject to compliance with requirements, provide products by one of the following. Where a specific manufacturer is listed in the Drawings, this shall be considered the Basis-of-Design.
 - 1. AAON.
 - 2. Annexair.
 - 3. Carrier Corporation; a unit of United Technologies Corp.
 - 4. Daikin Applied.
 - 5. Engineered Air.
 - 6. Innovent.
 - 7. Haakon.
 - 8. Trane.
 - 9. YORK; a Johnson Controls company.

2.2 UNIT CASING

- A. Cabinet Deflection Performance:
 - 1. Walls and roof deflection within 1/200 of the span at the design working pressure equal to the fan shut-off pressure. Deflection limits measured at any point on the surface.
 - 2. Floor deflections within 1/240 of the span considering the worst-case condition caused by the following:
 - a. Service personnel.
 - b. Internal components.
 - c. Design working pressure defined for the walls and roof.
- B. Construction: Double wall.
- C. Outside Casing Wall: Galvanized- or stainless-steel, minimum 18-gauge thickness, with manufacturer's standard finish.
- D. Inside Casing Wall: Galvanized- or stainless-steel sheet, minimum 18-gauge thickness. Solid or perforated with mylar lining between perforated sheet and insulation.
- E. Option: 22-gauge external/internal casing thickness will be acceptable in lieu of the above requirements if applied as part of an engineered panel construction using closed-cell insulation, and if the assembly meets pressure and rigidity requirements specified elsewhere in this section.
- F. Lifting and Handling Provisions: Factory-installed shipping skids and lifting lugs.
- G. Base Rails: Galvanized-steel rails for mounting on roof curb or pad as indicated.
- H. Access for Inspection, Cleaning, and Maintenance: Comply with requirements in ASHRAE 62.1.

- I. Service Doors: Hinged access doors with gaskets. Material and construction of doors shall match material and construction of cabinet in which doors are installed.
 - 1. Provide temperature and pressure test ports in access doors between coils.
- J. Roof: Standing seam or membrane; sloped to drain water.
- K. Floor: Reinforced, treadplate, minimum 0.1875" thick metal surface; reinforced to limit deflection when walked on by service personnel. Insulation below metal walking surface.
- L. Cabinet Insulation:
 - 1. Materials: ASTM C 1071, fiberglass with coated surface exposed to the airstream to prevent erosion of glass fibers.
 - 2. Casing Panel R-Value: Minimum R-12.
 - 3. Insulation Thickness: 2 inches.
 - 4. Thermal Break: Provide continuity of insulation with no through-casing metal in casing walls, floors, or roofs of air-handling unit.
- M. Condensate Drain Pans:
 - 1. Construction: Double walls of minimum 18-gauge stainless steel. Insulation between walls.
 - 2. Drain Connection: Stainless steel drain connection located at lowest point of pan and sized to prevent overflow. Terminate with threaded nipple welded on one end of pan.
 - 3. Slope: Minimum 0.125 in./ft. slope, to comply with ASHRAE 62.1, in at least two planes to collect condensate from cooling coils (including coil piping connections, coil headers, and return bends) and from humidifiers, and to direct water toward drain connection.
 - 4. Length: Extend drain pan 18" downstream from leaving face of coil or to comply with ASHRAE 62.1.
 - 5. Width: Entire width of water producing device.
 - 6. Depth: 2 inches minimum.
- N. Surfaces in Contact with Airstream: Comply with requirements in ASHRAE 62.1 for resistance to mold and erosion.

2.3 FAN, DRIVE, AND MOTOR SECTION

- A. Fan and Drive Assemblies: Statically and dynamically balanced and designed for continuous operation at maximum-rated fan speed and motor horsepower.
 - 1. Shafts: With field-adjustable alignment.
 - a. Turned, ground, and polished hot-rolled steel with keyway. Ship with a protective coating of lubricating oil.
 - b. Designed to operate at no more than 70 percent of first critical speed at fan's maximum speed.
- B. Centrifugal Fan Housings: Formed- and reinforced-steel panels to form curved scroll housings with shaped cutoff and spun-metal inlet bell.
 - 1. Bracing: Steel angle or channel supports for mounting and supporting fan scroll, wheel, motor, and accessories.

- 2. Horizontal-Flanged, Split Housing: Bolted construction.
- 3. Housing for Supply Fan: Attach housing to fan-section casing with metal-edged flexible duct connector.
- 4. Flexible Connector: Factory fabricated with a fabric strip minimum 3-1/2 inches wide, attached to two strips of minimum 2-3/4-inch wide by 0.028-inch-thick, galvanized-steel or stainless-steel sheet.
 - a. Flexible Connector Fabric: Glass fabric, double coated with neoprene. Fabrics, coatings, and adhesives shall comply with UL 181, Class 1.
 - 1) Fabric Minimum Weight: 26 oz./sq. yd.
 - 2) Fabric Minimum Tensile Strength: 480 lbf/inch in the warp and 360 lbf/inch in the filling.
 - 3) Fabric Minimum Service Temperature Range: Minus 40 to plus 200 deg F.
- C. Plenum Fan Housings: Steel frame and panel; fabricated without fan scroll and volute housing. Provide inlet screens for Type SWSI fans. Direct drive.
- D. Fan Shaft Bearings:
 - 1. Self-aligning, pillow-block type with an L-50 rated life of minimum 200,000 hours according to ABMA 9.
- E. Internal Vibration Isolation: Fans shall be factory mounted with manufacturer's standard restrained vibration isolation mounting devices having a minimum static deflection of 1 inch. Refer to other Division 23 sections for additional requirements.
- F. Motor: Comply with NEMA designation, temperature rating, service factor, enclosure type, and efficiency requirements for motors specified in Division 23.
 - 1. Enclosure Type: Totally enclosed, fan cooled.
 - 2. NEMA Premium Efficient motors as defined in NEMA MG 1.
 - 3. Motor Sizes: Minimum size as indicated. If not indicated, large enough so driven load will not require motor to operate in service factor range above 1.0.
 - 4. Controllers, Electrical Devices, and Wiring: Comply with requirements for electrical devices and connections specified in electrical Sections.
 - 5. Mount unit-mounted disconnect switches on exterior of unit.
 - 6. A Motor removal rail shall be factory provided and installed above the fan section.
- G. Variable-Frequency Drive (VFD): Shall be factory mounted and wired to direct drive plenum fans. Include shaft grounding ring.

2.4 COIL SECTION

- A. General Requirements for Coil Section:
 - 1. Comply with AHRI 410.
 - 2. Fabricate coil section to allow removal and replacement of coil for maintenance and to allow in-place access for service and maintenance of coils.
 - 3. Coils shall not act as structural component of unit.
- B. COOLING COILS
 - 1. Piping Connections: Non-ferrous, threaded, on same end and extended 4" through exterior of unit.
 - 2. Tube Material: Copper.

- 3. Tube Thickness: 5/8-inch O.D. copper, minimum 0.025-inch wall thickness.
- 4. Fin Type: Plate.
- 5. Fin Material: Aluminum.
- 6. Fin Thickness: 0.0075 inches.
- 7. Fin and Tube Joint: Mechanical bond.
- 8. Headers:
 - a. Seamless copper tube with brazed joints, prime with cleaning plugs.
 - b. Provide insulated cover to conceal exposed outside casings of headers.
- 9. Frames: Channel frame, stainless steel.
- 10. Working-Pressure Ratings: 200 psig, 325 deg F.
- C. HOT-WATER HEATING COIL
 - 1. Piping Connections: Non-ferrous, threaded, on same end of coil.
 - 2. Tube Material: Copper.
 - 3. Fin Type: Plate.
 - 4. Fin Material: Aluminum.
 - 5. Fin Thickness: 0.0075 inches.
 - 6. Fin and Tube Joint: Mechanical bond.
 - 7. Headers: Seamless copper tube with brazed joints, prime coated with cleaning plugs.
 - 8. Frames: Channel frame, minimum 0.052-inch-thick galvanized- or stainless-steel.
 - 9. Coil Working-Pressure Ratings: 200 psig, 325 deg F.

2.5 FIXED-PLATE TOTAL HEAT EXCHANGERS

- A. Provide cross flow flat plate heat exchanger with performance as scheduled. Counter flow heat exchangers are not acceptable.
- B. Plates: Heat Exchanger plates shall be completely smooth with no dimples or corrugations.
 - 1. Heat Exchanger shall have aluminum tube framing. Steel framing is not acceptable. Plate shall be aluminum.
 - 2. Plate corners must be sealed both mechanically and with sealant to limit cross contamination.
 - 3. Entire heat transfer surface shall be visible for inspection and cleaning without disassembling the heat exchanger.
 - 4. Provide double sloped stainless steel drain pans under entire heat exchanger.
 - 5. A (10) year non-prorated parts warranty shall be provided for all flat plate air to air heat exchangers. The warranty shall begin at start up, or six months after shipment, whichever comes first.

2.6 ENTHALPIC CORE HEAT EXCHANGERS

- A. Provide cross flow flat heat exchanger with performance as scheduled. Counter flow heat exchangers are not acceptable.
- B. Plates: Heat Exchanger shall consist of solid enthalpic core material with no gaps.
 - 1. Enthalpic core material shall be easily removed for cleaning or replacement.
 - 2. Corners must be sealed both mechanically and with sealant to limit cross contamination.
 - 3. Entire heat transfer surface shall be visible for inspection and cleaning without disassembling the heat exchanger.

- 4. Provide double sloped stainless steel drain pans under entire heat exchanger.
- 5. A (10) year non-prorated parts warranty shall be provided for all flat plate air to air heat exchangers. The warranty shall begin at start up, or six months after shipment, whichever comes first.

2.7 FILTERS

- A. Disposable Panel Filters:
 - 1. Comply with NFPA 90A.
 - 2. Located upstream of the fixed plate heat exchanger.
 - 3. Factory-fabricated, viscous-coated, flat-panel type.
 - 4. Thickness: 2 inches.
 - 5. Minimum MERV: 8, according to ASHRAE 52.2.
 - 6. Media: Interlaced glass fibers sprayed with nonflammable adhesive and antimicrobial agent.
- B. Mounting Frames:
 - 1. Panel filters arranged for flat or angular orientation, with access doors on both sides of unit. Filters shall be removable from one side or from access plenum.
 - 2. Extended surface filters arranged for flat orientation, removable from access plenum.
 - 3. Galvanized or stainless steel with gaskets and fasteners, suitable for bolting together into built-up filter banks.

2.8 DAMPERS

- A. General Requirements for Dampers: Leakage rate, according to AMCA 500, "Laboratory Methods for Testing Dampers for Rating," shall not exceed 4 cfm/sq. ft. at 1-inch wg and 8 cfm/sq. ft. at 4-inch wg.
- B. Damper Operators: Comply with requirements in other Division 23 sections.
- C. Outdoor-Air, Relief-Air, and Return-Air Dampers: Low-leakage, double-skin, airfoil-blade, galvanized-steel dampers with compressible jamb seals and extruded-vinyl blade edge seals in opposed blade arrangement with zinc-plated steel operating rods rotating in nylon bearings mounted in a single galvanized-steel frame, and with operating rods connected with a common linkage. Leakage rate shall not exceed 4 cfm/sq. ft. at 1-inch wg and 8 cfm/sq. ft. at 4-inch wg.
- D. Combination Filter and Mixing Section:
 - 1. Cabinet support members shall hold 2-inch- thick, pleated, flat throwaway filters.
 - 2. Multiple-blade, air-mixer assembly shall mix air to prevent stratification, located immediately downstream of mixing box.

2.9 ELECTRICAL POWER CONNECTIONS

- A. General Electrical Power Connection Requirements: Factory-installed and -wired switches, motor controllers, transformers, and other necessary electrical devices shall provide a single-point field power connection to unit.
- B. Wiring: Numbered and color-coded to match wiring diagram.
- C. Wiring Location: Install factory wiring outside an enclosure in a raceway.
- D. Factory Wiring: Branch power circuit to each motor and to controls with one of the following disconnecting means:
 - 1. NEMA KS 1, heavy-duty, fusible switch with rejection-type fuse clips rated for fuses. Select and size fuses to provide Type 2 protection according to IEC 60947-4-1.
 - 2. NEMA KS 1, heavy-duty, nonfusible switch.
 - 3. UL 489, motor-circuit protector (circuit breaker) with field-adjustable, short-circuit trip coordinated with motor locked-rotor amperes.
- E. Factory-Mounted, Overcurrent-Protection Service: For each motor.
- F. Transformer: Factory mounted with primary and secondary fuses and sized with enough capacity to operate electrical load plus spare capacity.
- G. Controls: Factory wire unit-mounted controls and control transformer.
- H. Lights: Factory wire unit-mounted LED lights.
- I. Receptacle: Factory wire unit-mounted, ground fault interrupt (GFI) duplex receptacle.
- J. Control Relays: Auxiliary and adjustable time-delay relays.

2.10 CONTROLS

A. DOAS unit controls to be provided by unit manufacturer with complete control system to include all devices, control panels, wiring, programming, and commissioning. DOAS Units are to operate standalone and must be capable of standalone operation in the event of a communication failure with the TCC. The controls provided by the DOAS unit manufacturer shall be responsible for enacting a sequence to provide frost control on the integral airside heat recovery heat exchanger. The DOAS unit provided controls shall be responsible for making available to the TCC via the BACnet connection any and all alarm points necessary to prevent a freeze up or failure of any kind in the DOAS unit. DOAS units are to have a BACnet connection at the control panel for setpoint adjustment by the TCC via a BACnet connection. The BACnet connection shall be as defined by the ASHRAE 135 standard. Control valves shall be provided by the DOAS manufacturer for field piping by the installing contractor. Any sensors, such as building pressurization sensors, that require remote mounting shall be installed and wired back to the DOAS unit mounted controller by the TCC, as specified by the DOAS manufacturer.

2.11 ACCESSORIES

- A. Service Lights and Switch: Factory installed in each accessible section with weatherproof cover. Factory wire lights to a single-point field connection.
- B. Duplex Receptacle: Factory mounted in unit supply-fan section and refrigeration section, with 20-amp 120 V GFI duplex receptacle and weatherproof cover factory wired for single point power connection to entire unit.

PART 3 - EXECUTION

3.1 EXAMINATION

- A. Examine areas and conditions, with Installer present, for compliance with requirements for installation tolerances and other conditions affecting performance of the Work.
- B. Examine casing insulation materials and filter media before air-handling unit installation. Replace materials that are wet, moisture damaged, or mold damaged.
- C. Examine roughing-in for steam, hydronic, and condensate drainage piping systems and electrical services to verify actual locations of connections before installation.
- D. Proceed with installation only after unsatisfactory conditions have been corrected.

3.2 INSTALLATION

- A. Equipment Mounting:
 - 1. Install air units on cast-in-place concrete equipment bases.
 - 2. Comply with requirements for vibration isolation and seismic control devices specified in Division 23.
- B. Arrange installation of units to provide access space around air-handling units for service and maintenance.
- C. Do not operate fan system until filters (temporary or permanent) are in place. Replace temporary filters used during construction and testing with new, clean filters.
- D. If air-handling unit fans are not internally vibration-isolated, connect ducts to air-handling units with flexible connections. Comply with requirements in Division 23.
- E. Connect duct to air-handling units with flexible connections unless fans are internally vibrationisolated. Comply with requirements in other Division 23 sections.

3.3 PIPING CONNECTIONS

A. Piping installation requirements are specified in other Sections. Drawings indicate general arrangement of piping, fittings, and specialties.

- B. Where installing piping adjacent to air-handling unit, allow for service and maintenance.
- C. Connect piping to air-handling units mounted on vibration isolators with flexible connectors.
- D. Connect condensate drain pans using, ASTM B 88, Type M copper tubing. Extend to nearest equipment or floor drain. Construct deep trap at connection to drain pan and install cleanouts at changes in direction.

3.4 ELECTRICAL CONNECTIONS

- A. Connect wiring according to Division 26.
- B. Ground equipment according to Division 26.
- C. Install electrical devices furnished by manufacturer, but not factory mounted, according to NFPA 70 and NECA 1.
- D. Install nameplate for each electrical connection, indicating electrical equipment designation and circuit number feeding connection. Nameplates shall be laminated acrylic or melamine plastic signs with a black background and engraved white letters at least 1/2 inch high.

3.5 CONTROL CONNECTIONS

- A. Install control and electrical power wiring to field-mounted control devices.
- B. Connect control wiring according to Division 26.

3.6 FIELD QUALITY CONTROL

- A. Manufacturer's Field Service: Engage a factory-authorized service representative to test and inspect components, assemblies, and equipment installations, including connections.
- B. Perform the following tests and inspections with the assistance of a factory-authorized service representative:
 - 1. Leak Test: After installation, fill water and steam coils with water, and test coils and connections for leaks.
 - 2. Charge refrigerant coils with refrigerant and test for leaks.
 - 3. Fan Operational Test: After electrical circuitry has been energized, start units to confirm proper motor rotation and unit operation.
 - 4. Test and adjust controls and safeties. Replace damaged and malfunctioning controls and equipment.
- C. Air-handling unit or components will be considered defective if unit or components do not pass tests and inspections.
- D. Prepare test and inspection reports.

3.7 STARTUP SERVICE

- A. Engage a factory-authorized service representative to perform startup service.
 - 1. Complete installation and startup checks according to manufacturer's written instructions.
 - 2. Verify that shipping, blocking, and bracing are removed.
 - 3. Verify that unit is secure on mountings and supporting devices and that connections to piping, ducts, and electrical systems are complete.
 - 4. Verify that proper thermal-overload protection is installed in motors, controllers, and switches.
 - 5. Verify proper motor rotation direction, free fan wheel rotation, and smooth bearing operations. Reconnect fan drive system, align belts, and install belt guards.
 - 6. Verify that bearings, pulleys, belts, and other moving parts are lubricated with factory-recommended lubricants.
 - 7. Verify that dampers open and close, and maintain minimum outdoor-air setting.
 - 8. Comb coil fins for parallel orientation.
 - 9. Verify that proper thermal-overload protection is installed for electric coils.
 - 10. Install new, clean filters.
 - 11. Verify that manual and automatic volume control and fire and smoke dampers in connected duct systems are in fully open position.
- B. Starting procedures for air-handling units include the following:
 - 1. Energize motor; verify proper operation of motor, drive system, and fan wheel. Adjust fan to indicated rpm. Replace fan and motor pulleys as required to achieve design conditions.
 - 2. Measure and record motor electrical values for voltage and amperage.
 - 3. Manually operate dampers from fully closed to fully open position and record fan performance.

3.8 ADJUSTING

- A. Adjust damper linkages for proper damper operation.
- B. Comply with requirements in Division 23 for air-handling system testing, adjusting, and balancing.

3.9 CLEANING

A. After completing system installation and testing, adjusting, and balancing of air-handling unit and air-distribution systems, and after completing startup service, clean air-handling units internally to remove foreign material and construction dirt and dust. Clean fan wheels, cabinets, dampers, coils, and filter housings, and install new, clean filters.

3.10 DEMONSTRATION

A. Engage a factory-authorized service representative to train Owner's maintenance personnel to adjust, operate, and maintain air-handling units.

END OF SECTION 23 74 33

SECTION 28 31 00

ADDRESSABLE FIRE-ALARM SYSTEM

PART 1 - GENERAL

1.1 RELATED DOCUMENTS

A. Drawings and general provisions of the Contract, including General and Supplementary Conditions and Division 01 Specification Sections, apply to this Section.

1.2 SUMMARY

A. This Section provides for a new, *horn type*, fire alarm system to be installed and fully functional in *this correction the Community Corrections* facility.

B. The existing Jail fire alarm system is SIMPLEX 4010 Series, Horn type system. This system shall be extended / modified as per drawings. New system areas, as indicated on drawings, shall be interconnected to existing system.

- C. Fire alarm devices installed within inmate accessible areas as identified in the architectural documents shall be suitable for Institutional Group I-3 occupancy.
- D. Section Includes:
 - 1. Fire-alarm control unit.
 - 2. Manual fire-alarm boxes.
 - 3. System smoke detectors.
 - 4. Air-sampling smoke detectors.
 - 5. Heat detectors.
 - 6. Notification appliances.
 - 7. Fire Alarm Device protective covers.
 - 8. Remote annunciator.
 - 9. Addressable interface device.
 - 10. Digital alarm communicator transmitter.
 - 11. Network communications.
- E. This facility shall be divided up into individual notification and detection circuits as follows.
 - 1. POD Inmate area.
 - 2. POD Control tower.
 - 3. POD mechanical spaces.
 - 4. Connecting Corridor and mechanical spaces.
 - 5. Connecting Corridor intake and booking.
 - 6. Sheriff Administration
 - 7. Kitchen and Laundry

F. Related Requirements:

- 1. Section 087100 Door Hardware: Door closers, electric locks, electric releases.
- 2. Section 211200 Fire-Suppression Standpipes: Flow detection and alarm devices.
- 3. Section 212200 Clean Agent Extinguishing System
- 4. Section 211313 Wet-Pipe Sprinkler Systems: Flow detection and alarm devices.
- 5. Section 233300 Air Duct Accessories: Smoke dampers: HVAC duct dampers and instrumentation.
- 6. system to supervise fire and smoke alarms, as well as other building systems.
- 7. Section 260519 Low-Voltage Electrical Power Conductors and Cables: Building wire and cable.
- 8. Section 260526 Grounding and Bonding for Electrical Systems: Grounding and bonding of fire-alarm equipment and circuits.

1.3 DEFINITIONS

- A. EMT: Electrical Metallic Tubing.
- B. FACP: Fire Alarm Control Panel.
- C. LED: Light Emitting Diode
- D. NICET: National Institute for Certification in Engineering Technologies.
- E. NFPA 72 apply to fire alarm terms used in this Section.
- F. FANP: Fire Alarm Power Extender Panel.
- G. FAAP: Fire Alarm Annunciator (LCD).

1.4 ACTION SUBMITTALS

- A. Product Data: For each type of product, including furnished options and accessories.
 - 1. Include construction details, material descriptions, dimensions, profiles, and finishes.
 - 2. Include rated capacities, operating characteristics, and electrical characteristics.
- B. Shop Drawings: For fire-alarm system.
 - 1. System operation description: Detailed description for this Project, including method of operation and supervision of each type of circuit and sequence of operations for manually and automatically initiated system inputs and outputs. Manufacturer's standard descriptions for generic systems are not acceptable.
 - 2. System riser diagram with device addresses, conduit sizes, and cable and wire types and sizes.
 - 3. Wiring diagrams: Power, signal, and control wiring. Include diagrams for equipment and for system with all terminals and interconnections identified. Show wiring color code.

- 4. Comply with recommendations and requirements in the "Documentation" section of the "Fundamentals" chapter in NFPA 72.
- 5. Include plans, elevations, sections, details, and attachments to other work.
- 6. Include details of equipment assemblies. Indicate dimensions, weights, loads, required clearances, method of field assembly, components, and locations. Indicate conductor sizes, indicate termination locations and requirements, and distinguish between factory and field wiring.
- 7. Detail assembly and support requirements.
- 8. Include voltage drop calculations for notification-appliance circuits.
- 9. Include battery-size calculations.
- 10. Include input/output matrix.
- 11. Include statement from manufacturer that all equipment and components have been tested as a system and meet all requirements in this Specification and in NFPA 72.
- 12. Include performance parameters and installation details for each detector.
- 13. Verify that each duct detector is listed for complete range of air velocity, temperature, and humidity possible when air-handling system is operating.
- 14. Provide program report showing that air-sampling detector pipe layout balances pneumatically within the airflow range of the air-sampling detector.
- 15. Include plans, sections, and elevations of heating, ventilating, and air-conditioning ducts, drawn to scale; coordinate location of duct smoke detectors and access to them.
 - a. Show critical dimensions that relate to placement and support of sampling tubes, detector housing, and remote status and alarm indicators.
 - b. Show field wiring required for HVAC unit shutdown on alarm.
 - c. Show field wiring and equipment required for HVAC unit shutdown on alarm and override by firefighters' control system.
 - d. Show field wiring and equipment required for HVAC unit shutdown on alarm and override by firefighters' smoke-evacuation system.
 - e. Locate detectors according to manufacturer's written recommendations.
 - f. Show air-sampling detector pipe routing.
- 16. Include voice/alarm signaling-service equipment rack or console layout, grounding schematic, amplifier power calculation, and single-line connection diagram.
- 17. Include floor plans to indicate final outlet locations showing address of each addressable device. Show size and route of cable and conduits and point-to-point wiring diagrams.
- C. General Submittal Requirements:
 - 1. Submittals shall be approved by authorities having jurisdiction prior to submitting them to Architect.
 - 2. Shop Drawings shall be prepared by persons with the following qualifications:
 - a. Trained and certified by manufacturer in fire-alarm system design.
 - b. NICET-certified, fire-alarm technician; Level III minimum.
 - c. Licensed or certified by authorities having jurisdiction.

1.5 CLOSEOUT SUBMITTALS

- A. Operation and Maintenance Data: For fire-alarm systems and components to include in emergency, operation, and maintenance manuals.
 - 1. Include the following and deliver copies to authorities having jurisdiction:
 - a. Comply with the "Records" section of the "Inspection, Testing and Maintenance" chapter in NFPA 72.
 - b. Provide "Fire Alarm and Emergency Communications System Record of Completion Documents" according to the "Completion Documents" Article in the "Documentation" section of the "Fundamentals" chapter in NFPA 72.
 - c. Complete wiring diagrams showing connections between all devices and equipment. Each conductor shall be numbered at every junction point with indication of origination and termination points.
 - d. Riser diagram.
 - e. Device addresses.
 - *f. Air-sampling system sample port locations and modeling program report showing layout meets performance criteria.*
 - g. Record copy of site-specific software.
 - h. Provide "Inspection and Testing Form" according to the "Inspection, Testing and Maintenance" chapter in NFPA 72, and include the following:
 - 1) Equipment tested.
 - 2) Frequency of testing of installed components.
 - 3) Frequency of inspection of installed components.
 - 4) Requirements and recommendations related to results of maintenance.
 - 5) Manufacturer's user training manuals.
 - i. Manufacturer's required maintenance related to system warranty requirements.
 - j. Abbreviated operating instructions for mounting at fire-alarm control unit and each annunciator unit.
- B. Software and Firmware Operational Documentation:
 - 1. Software operating and upgrade manuals.
 - 2. Program Software Backup: On magnetic media or compact disk, complete with data files.
 - 3. Device address list.
 - 4. Printout of software application and graphic screens.

1.6 EXTRA MATERIAL

- A. Furnish extra materials that match products installed and that are packaged with protective covering for storage and identified with labels describing contents.
 - 1. Lamps for Remote Indicating Lamp Units: **Ten**
 - 2. Lamps for Strobe Units: **Ten**
 - 3. Smoke Detectors: Ten

- 4. Detector Bases: **Five**
- 5. Keys and Tools: One extra set for access to locked or tamper proofed components.
- 6. Audible and Visual Notification Appliances: [One] of each type installed.
- 7. Fuses: **[Two]** of each type installed in the system. Provide in a box or cabinet with compartments marked with fuse types and sizes.

8. Filters for Air-Sampling Detectors: Quantity equal to [two] percent of amount of each type installed, but no fewer than one unit of each type.

1.7 QUALITY ASSURANCE

- A. Installer Qualifications: Personnel shall be trained and certified by manufacturer for installation of units required for this Project.
- B. Installer Qualifications: Installation shall be by personnel certified by NICET as fire-alarm [Level III] technician.
- C. Requirement of Regulatory Agencies:
 - 1. National Fire Protection Association (NFPA).
 - a. NFPA 70 National Electrical Code.
 - b. NFPA 72 National Fire Alarm Code.
 - c. NFPA 90A Standard for the installation of Air Conditioning and Venting Systems.
 - d. NFPA 92 Standard for Smoke Management Systems.
 - e. NFPA 101 Life Safety Code.
 - 2. Underwriters Laboratories, Inc. (UL)WARRANTY
 - a. UL 864, 10th Edition.
 - b. UL FPED.
 - c. UL 1971, standard for visual signaling appliances. Uniform Building Code and the Uniform Fire Code or other State and Local Building Codes as adopted and/or amended by the authority having jurisdiction.
 - d. Department of Justice rules for building accessibility by the handicapped, and/or State and local equivalency standards as adopted by local AHJ's
- D. Manufacturer's Warranty: Manufacturer agrees to repair or replace fire-alarm system equipment and components that fail in materials or workmanship within specified warranty period.
 - 1. Warranty Period: **[one]** year from date of substantial completion.

PART 2 - PRODUCTS

2.1 MANUFACTUERS

A. Fire alarm systems, equipment, hardware and software shall be provided by a single manufacturer.

- B. Manufacturers: Subject to compliance with requirements of this section and sections referenced in paragraph, provide products by one of the following:
 - 1. Jail Facility Fire Alarm system manufacturer shall match existing.
 - 2. FACP, Audible and Visual Signals, and Equipment
 - a. EST
 - b. NOTIFIER.
 - c. Siemens Building Technologies, Inc.; a Cerberus Division.
 - d. JCI/ Simplex
 - 3. Wire and Cable
 - a. Comtran Corporation.
 - b. Helix/HiTemp Cables, Inc.; a Draka USA Company.
 - c. West Penn Wire/CDT; a division of Cable Design Technologies.

2.2 SYSTEM DESCRIPTION

- A. Non-code, analog-addressable system; automatic sensitivity control of certain smoke detectors; and multiplexed signal transmission dedicated to fire alarm service only. System shall be forward and backward compatible without replacing or extensive modifications for ten (10) years.
 - 1. The system shall include all required hardware, interconnecting wiring and software to accomplish the requirements of this specification section and the contract documents for complete operational system.
 - The system shall be UL 864 10th Edition compliant and meet the requirements of UOJZ for Fire Alarm Control and also meet UUKL for Smoke Control in accordance with NFPA 90A and 92. The system shall be listed and approved for use in both dedicated and non-dedicated smoke control.
 - 3. All components provided shall be listed for use with the selected system.

2.3 SYSTEMS OPERATIONAL DESCRIPTION

- A. Fire-alarm signal initiation shall be by one or more of the following devices [and systems]:
 - 1. Manual stations.
 - 2. Heat detectors.
 - 3. Flame detectors.
 - 4. Smoke detectors.
 - 5. Duct smoke detectors.

6. Air-sampling smoke-detection system

- 7. Combustible gas detectors.
- 8. Automatic sprinkler system water flow.
- 9. Fire-extinguishing system operation.
- 10. Clean Agent Extinguishing System flow switch.
- B. Fire-alarm signal shall initiate the following actions:

- 1. Continuously operate alarm notification appliances.
- 2. Identify alarm and specific initiating device at fire-alarm control unit and remote annunciators.
- 3. Transmit an alarm signal to the remote alarm receiving station.
- 4. Unlock electric door locks in designated egress paths.
- 5. Release fire and smoke doors held open by magnetic door holders.
- 6. Activate voice/alarm communication system.
- 7. Switch heating, ventilating, and air-conditioning equipment controls to fire-alarm mode.
- 8. Activate smoke-control system (smoke management) at firefighters' smoke-control system panel.
- 9. Activate stairwell and elevator-shaft pressurization systems.
- 10. Close smoke dampers in air ducts of designated air-conditioning duct systems.
- 11. Recall elevators to primary.
- 12. Activate elevator power shunt trip.
- 13. Activate emergency lighting control.
- 14. Activate emergency shutoffs for gas and fuel supplies.
- 15. Record events in the system memory.
- 16. Record events by the system printer.
- 17. Indicate device in alarm on the graphic annunciator.
- C. Supervisory signal initiation shall be by one or more of the following devices and actions:
 - 1. Valve supervisory switch.
 - 2. Alert and Action signals of air-sampling detector system.
 - 3. Elevator shunt-trip supervision.
 - 4. Independent fire-detection and -suppression systems.
 - 5. User disabling of zones or individual devices.
- D. System trouble signal initiation shall be by one or more of the following devices and actions:
 - 1. Open circuits, shorts, and grounds in designated circuits.
 - 2. Opening, tampering with, or removing alarm-initiating and supervisory signal-initiating devices.
 - 3. Loss of communication with any addressable sensor, input module, relay, control module, remote annunciator, printer interface, or Ethernet module.
 - 4. Loss of primary power at fire-alarm control unit.
 - 5. Ground or a single break in internal circuits of fire-alarm control unit.
 - 6. Abnormal ac voltage at the FACP and FAAP.
 - 7. Break in standby battery circuitry.
 - 8. Failure of battery charging.
 - 9. Abnormal position of any switch at the FACP and FAAP.
 - 10. Voice signal amplifier failure.
 - 11. Low-air-pressure switch operation on pre-action sprinkler system
 - 12. Removal of an alarm initiating device.
 - 13. Loss of power to equipment and components required to perform a required fire safety function.
 - 14. Trouble in any fire suppression system control panel such as pre-action or gas systems.
 - 15. Failure in remote fire alarm notification appliance circuit power supplies.
 - 16. Failure in air sampling detectors and associated power supplies

- E. System Supervisory Signal Actions:
 - 1. Initiate notification appliances.
 - 2. Identify specific device initiating the event at FACP and FAAP.
 - 3. Record the event on system printer.
 - 4. Transmit system status to building management system.
 - 5. Display system status on graphic annunciator.

2.4 FIRE-ALARM CONTROL UNIT

- A. General Requirements for Fire-Alarm Control Unit:
 - 1. Field-programmable, microprocessor-based, modular, power-limited design with electronic modules, complying with UL 864.
 - a. System software and programs shall be held in nonvolatile flash, electrically erasable, programmable, read-only memory, retaining the information through failure of primary and secondary power supplies.
 - b. Include a real-time clock for time annotation of events on the event recorder and printer.
 - c. Provide communication between the FACP, FAAP and remote circuit interface panels, annunciators, and displays.
 - d. The FACP shall be listed for connection to a central-station signaling system service.
 - e. Provide nonvolatile memory for system database, logic, and operating system and event history. The system shall require no manual input to initialize in the event of a complete power down condition. The FACP shall provide a minimum 4000-event history log.
 - 2. Addressable Initiation Device Circuits: The FACP shall indicate which communication zones have been silenced and shall provide selective silencing of alarm notification appliance by building communication zone.
 - 3. Addressable Control Circuits for Operation of Notification Appliances and Mechanical Equipment: The FACP shall be listed for releasing service.
- B. Alphanumeric Display and System Controls: Arranged for interface between human operator at fire-alarm control unit and addressable system components including annunciation and supervision. Display alarm, supervisory, and component status messages and control menu.
 - 1. Annunciator and Display: Liquid-crystal type, [160] characters, minimum.
 - 2. Keypad: Arranged to permit entry and execution of display, and control commands.
- C. Alphanumeric Display and System Controls: Arranged for interface between human operator at fire-alarm control unit and addressable system components including annunciation and supervision. Display alarm, supervisory, and component status messages and the programming and control menu.
 - 1. Annunciator and Display: Liquid-crystal type, [four] lines of [40] characters, minimum.

- 2. Keypad: Arranged to permit entry and execution of display, and control commands.
- D. Initiating-Device, Notification-Appliance, and Signaling-Line Circuits:
 - 1. Pathway Class Designations: NFPA 72, [Class C]
 - 2. Pathway Survivability: [Level 1].
 - 3. Serial Interfaces:
 - a. One dedicated RS 485 port for [central-station] [remote station] operation using point ID DACT.
 - b. One RS 485 port for remote annunciators, Ethernet module, or multi-interface module (printer port).
 - c. One Ethernet port for PC configuration.
- E. Stairwell and Elevator Shaft Pressurization: Provide an output signal using an addressable relay to start the stairwell and elevator shaft pressurization system. Signal shall remain on until alarm conditions are cleared, and fire-alarm system is reset. Signal shall not stop in response to alarm acknowledge or signal silence commands.
 - 1. Pressurization starts when any alarm is received at fire-alarm control unit.
 - 2. Alarm signals from smoke detectors at pressurization air supplies have a higher priority than other alarm signals that start the system.
- F. Smoke-Alarm Verification:
 - 1. Initiate audible and visible indication of an "alarm-verification" signal at fire-alarm control unit.
 - 2. Activate an approved "alarm-verification" sequence at fire-alarm control unit and detector.
 - 3. Record events by the system printer.
 - 4. Sound general alarm if the alarm is verified.
 - 5. Cancel fire-alarm control unit indication and system reset if the alarm is not verified.
- G. Notification-Appliance Circuit:
 - 1. Audible appliances shall sound in a three-pulse temporal pattern, as defined in NFPA 72.
 - 2. Where notification appliances provide signals to sleeping areas, the alarm signal shall be a 520-Hz square wave with an intensity 15 dB above the average ambient sound level or 5 dB above the maximum sound level, or at least 75 dBA, whichever is greater, measured at the pillow.
 - 3. Visual alarm appliances shall flash in synchronization where multiple appliances are in the same field of view, as defined in NFPA 72.
- H. Elevator Recall:
 - 1. Elevator recall shall be initiated only by one of the following alarm-initiating devices:
 - a. Elevator lobby detectors except the lobby detector on the designated floor.
 - b. Smoke detector in elevator machine room.
 - c. Smoke detectors in elevator hoistway.

- 2. Elevator controller shall be programmed to move the cars to the alternate recall floor if lobby detectors located on the designated recall floors are activated.
- 3. Water-flow alarm connected to sprinkler in an elevator shaft and elevator machine room shall shut down elevators associated with the location without time delay.
 - a. Water-flow switch associated with the sprinkler in the elevator pit may have a delay to allow elevators to move to the designated floor.
- I. Remote Smoke-Detector Sensitivity Adjustment: Controls shall select specific addressable smoke detectors for adjustment, display their current status and sensitivity settings, and change those settings. Allow controls to be used to program repetitive, time-scheduled, and automated changes in sensitivity of specific detector groups. Record sensitivity adjustments and sensitivity-adjustment schedule changes in system memory.
- J. Transmission to Remote Alarm Receiving Station: Automatically transmit alarm, supervisory, and trouble signals to a remote alarm station.
- K. Voice/Alarm Signaling Service: Central emergency communication system
 - 1. Indicate number of alarm channels for automatic, simultaneous transmission of different announcements to different zones or for manual transmission of announcements by use of the central-control microphone. Amplifiers shall comply with UL 1711.
 - a. Allow the application of, and evacuation signal to, indicated number of zones and, at the same time, allow voice paging to the other zones selectively or in any combination.
 - b. Programmable tone and message sequence selection.
 - c. Standard digitally recorded messages for "Evacuation" and "All Clear."
 - d. Generate tones to be sequenced with audio messages of type recommended by NFPA 72 and that are compatible with tone patterns of notification-appliance circuits of fire-alarm control unit.
 - 2. Status Annunciator: Indicate the status of various voice/alarm speaker zones and the status of firefighters' two-way telephone communication zones.
- L. Primary Power: 24-V dc obtained from 120-V ac service and a power-supply module. Initiating devices, notification appliances, signaling lines, trouble signals, [supervisory signals] [supervisory and digital alarm communicator transmitters] be powered by 24-V dc source.
 - 1. Alarm current draw of entire fire-alarm system shall 8not exceed 80 percent of the powersupply module rating.
- M. Secondary Power: 24-V dc supply system with batteries, automatic battery charger, and automatic transfer switch.
 - 1. Batteries: Sealed lead-acid of nickel cadmium type. Provide sufficient capacity to operate the complete system in normal or supervisory (non-alarm) mode for a period of 24 hours. Following this period of operation on battery power, the battery shall have sufficient capacity to operate all components of the system, including all alarm indicating devices in alarm or supervisory mode for a period of 5 minutes.

N. Instructions: Computer printout or typewritten instruction card mounted behind a plastic or glass cover in a stainless-steel or aluminum frame. Include interpretation and describe appropriate response for displays and signals. Briefly describe the functional operation of the system under normal, alarm, and trouble conditions.

2.5 MANUAL FIRE-ALARM BOXES (Manual Pull Stations)

- A. General Requirements for Manual Fire-Alarm Boxes: Comply with UL 38. Boxes shall be diecast construction finished in red with operating instructions in contrasting color; shall show visible indication of operation; and shall be mounted on recessed outlet box. If indicated as surface mounted, provide manufacturer's surface back box.
 - 1. Double-action mechanism requiring two actions to initiate an alarm, [lift-cover] [pull-lever] type; with [integral] addressable module arranged to communicate manual-station status (normal, alarm, or trouble) to fire-alarm control unit.
 - 2. Station Reset: Key- or wrench-operated switch.
 - 3. Indoor Protective Shield: Factory-fabricated, clear plastic enclosure hinged at the top to permit lifting for access to initiate an alarm.
 - 4. Weatherproof Protective Shield: Factory-fabricated, clear plastic enclosure hinged at the top to permit lifting for access to initiate an alarm.

2.6 SYSTEM SMOKE DETECTORS

- A. General Requirements for System Smoke Detectors:
 - 1. Integral Addressable Module: Arranged to communicate detector status (normal, alarm, or trouble) to fire-alarm control unit.
 - 2. Base Mounting: Detector and associated electronic components shall be mounted in a twist-lock module that connects to a fixed base. Provide terminals in the fixed base for connection to building wiring.
 - 3. Self-Restoring: Detectors do not require resetting or readjustment after actuation to restore them to normal operation.
 - 4. Integral Visual-Indicating Light: LED type, indicating detector has operated.
 - 5. Remote Control: Unless otherwise indicated, detectors shall be digital-addressable type, individually monitored at fire-alarm control unit for calibration, sensitivity, and alarm condition **and individually adjustable for sensitivity by fire-alarm control unit**.
 - a. Rate-of-rise temperature characteristic of combination smoke- and heat-detection units shall be selectable at fire-alarm control unit for 15 deg F (8 deg C) per minute.
 - b. Multiple levels of detection sensitivity for each sensor.
 - c. Sensitivity levels based on time of day.
- B. Photoelectric Smoke Detectors:
 - 1. Detector address shall be accessible from fire-alarm control unit and shall be able to identify the detector's location within the system and its sensitivity setting.

- 2. An operator at fire-alarm control unit, having the designated access level, shall be able to manually access the following for each detector:
 - a. Primary status.
 - b. Device type.
 - c. Present average value.
 - d. Present sensitivity selected.
 - e. Sensor range (normal, dirty, etc.).
- C. Duct Smoke Detectors: Photoelectric type complying with NFPA 72.
 - 1. Detector address shall be accessible from fire-alarm control unit and shall be able to identify the detector's location within the system and its sensitivity setting.
 - 2. An operator at fire-alarm control unit, having the designated access level, shall be able to manually access the following for each detector:
 - a. Primary status.
 - b. Device type.
 - c. Present average value.
 - d. Present sensitivity selected.
 - e. Sensor range (normal, dirty, etc.).
 - 3. Sampling Tubes: Design and dimensions as recommended by manufacturer for specific duct size, air velocity, and installation conditions where applied.
 - 4. Relay Fan Shutdown: Fully programmable relay rated to interrupt fan motor-control circuit.

2.7 PROJECTED BEAM SMOKE DETECTORS

- A. Projected Beam Light Source and Receiver: Designed to accommodate small angular movements and continue to operate and not cause nuisance alarms.
- B. Conventional detector with monitor module to identify the detector's location within the system.

2.8 HEAT DETECTORS

- A. General Requirements for Heat Detectors: Comply with NFPA 72.
 - 1. Temperature sensors shall test for and communicate the sensitivity range of the device.
- B. Heat Detector, Combination Type: Actuated by either a fixed temperature of [135 deg F (57 deg C)] or a rate of rise that exceeds 15 deg F (8 deg C) per minute unless otherwise indicated.
 - 1. Mounting: Twist-lock base interchangeable with smoke-detector bases.
 - 2. Integral Addressable Module: Arranged to communicate detector status (normal, alarm, or trouble) to fire-alarm control unit.
- C. Continuous Linear Heat-Detector System:

- 1. Detector Cable: Rated detection temperature [155 deg F (68 deg C)]. Listed for "regular" service and a standard environment. Cable includes two steel actuator wires twisted together with spring pressure, wrapped with protective tape, and finished with PVC outer sheath. Each actuator wire is insulated with heat-sensitive material that reacts with heat to allow the cable twist pressure to short circuit wires at the location of elevated temperature.
- 2. Control Unit: Two-zone or multizone unit as indicated. Provide same system power supply, supervision, and alarm features as specified for fire-alarm control unit.
- 3. Signals to Fire-Alarm Control Unit: Any type of local system trouble shall be reported to fire-alarm control unit as a composite "trouble" signal. Alarms on each detection zone shall be individually reported to central fire-alarm control unit as separately identified zones.
- 4. Integral Addressable Module: Arranged to communicate detector status (normal, alarm, or trouble) to fire-alarm control unit.

2.9 AIR-SAMPLING SMOKE DETECTOR

- A. General Description:
 - 1. Air-sampling smoke detector shall be laser based using a piping system and a fan to transport the particles of combustion to the detector.
 - 2. Provide two levels of alarm from each zone covered by the detector and two supervisory levels of alarm from each detector.
 - 3. The air being sampled shall pass through filters to remove dust particulates greater than 20 microns before entering the detection chamber.
 - 4. Detectors shall have the capability via RS 485 to connect up to 100 detectors in a network.
 - 5. Detectors shall communicate with the fire-alarm control unit via addressable, monitored dry contact closures, RS 485, and interface modules. Provide a minimum of six relays, individually programmable remotely for any function.
 - 6. Pipe airflow balancing calculations shall be performed using approved calculation software.
- **B.** Detector:
 - 1. Detector, Filter, Aspirator, and Relays: Housed in a mounting box and arranged in such a way that air is drawn from the detection area and a sample passed through the dualstage filter and detector by the aspirator.
 - 2. Four independent, field-programmable, smoke-alarm thresholds per sensor pipe and a programmable scan time delay. The threshold set points shall be programmable.
 - a. The four alarm thresholds may be used as follows:
 - 1) Alarm Level 1 (Alert): Activate a visual and an audible supervisory alarm.
 - 2) Alarm Level 2 (Action): Activate shutdown of electrical/HVAC equipment and activate a visual and an audible supervisory alarm.
 - 3) Alarm Level 3 (Fire 1): Activate building alarm systems and initiate call to fire response unit.
 - 4) Alarm Level 4 (Fire 2): Activate suppression system or other countermeasures.

ADDENDUM #04 Addressable Fire-Alarm Systems Copyright © 2022 by RQAW b. Final Detection System Settings: Approved by Owner.

3. Power Supply:

- a. Regulated 24-V dc, monitored by the fire-alarm control unit, with battery backup.
 b. Battery backup shall provide 24 hours' standby, followed by 30 minutes at maximum connected load.
- 4. Detector shall also transmit the following faults:
 - a. Detector.
 - b. Airflow.
 - c. Filter.
 - d. System.
 - e. Zone.
 - f. Network. g. Power.
- 5. Provide four in-line sample pipe inlets that shall contain a flow sensor for each pipe inlet. The detector shall be capable of identifying the pipe from which smoke was
 - detected.
 Aspirator: Air pump capable of allowing for multiple sampling pipe runs up to 650 feet
 (200 m) in total, (four pipe runs per detector) with a transport time of less than 120 seconds from the farthest sample port.
 - 7. Air-Sampling Flow Rates Outside Manufacturer's Specified Range: Result in a trouble alarm.
 - 8. Provide software-programmable relays rated at 2 A at 30-V dc for alarm and fault conditions.
 - 9. Provide built-in event and smoke logging; store smoke levels, alarm conditions, operator actions, and faults with date and time of each event. Each detector (zone) shall be capable of storing up to 18,000 events.
 - 10. Urgent and Minor Faults. Minor faults shall be designated as trouble alarms. Urgent faults, which indicate the unit may not be able to detect smoke, shall be designated as supervisory alarms.

C. Displays:

- **1.** Include display module within each detector.
- 2. Each display shall provide the following features at a minimum:
 - a. <u>A bar-graph display.</u>
 - b. Four independent, high-intensity alarm indicators (Alert, Action, Fire 1, and Fire 2), corresponding to the four alarm thresholds of the indicated sector.
 - c. Alarm threshold indicators for Alert, Action, and Fire 1.
 - d. LED indication that the first alarm sector is established.
 - e. Detector fault and airflow fault indicators.
 - f. LED indicators shall be provided for faults originating in the particular zone (Zone Fault), faults produced by the overall smoke-detection system, and faults resulting from network wiring errors (Network Fault).
 - g. Minor and urgent LED fault indicators.

ADDENDUM #04 Addressable Fire-Alarm Systems

Copyright © 2022 by RQAW

D. Sampling Tubes:

- 1. Smooth bore with a nominal 1-inch (25-mm) OD and a 7/8-inch (21-mm) ID. Sampling pipe with between 5/8- and 1-inch (15- and 25-mm) ID can be used in specifically approved locations when recommended by manufacturer.
- 2. Pipe Material: CPVC and complying with UL 1887, "Safety Fire Test of Plastic Sprinkler Pipe for Visible Flame and Smoke Characteristics."
- 3. Joints in the sampling pipe shall be airtight. Use solvent cement approved by the pipe manufacturer on all joints except at entry to the detector.
- 4. Identify piping with labels reading: "Aspirating Smoke Detector Pipe Do Not Paint or Disturb" along its entire length at regular intervals according to NFPA 72.
- 5. Support pipes at not more than 60-inch (1520-mm) centers.
- 6. Fit end of each trunk or branch pipe with an end cap and drilled with a hole appropriately sized to achieve the performance as specified and as calculated by the system design.
- E. Sampling Holes:
 - 1. Sampling holes of 5/64 inch (2 mm), or other sized holes per manufacturer's written instructions, shall be separated by not more than the maximum distance allowable for conventional smoke detectors. Intervals may vary according to calculations.
 - 2. Follow manufacturer's written recommendations to determine the number and spacing of sampling points and the distance from sampling points to ceiling or roof structure and to forced ventilation systems.
 - 3. Each sampling point shall be identified by an applied decal.

2.10 NOTIFICATION APPLIANCES

- A. General Requirements for Notification Appliances: Connected to notification-appliance signal circuits, zoned as indicated, equipped for mounting as indicated, and with screw terminals for system connections.
 - 1. Combination Devices: Factory-integrated audible and visible devices in a single-mounting assembly, equipped for mounting as indicated, and with screw terminals for system connections.
- B. Visible Notification Appliances: Xenon strobe lights complying with UL 1971, with clear lens mounted on an aluminum faceplate. The word "FIRE" is displayed in minimum 1-inch- (25-mm-) high letters.
 - 1. Rated Light Output:
 - a. 15/30/75/110 candela, selectable in the field
 - 2. Mounting: Wall mounted unless otherwise indicated.
 - 3. For units with guards to prevent physical damage, light output ratings shall be determined with guards in place.
 - 4. Flashing shall be in a temporal pattern, synchronized with other units.
 - 5. Strobe Leads: Factory connected to screw terminals.

- 6. Mounting Faceplate: Factory finished, red.
- C. Voice/Tone Notification Appliances:
 - 1. Comply with UL 1480.
 - 2. Speakers for Voice Notification: Locate speakers for voice notification to provide the intelligibility requirements of the "Notification Appliances" and "Emergency Communications Systems" chapters in NFPA 72.
 - 3. High-Range Units: Rated 2 to 15 W.
 - 4. Low-Range Units: Rated 1 to 2 W.
 - 5. Mounting: Flush, semi-recessed] [or] surface mounted and bidirectional.
 - 6. Matching Transformers: Tap range matched to acoustical environment of speaker location.
- D. Exit Marking Audible Notification Appliance:
 - 1. Exit marking audible notification appliances shall meet the audibility requirements in NFPA 72.
 - 2. Provide exit marking audible notification appliances at the entrance to all building exits.
 - 3. Provide exit marking audible notification appliances at the entrance to areas of refuge with audible signals distinct from those used for building exit marking.

2.11 FIREFIGHTERS' TWO-WAY TELEPHONE COMMUNICATION SERVICE

- A. Dedicated, two-way, supervised, telephone voice communication links between fire-alarm control unit and remote firefighters' telephone stations. Supervised telephone lines shall be connected to talk circuits by controls in a control module. Provide the following:
 - 1. Common-talk type for firefighter use only.
 - 2. Selective-talk type for use by firefighters and fire wardens.
 - 3. Audible Pulse and Tone Generator, and High-Intensity Lamp: When a remote telephone is taken off the hook, it causes an audible signal to sound and a high-intensity lamp to flash at the fire command center.
 - 4. Selector panel controls to provide for simultaneous operation of up to five telephones in the same zone. Indicate ground faults and open or shorted telephone lines on the panel front by individual LEDs.
 - 5. Display: LED to indicate location of caller.
 - 6. Remote Telephone Cabinet: Flush- or surface-mounted cabinet as indicated, factorystandard red finish, with handset.
 - 7. Remote Telephone Jack Stations: Single-gang, stainless-steel-plate mounted plug, engraved "Fire Emergency Phone."

2.12 FIREFIGHTERS' SMOKE-CONTROL SYSTEM

- A. Initiate Smoke-Management Sequence of Operation:
 - 1. Comply with sequence of operation as described in Section 230993.11 "Sequence of Operations for HVAC DDC."

- 2. Smoke control panel shall provide all interfaces and control points required to properly activate smoke-management systems.
- 3. First fire-alarm system initiating device to go into alarm condition shall activate the smokecontrol functions.
- 4. Subsequent devices going into alarm condition shall have no effect on the smoke-control mode.

2.13 REMOTE ANNUNCIATOR

- A. Description: Annunciator functions shall match those of fire-alarm control unit for alarm, supervisory, and trouble indications. Manual switching functions shall match those of fire-alarm control unit, including acknowledging, silencing, resetting, and testing.
 - 1. Mounting: [**Surface**] cabinet, NEMA 250, Type 1.
- B. Display Type and Functional Performance: Alphanumeric display and LED indicating lights shall match those of fire-alarm control unit. Provide controls to acknowledge, silence, reset, and test functions for alarm, supervisory, and trouble signals.

2.14 ADDRESSABLE INTERFACE DEVICE

- A. General:
 - 1. Include address-setting means on the module.
 - 2. Store an internal identifying code for control panel use to identify the module type.
- B. Monitor Module: Microelectronic module providing a system address for alarm-initiating devices for wired applications with normally open contacts.
- C. Integral Relay: Capable of providing a direct signal [to elevator controller to initiate elevator recall].
 - 1. Allow the control panel to switch the relay contacts on command.
 - 2. Have a minimum of one normally open and one normally closed contacts available for field wiring.
- D. Control Module:
 - 1. Operate notification devices.
 - 2. Operate solenoids for use in sprinkler service.

2.15 DIGITAL ALARM COMMUNICATOR TRANSMITTER

- A. Digital alarm communicator transmitter shall be acceptable to the remote central station and shall comply with UL 632.
- B. Functional Performance: Unit shall receive an alarm, supervisory, or trouble signal from firealarm control unit and automatically capture [**two**] telephone line(s) and dial a preset number for

a remote central station. When contact is made with central station(s), signals shall be transmitted. If service on either line is interrupted for longer than 45 seconds, transmitter shall initiate a local trouble signal and transmit the signal indicating loss of telephone line to the remote alarm receiving station over the remaining line. Transmitter shall automatically report telephone service restoration to the central station. If service is lost on both telephone lines, transmitter shall initiate the local trouble signal.

- C. Local functions and display at the digital alarm communicator transmitter shall include the following:
 - 1. Verification that both telephone lines are available.
 - 2. Programming device.
 - 3. LED display.
 - 4. Manual test report function and manual transmission clear indication.
 - 5. Communications failure with the central station or fire-alarm control unit.
- D. Digital data transmission shall include the following:
 - 1. Address of the alarm-initiating device.
 - 2. Address of the supervisory signal.
 - 3. Address of the trouble-initiating device.
 - 4. Loss of ac supply.
 - 5. Loss of power.
 - 6. Low battery.
 - 7. Abnormal test signal.
 - 8. Communication bus failure.
- E. Secondary Power: Integral rechargeable battery and automatic charger.
- F. Self-Test: Conducted automatically every 24 hours with report transmitted to central station.

2.16 NETWORK COMMUNICATIONS

- A. Provide network communications for fire-alarm system according to fire-alarm manufacturer's written requirements.
- B. Provide network communications pathway per manufacturer's written requirements and requirements in NFPA 72 and NFPA 70.

2.17 FIRE ALARM DEVICE PROTECTIVE COVERS

- A. Description: Provide Safety Technology International (STI) type protective covers for the manual pull station, smoke detector, or other device requiring protection.
 - 1. Factory fabricated and furnished by device manufacturer.

2.18 WIRE AND CABLE

- A. Wire and cable for fire alarm systems shall be UL listed and labeled as complying with NFPA 70, Article 760.
- B. Signaling Line Circuits: Type and size as recommended by system manufacturer.
- C. Non-Power-Limited Circuits: Solid-copper conductors with 600-V rated, 75 deg C, color-coded insulation.
 - 1. Low-voltage circuits: No. 16 AWG, minimum.
 - 2. Line-voltage circuits: No. 12 AWG, minimum.

PART 3 - EXECUTION

3.1 EXAMINATION

- A. Examine areas and conditions for compliance with requirements for ventilation, temperature, humidity, and other conditions affecting performance of the Work.
 - 1. Verify that manufacturer's written instructions for environmental conditions have been permanently established in spaces where equipment and wiring are installed, before installation begins.
- B. Examine roughing-in for electrical connections to verify actual locations of connections before installation.
- C. Proceed with installation only after unsatisfactory conditions have been corrected.

3.2 EQUIPMENT INSTALLATION

- A. Comply with NFPA 72, NFPA 101, and requirements of authorities having jurisdiction for installation and testing of fire-alarm equipment. Install all electrical wiring to comply with requirements in NFPA 70 including, but not limited to, Article 760, "Fire Alarm Systems."
 - 1. Devices placed in service before all other trades have completed cleanup shall be replaced.
 - 2. Devices installed but not yet placed in service shall be protected from construction dust, debris, dirt, moisture, and damage according to manufacturer's written storage instructions.
- B. Equipment Mounting: Install fire-alarm control unit on concrete base. Comply with requirements for concrete base specified in Section 033000 "Cast-in-Place Concrete."
- C.
- 1. Install dowel rods to connect concrete base to concrete floor. Unless otherwise indicated, install dowel rods on 18-inch (460-mm) centers around the full perimeter of concrete base.

- 2. For supported equipment, install epoxy-coated anchor bolts that extend through concrete base and anchor into structural concrete floor.
- 3. Place and secure anchorage devices. Use setting drawings, templates, diagrams, instructions, and directions furnished with items to be embedded.
- 4. Install anchor bolts to elevations required for proper attachment to supported equipment.
- D. Install wall-mounted equipment, with tops of cabinets not more than 78 inches (1980 mm) above the finished floor.
- E. Manual Fire-Alarm Boxes:
 - 1. Install manual fire-alarm box in the normal path of egress within 60 inches (1520 mm) of the exit doorway.
 - 2. Mount manual fire-alarm box on a background of a contrasting color.
 - 3. The operable part of manual fire-alarm box shall be between 42 inches (1060 mm) and 48 inches (1220 mm) above floor level. All devices shall be mounted at the same height unless otherwise indicated.
- F. Smoke- or Heat-Detector Spacing:
 - 1. Comply with the "Smoke-Sensing Fire Detectors" section in the "Initiating Devices" chapter in NFPA 72, for smoke-detector spacing.
 - 2. Comply with the "Heat-Sensing Fire Detectors" section in the "Initiating Devices" chapter in NFPA 72, for heat-detector spacing.
 - 3. Smooth ceiling spacing shall not exceed [30 feet (9 m)].
 - 4. Spacing of detectors for irregular areas, for irregular ceiling construction, and for high ceiling areas shall be determined according to Annex A or Annex B in NFPA 72.
 - 5. HVAC: Locate detectors not closer than [**36 inches (910 mm)**] from air-supply diffuser or return-air opening.
 - 6. Lighting Fixtures: Locate detectors not closer than 12 inches (300 mm) from any part of a lighting fixture and not directly above pendant mounted or indirect lighting.
- G. Install a cover on each smoke detector that is not placed in service during construction. Cover shall remain in place except during system testing. Remove cover prior to system turnover.
- H. Duct Smoke Detectors: Comply with NFPA 72 and NFPA 90A. Install sampling tubes so they extend the full width of duct. Tubes more than 36 inches (9100 mm) long shall be supported at both ends.
 - 1. Do not install smoke detector in duct smoke-detector housing during construction. Install detector only during system testing and prior to system turnover.

I. Air-Sampling Smoke Detectors: If using multiple pipe runs, the runs shall be pneumatically balanced.

J. Elevator Shafts: Coordinate temperature rating and location with sprinkler rating and location. Do not install smoke detectors in sprinklered elevator shafts.

- K. Single-Station Smoke Detectors: Where more than one smoke alarm is installed within a dwelling or suite, they shall be connected so that the operation of any smoke alarm causes the alarm in all smoke alarms to sound.
- L. Remote Status and Alarm Indicators: Install in a visible location near each smoke detector, sprinkler water-flow switch, and valve-tamper switch that is not readily visible from normal viewing position.
- M. Audible Alarm-Indicating Devices: Install not less than 6 inches (150 mm) below the ceiling. Install bells and horns on flush-mounted back boxes with the device-operating mechanism concealed behind a grille. Install all devices at the same height unless otherwise indicated.
- N. Visible Alarm-Indicating Devices: Install adjacent to each alarm bell or alarm horn and at least 6 inches (150 mm) below the ceiling. Install all devices at the same height unless otherwise indicated.
- O. Device Location-Indicating Lights: Locate in public space near the device they monitor.

3.3 PATHWAYS

- A. Pathways above recessed ceilings and in nonaccessible locations may be routed exposed.
 - 1. Exposed pathways located less than 96 inches (2440 mm) above the floor shall be installed in EMT.
- B. Pathways shall be installed in EMT.
- C. Exposed EMT shall be painted red enamel.

3.4 CONNECTIONS

- A. For fire-protection systems related to doors in fire-rated walls and partitions and to doors in smoke partitions, comply with requirements in Section 087100 "Door Hardware." Connect hardware and devices to fire-alarm system.
 - 1. Verify that hardware and devices are listed for use with installed fire-alarm system before making connections.
- B. Make addressable connections with a supervised interface device to the following devices and systems. Install the interface device less than 36 inches (910 mm) from the device controlled. Make an addressable confirmation connection when such feedback is available at the device or system being controlled.
 - 1. Alarm-initiating connection to smoke-control system (smoke management) at firefighters' smoke-control system panel.
 - 2. Alarm-initiating connection to stairwell and elevator-shaft pressurization systems.
 - 3. Smoke dampers in air ducts of designated HVAC duct systems.
 - 4. Electronically locked doors and access gates.
 - 5. Alarm-initiating connection to elevator recall system and components.

- 6. Alarm-initiating connection to activate emergency lighting control.
- 7. Alarm-initiating connection to activate emergency shutoffs for gas and fuel supplies.
- 8. Supervisory connections at valve supervisory switches.
- 9. Supervisory connections at low-air-pressure switch of each dry-pipe sprinkler system.
- 10. Supervisory connections at elevator shunt-trip breaker.
- 11. Data communication circuits for connection to building management system.
- 12. Supervisory connections at fire-extinguisher locations.

3.5 IDENTIFICATION

- A. Identify system components, wiring, cabling, and terminals. Comply with requirements for identification specified in Section 260553 "Identification for Electrical Systems."
- B. Install framed instructions in a location visible from fire-alarm control unit.

3.6 GROUNDING

- A. Ground fire-alarm control unit and associated circuits; comply with IEEE 1100. Install a ground wire from main service ground to fire-alarm control unit.
- B. Ground shielded cables at the control panel location only. Insulate shield at device location.

3.7 FIELD QUALITY CONTROL

- A. Manufacturer's Field Service: Engage a factory-authorized service representative to test and inspect components, assemblies, and equipment installations, including connections.
- B. Perform tests and inspections.
- C. Perform the following tests and inspections with the assistance of a factory-authorized service representative:
 - 1. Visual Inspection: Conduct visual inspection prior to testing.
 - a. Inspection shall be based on completed record Drawings and system documentation that is required by the "Completion Documents, Preparation" table in the "Documentation" section of the "Fundamentals" chapter in NFPA 72.
 - b. Comply with the "Visual Inspection Frequencies" table in the "Inspection" section of the "Inspection, Testing and Maintenance" chapter in NFPA 72; retain the "Initial/Reacceptance" column and list only the installed components.
 - 2. System Testing: Comply with the "Test Methods" table in the "Testing" section of the "Inspection, Testing and Maintenance" chapter in NFPA 72.
 - 3. Test audible appliances for the public operating mode according to manufacturer's written instructions. Perform the test using a portable sound-level meter complying with Type 2 requirements in ANSI S1.4.
 - 4. Test audible appliances for the private operating mode according to manufacturer's written instructions.

- 5. Test visible appliances for the public operating mode according to manufacturer's written instructions.
- 6. Factory-authorized service representative shall prepare the "Fire Alarm System Record of Completion" in the "Documentation" section of the "Fundamentals" chapter in NFPA 72 and the "Inspection and Testing Form" in the "Records" section of the "Inspection, Testing and Maintenance" chapter in NFPA 72.
- D. Reacceptance Testing: Perform reacceptance testing to verify the proper operation of added or replaced devices and appliances.
- E. Fire-alarm system will be considered defective if it does not pass tests and inspections.
- F. Prepare test and inspection reports.
- G. Maintenance Test and Inspection: Perform tests and inspections listed for weekly, monthly, quarterly, and semiannual periods. Use forms developed for initial tests and inspections.
- H. Annual Test and Inspection: One year after date of Substantial Completion, test fire-alarm system complying with visual and testing inspection requirements in NFPA 72. Use forms developed for initial tests and inspections.

3.8 MAINTENANCE SERVICE

- A. Initial Maintenance Service: Beginning at Substantial Completion, maintenance service shall include [12] months' full maintenance by skilled employees of manufacturer's designated service organization. Include preventive maintenance, repair or replacement of worn or defective components, lubrication, cleaning, and adjusting as required for proper operation. Parts and supplies shall be manufacturer's authorized replacement parts and supplies.
 - 1. Include visual inspections according to the "Visual Inspection Frequencies" table in the "Testing" paragraph of the "Inspection, Testing and Maintenance" chapter in NFPA 72.
 - 2. Perform tests in the "Test Methods" table in the "Testing" paragraph of the "Inspection, Testing and Maintenance" chapter in NFPA 72.
 - 3. Perform tests per the "Testing Frequencies" table in the "Testing" paragraph of the "Inspection, Testing and Maintenance" chapter in NFPA 72.

3.9 SOFTWARE SERVICE AGREEMENT

- A. Comply with UL 864.
- B. Technical Support: Beginning at Substantial Completion, service agreement shall include software support for [two] years.
- C. Upgrade Service: At Substantial Completion, update software to latest version. Install and program software upgrades that become available within [two] years from date of Substantial Completion. Upgrading software shall include operating system and new or revised licenses for using software.

1. Upgrade Notice: At least [60] days to allow Owner to schedule access to system and to upgrade computer equipment if necessary.

3.10 DEMONSTRATION AND TRAINING

- 1. Training of the Owner's operation and maintenance personnel is required in cooperation with the Owner and/or Owner's Representative. Provide competent, factory authored personnel to provide instruction to operation and maintenance personnel concerning the location, operation and troubleshooting of the installed systems. The instruction shall be scheduled in coordination with the Owner and/or Owner's Representative after submission and approval of formal training plans.
- 2. Train Owner's maintenance personnel in the procedures and schedules involved in operating, troubleshooting, servicing, and preventative maintenance of the system. Provide a minimum of eight (8) hours' training.
- 3. Schedule training with the Owner at least seven days in advance.

END OF SECTION 28 31 00

SECTION 006216 – INSURANCE CERTIFICATES

ADDENDUM #04

PART 1 - GENERAL

1.1 INSURANCE REQUIREMENTS

- A. Schedule of Coverages
 - 1. Commercial General Liability policy limits not less than one (\$1,000,000) for each occurrence and two (\$2,000,000) in the aggregate for bodily injury and property damage.
 - a. These limits may be achieved through the use of an umbrella policy.
 - 2. Automobile Liability covering vehicles owner, and non-owned vehicles used by the Contractor with policy limits of not less than two (\$2,000,000) per accident for bodily injury, death of a person, and property damage arising out of the ownership, maintenance and use of those motor vehicles, along with any other statutorily required automobile coverage.
 - a. These limits may be achieved through the use of an umbrella policy.
 - 3. Worker's Compensation as statutory limits and Employers Liability with policy limits not less than one (\$1,000,000) each accident, one million (\$1,000,000) each employee, and one (\$1,000,000) policy limit.
 - a. Workers compensation as required by the statutory benefit laws of the state of states where the services are to be performed (or an associated materials and equipment created) or as required by any other state where the employee performing the services (or creating, assembling, delivering, or otherwise working on associated materials and equipment) is normally employed.
 - 4. Professional Liability covering negligent acts, errors, and omissions in the performance of professional services with policy limits of not less than one million (\$1,000,000) per claim and two million (\$2,000,000) in the aggregate.
 - 5. The Owner, Construction Manager, and Architect shall be listed as additional insureds.
 - 6. CGL insurance shall contain no exclusions for explosion, collapse, or underground hazards.
 - 7. Contracts shall maintain insurance until termination of the Agreement between Owner and Contractor.

PART 2 – PRODUCTS

2.1 WORKERS COMPENSATION INSURANCE

A. Individual Prime Contractors, Subcontractors, etc. shall provide their own Workers Compensation insurance.

2.2 BUILDER'S RISK INSURANCE

A. The Knox County Commissioners will provide Builder's Risk Insurance.

PART 3 – EXECUTION

- 3.1 Insurance requirements necessary to complete installations are included in Base Bid. A Certificate of Insurance must be issued to Garmong Construction prior to commencement of Work at the site. Identify additional insured as required.
- 3.2 The Contractor is required to keep a valid Certificate of Insurance on file for a period of three (3) years from the date of Substantial Completion.
- 3.3 By submitting a Bid Proposal for the Knox County Justice Center Project, Contractor is agreeing to all terms, conditions, and requirements of insurance requirements. No insurance requirement modifications will be made.

END OF SECTION 006216

BID CATEGORY BP. NO. 1 GENERAL TRADES SCOPE OF WORK ADDENDUM #01 ADDENDUM #03 ADDENDUM #04

This Scope of Work is to include, but is not limited to, the following Specification Sections:

<u>Section</u>	Description
Division 00	Procurement and Contracting Requirements
Division 01	General Requirements
01 74 23	FINAL CLEANING
02 41 19	SELECTIVE DEMOLITION
03 10 00	CONCRETE FORMING AND ACCESSORIES
03 20 00	CONCRETE REINFORCING
03 30 00	CAST-IN-PLACE CONCRETE
03 60 00	EPOXY GROUT
03 60 20	NON-SHRINK GROUT
06 10 53	WOOD BLOCKING AND CURBING
06 20 23	INTERIOR FINISH CARPENTRY
07 21 00	THERMAL INSULATION
07 54 03	SINGLE PLY ROOFING FULLY ADHERED
07 62 00	SHEET METAL FLASHING and TRIM
07 71 00	ROOF SPECIALTIES
07 72 33	ROOF HATCHES
07 81 23	INTUMESCENT FIREPROOFING
07 84 00	FIRESTOPPING
07 92 00	JOINT SEALANTS
07 95 00	EXPANSION JOINT COVER ASSEMBLIES
08 11 13	HOLLOW METAL DOORS AND FRAMES
08 14 16	FLUSH WOOD DOORS
08 31 13	ACCESS DOORS AND FRAMES
08 33 23	OVERHEAD COILING DOORS
08 41 13	ALUMINUM-FRAMED ENTRANCES AND STOREFRONTS
08 52 10	ALUMINUM AND GLASS BARRIER SYSTEM
08 62 00	PLASTIC UNIT SKYLIGHTS
08 71 00	DOOR HARDWARE
08 71 10	DOOR HARDWARE SCHEDULE
08 80 00	GLAZING
09 30 13	TILING
09 30 50	TILING ACCESSORIES
09 65 13	RESILIENT BASE AND ACCESSORIES
09 65 19	RESILIENT TILE FLOORING
09 65 36	STATIC CONTROL RESILIENT FLOORING
09 67 23	RESINOUS FLOORING
09 68 13	TILE CARPETING
	-

- 10 11 00 VISUAL DISPLAY UNITS
- 10 14 00 EXTERIOR SIGNAGE
- 10 14 23 ROOM INDENTIFICATION SIGNAGE
- 10 21 00 LOUVERS
- 10 21 13 SOLID PHENOLIC TOILET PARTITIONS
- 10 21 16.19 SHOWER AND TUB ENCLOSURES
- 10 26 00 CORNER GUARDS
- 10 27 00 ACCESS FLOORING
- 10 28 00 TOILET AND BATH ACCESSORIES
- 10 44 13 FIRE EXTGINGUISHERS AND CABINETS
- 10 51 13 METAL LOCKERS
- 10 53 00 CANOPY
- 10 67 00 STORAGE SHELVING
- 12 20 00 WINDOW TREATMENTS VINYL
- 12 21 13 LOUVER BLINDS (VINYL)
- 12 32 16 MANUFACTURED PLASTIC-LAMINATE -FACED CASEWORK
- 12 35 53.13 METAL LABORATORY CASEWORK
- 12 36 16 METAL COUNTERTOPS
- 12 36 61 SOLID SURFACING
- 12 48 13 ENTRANCE FLOOR MATS AND FRAMES
- 13 34 19 METAL BUILDING SYSTEMS
- 32 11 23 AGGREGATE BASE COURSE
- 32 13 13 RIGID PAVEMENT
- 32 31 13 CHAIN LINK FENCES AND GATES

This Bid Package Scope of Work describes and assigns Work to this Bid Package as designated by the Construction Manager. Each Contractor shall cooperate and coordinate with all other Bid Package Contractors for proper and expedient completion of the Work in this Project. This summary should in no way be construed as being all inclusive. It is issued as a guide to aid in the assignment of Work and is intended to clarify and/or further define the Scope of Work included in the Bid Documents. They shall not be construed as the entire Scope of Work for this Bid Package. All work described or indicated in the respective Specifications Sections or Divisions listed above shall be included, except as specifically excluded herein.

- A. General items to be included in this scope of work
 - Include an allowance for CM Directed Work in the amount of 500 manhours (250 hours each for labor and carpenter classifications). This allowance will be used at the direction of the Construction Manager for coordination, safety, cleanup, and any other item deemed necessary by the Construction Manager. All unused portions of this allowance shall be returned to the Owner via a deductive change order.
 - 2. Provide all surveying and layout required to complete the work of this bid package. This shall include providing control layout points/lines for all other trades.

- 3. Provide a telescoping boom forklift (LULL) on site upon the commencement of concrete foundations and continuing until project completion, as directed by CM. The forklift is intended for general site usage (deliveries, group clean-ups, miscellaneous material laydown organization). Individuals using the lift will be responsible for providing their own operator.
- 4. The general laborer time is intended for miscellaneous activities as requested by CM (clean-up, maintaining fall protection, etc.). Labor hours will be tracked using a log in the CM trailer that will require sign-off of all hours spent from the General Trades Contractor and CM superintendent. Provide fuel and maintenance for the (LULL) equipment on site, specified in Item #3 above.
- 5. Provide the final clean for the entire project. This shall include all sweeping, vacuuming, dusting, waxing of floors, glass cleaning (inside and outside), cell cleaning, cleaning of showers and all plumbing fixtures, toilets including all accessories, furniture, inside and outside of cabinets, walls moldings, etc. for complete clean of the entire project.
- Unloading and distribution of 11 19 10 Detention Equipment, Furnishings & Accessories, 11 19
 20 Detention Hollow Metal Doors and Frames, and 11 19 50 Detention Security Glass & Glazing.
- Provide and maintain six (6) weather resistant temporary doors complete with framing for construction access into the building through the exterior skin of the building, approximately 12'x12'. Construction consistent with Item #9 below. Remove these doors and framing as directed by the CM.
- 8. Provide two (2) temporary entrance doors for public egress and sallyport. Include locking mechanisms as required by the owner.
- 9. Temporary dust, weather, and security partitions required for demolition, construction, and phasing of work activities, as determined by the CM and owner.
 - a. Partition construction will be a minimum of 2x4 framing, plywood at each side, with a vapor / dust barrier membrane placed beneath plywood)
- 10. Access shall be provided for installation of interior work. This location is indicated in Specification 01 32 00 Schedules and Reports.
- 11. Provide and erect job / project signs as indicated in the construction documents, include costs for removal and disposal at project completion.
- B. Division 2 Demolition
 - 1. Selective demolition of existing interior and exterior partitions, slabs, doors, windows, roofing, finishes, and security items, per construction documents. This scope excludes demo of plumbing, mechanical, and fire protection equipment, devices, and piping.
 - 2. Repair adjacent or exposed surfaces which become damage as a result of demolition activities, or require rework to transition to new construction.
 - 3. All removals required for new work shall be included even if not indicated on the demolition drawings.
 - 4. All demolished materials shall be removed to a dumpster provided by the CM, with exception of larger quantities of masonry, concrete, etc. (heavy bulky materials suitable for landfill)
 - 5. This contractor is responsible for ensuring that the building is weather tight and secure during and after demolition.
- C. Division 3 Concrete
 - 1. Provide and install all concrete required for the project. This shall include all labor, materials, equipment, and supervision necessary to install a complete concrete package inclusive of

building and site concrete. This work shall include, but not limited to, the following:

- 2. Provide all surveying and layout required to complete the work of this category. This includes the establishment of a benchmark, control on site, and confirming all transition layout points are accurate, prior to placing work.
- 3. Dewatering required for the performance of this scope of work is include, regardless of source (ground, weather, etc.).
- 4. Provide excavation, over excavation or benching (if required), and compacted backfill / subgrade materials of the proper type indicated on the structural details and notations. Review and adherence to the site geotechnical report, including costs for required remediation of unsuitable soils, including haul off and proper disposal of spoils, is included in this scope of work.
- 5. Form, place, and finish all concrete footings, foundation walls, stoop turndowns, frost walls, column pads, retaining walls, and piers. Scope of work includes all reinforcing steel as indicated or required, for all concrete work. (This includes additional reinforcing requirements at security walls / floors, etc.). Provide all dowels, including epoxy drill in, required to anchor masonry walls to foundations and thickened slab areas, allowing for lap lengths specified. Provide and maintain rebar caps on all dowels until fully embedded in masonry.
- 6. Form, place, and finish all interior and exterior concrete slabs, slabs on deck, security concrete topping slabs, concrete stoops/turndowns, recessed slabs and thickened slabs including all foundation insulation, sand fill under elevated slabs, vapor barriers, expansion joint material, bond breaker material, control joints, associated dowels, wire mesh, and all other steel reinforcing. Assure curing method selected is compatible with floor finishes specified and provide complete coordination with all floor finishes. FF/FL testing within 24 hours after finishing is to be provided by this contractor.
- 7. Grinding or remedial corrective work, to provide a concrete surface in accordance with the requirements of any material to be placed over concrete (ie. Flooring), is included in this scope of work.
- 8. This contractor shall be responsible for preparing substrate to receive concrete (examples include vacuuming, sweeping, cleaning, or drying metal substrate.) Reference notes containted in the structural plans, for preparation of surfaces, prior to concrete placement. Recess concrete floor slabs at all tile locations to allow tile and floor drains to flush out with adjacent flooring.
- 9. Provide all excavation, backfill, compaction, and grading associated with completion of this bid category including building and site concrete. Provide all compacted granular base fill and fine grading under concrete provided as part of the work of this category.
- 10. All under slab vapor barrier shall be included.
- 11. Provide all miscellaneous cast in place concrete items such as benches, beds, wall caps, concrete shower curbs, locker bases, etc.
- 12. Installation of all embedded plates, angles and other misc. steel shall be included.
- 13. Layout and set all anchor bolts provided by Structural Steel and Pre-engineered Building Contractors. Grout all base plates after columns are set and elevations are finalized by steel erectors. Provide asphalt-mastic paint on portions of columns below grade according to structural details.
- 14. Coordinate installation of all concrete wall/slab/grade beam penetrations with Earthwork, HVAC, Plumbing, Fire Protection, Security Electronics, and Electrical Contractors. Sleeves for penetrations will be furnished and laid out by others for installation in formwork by this

contractor.

- 15. Provide additional reinforcing at all openings, in concrete walls and floors as indicated or specified.
- 16. Assure building grounding conductors are in place, prior to concrete placement
- 17. Provide all water stop, chamfers, keyway, stair nosing's, and other concrete accessories as indicated, specified, or required for completion of this category.
- 18. Provide positive drainage on all floors with floors drains and provide slope from room perimeter where indicated. Coordinate with flooring trades and plumbing contractor.
- 19. Finish all concrete slabs to the specified finish standards. This shall include meeting all levelness and flatness criteria and installing required sealers.
- 20. Contractor will be responsible for removing and replacing any new concrete that is deemed to not meet the contract documents through independent testing as well as any concrete that fails due to improper protection from weather conditions.
- 21. Form, place and finish all exterior and interior mechanical and electrical equipment pads. Coordinate the work for the proper size and layout of the pads with the Mechanical & Electrical Contractors.
- 22. Provide all temporary weather general conditions associated with completion of this scope of work including snow removal within the building footprint, ground thawing, and all cold and hot weather concrete procedures and protection, including rain.
- 23. Dewatering and mucking of excavations shall be the responsibility of this Contractor.
- 24. Include all hoisting and placement equipment necessary to install all concrete.
- 25. All precautions (blankets, admixtures, heat, etc.) for cold weather concrete according to ACI and/or industry practice shall be included.
- 26. All exposed concrete shall be rub finished.
- 27. Grouting of all base plates after steel erection shall be included.
- 28. Provide, place, and finish all concrete for pan fill stair treads and landings.
- 29. Provide, place and finish all site concrete, including reinforcement as indicated per the documents. Site concrete includes, but not limited to all concrete paving, sidewalks, curb & gutter, mow strips, maintenance strips, screen walls, security walls; security bollards, signs and sign bases, stoops, curbs, precast vehicle stops at concrete paving areas, pads, ramps, approaches, flagpole *and light pole* bases, etc. Provide concrete encasement for bollards, pedestals, signage, etc.
- Provide concrete paving at site utility castings / cleanouts, in hardscape and / or paved areas, as detailed on the civil drawing details, even if not specifically included or designated on site layout / paving drawings .
- 31. Provide all steel bollards for this work.
- 32. Provide barrier-free textured warning surfaces at ADA ramps where indicated.
- 33. Concrete wash out area will be created and maintained by this contractor.
- 34. Provide all sealed concrete.
- 35. Provide temporary concrete mud slab for steel cell set in (2) locations. Provide demolition, removal, and regrading of temp slabs.

- D. Sitework
 - 1. Provide all chain link fencing, site fencing, security fencing, decorative metal security fencing, gates, chain link overhead security barriers and barbed tape including all chain link fence fabric fence framing, tension wire, barbed wire, grout, concrete, fence grounding, fittings, and hardware complete.
 - 2. Provide all security bollards including all concrete & excavation work.
- E. Division 6 Wood, Plastics, and Composites
 - 1. Provide all building expansion joints. (Roof expansion joints will be provided and installed by the roofing Contractor.)
 - 2. Provide all treated or untreated wood blocking and / or sheathing at the roof areas, or building openings (roof hatches, skylights, parapets, top edge of existing precast, blocking at existing precast to new construction interface, expansion joints, windows, doors, etc.) Coordinate blocking dimensions with Roofing or any other contractor for proper depth and anchorage requirements, at interface points.
 - 3. Provide all locker bases and any partition blocking, which is required or indicated for the lockers.
 - 4. Contractor shall furnish all fasteners, anchors, and miscellaneous accessories which are required for the complete installation of the work of this scope. (This includes anchor bolts, which are embedded in masonry bond beams)
 - 5. This contractor shall provide all exterior wall insulation. This shall include, but not limited to, all ridged board insulation, batt insulation, foam spray insulation, etc.
 - 6. Provide and install all interior trim, shelving (including wire shelving if indicated), clothes rods, prefinished hardware, etc. including blocking, anchors, adhesives, joint sealants, putty, and any accessories indicated and / or required for a complete installation.
 - 7. Provide blocking and sheathing, required in detention areas, at all locations indicated or required (ie. Example "Padded" cell details)
 - 8. Provide all access flooring. Provide all cutouts for grilles, equipment and furniture that may be required.
 - 9. Access panels required by other Bid Package scopes of work, will be materially provided by those contractors. Access panels which are required, but not included in other bid packages, will be materially provided by this bid package contractor. This Bid Package Contractor is responsible for the complete installation of all access panels, throughout the entire project.
- F. Division 7 Thermal and Moisture Protection
 - 1. All sealants including but not limited to the following:
 - a) Masonry control joints (provide security sealant in applicable areas)
 - b) Casework and millwork including countertops, backsplashes and trims to themselves or dissimilar materials.
 - c) Door frames (walls and floor)
 - d) Louvers
 - e) Storefront
 - f) Expansion joints and Control joints
 - g) Site concrete walks and paving
 - h) Plumbing fixtures
 - 2) All security joint sealants including but not limited to the following:
 - a) Security frames
 - b) Concrete slab to any adjacent surface

- c) Security ceiling perimeter to any adjacent surface
- d) Wall partition to any adjacent surface
- e) Prefabricated cells
- f) Security equipment & furnishings
- 3) Provide and install all thermal / sound insulation:
 - a) Prior to installation of sealants and security joint sealants at all masonry partitions. (ie. Top edge of CMU to decking, control / expansion joints, etc.),
 - b) At existing precast panel to new building construction joints, including "building wrap" material
- G. Division 8 Openings
 - 1. Provide all non-detention hollow metal doors and frames including all anchors, glazing, hardware, and accessories. Any frames not on site in time for masonry will be left open and this category will pay mason's premium to tooth-in frame. Bid Package 3 Masonry will grout frames.
 - 2. Security doors and frames will be furnished to the site by Bid Package 7 Detention Equipment.
 - 3. Provide all flush wood doors complete where indicated including all glazing and accessories.
 - 4. Include all hoisting and transportation for the delivery and installation of doors, frames, and hardware.
 - 5. Contractor shall install all hollow metal frames under this scope. Care should be taken to ensure that frames are installed in a true, level, square and plumb fashion. This Contractor shall remove hollow metal frame spreaders.
 - 6. Contractor shall be responsible for protection of all hardware and wood doors until installed and accepted by the Construction Manager. Removal of shipping protection materials and depositing in the job site dumpsters is included in this scope of work.
 - 7. This bid package is to receive, unload, inspect, and installation.
 - 8. This bid package will install all detention doors, frames, tear gas ports, chase doors and security access doors furnished by Bid Package 7 Detention Equipment.
 - 9. The General Trades contractor will be required to Bondo over grout holes where required to grout frames under steel framing.
 - 10. Provide and install all Aluminum Framed Entrances and Storefront, Aluminum Curtain Walls. All labor, material, equipment, supervision, and services required to provide complete and operational units is included in this scope of work.
 - 11. Provide temporary protection of entire assembly of windows, doors, and storefronts (frames, glazing and doors)
 - 12. Installation of security glazing located in doors and/or frames not supplied by Bid Package 7 - Detention Equipment.
 - 13. This Contractor shall remove all dirt, grease, stickers, glue, and markings when directed by the CM prior to turnover.
 - 14. Provide all overhead coiling doors and associated components.
- H. Division 10 Specialties
 - 1. Provide all miscellaneous specialties, including, but not limited to visual display units, interior signage, lettering, toilet compartments, urinal screens, and toilet accessories, welding curtains, fire extinguishers, lockers, evidence lockers, wall protection (including stainless splash shield at mop basins), shelving, mobile storage shelving, lockbox, canopies, and

flagpoles, unless indicated in the project documents as "by owner". Scope of work will include all fasteners, adhesives, blocking, etc., which are required to provide a complete installation.

- 2. Provide exterior site signage, directional signage, ADA signage, traffic signage.
- 3. Install detention toilet and bath accessories where embedded in masonry. Detention equipment is furnished by Bid Package 7 Detention Equipment.
- I. Division 11 Equipment
 - 1. Unload, store, and distribute Bid Package 7 Detention Equipment furnished only items.
 - 2. Welding of large, spliced frames shall be included in this scope.
 - 3. Provide all package transfer units, gun lockers, and inmate property packaging equipment. Include anchorage devices and fasteners for complete installation.
- J. Division 12 Furnishings
 - Provide all manufactured laminate casework, solid surface materials, stainless steel cabinets & countertops, sills, backsplashes, end splashes, wall caps, undercounter knee protection, countertops, and closet and utility shelving as indicated and required including blocking, shims, stud framing, mounting hardware, countertop support brackets, and accessories. Protect all casework and countertops, using cardboard protection, after installation and remove protection at project completion.
 - a. Grommets in countertops to be located in the field and installed by this contractor following Owner equipment move-in.
 - b. Cutting of counters for plumbing fixtures provided by Bid Package 9 Mechanical & Plumbing
 - 2. Provide all window coverings.
 - K. Division 13 Metal Building Systems
- 1. Provide / install sub framing, which is required for installation of metal panel siding system, at each and every location indicated or required.
- 2. Provide / install rigid insulation indicated at sub-framing assembly location, prior to installation of metal building insulation.
- Provide / install metal panel siding system complete to the reglet, which is provided by BP #05

END BID CATEGORY BP NO. 1 GENERAL TRADES SCOPE OF WORK

BID CATEGORY BP NO. 6 INTERIOR WALL SYSTEM:METAL STUDS, DRYWALL, PAINTING &ACOUSTICAL CEILINGS SCOPE OF WORKADDENDUM #04

This Scope of Work is to include, but is not limited to, the following Specification Sections:

<u>Section</u>	Description
Division 00	Procurement and Contracting Requirements
Division 01	General Requirements
05 40 00	COLD-FORMED METAL FRAMING
06 10 53	WOOD BLOCKING AND CURBING
07 21 00	THERMAL INSULATION (AT FRAMING)
08 31 13	ACCESS DOORS AND PANELS (INSTALLATION)
09 01 00	MAINTENANCE OF FINISHES
09 22 16	NON-STRUCTURAL METAL FRAMING
09 29 00	GYPSUM BOARD
09 51 23	ACOUSTICAL PANEL CEILINGS (SCL-1 CEILINGS BY BID PACKAGE NO. 7)
09 91 13	EXTERIOR PAINTING
09 91 23	INTERIOR PAINTING
09 96 00	HIGH PERFORMANCE COATINGS

This Bid Package Scope of Work describes and assigns Work to this Bid Package as designated by the Construction Manager. Each Contractor shall cooperate and coordinate with all other Bid Package Contractors for proper and expedient completion of the Work in this Project. This summary should in no way be construed as being all inclusive. It is issued as a guide to aid in the assignment of Work and is intended to clarify and/or further define the Scope of Work included in the Bid Documents. They shall not be construed as the entire Scope of Work for this Bid Package. All work described or indicated in the respective Specifications Sections or Divisions listed above shall be included, except as specifically excluded herein.


A. General Items

- Contractor shall include a \$30,000 allowance to be used at the discretion of the Construction Manager. Unused portions of this allowance shall be returned to the Owner via deductive change order.
- 2. Floors shall be scraped clean of drywall mud daily.
- 3. Contractor shall protect storefront, hollow metal work, aluminum work, glass etc. as required to prevent damage by Contractor's work.
- 4. Coordinate penetrations in drywall with appropriate trades.
- 5. Contractor will not be allowed to clean tools and equipment in permanent plumbing fixtures.
- 6. Remobilizations will be expected at no additional cost to the owner.
- 7. Site and Building Access will be provided for installation of this scope of work. These locations are indicated in Specification 01 32 00 Schedules and Reports.
- B. Division 5 Metals

- 1. Install miscellaneous angles at top of metal framed walls furnished by Bid Package No. 4 Structural & Miscellaneous Steel.
- 2. Costs for delegated design, if required for light gage metal framing, is the responsibility of this contractor, with all costs included in bid.
- C. Division 6 Wood, Plastics, and Composites
 - 1. Contractor shall provide and install all blocking, bracing and/or backing required to adequately support all wall hung fixtures and equipment (cabinets, lab casework, furniture, toilet accessories, tack boards, handrails, fire extinguisher cabinets, electronic devices, etc.) specified on the contract documents. Coordinate blocking, sheathing, and backing work with all other contractors.
 - 2. Contractor shall provide all blocking at openings, and roof perimeter.
 - 3. Contractor shall provide nail base, furring, and rigid insulation as all locations indicated.
 - 4. Provide interior wood blocking with in metal or cold-formed steel assemblies or partitions as indicated or required, for anchorage of the partition, equipment, accessories, etc.
 - 5. All drywall is to be finished to the floor to allow for the proper installation of base.
- D. Division 7 Thermal Insulation
 - 1. Provide all insulation as noted on the construction documents, which is included with any metal stud framing assembly. This includes fire safing, mineral wool, thermal or sound insulation at termination of a partition to overhead or adjacent assemblies.
 - 2. Provide / install rigid insulation at sub-framing location, prior to installation of metal siding panels.
 - 3. Provide and install break metal trim, which is indicated at partition termination to overhead structure or other assemblies.
 - 4. Contractor shall provide all acoustical sealants required.
- E. Division 9 Finishes
 - Coordinate with Electrical, Plumbing, Mechanical, and Fire Protection Bid Packages, the location
 of, the suspension reinforcement for, skylights & associated ducting, fixtures and/or mechanical
 grilles, etc. to coordinate with the ceiling suspension pattern. Provide additional ceiling supports
 and cut outs where necessary to support light fixtures, speakers, and other ceiling mounted
 equipment.
 - 2. Contractor shall cut and install all ceiling tile required, except for the fire sprinkler tile.
 - 3. Install domed security mirrors furnished by Bid Package 7 Detention Equipment Contractor.
 - 4. Finish exterior doors on tops, bottoms, and side edges same as exterior faces.
 - 5. Paint backsides of access panels, removable and hinged covers to match exposed surfaces.
 - 6. Paint all cell module fronts and both sides of each cell door.
 - 7. Paint mezzanine level support steel, hand-railing, stairs, stair stringers, metal bulkheads, metal cover plates, security woven rod, mesh, and screens. etc. The open grating of mezzanines and the open grate stair treads will remain galvanized and not painted.
 - 8. Touch up primer on factory or shop primed metal surfaces required for application of finish painting.
 - 9. The Contractor will clean adjacent surfaces that receive over spray.
 - 10. Contractor shall be responsible for painting mechanical and electrical work exposed to view in interior occupied spaces and exterior walls and roof.

11. The Masonry Contractor will inspect all masonry walls after prime painting for surface defects. Re-priming and/or subsequent patchwork if required shall be performed prior to finish painting at no additional cost to the owner.

END BID CATEGORY BP NO. 6 METAL STUDS, DRYWALL, PAINTING & ACOUSTICAL CEILINGS SCOPE OF WORK

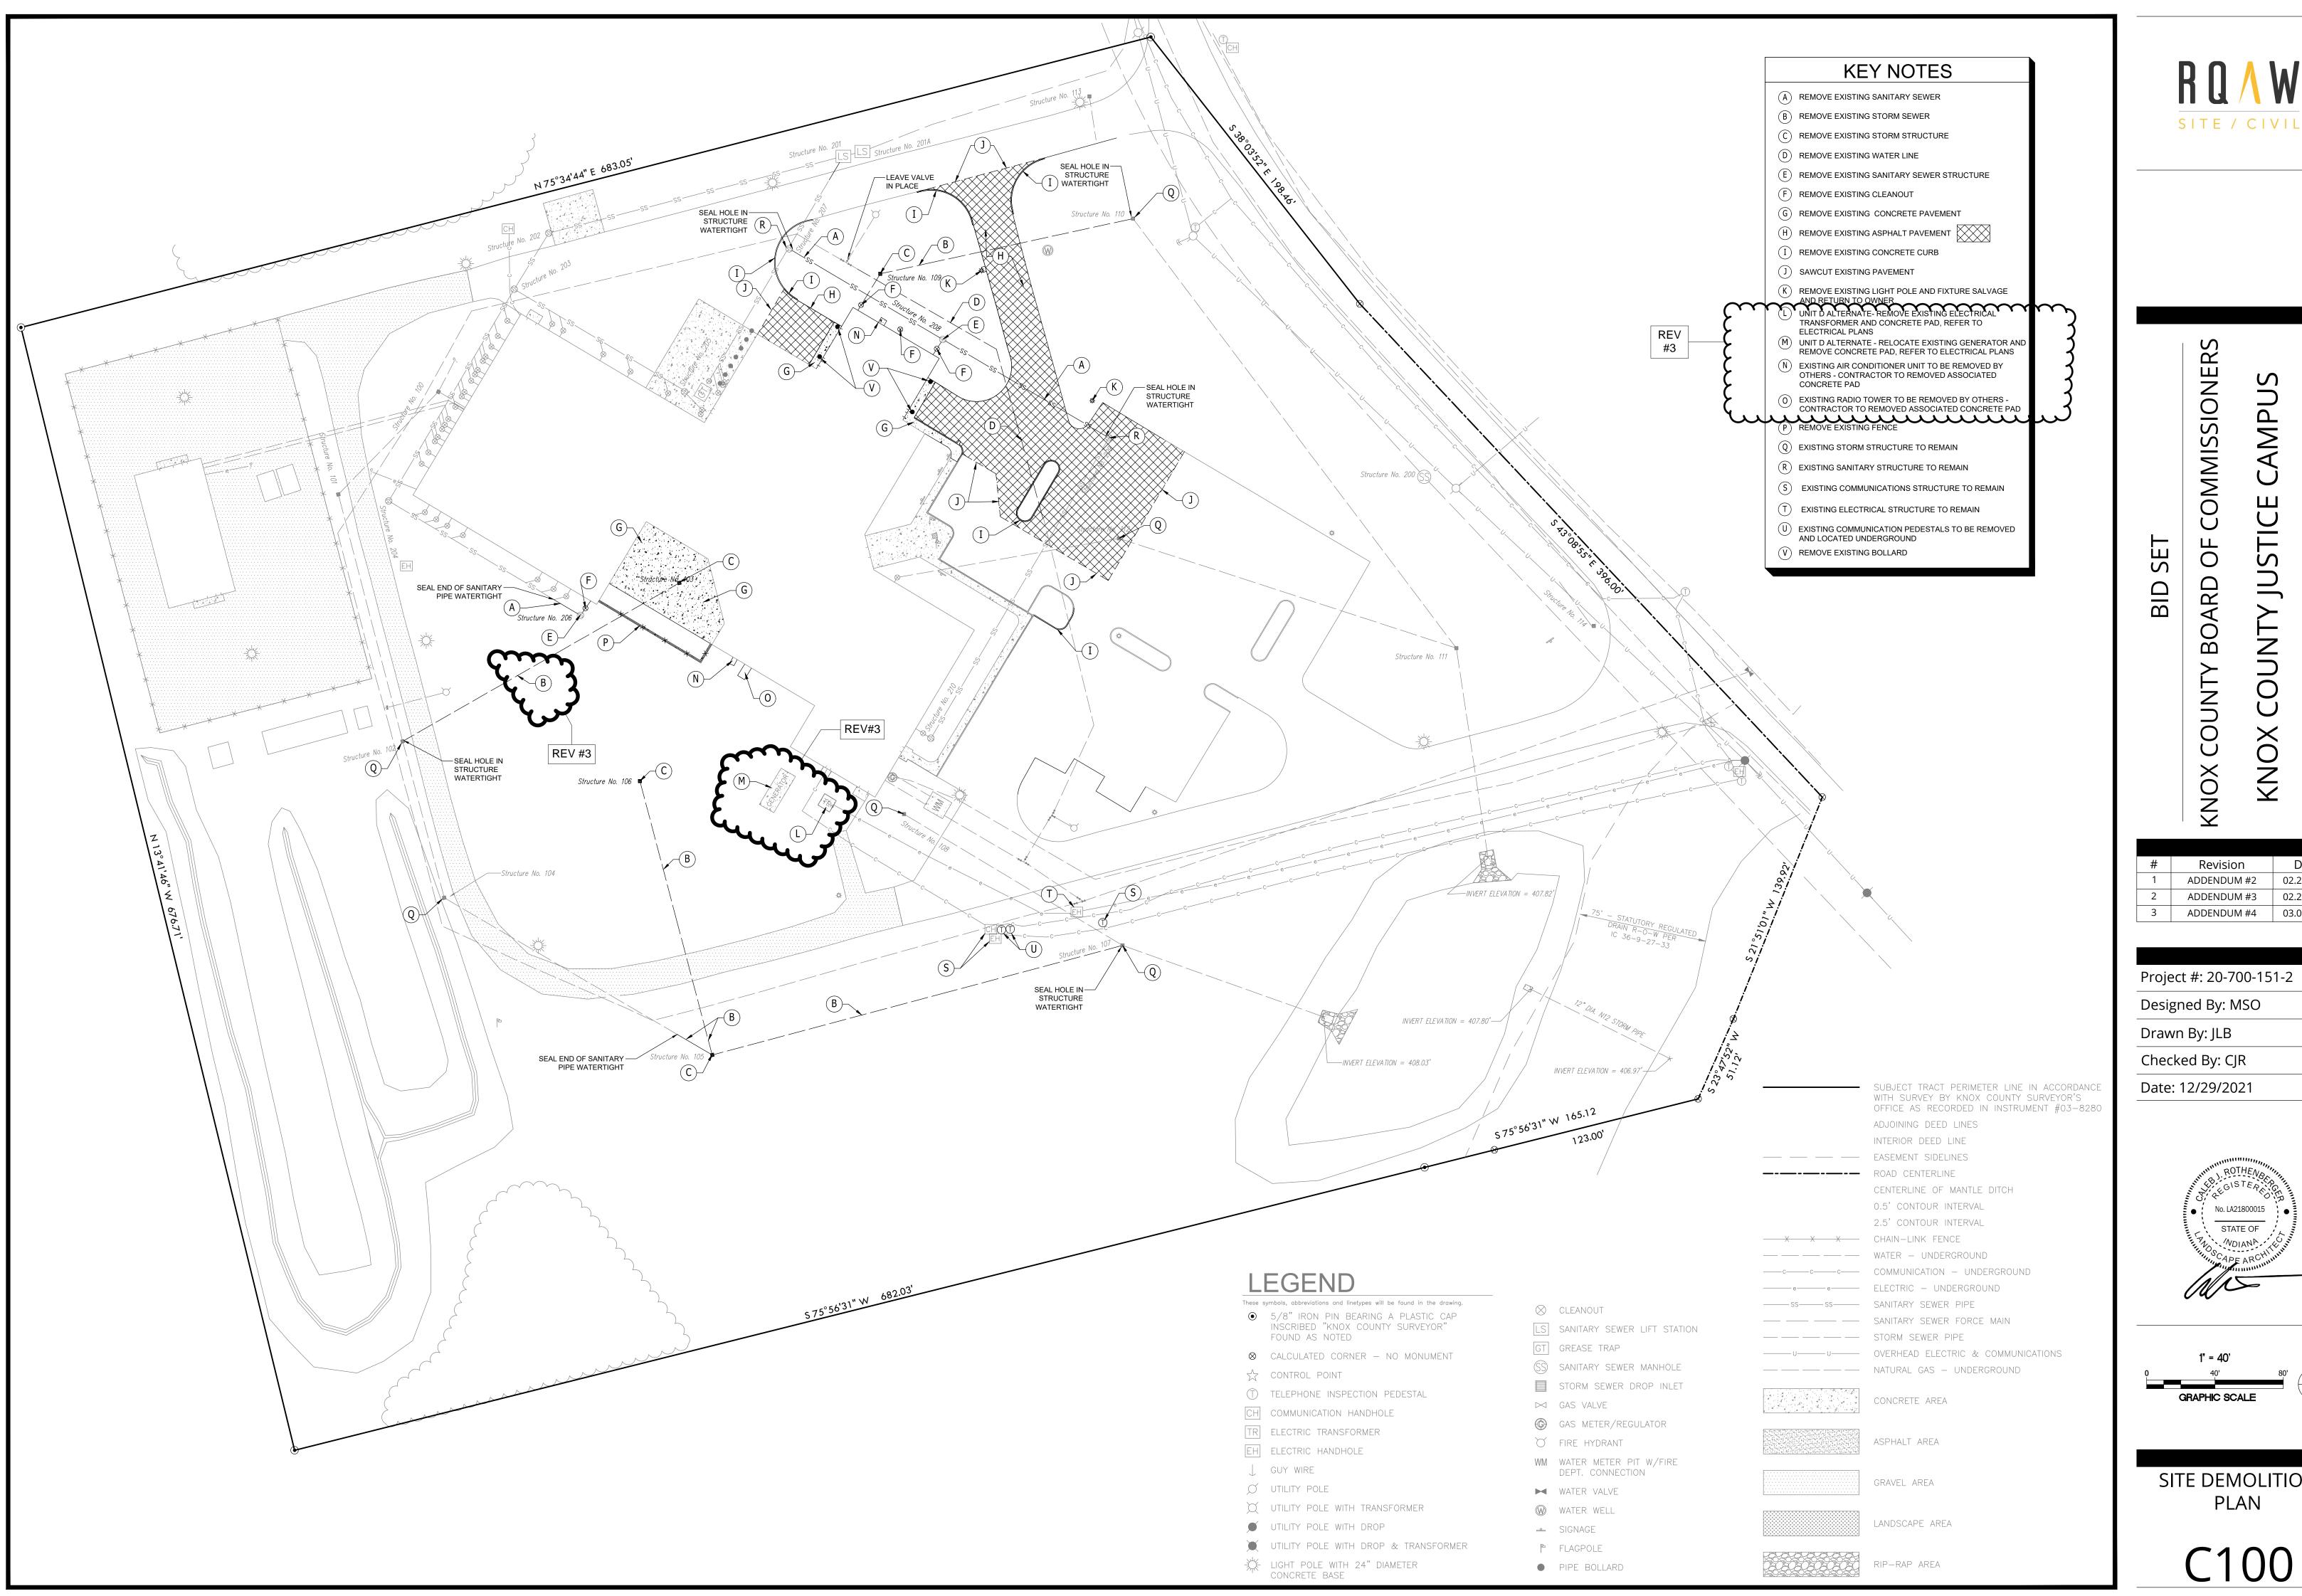







Revision	Date
ADDENDUM #2	02.21.2022
ADDENDUM #3	02.28.2022
ADDENDUM #4	03.07.2022
	ADDENDUM #2 ADDENDUM #3

SITE DEMOLITION

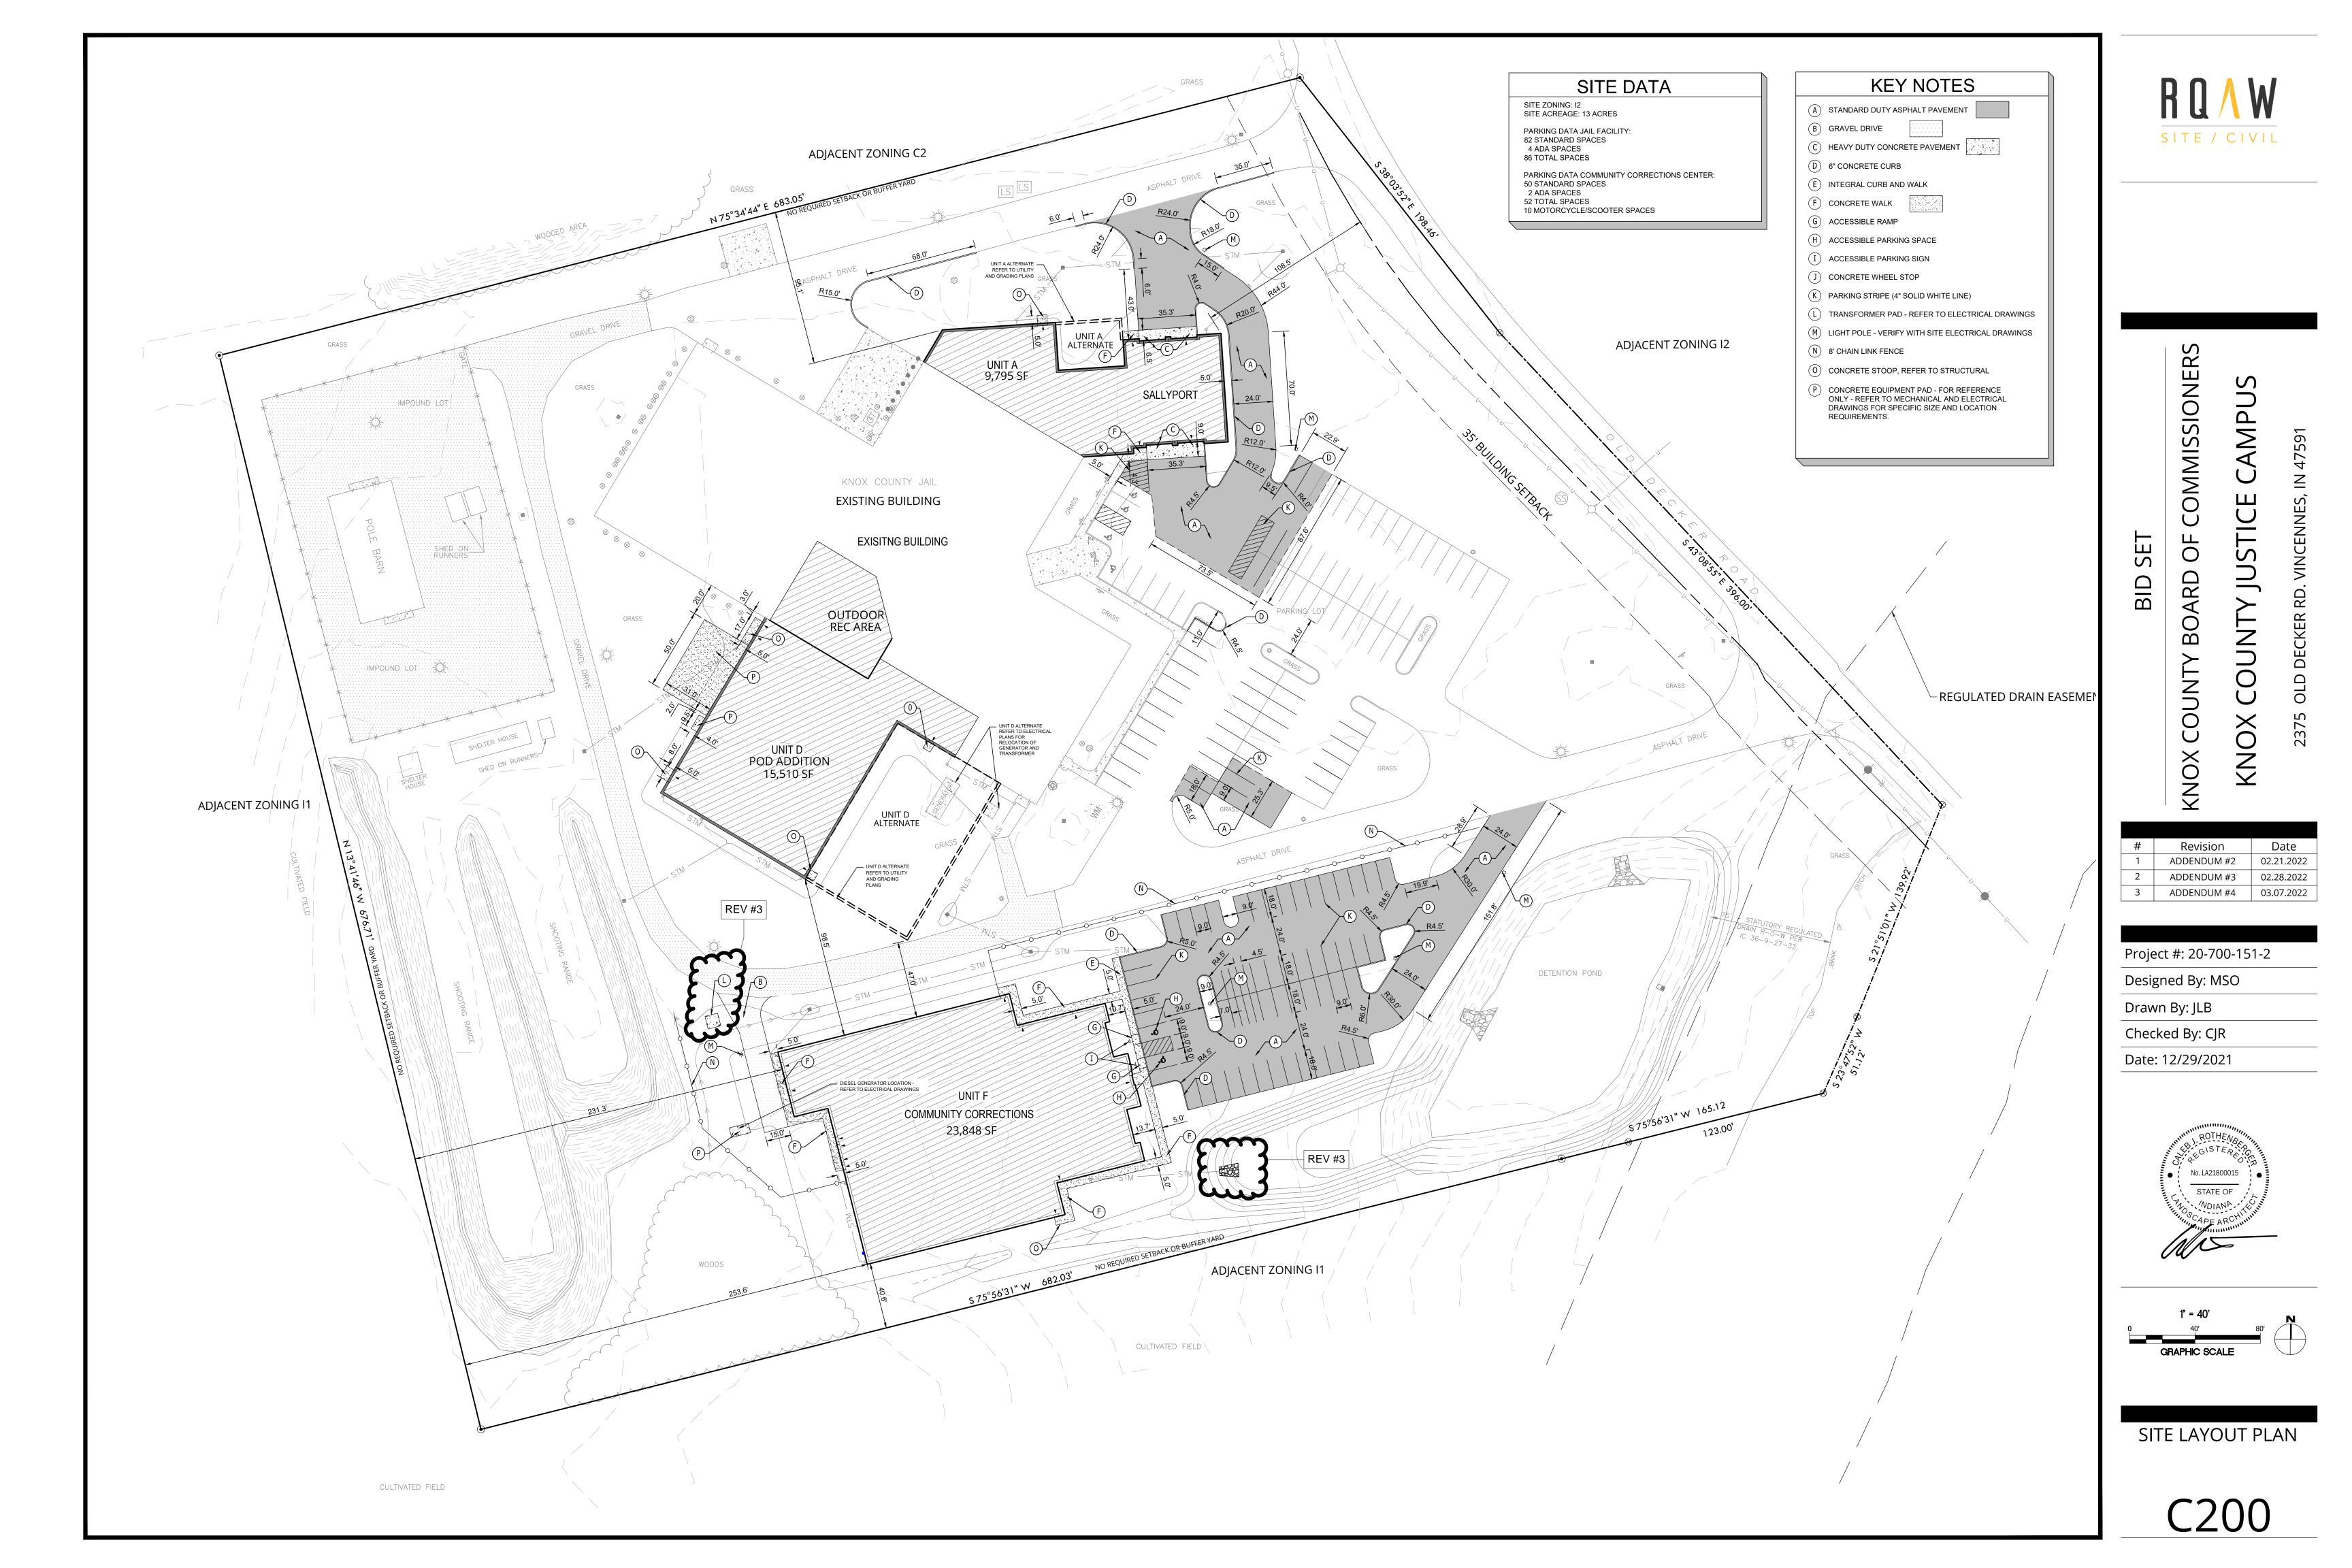

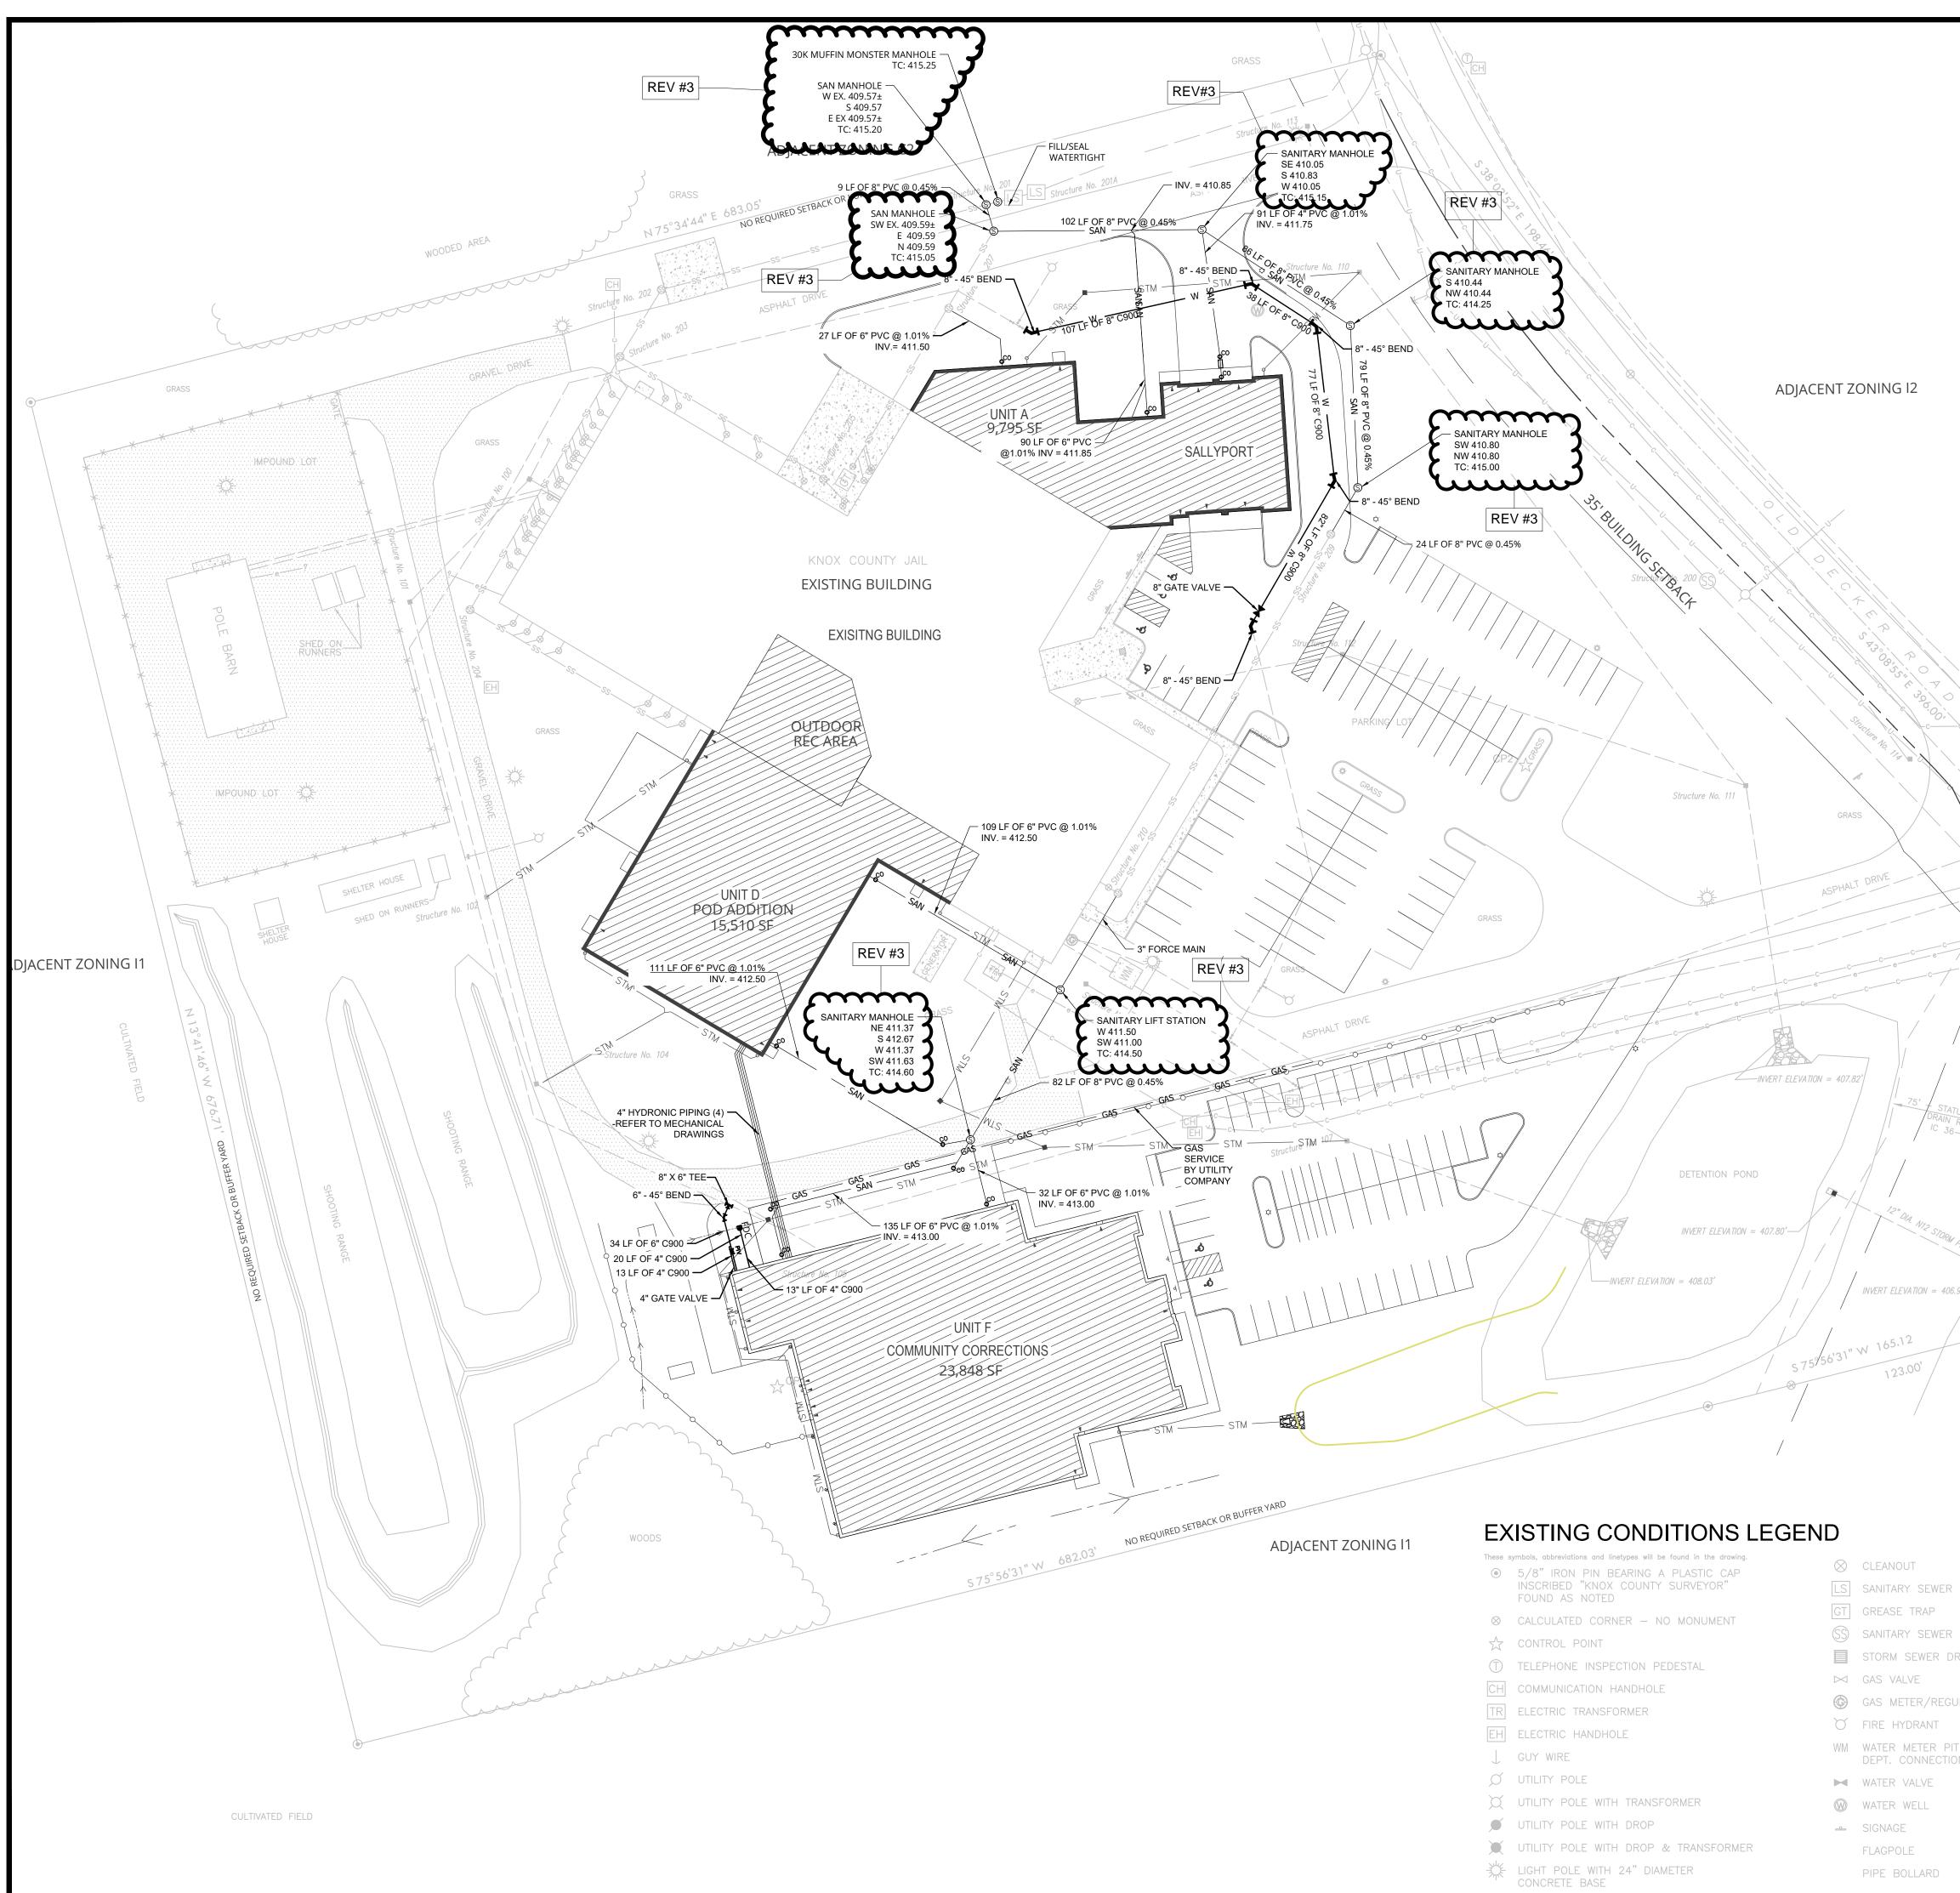

	STM STM	PROPOSED STORM SEWER REFER TO SHEET C400-C401 PROPOSED SANITARY SEWER	RQ/W SITE/CIVIL
o ^{cc} S	W GAS GAS GAS GAS GAS PROPOSED STORM INLET PROPOSED CLEANOUT PROPOSED SANITARY MANHO	PROPOSED WATER VALVE	
BANK	521		Project #: 20-700-151-2 Designed By: MSO
			Drawn By: JLB
6.97' × 5		SUBJECT TRACT PERIMETER LINE IN ACCORDANCE WITH SURVEY BY KNOX COUNTY SURVEYOR'S OFFICE AS RECORDED IN INSTRUMENT #03-8280 ADJOINING DEED LINES INTERIOR DEED LINE EASEMENT SIDELINES	Checked By: CJR Date: 12/29/2021
R LIFT STATION	X X X	ROAD CENTERLINE CENTERLINE OF MANTLE DITCH 0.5' CONTOUR INTERVAL 2.5' CONTOUR INTERVAL CHAIN—LINK FENCE WATER — UNDERGROUND COMMUNICATION — UNDERGROUND ELECTRIC — UNDERGROUND SANITARY SEWER PIPE SANITARY SEWER FORCE MAIN	NO. PE11500269 STATE OF NOIANIA Micholos Bign Vigatoz
MANHOLE	UU	STORM SEWER PIPE OVERHEAD ELECTRIC & COMMUNICATIONS NATURAL GAS – UNDERGROUND	1" = 40' 0 40' 80'
DROP INLET		CONCRETE AREA	GRAPHIC SCALE
		ASPHALT AREA	
IT W/FIRE ON		GRAVEL AREA	SITE UTILITY PLAN
		LANDSCAPE AREA	
		RIP-RAP AREA	C300

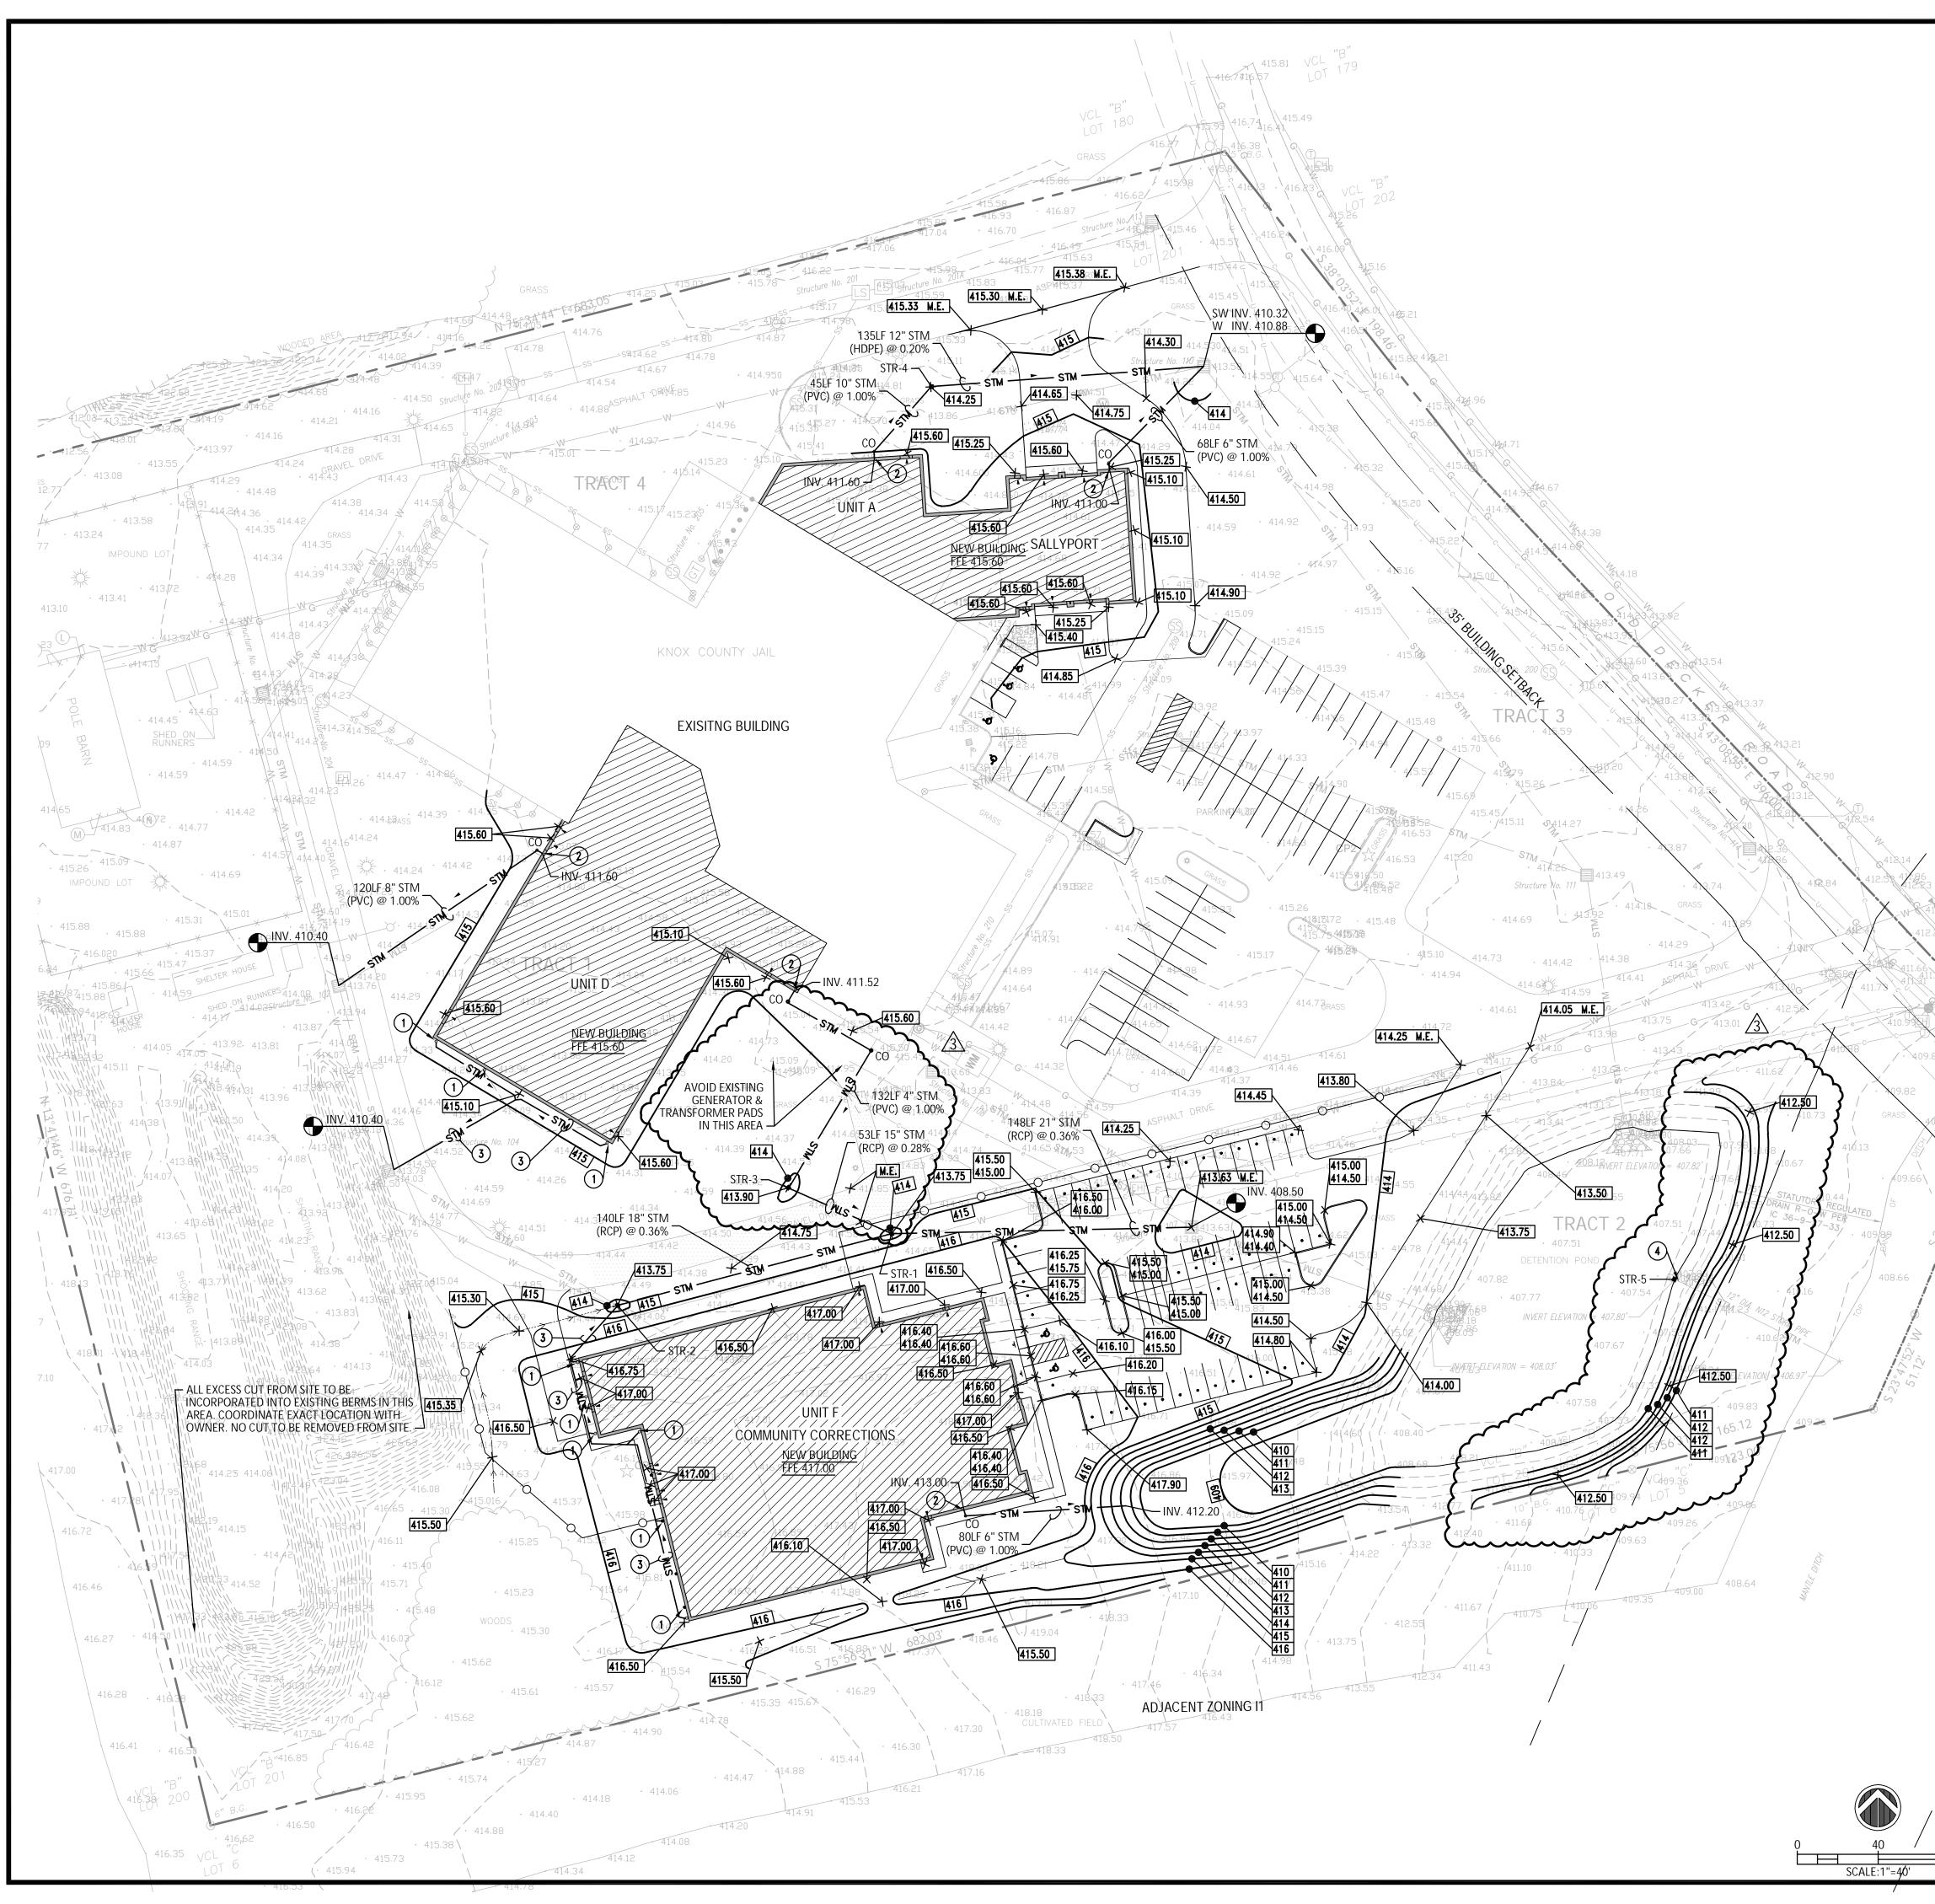

S Consulting Engineers - K:\Civil Projects\21JPSC46 Knox County Jail\Drawings\C400.dwg March 8, 2022 - 4:59 PM Nvergatos

STRUCTURE SCHEDULE

		INVE	RT	CAS.	TING	STRUC	TURE
	MARK	INLET	OUTLET	ELEVATION	TYPE	TYPE	DETAIL
	STR-1	409.00 W 409.00 NW	409.00	413.75	R2554	INLET	C602
	STR-2	409.50± NW 411.50 SW	409.50	413.75	R2554	INLET	C602
	STR-3	410.20	409.15	413.90	R2554	INLET	C602
3	STR-4	411.15	411.15	414.25	R2554	INLET	C602
<u> </u>	STR-5	-	EX. 407.80	409.50	R2554	OUTLET CONTROL STRUCTURE	C602
	EXISTING 107	-		413.63	R3405	INLET	C602



GENERAL NOTES

- A. THE CONTRACTOR SHALL BE RESPONSIBLE FOR OBTAINING, AND VERIFYING, THAT ALL PERMITS AND APPROVALS ARE OBTAINED FROM THE RESPECTIVE CITY, COUNTY, STATE AND FEDERAL AGENCIES PRIOR TO STARTING CONSTRUCTION.
- B. CONTRACTOR SHALL VERIFY LOCATION AND INVERT ELEVATIONS OF EXISTING SEWERS PRIOR TO START OF CONSTRUCTION.
- C. CONTRACTOR SHALL MAINTAIN A COMPLETE AND OPERABLE UTILITY SYSTEM AT ALL TIMES.
- D. CONTRACTOR SHALL INCLUDE COSTS FOR CUTTING AND PATCHING AS REQUIRED IN THEIR BID PROPOSAL TO COMPLETELY INSTALL THE WORK INDICATED.
- E. INFORMATION SHOWN WAS OBTAINED FROM AN OWNER FURNISHED SITE SURVEY OF EXISTING CONDITIONS AND IS UNCONFIRMED. CONTRACTOR IS REQUIRED TO FIELD VERIFY THIS INFORMATION AND NOTIFY ARCHITECT OF ANY DISCREPANCIES SO MODIFICATION CAN BE MADE.
- F. CONTRACTOR SHALL COORDINATE EXACT UTILITY LOCATIONS WITH THE OWNER AND LOCAL UTILITY COMPANIES PRIOR TO COMMENCING ANY WORK. UTILIZE THE INDIANA UNDERGROUND UTILITY LOCATION SERVICE AT 811 OR 800-382-5544 PRIOR TO ANY EXCAVATION ON THE SITE.
- G. ALL EXCESS EARTHWORK CUT FROM SITE TO BE DEPOSITED AND INCORPORATED INTO EXISTING BERMS ON SITE. NO EXCESS EARTHWORK TO BE HAULED OFF SITE. COORDINATE EXACT LOCATION WITH OWNER. REFER TO PLAN FOR LOCATION OF BERMS.

GENERAL NOTES

- A. REFER TO UTILITY DETAILS FOR NOTE REFERENCES.
- B. ALL CASTINGS SHALL HAVE THE WORDS 'NO DUMPING DRAINS TO STREAM" CAST IN RAISED OR RECESSED LETTERS AT A MINIMUM OF 1" HEIGHT. A SYMBOL OF A FISH SHALL ALSO BE CAST WITH THE LETTERS.
 C. CASTINGS TO BE NEENAH TYPE OR APPROVED EQUAL.
- CONTRACTOR TO VERIFY LOCATIONS AND ELEVATIONS OF EXISTING UTILITIES PRIOR TO THE START OF CONSTRUCTION.


PLAN NOTES

- 1. DOWNSPOUT ADAPTER. REFER TO ARCHITECTURAL PLANS FOR EXACT LOCATION.
- 2. COORDINATE SIZE, LOCATION AND ELEVATION OF PIPING AND CONTINUATION INSIDE BUILDING WITH PLUMBING PLANS.
- 3. 8" HDPE ROOF DRAIN PIPING SYSTEM AT MINIMUM 0.50% SLOPE OR AS NOTED. CONNECT DOWNSPOUTS TO PIPING WHERE INDICATED.
- 4. INSTALL 12" TIDEFLEX CHECK VALVE IN EXISTING 12" STORM PIPE



 $\overline{3}$

Know what's below. Call before you dig.

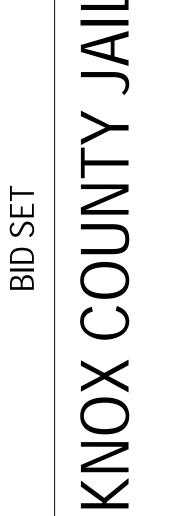



Date

21 FEB 2022

28 FEB 2022

07 MAR 2022

3 ADDENDUM #4

ADDENDUM #2 ADDENDUM #3

Revision

Project #: 20-700-151-2

Designed By: NBV

|


Drawn By: JLB


Checked By: NBV

Date: 01/28/2022




C400

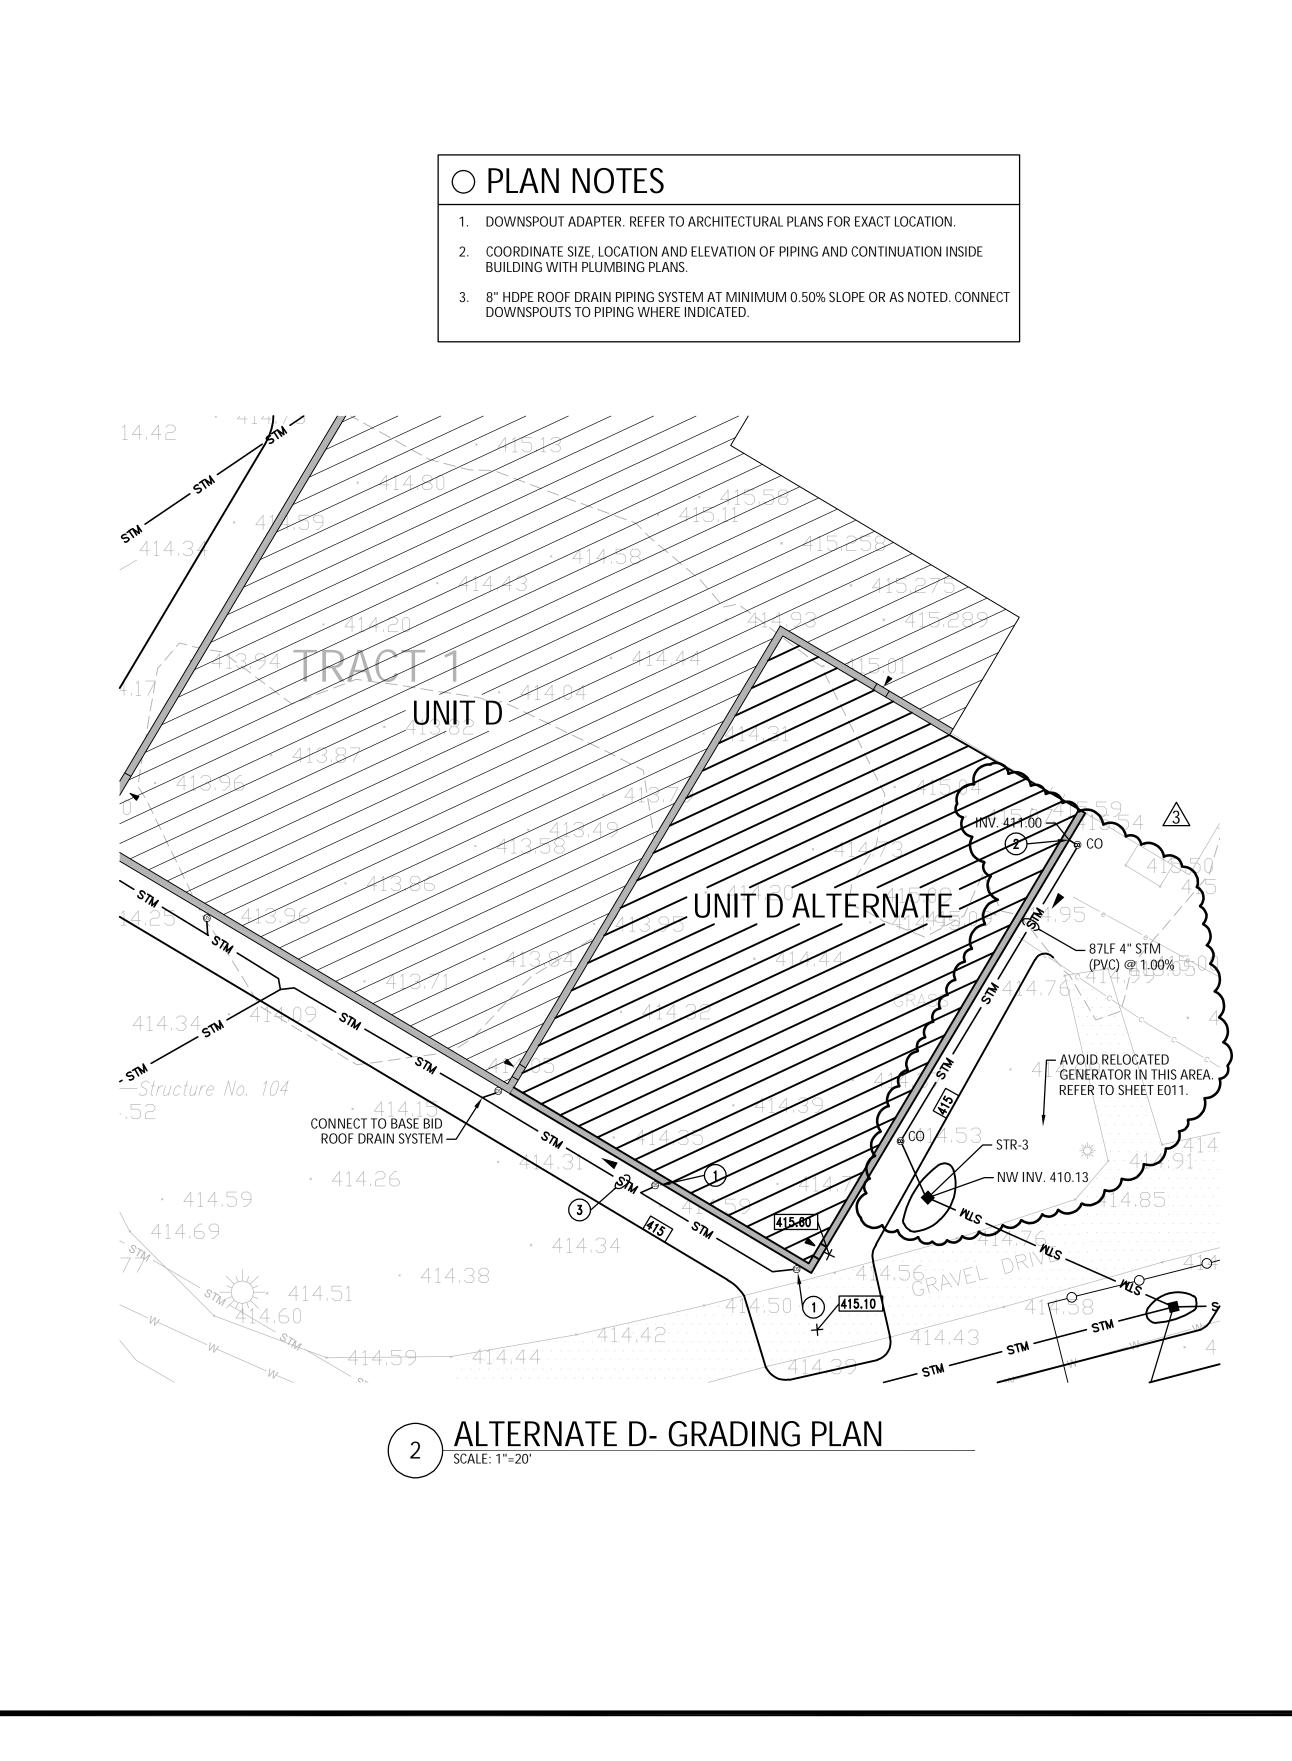

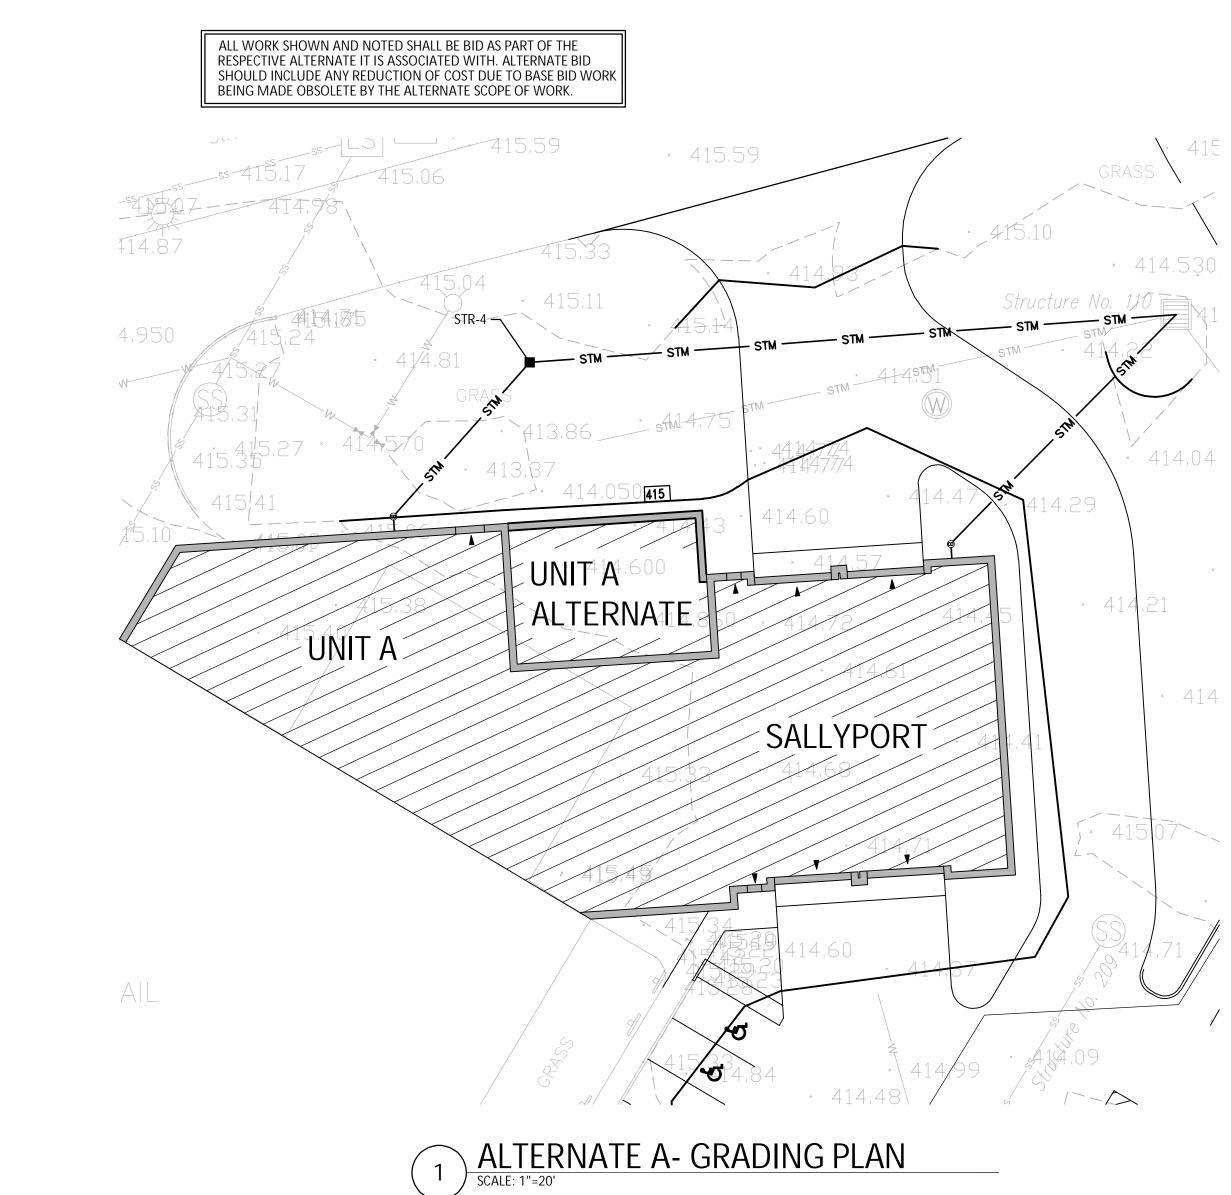




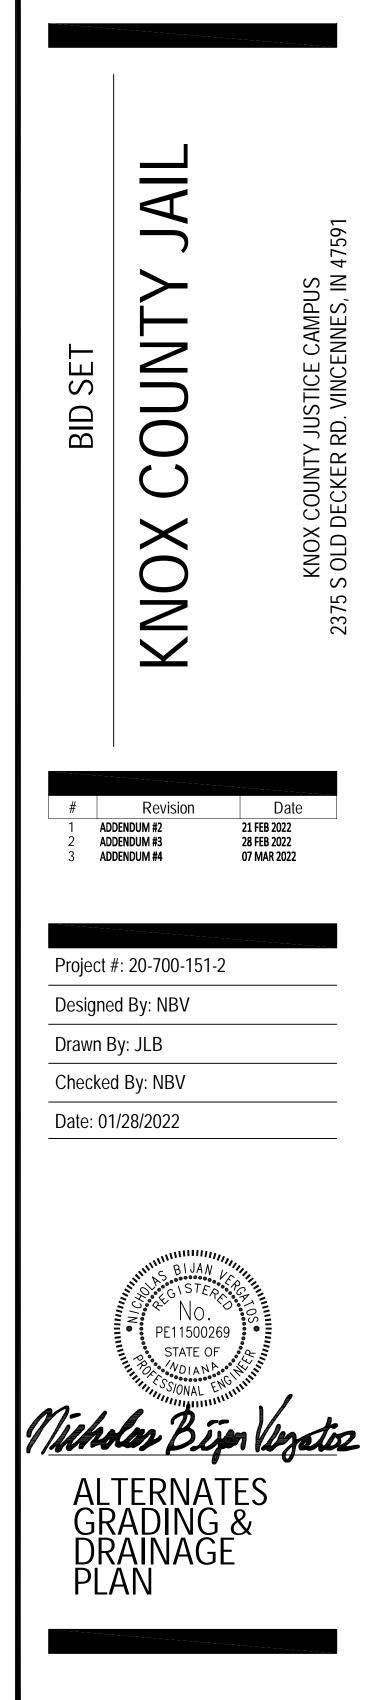


C401



Know what's below. Call before you dig.

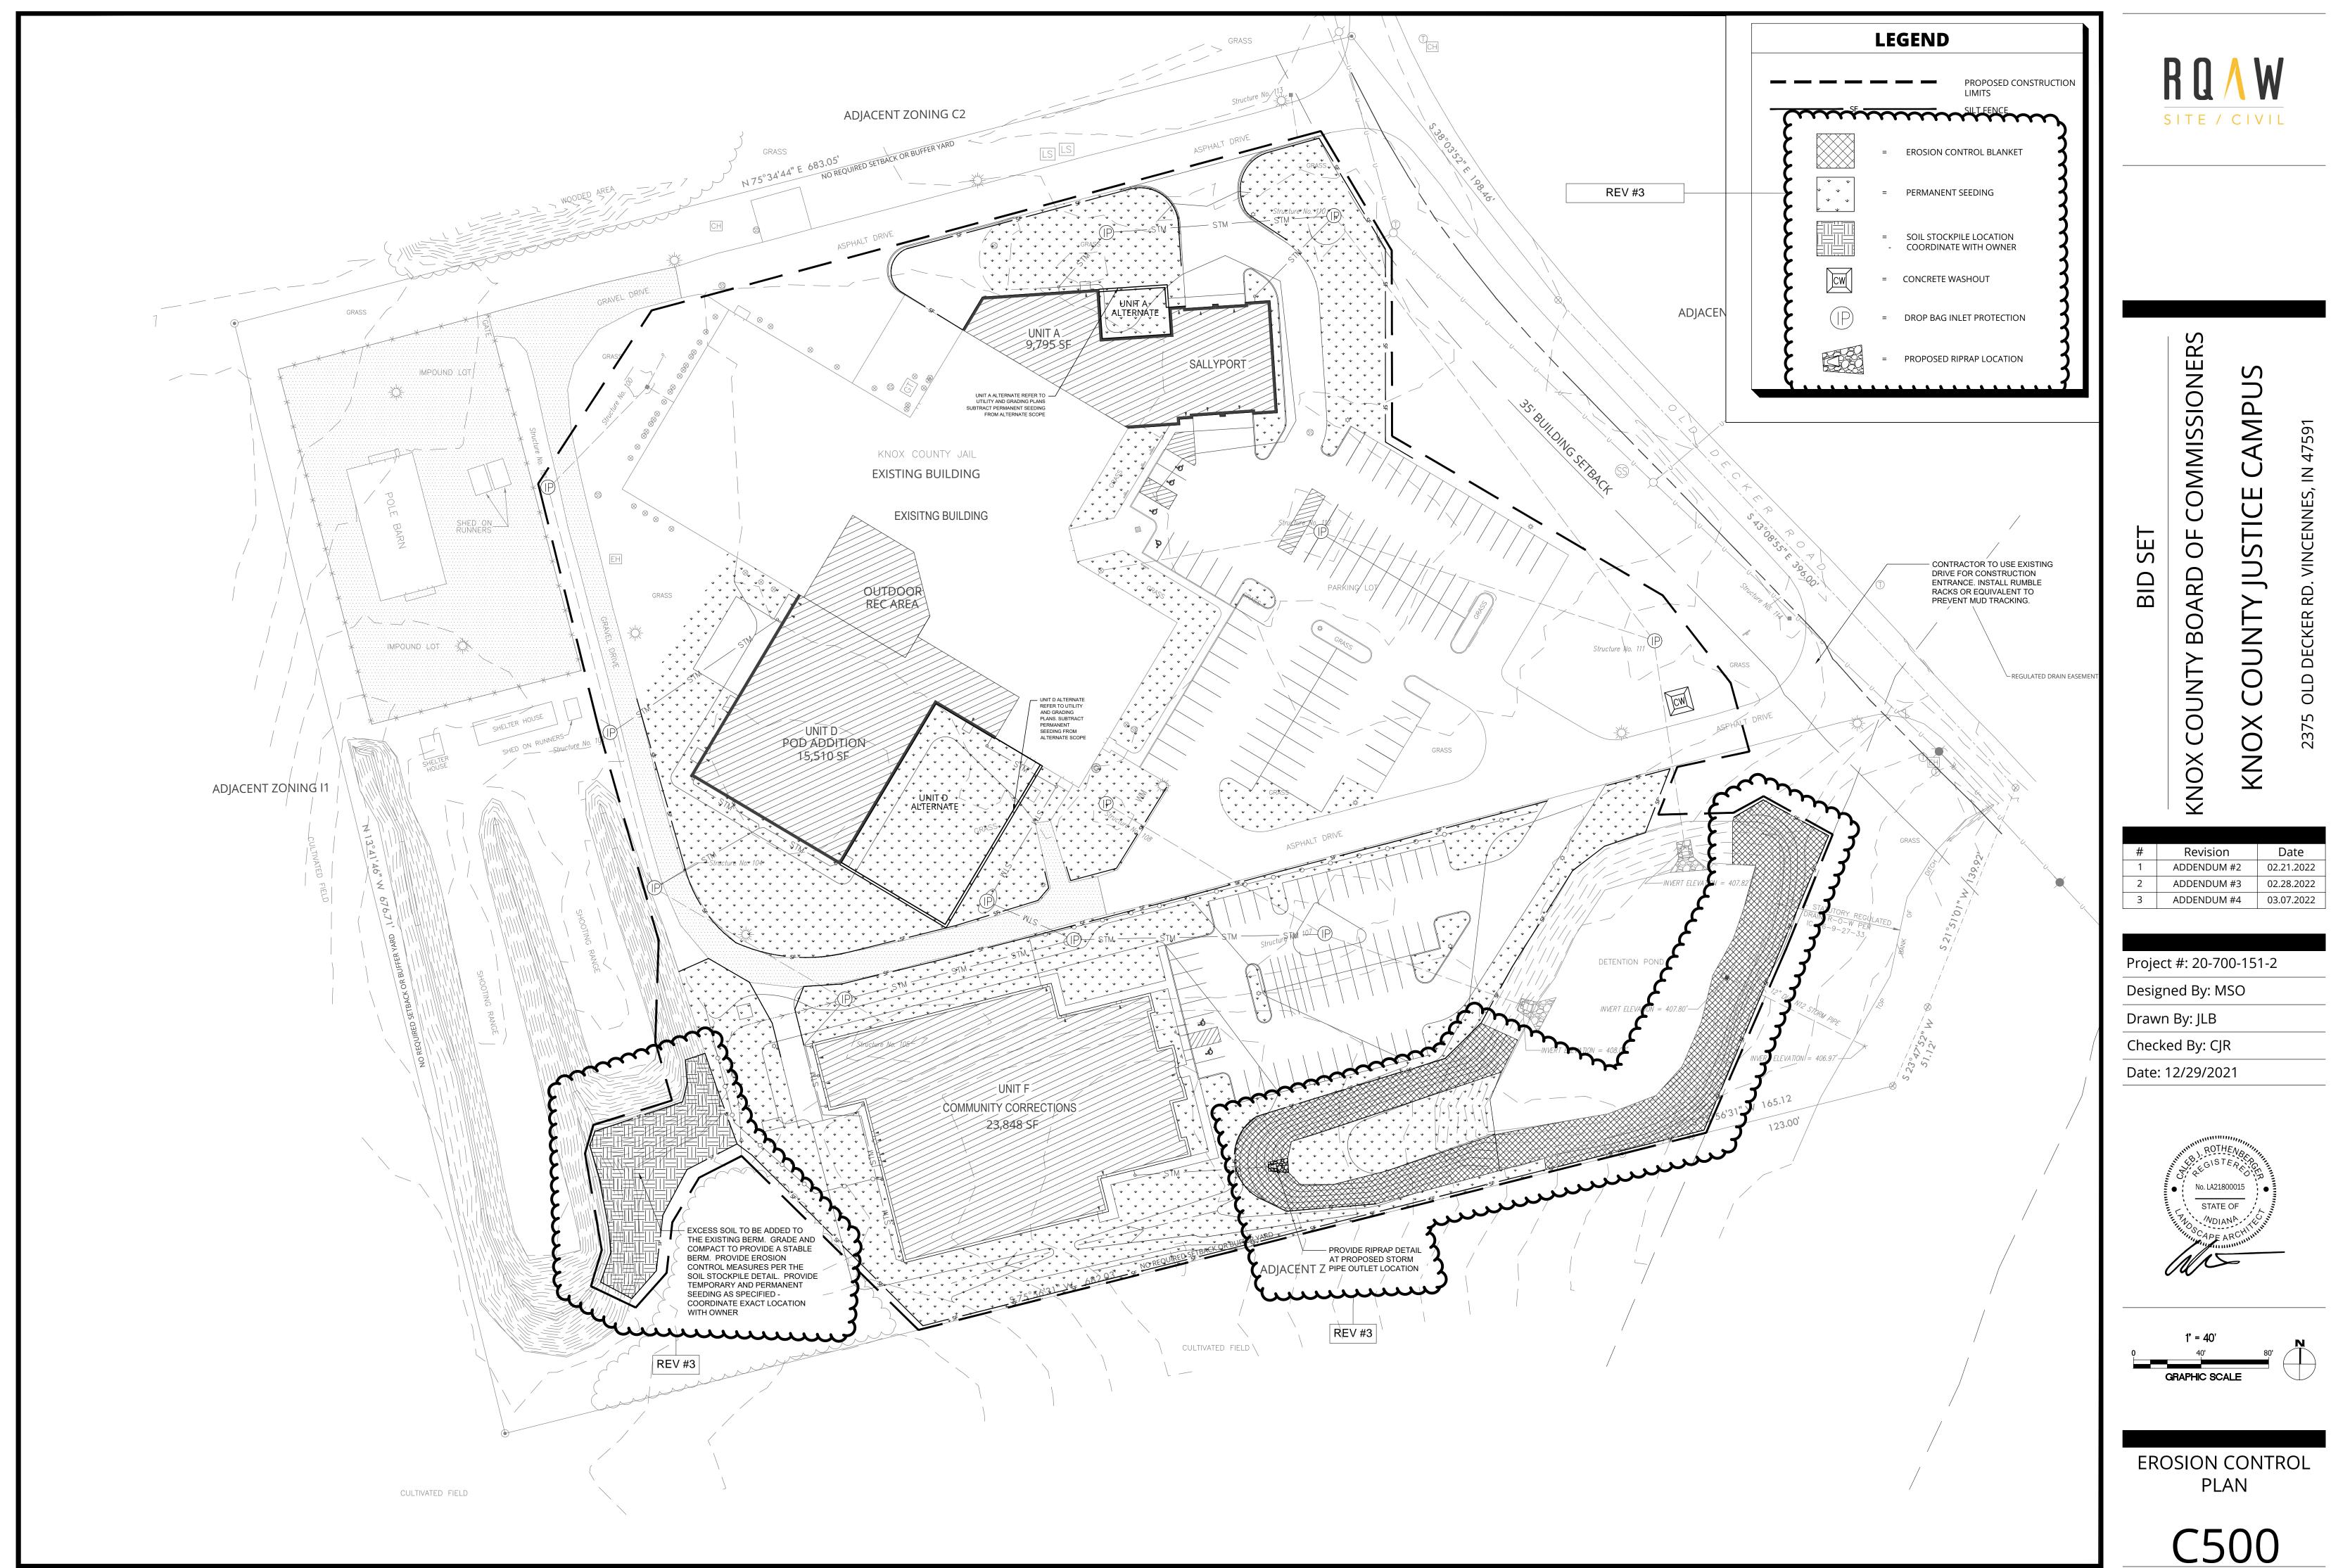



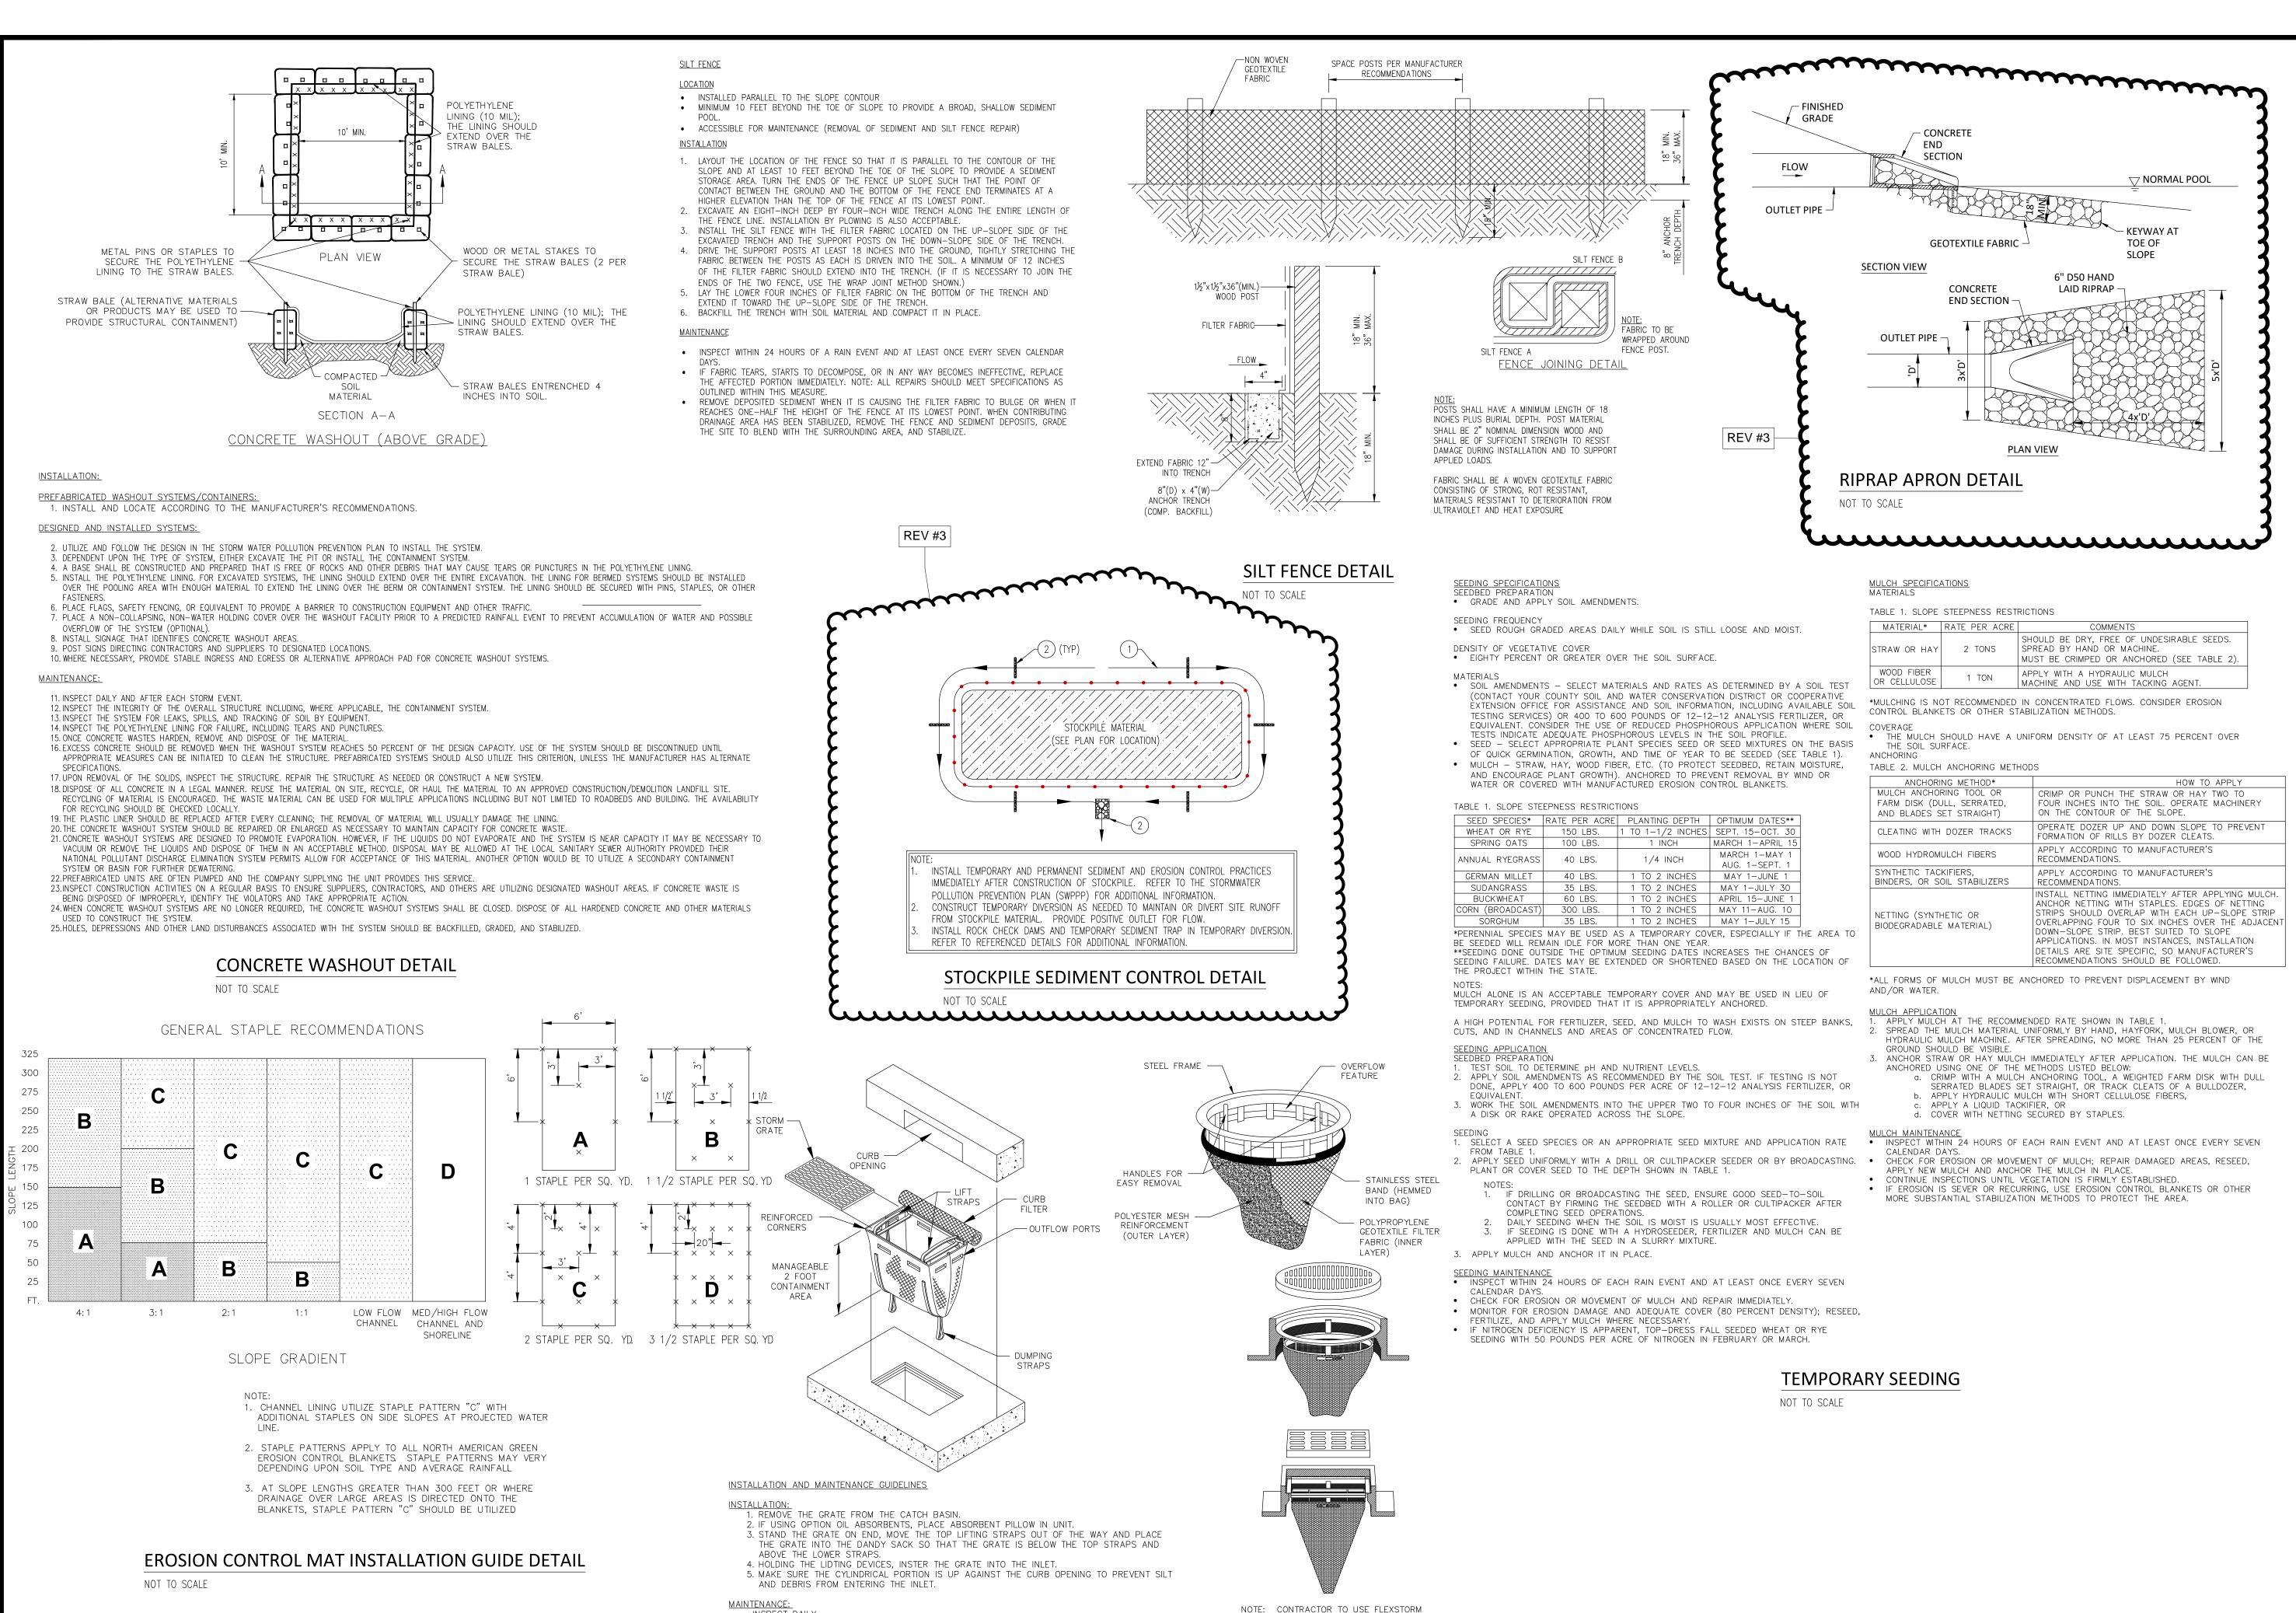



• INSPECT DAILY.


• REMOVE ALL ACCUMULATED SEDIMENT AFTER EACH STORM EVENT. DISPOSE OF SEDIMENT IN AN AREA WHERE IT WILL NOT REENTER THE PAVED AREA OR STORM DRAINS. TO EMPTY UNIT, LIFT THE UNIT OUT OF THE INLET BY USING THE LIFTING STRAPS AND REMOVE THE GRATE. • WHEN CONTRIBUTING DRAINAGE AREA HAD BEEN STABILIZED, REMOVE INLET PROTECTION.

DROP BAG INLET PROTECTION

CATCH-IT INLET PROTECTOR, DANDY BAG

OR APPROVED ALTERNATE.

NOT TO SCALE

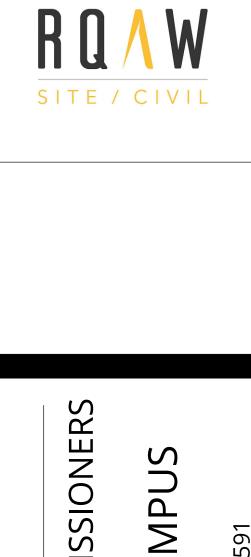

Ζ Ś С ш NZ С \square \square $\mathbf{\mathcal{L}}$ \Box R \mathbf{m} 4 R CKE \mathbf{m} ш \Box Z Ο \supset С ഹ \cup C Ž Revision Date ADDENDUM #2 02.21.2022 ADDENDUM #3 02.28.2022 ADDENDUM #4 03.07.2022 Project #: 20-700-151-2 Designed By: MSO Drawn By: JLB Checked By: CJR Date: 12/29/2021



EROSION CONTROL DETAILS



SITE NAME	B2 SEQUENCE DESCRIBING STORMWA
The area scheduled for construction is known as "Knox County Jail" (hereinafter referred to as the "Project")	Pre-construction Activity 1. The exact locations of a 2. Schedule pre-construct
PROJECT LOCATION	 2. Schedule pre-construct 3. Install protection fencir
The property is located approximately 0.35 miles north and 0.4 miles west of the intersection of E. Elkhorn Rd and S Decker Rd in Vincennes, Indiana, at a latitude of 38°38'27.50" N and a longitude of 87°31'34.52" W.	Construction Site Access 1. Install gravel constructi
OWNER'S INFORMATION	2. Post the NOI and conta 3. Install construction sta
Name: Knox County Commissioners Address: 111 North 7th Street, Vincennes, IN 47591	and stabilize construction r
Contact: Trent Hinkle Title: Commissioner Telephone: 812-890-2623	Perimeter Controls 1. Utilize the gravel constr
Telephone: 812-890-2623 Email: tahinkle@knoxcounty.in.gov	Initial Land Clearing and Gradin 1. Add protection measur
OPERATOR'S INFORMATION	2. Strip the topsoil and st
Name: Knox County Jail Address: 2375 S. Old Decker Road, Vincennes, IN 47591	Secondary Land Grading Activit 1. Begin site grading/cons
Contact: Doug Vantlin Title: Sheriff Telephone: 812-882-7660	for more than 10 days. 2. Complete the cut and f control blanket.
Email: dougvantlin@gmail.com	3. Install storm sewer sys protection prior to installing
NOTICE OF INTENT	Surface Stabilization
All parties defined as owners must submit a Notice of Intent (NOI) at least 48 hours prior to commencement of on-site construction activities. Submittal of late NOI's is not prohibited; however, authorization under the construction general permit is only for	 Apply temporary seedi Apply permanent seed
discharges that occur after permit coverage is granted. Unpermitted discharges may be subject to enforcement actions by the EPA. For the purposes of this permit, an owner is defined as any party meeting either of the following requirements:	Building Construction 1. Prior to building constr
1) The party has operational control over the construction plans and specifications, including the ability to make modifications to those plans and specifications.	2. Building pads left dorm 3. Start building construc
2) The party has day-to-day operational control of those activities at a project that are necessary to ensure compliance with a	Final Shaping/Landscaping
stormwater pollution prevention plan for the site or other permit conditions.	1. Utilize topsoil salvage in 2. Apply permanent seed
Refer to the Site Layout Plan.	 Complete utility installa Install landscaping plar Remove all erosion and
A3 PROJECT NARRATIVE	B3 STABLE CONSTRUCTION ENTRANC
The project consists of the renovation and construction of new additions of approximately 132,500 square foot (type) building, asphalt parking lots and drives, and (other items?) An existing detention pond is located on site to limit the runoff release rate	Construction entrances will be i
asphalt parking lots and drives, and (other items?). An existing detention pond is located on site to limit the runoff release rate.	Plan. Refer to the Erosion Contr B4 SEDIMENT CONTROL MEASURES F
Refer to the Cover Sheet	Sheet flow areas will be protect
A5 LEGAL DESCRIPTION OF THE PROJECT SITE	where the slope exceeds 4:1 (he Refer to the Erosion Control Pla
Section: Division B Township: 3 North	B5 SEDIMENT CONTROL MEASURES F
Range: 10 West	Proposed swales will be stabiliz flow protection measures. Refe
A6 LOCATION OF ALL LOTS AND PROPOSED SITE IMPROVEMENTS	B6 STORM SEWER INLET PROTECTION
The site is not subdivided into lots; therefore, all proposed site improvements are shown on the included plans. A7 HYDROLOGIC UNIT CODE (HUC)	The contractor shall install appr the Erosion Control Details for o
05120113020020	the Erosion Control Details for one measures should be installed as
A8 STATE AND FEDERAL WATER QUALITY PERMITS	B7 RUNOFF CONTROL MEASURES
Indiana Department of Environmental Management - Construction Stormwater General Permit (CSGP)	N/A
A9 SPECIFIC POINTS WHERE STORMWATER DISCHARGE WILL LEAVE THE SITE	B8 STORMWATER OUTLET PROTECTIC
Stormwater drainage from the site will be conveyed via sheet flow, storm sewer, and vegetated swales to an on-site dry detention basin that discharges to an unnamed ditch.	B9 GRADE STABILIZATION STRUCTUR
A10 LOCATION AND NAME OF ALL WETLANDS, LAKES, AND WATERCOURSES ON AND ADJACENT TO THE SITE	N/A
No wetlands, lakes, or watercourses have been identified on or adjacent to the site.	B10 LOCATION, DIMENSIONS, SPECIFI
A 11 IDENTIFICATION OF ALL RECEIVING WATERS	Refer to the Erosion Control Pla Construction Details.
The Wabash River via the Vieck Ditch is the ultimate receiving water for this project.	B11 TEMPORARY SURFACE STABILIZA
There are no locations on site where surface water may be discharged into groundwater.	Surface stabilization is required 10 days or more. Refer to the Te
A13 100 YEAR FLOODPLAINS, FLOODWAYS, AND FLOODWAY FRINGES	mixtures, and mulching. The su into the streets. If this is not po
The project site is located within Zone B as indicated on the Knox County, IN (Unincorporated Areas) Flood Insurance Rate Map	B12 PERMANENT SURFACE STABILIZA
1804220150C dated February 15, 1985. A14 PRE-CONSTRUCTION AND POST CONSTRUCTION ESTIMATE OF PEAK DISCHARGE	1.) Loosen lawn area to a minim
Pre-Construction 10-year discharge = 0.89 cfs	soil amendments such as peat, of topsoil. Provide fertilizer with square feet of lawn area and no
Post-Construction 10-year discharge = 0.72 cfs	be organic form. Delay mixing c 2.) Fertilizer for lawns: provide a
ATS ADJACENT LAND USE North: Commercial/ Industrial	percent phosphorous, and 2 pe 3.) Slow-release fertilizer for tre
South: Agriculture East: Agriculture (Future Industrial)	and potassium made up of a co 4.) Grade lawn and grass areas
West: Agriculture/Single Family Residential	planted within immediate future with planting or maintenance o exceeds 5 miles per hour.
A16 LOCATIONS AND APPROXIMATE BOUNDARIES OF ALL DISTURBED AREAS	5.) Distribute seed evenly over e 6.) Rake seed lightly into top 1/8
Approximate boundaries of disturbed areas are as identified on the Erosion Control Plan.	7.) Install erosion control blanke8.) Protect seeded areas against
Approximate areas of existing vegetative cover are as shown on the Existing Conditions Plan or Topographic Survey.	Spread uniformly to form a con 9.) Water newly planted lawn ar
A18 SOILS MAP INCLUDING SOIL DESCRIPTION AND LIMITATIONS	construction activities including 10.) Refer to the Permanent See specifications and mulching spe
The Natural Resources Conservation Service (NRCS) Web Soil Survey of Knox County, Indiana indicates (Brookston silty clay loam (Br),Crosby silt loam (CrA), and Miami silt loam (MmB2)) are located on the site.	B13 MATERIAL HANDLING AND SPILL
(Br), crosby sin foarm (CrA), and Marin sin foarm (MinB2)) are located on the site. The on-site soil will be treated as recommended by the geotechnical engineer if the conditions are unsuitable for the proposed	Solid Waste Disposal
construction.	No solid material, including buil materials, including disposable The collection containers must
A19 LOCATIONS, SIZE, AND DIMENSIONS FOR THE PROPSOED STORMWATER SYSTEMS Locations of stormwater systems: Refer to the Site Utility Plan	The collection containers must and/or appropriate local munici
Locations of stormwater systems:Refer to the Site Offity PlanSize of storm sewers:Refer to the Site Utility Plan or Storm Sewer ProfilesDetails of storm inlets and manholes:Refer to the Construction Details	A foreman or supervisor should waste procedures.
A20 PLANS FOR ANY OFF-SITE CONSTRUCTION ACTIVITIES ASSOCIATED WITH THIS PROJECT	Hazardous Waste
No offsite work will be performed for this project.	Whenever possible, minimize the will be disposed in the manner
A21 LOCATIONS OF PROPOSED SOIL STOCKPILES AND/OR BORROW/DISPOSAL	Use containment berms in fueli
Excess soil shall be immediately stockpiled, surrounded with silt fence, and seeded where indicated in grading plan in accordance with all applicable laws. If topsoil stockpiles are anticipated for this project, they are shown on the Erosion Control Plan.	A foreman or supervisor should hazardous waste procedures. T
A22 EXISTING SITE TOPOGRAPHY	prevention plan by the operator
Refer to the Existing Conditions Plan or Topographic Survey	Dust Control/Off-Site Vehicle Tra During construction, water truct construction, the site should sta
A23 PROPOSED FINAL SITE TOPOGRAPHY	Construction traffic should ente
Refer to the Site Grading Plan	the rock pad is to minimize the site, off-site accumulations of se
<u>B1 DESCRIPTION OF POTENTIAL POLLUTANT SOURCES ASSOCIATED WITH CONSTRUCTION ACTIVITIES</u> The following potential pollutant sources may be associated with construction activities on site:	
1. Material storage areas 2. Construction waste material	
3. Fuel storage areas and fueling stations 4. Exposed soils	
5. Leaking vehicles and equipment 6. Sanitary waste from temporary toilet facilities	
7. Litter	
8. Windblown dust 9. Soil tracking off site from construction equipment	
8. Windblown dust 9. Soil tracking off site from construction equipment The following materials may be staged or stored on site at various points during construction:	
9. Soil tracking off site from construction equipment	

gutilities within the project limits are to verified prior to construction. ing with local stormwater authority 48 hours prior to start of construction. ting trees to remain in place within the project limits

ation at the construction entrance. NOI to remain posted for duration of the project. s, fueling station, material storage areas, concrete washout, construction parking areas,

trance for installation of the perimeter silt fence. Add stone if needed.

ing inlets. topsoil stockpile.

detention basins (if applicable) and stabilize any soil stockpiles that will be left dormant

site. Final grade and seed the pond slopes (if applicable). Stabilize slopes with erosion nstall inlet protection immediately upon complete of the inlet and install rip-rap outlet

bilize slopes in areas where rough grading has been completed. abilize slopes in areas where final grading has been completed.

stall stone surface for paved areas. nore than 10 days, must be temporarily seeded.

Il staging area for building materials and stabilize.

ble areas and apply permanent seeding the perimeter of the site.

bs, paving, and building construction. and stabilize all disturbed areas.

t control practices when areas have a uniform grass cover.

ONS AND SPECIFICATIONS

rior to any site construction or demolition. Entrances are shown on the Erosion Control s for details.

FLOW AREAS

and mulch or hydroseeding. Erosion control blankets will be installed on sloped areas o vertical). Silt fencing will be utilized to prevent sedimentation from leaving the site. ations and the Erosion Control Details for details.

ENTRATED FLOW AREAS

rosion control blankets. Straw bales and silt fences will not be allowed as concentrated rosion Control Plan for locations and the Erosion Control Details for details.

LOCATIONS AND SPECIFICATIONS

nlet protection measures at each inlet. Refer to the Erosion Control Plan for locations and raw bales will not be allowed as inlet protection measures. These inlet protection the inlets are installed or shortly thereafter.

RES

on pond outlet to prevent erosion.

AND CONSTRUCTION DETAILS OF EACH STORMWATER QUALITY MEASURE

ions of each stormwater quality measure and the Erosion Control Details and Site

HODS APPROPRIATE FOR EACH SEASON

pare or thinly vegetated areas that is scheduled or likely to remain inactive for a period of eeding Detail within the Erosion Control Details for specifics on soil amendments, se ilization for the lots needs to be established as soon as possible to prevent dirt wash-out en silt fencing will need to be installed along the back of curbs.

CIFICATIONS

n of 6 inches. Mix soil amendments and fertilizers with topsoil at rates specified. Organic , or manure shall be applied at 2" depth evenly over soil and incorporated into the top 6" age of nitrogen required to provide not less than 1 pound of actual nitrogen per 1,000 n 4 percent phosphoric acid and 2 percent potassium. At least 50 percent of nitrogen to r if planting will not follow placing of planting soil within a few days. ase fertilizer with a composition of 1 lb per 1,000 square feet of actual nitrogen, 4

assium by weight. rubs: granular fertilizer consisting of 50 percent water-insoluble nitrogen, phosphorous by weight of 5 percent. oth, even surface with loose, uniformly fine texture. Limit fine grading to areas that can be

e trash, debris, stones larger than 1 inch diameter, and other objects that may interfere . Sow seed using a spreader of seeding machine. Do not seed when wind velocity a by sowing equal quantity in 2 directions at right angles to each other.

oil, roll lightly, and water with a fine spray.

icated on the Erosion Control Plan. by spreading clean, seed-free straw mulch after completion of speeding operations. lanket not less than 1-1/2 inches loose measurements over seeded areas.

keep moist until new grass is established. Immediately repair any lawn areas disturbed by shrub installation.

tails within the Erosion Control Detail Sheet, for timing of permanent seeding, grass seed

ION PLAN

erials, is permitted to be discharged to surface waters or buried on site. All solid waste incidental to construction activity, must be collected in containers or closed dumpsters. ed periodically and the collected material hauled to a landfill permitted by the State ccept the waste for disposal.

nated in writing to oversee, enforce, and instruct construction workers on proper solid

hazardous materials and generation of hazardous wastes. All hazardous waste materials by federal, state, or local regulations or by the manufacturer.

aintenance areas and where potential for spills is high.

nated in writing to oversee, enforce, and instruct construction workers on proper n of any hazardous waste storage areas should be indicated on the stormwater pollution on-site location of the facility.

l be used, as needed, by each contractor or subcontractor to reduce dust. After reduce dust.

t the site at a Construction Entrance with a rock pad or equivalent device. The purpose of f soil and mud that is tracked onto existing street. If sediment escapes the construction nust be removed a frequency sufficient to minimize off-site impacts.

Contractors and subcontractors must comply with all state and local sanitary sewer, portable toilet, or septic system regulations. Sanitary facilities shall be provided at the site by each contractor or subcontractor throughout construction activities. The sanitary facilities should be utilized by all construction personnel and be serviced regularly. All expenses associated with providing sanitary facilities are the responsibility of the contractors and subcontractors. The location of B15 EROSION AND SEDIMENT CONTROL SPECIFICATIONS FOR INDIVIDUAL BUILDING LOTS any sanitary facilities should be indicated on the stormwater pollution prevention plan by the operator following on-site location of said facilities.

Water Source

Water used to establish and maintain grass, to control dust, and for other construction purposes must originate from a public water supply or private well approved by the State or local health department.

Equipment Fueling and Storage Areas Equipment fueling, maintenance, and cleaning should only be completed in protected areas (i.e., bermed area). Leaking equipment and maintenance fluids will be collected and not allowed to discharge onto soil where they may be washed away during a rain event.

Equipment wash-down (except wheel washes) should take place within an area surrounded by a berm. The use of detergents is prohibited.

Hazardous Material Storage

Chemicals, paint, solvents, fertilizers, and other toxic or hazardous materials should be stored in their original containers (if original container is not resealable, store the products in a clearly labeled, waterproof container). Except during application, the containers should be kept in trucks or in bermed areas within covered storage facilities. Runoff containing such materials shall be collected, removed from the site, and disposed of in accordance with the federal state, and local regulations.

As may be required by federal, state or local regulations, the Contractor should have a Hazardous Materials Management Plan and/or Hazardous Materials Spill and Prevention Program in place. A foreman or supervisor should be designated in writing to oversee, enforce, and instruct construction workers on proper hazardous materials storage and handling procedures. The location of any hazardous material storage areas should be indicated on the stormwater pollution prevention plan by the operator following on-site location of the storage areas.

Material Handling and Spill Prevention

Discharge of hazardous substances or oil into stormwater is subject to reporting requirements. In the event of a spill of a hazardous substance, the operator is required to notify the National Response Center (1-800-424-8802) to properly report the spill. In addition, the operator shall submit a written description of the release (including the type and amount of material released, the date of the release, the circumstances of the release, and the steps to be taken to prevent future spill) to the local governing authority. The SWPPP must be revised within 14 calendar days after the release to reflect the release, stating the information above along with modifications minimize the possibility of future occurrences. Each contractor and subcontactor is responsible for complying with these reporting requirements.

Concrete Washout

All concrete trucks waste material shall be completely contained and disposed in accordance with all local, state, and federal regulations. A pit or container is required when cleaning concrete chutes.

Minor - Small spills that typically involve oil, gasoline, paint, hydraulic fluid, etc. can be controlled by the first responder at the discovery of the spill. • Contain spill to prevent material from entering storm or groundwater. Do not flush with water or bury.

- Use absorbent material to clean-up spill material and any subsequently contaminated soil and dispose of properly. Semi-Significant Spills - Approximately ten gallons or less of pollutant with no contamination of ground or surface waters. Minor spills can be generally controlled by the first responder with help from other site personnel. This response may require other operations to stop to make sure the spill is quickly and safely addressed. At the discovery of the spill:
- Contain spill to prevent material from entering storm or ground water. Do not flush with water or bury. • Use absorbent material to clean-up spills and dispose of properly. Spills on impervious surfaces should be disposed of as soon as possible to prevent migration deeper into the soil and groundwater. Dispose of contaminated soils or
- absorbents properly. • Contact 911 if the spill could be a safety issue
- Contact supervisors and designated site inspectors, including MS4 personnel, immediately.
- Contaminated solids are to be removed to an approved landfill Major or Hazardous Spills - More than ten gallons, there is the potential for death, injury or illness to humans or animals,
- or has the potential for surface or groundwater pollution. • Control or contain the spill without risking bodily harm. Temporarily plug storm drains if possible to prevent migration
- of the spill into the stormwater system • Immediately contact the local Fire Department at 911 to report any hazardous material spill.
- Contact supervisors and designated site inspectors immediately. Governing authorities, including MS4 personnel, responsible for stormeater facilities should be contacted as well. The contractor is responsible for having these contact numbers available at the job site. A written report should be submitted to the owner as soon as possible.
- As soon as possible but within 2 hours of discovery, contact the local agency responsible for spill management. The following information should be noted for future reports to the agency:
- •• Name, address and phone number of person making the spill report
- The location of the spill •• The time of the spill
- •• Identification of the spilled substance • Approximate quantity of the substance that has been spilled or may be further spilled
- The duration and source of the spill •• Name and location of the damaged waters
- •• Name of spill response organization
- •• What measures were taken in the spill response •• Other information that may be significant

Additional regulations or requirement may be present. A spill response professional should be consulted to make sure all

appropriate and required steps have been taken. Contaminated solids should only be removed from the site after approval is give by the appropriate agency.

B14 MONITORING AND MAINTENANCE GUIDELINES FOR EACH PROPOSED STORMWATER QUALITY MEASURE

spection Schedule/Reporting All impacted areas, as well as all erosion and sediment control devices, will be inspected every seven (7) calendar days and within 24 hours after a rianfall of 0.5 inch or greater. Where sites have been final or temporarily stabilized or on sites

where runoff is unlikely due to winter conditions (e.g. site is covered with snow, ice, or frozen ground exists), such inspections shall be conducted at least once every month.

Inspections shall be conducted and a written report prepared, by a designated and qualified person familiar with the USEPA NPDES Storm Water General Permit, this SWPPP, and the Project.

Inspection reports shall be completed including scope of the inspection, name(s) and qualifications of personnel making the inspection, the date of the inspection, observations relating to the implementation of the SWPPP, and any actions taken as a result of incidents of noncompliance noted during the inspection. The inspection report should state whether the site was in compliance or identify and incidents of noncompliance. The contractor shall keep a copy of the inspection reports on site and permanently for a period of two years following construction. The on-site reports may be requested by inspections conducted by the local governing authority.

Construction Entrance Locations where vehicles exit the site shall be inspected for evidence of off-site sediment tracking. Each contractor and subcontractor shall be responsible for maintaining the Construction Entrance and other controls as described in this

Material Storage Inspections

Inspectors must evaluate areas used for storage of materials that are exposed to precipitation. The purpose is to ensure that materials are protected and/or impounded so that pollutants cannot discharge from storage areas. Off-site material storage areas used solely b the subject project are considered to be part of the project and must be included in the erosion control plans and site inspection reports.

Soil Stabilization Inspections

Seeded areas will be inspected to confirm that a healthy stand of vegetation is maintained. The site has achieved final stabilization once all areas are covered with pavement or have a stand of vegetation with at least 70% of the background vegetation density. The density of 70% or greater must be maintained to be considered as stabilized. The operator or their representative will water, fertilize, and reseed disturbed areas as needed to achieve this goal.

Erosion and Sediment Control Inspections

Modifications/Revisions to SWPPP

All controls should be inspected at least once every seven (7) calendar days and following any storm event of 0.5 inch or greater. The following is a list of inspection/maintenance practices that will be used for specific controls: 1. Geotextiles/Erosion Control Mats: Missing or loose matting must be replaced or re-anchored.

- 2. Inlet Protection: If silt fence inlet protection is to be used, sediment should be removed when it reaches approximately one-half the height of the fence. If a sump is used, sediment should be removed when the volume of the basin is reduced by 50%.
- 3. Mulching: Inspect for thin or bare spots caused by natural decomposition or weather-related events. Mulch in high traffic areas should be replaced on a regular basis to maintain uniform protection. 4. Silt Fence: Removal of built-up sediment will occur when the sediment reaches one-third the height of the fence.
- 5. Stabilized Construction Entrance: Periodic re-grading and top dressing with additional stone. 6. Vegetation: Protect newly seeded areas from excessive runoff and traffic until vegetation is established. Establish a
- watering and fertilizing schedule. 7. Good Housekeeping: Litter, construction debris, and construction chemicals exposed to stormwater shall be
- prevented from becoming a pollutant source for stormwater discharges through screening of outfalls and daily pickup

In the event that sediment escapes the construction site, off-site accumulations of sediment must be removed at a frequency sufficient to minimize adverse impacts. An example of this may be the situation where sediment has washed into the street and could be carried into the storm sewers by the next rainfall and/or pose a safety hazard to user of public

Based on inspection results, any necessary modification to this SWPPP shall be implemented within seven (7) calendar days of the inspection. A modification is necessary if a control measure or operational procedure does not provide adequate pollutant control. All revisions shall be recorded on a Record of Revisions within seven (7) calendar days of the inspection.

It is the responsibility of the operator to maintain effective pollutant discharge controls. Physical site conditions or contractor/subcontractor practices could make it necessary to install more control than were originally planned. Fore example, localized concentrations of surface runoff or unusually steep areas could required additional silt barrier or other structural controls. Assessing the need for and installing additional controls will be a continuing contractor/subcontractor responsibility until final stabilization is achieved. Contractors and subcontractors implementing this SWPPP must remain alert to the need to periodically refine and update this SWPPP in order to accomplish the intended goals.

Notice of Termination Compliance of the site with the General Construction Permit remains the responsibility of all operators that have submitted an NOI until such time as they have submitted a Notice of Termination (NOT). The permittee's authorization to discharge under the General Construction Permit terminates at midnight of the day the NOT is signed.

All permittees must submit an NOT within thirty (30) days after one or more of the following conditions have been met: 1. Final stabilization has been achieved on all portions of the site for which the permittee was responsible.

2. Another operator/permittee has assumed control over all areas of the site that have not been finally stabilized. 3. In residential construction operations, temporary stabilization has been completed and the residence has been transferred to the homeowner.

The site is not currently subdivided, therefore the entire site is on this plan's Erosion Control Plan.

C1 DESCRIPTION OF POLLUTANTS AND THEIR SOURCES ASSOCIATED WITH THE PROPOSED LAND USE The proposed land use is for the expansion of the Knox County Justice Facility. The pollutants and sources of each

pollutant normally expected from this type of land use are: Pollutant Source: Passenger vehicles, delivery vehicles. Type of Pollutant: Oil, gasoline, diesel fuel, any hydrocarbon associated with vehicular fuels and lubricants, grease,

antifreeze, windshield cleaner solution, brake fluid, dust, rubber, glass, metal and plastic fragments, grit, road de-icing materials.

Pollutant Source: Building

Type of Pollutant: Cleaning solutions or solvents, leaks from HVAC equipment, grit from roof drainage, aggregate or rubber fragments from roofing system.

Pollutant Source: Trash Dumpster Type of Pollutant: Cleaning solutions or solvents, litter (paper, plastic, general refuse associated with distribution operations), uneaten food products, bacteria.

Pollutant Source: Parking Lot Type of Pollutant: Any pollutant associated with vehicular sources, grit from asphalt wearing surface, bituminous compounds from periodic maintenance (sealing, resurfacing, and patching), pavement de-icing materials, paint fragments from parking stall striping, concrete fragments, wind-blown litter from off-site sources, elevated water temperatures from contact with impervious surfaces.

Pollutant Source: Lawn and Landscape Areas Type of Pollutant: Fertilizers, soil, organic material (leaves, mulch, grass clippings)

C2 SEQUENCE DESCRIBING STORMWATER QUALITY MEASURE IMPLEMENTATION

The grass-lined channels and swales will serve as the permanent water quality features after construction is complete. The purpose of these features is to filter pollutants and sediment.

3 DESCRIPTION OF PROPOSED POST-CONSTRUCTION STORMWATER QUALITY MEASURES

Vegetated swales are designed to reduce pollutant and sediment loads in stormwater runoff. Stormwater runoff is directioned in the swale which conveys the runoff from the site. While moving through the swale, runoff velocity is greatly decreased allowing biofiltration (uptake of nutrients by plants), infiltration (percolation of water through the swale's porous soil substrate), and sedimentation (settling of later suspended particles).

Topsoil will be placed in lawn areas and seeded with grass, and graded not to exceed 3:1 slopes. Proposed landscape trees and shrubs will also be added. These bio areas will act as a natural filter strip to help improve stormwater quality. The vegetated areas will slow the velocities of stormwater runoff, reduce sediment runoff, and reduce problems associated with mud or dust from bare soils.

Good Housekeeping Measures

Good housekeeping measures such as regular street or pavement sweeping, installation of trash receptacles, and reduction in fertilizer overspray can be incorporated by the owner and/or occupant.

C4 LOCATION, DIMENSIONS, SPECIFICATIONS, AND CONSTRUCTION DETAILS OF EACH STORMWATER QUALITY MEASURE

Refer to the Erosion Control Plans for locations and Erosion Control Details for details.

C5 DESCRIPTION OF MAINTENANCE GUIDELINES FOR POST-CONSTRUCTION STORMWATER QUALITY MEASURES

Maintenance requirements for the stormwater quality measures which will remain in place after construction is complete, are described below.

Vegetated Swale

Vegetated swales require little maintenance if properly designed. Mow as needed during the growing season; inspect for erosion control problems twice during the first year, annually thereafter; and removed sediment, trash and debris annually or more frequently if needed.

Wet Detention Pond


Remove debris and sediment from entire pond when necessary. Inspect perimeter of basin annually and after major storm events. Regrade soil if gullies form and replant ground. Inspect inlet and outlet devices and structures annually and after maior storm events.

SOILS MAPINFORMATION


Map Unit Symbol	Map Unit Name	Acres in AOI	Percent of AOI
ChC	Chelsea loamy fine sand, 4 to 10 percent slopes	1.9	18.5%
CoA	Conotton sandy loam, 0 to 3 percent slopes	7.2	70.4%
Sc	Selma clay loam	1.1	11.0%
Totals for Area of Interest		10.2	100.0%






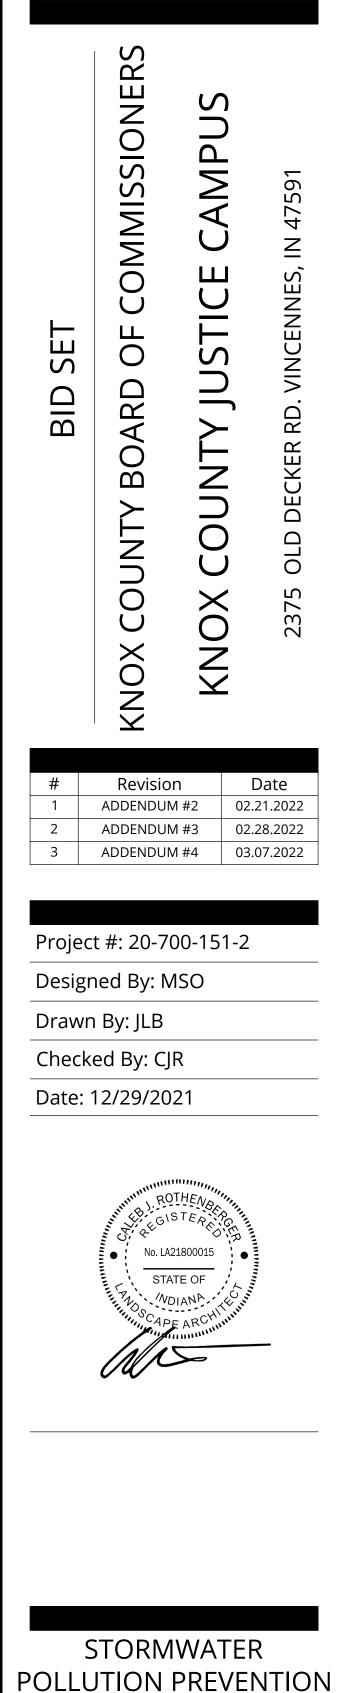


PLAN

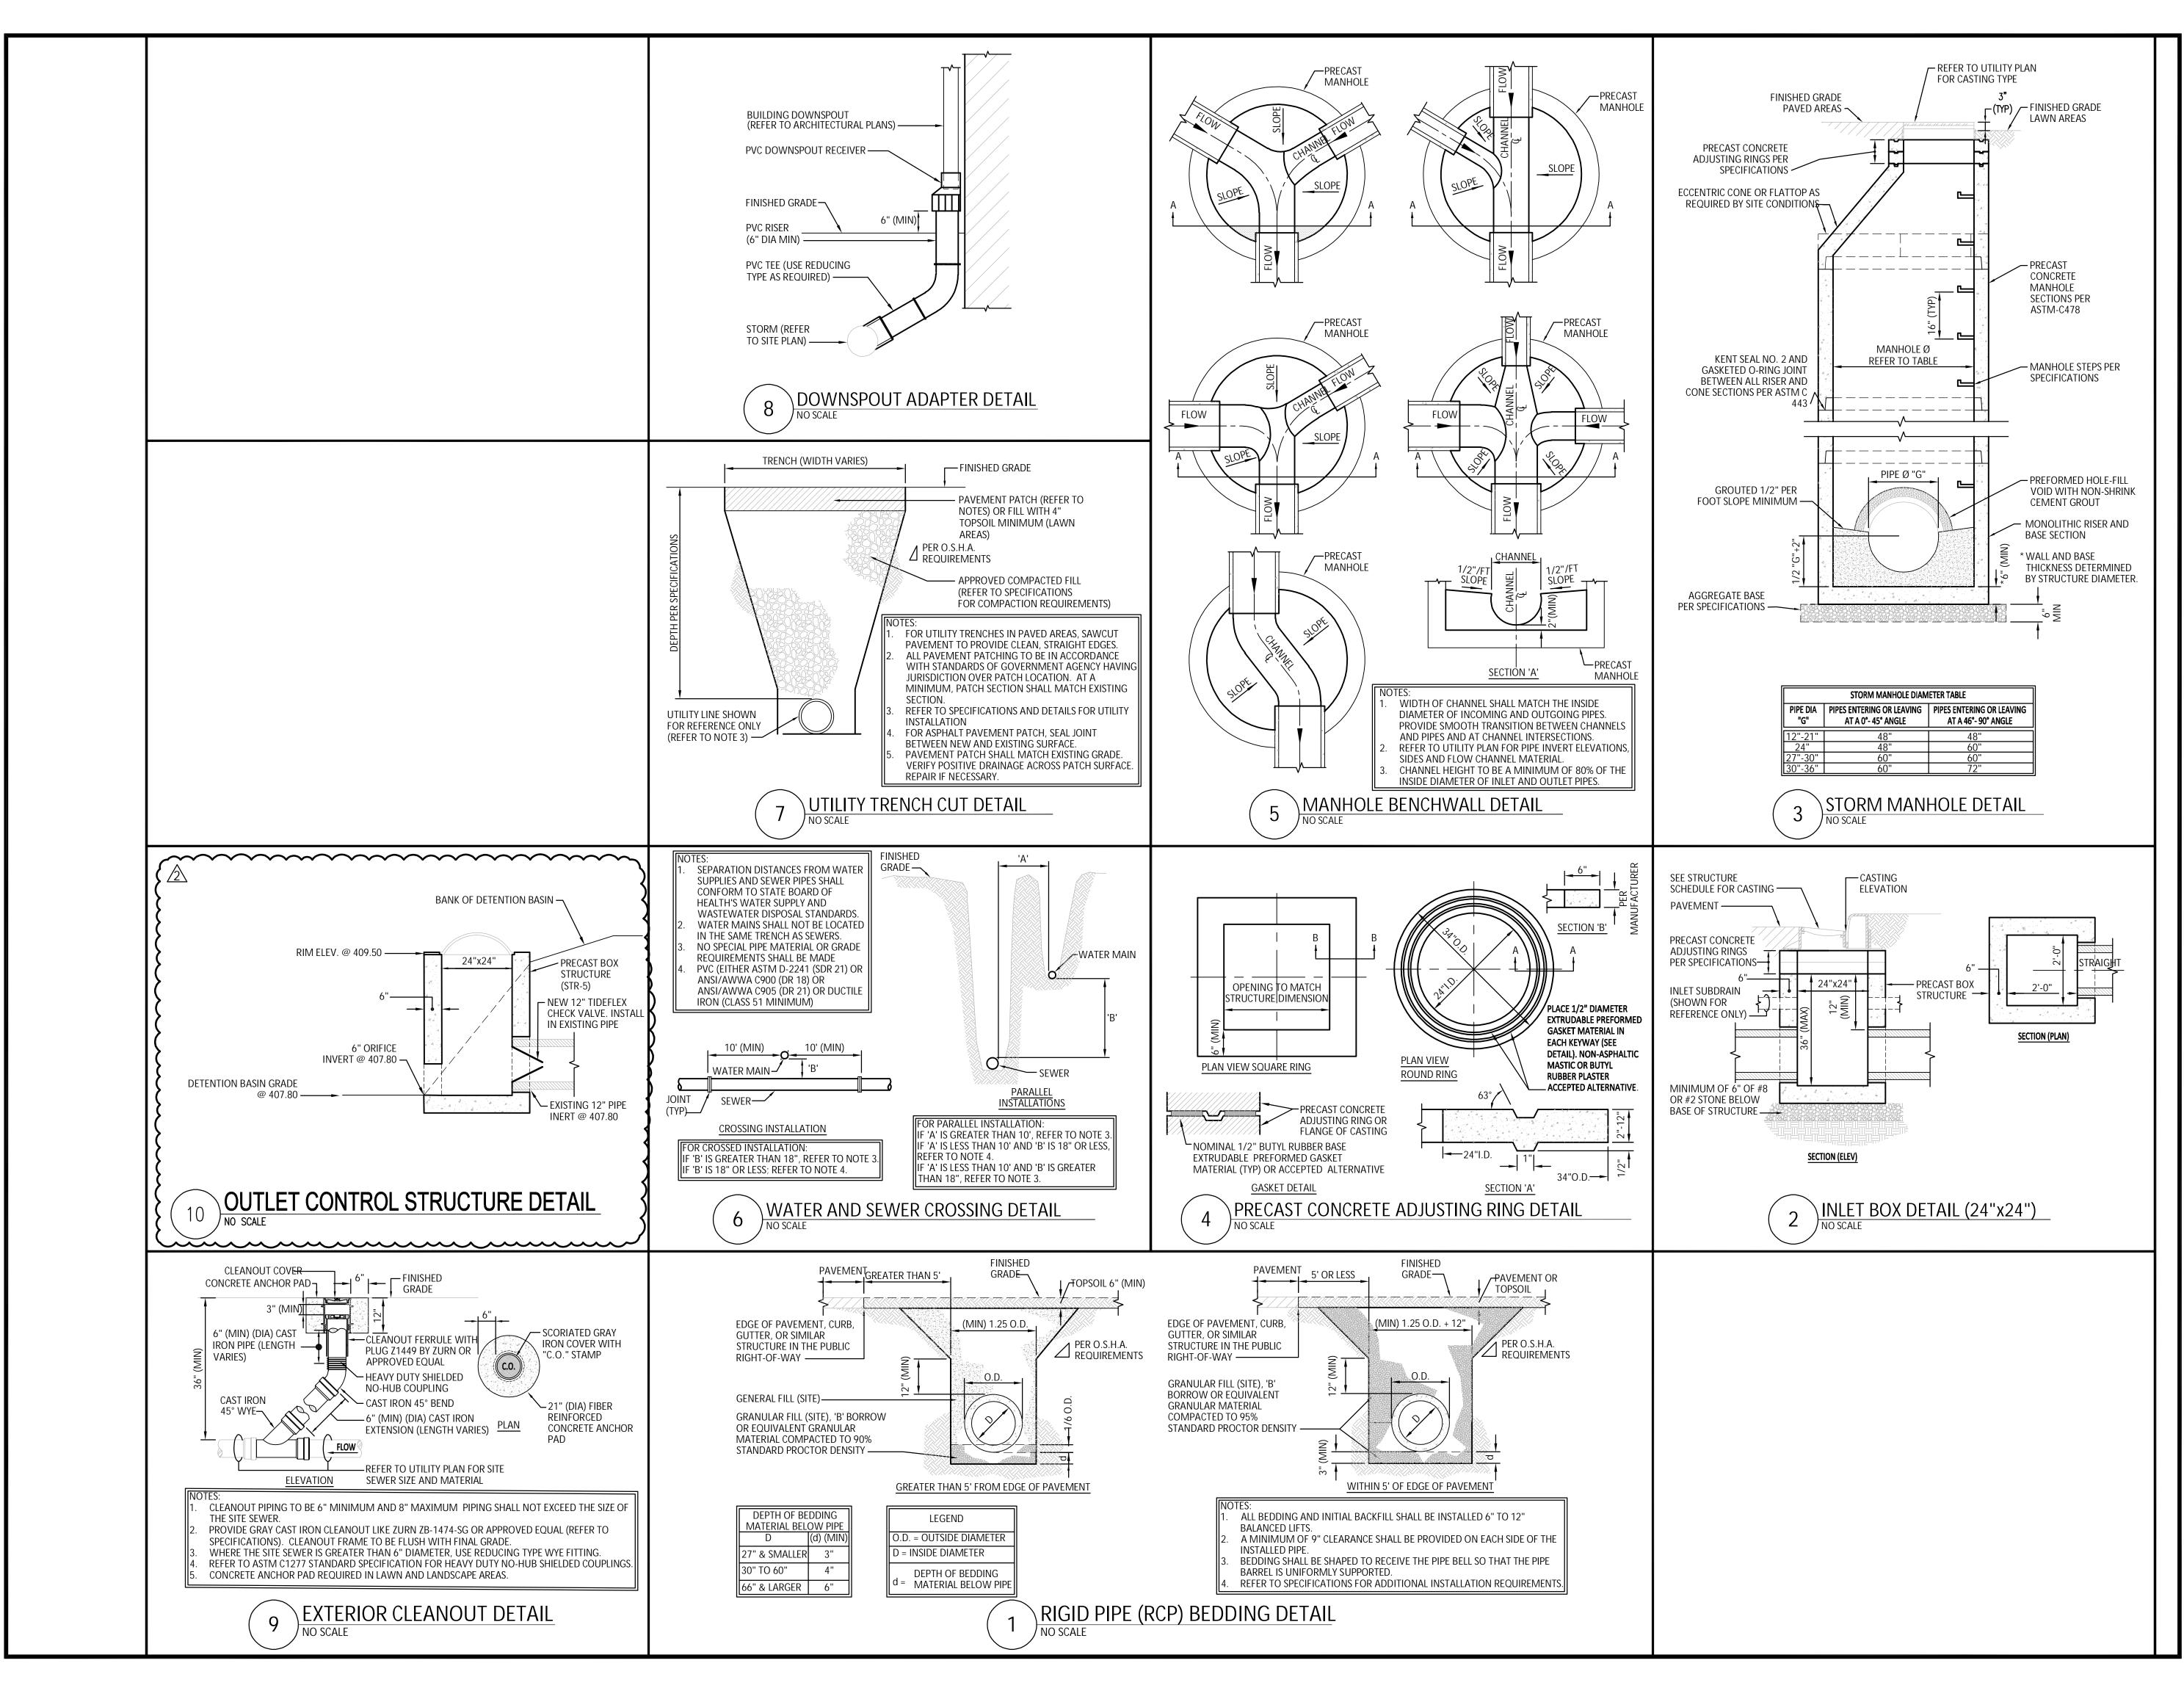



JPS Consulting Engineers - K:\Civil Projects\21JPSC46 Knox County Jai\\Drawings\C602.dwg February 17, 2022 - 2:03 PM Nvergatos

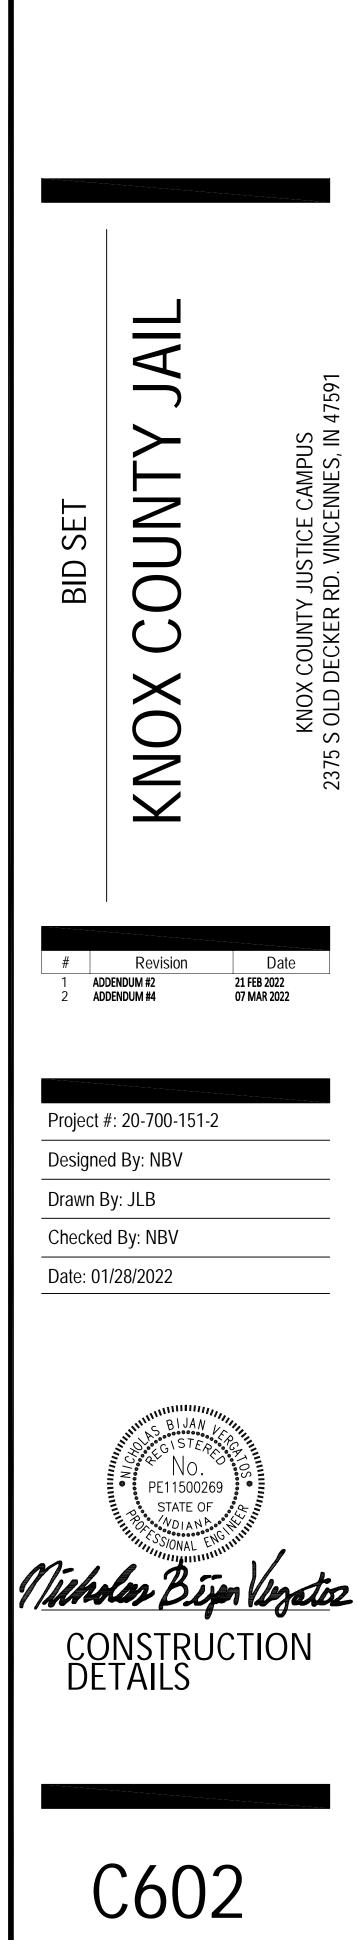



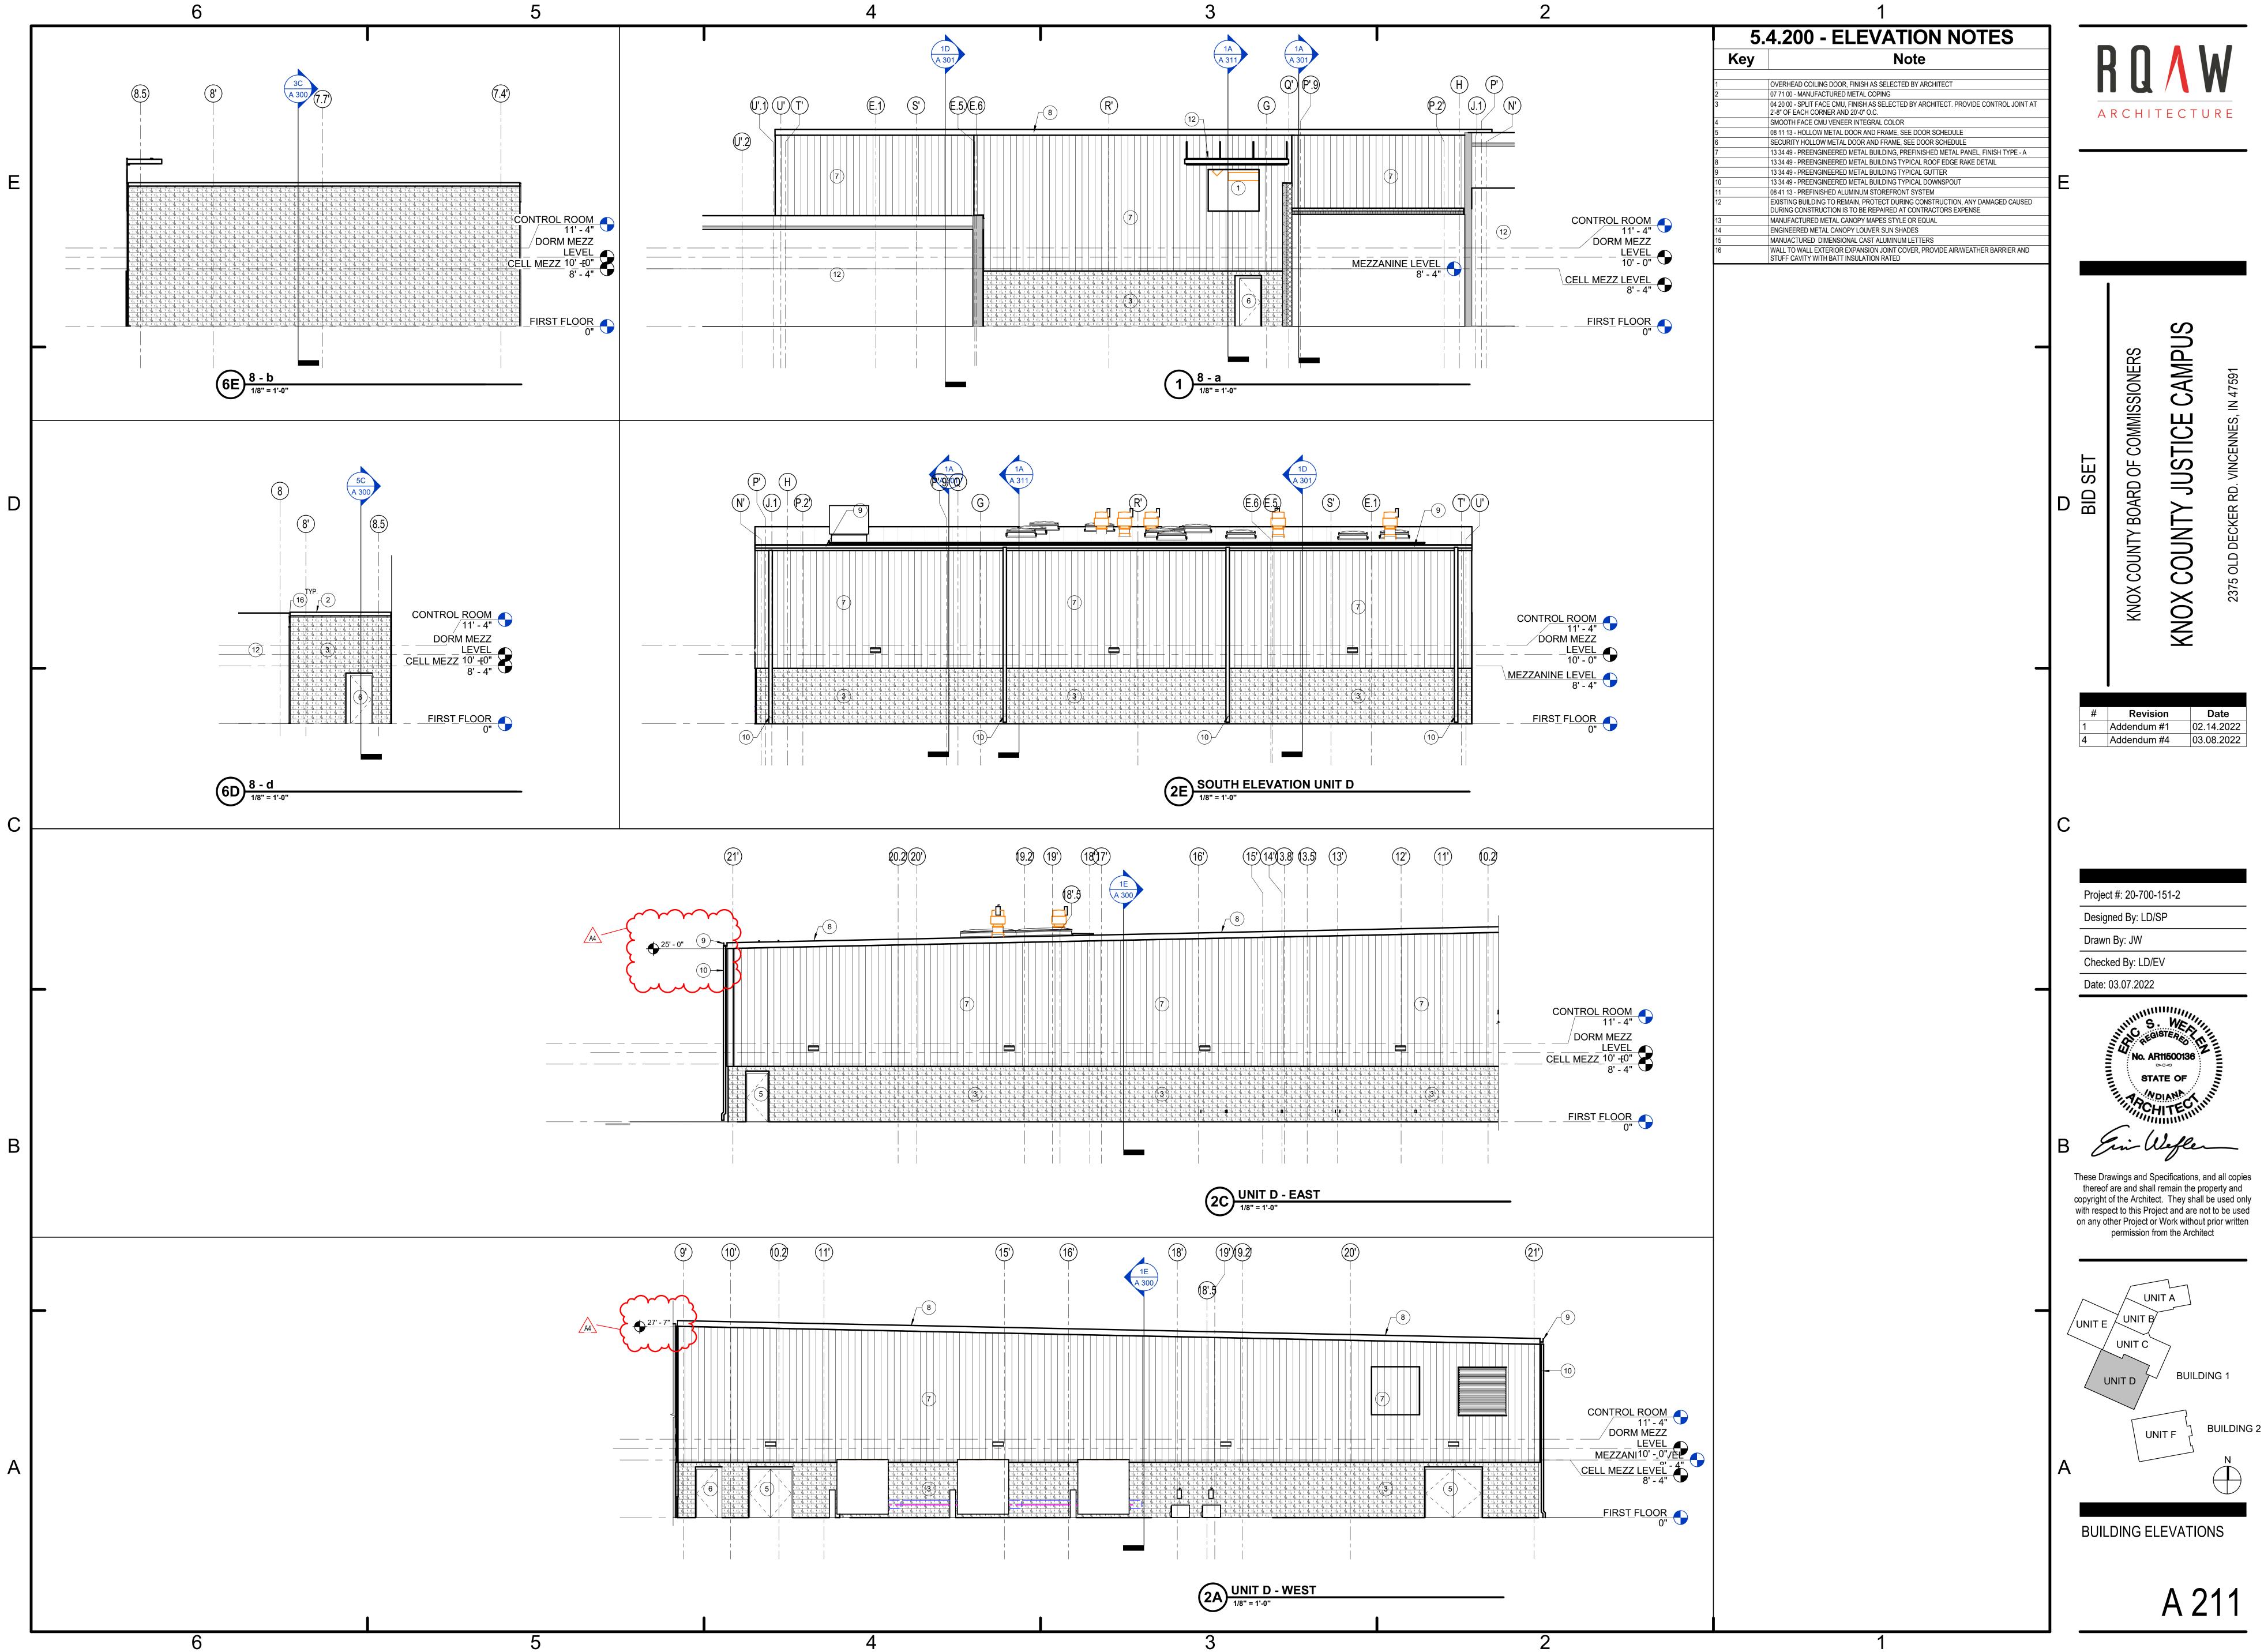

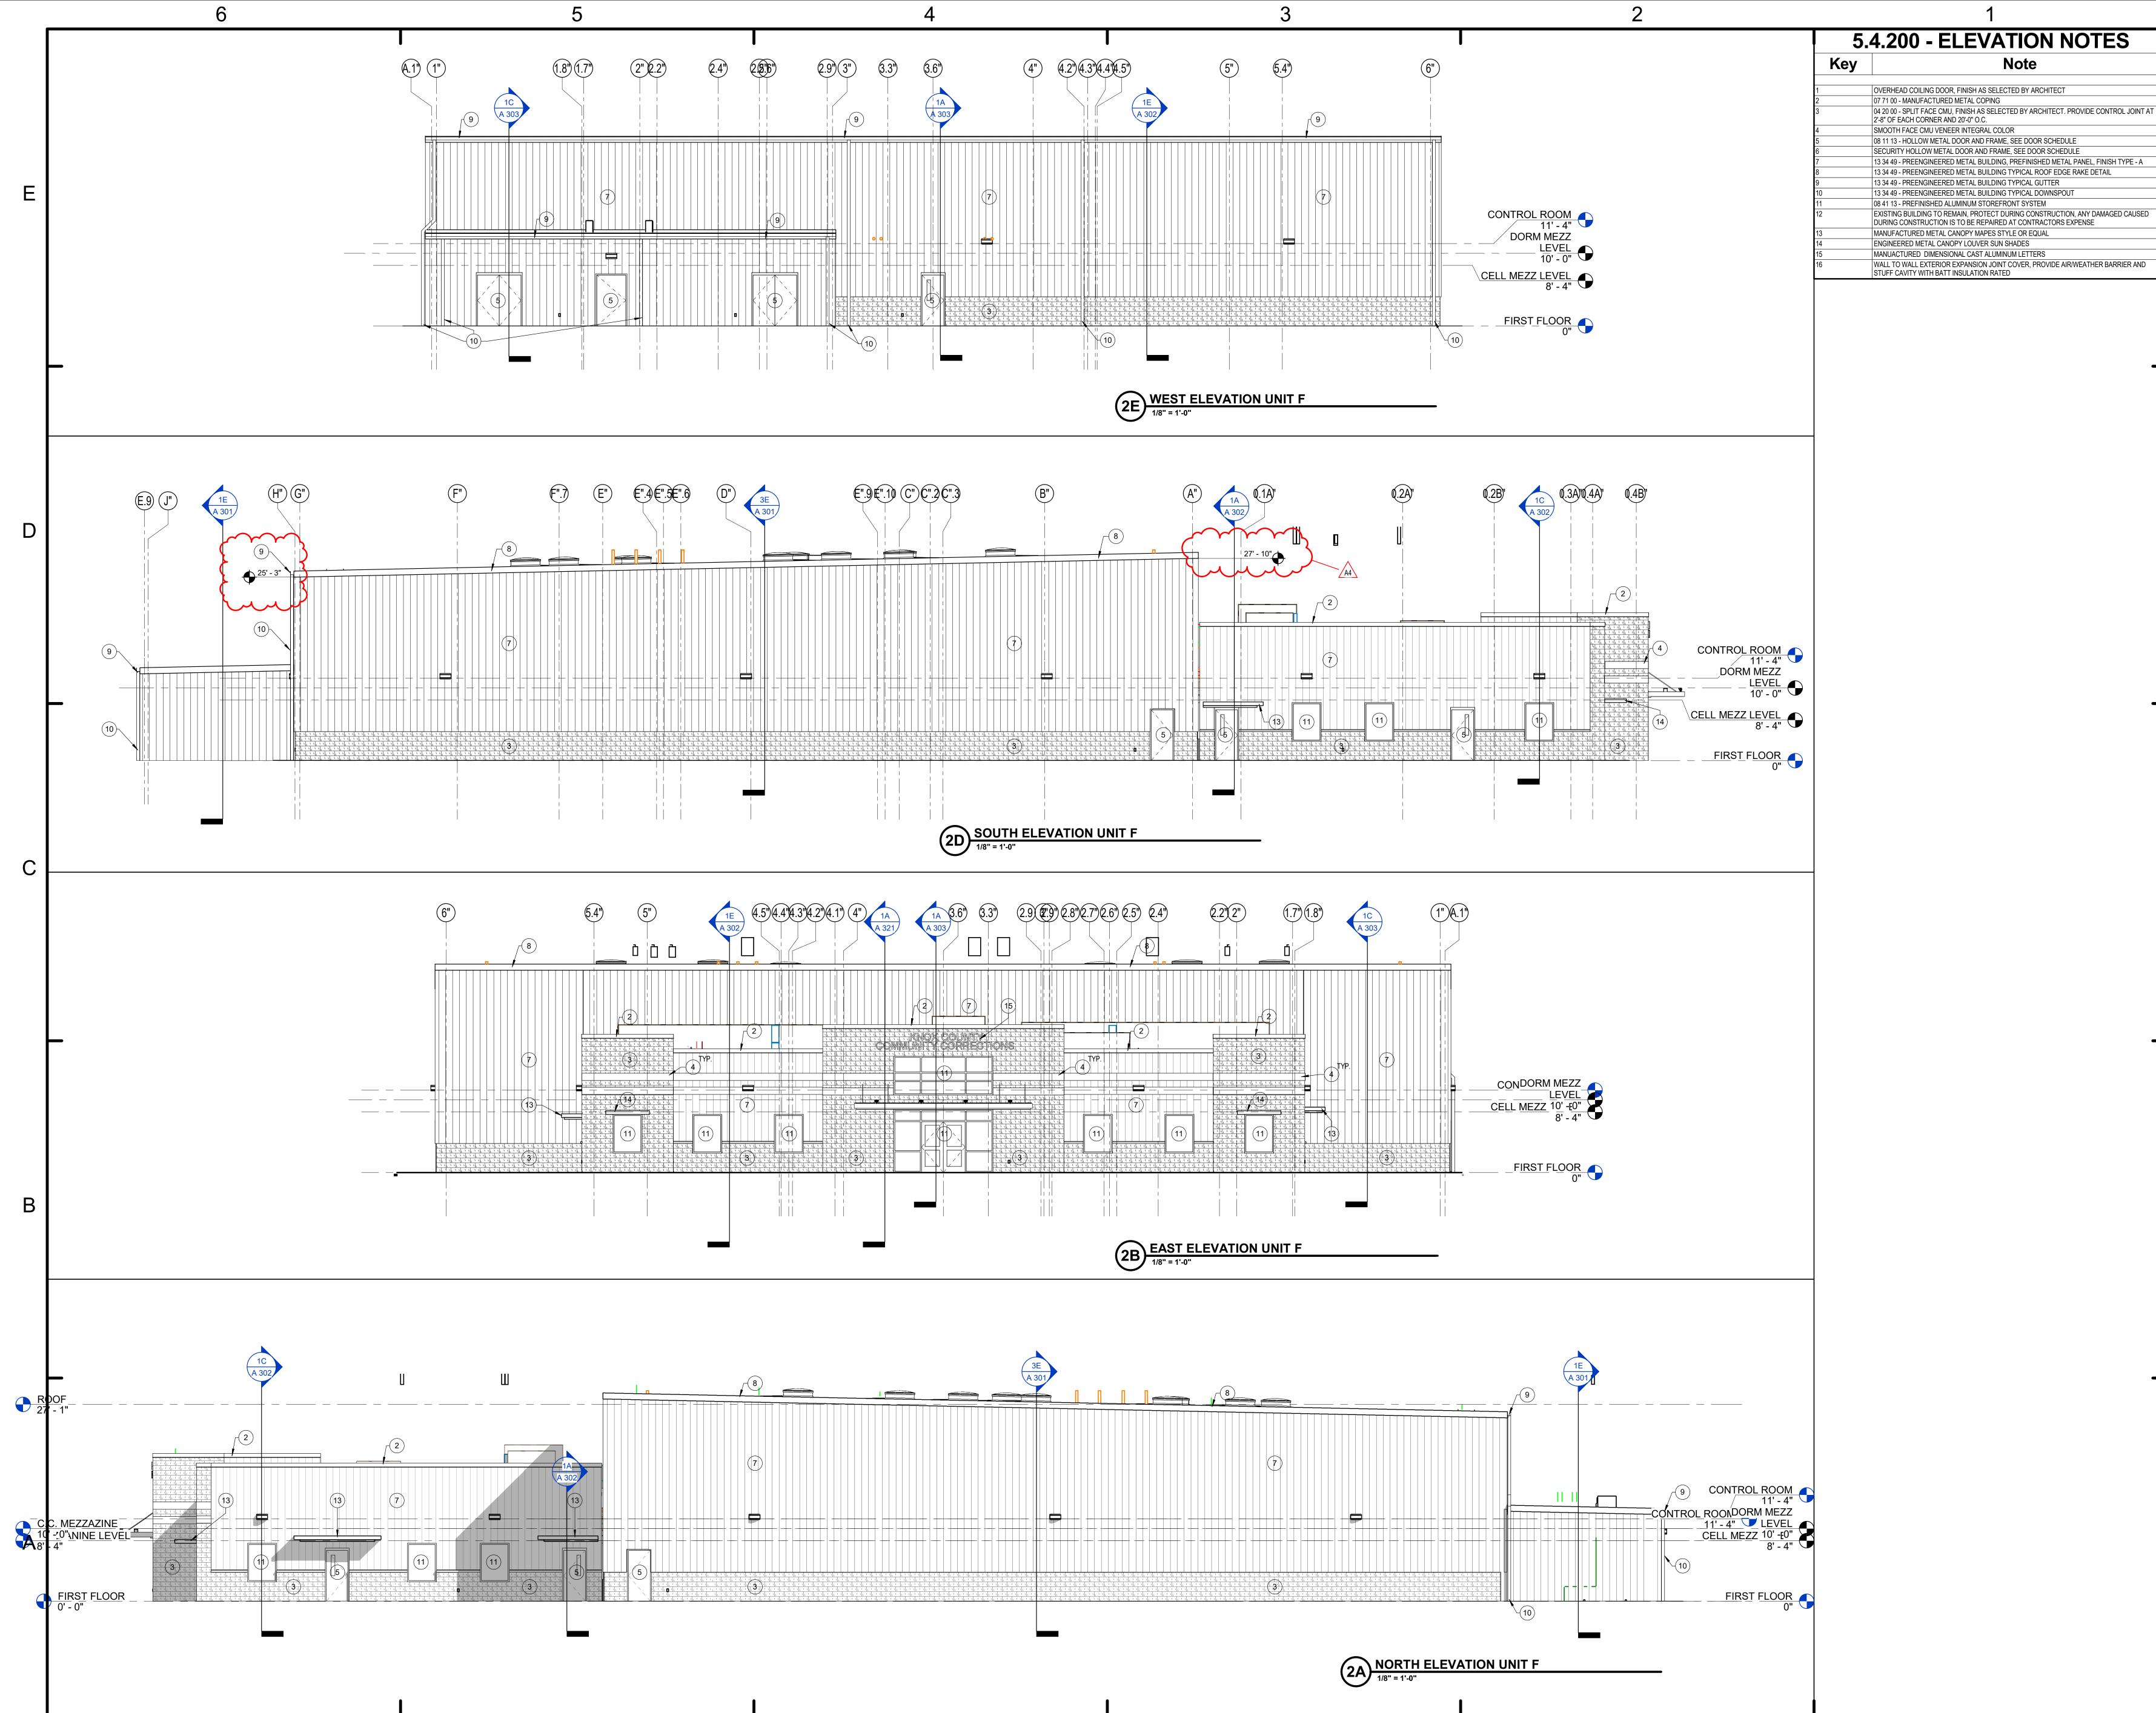

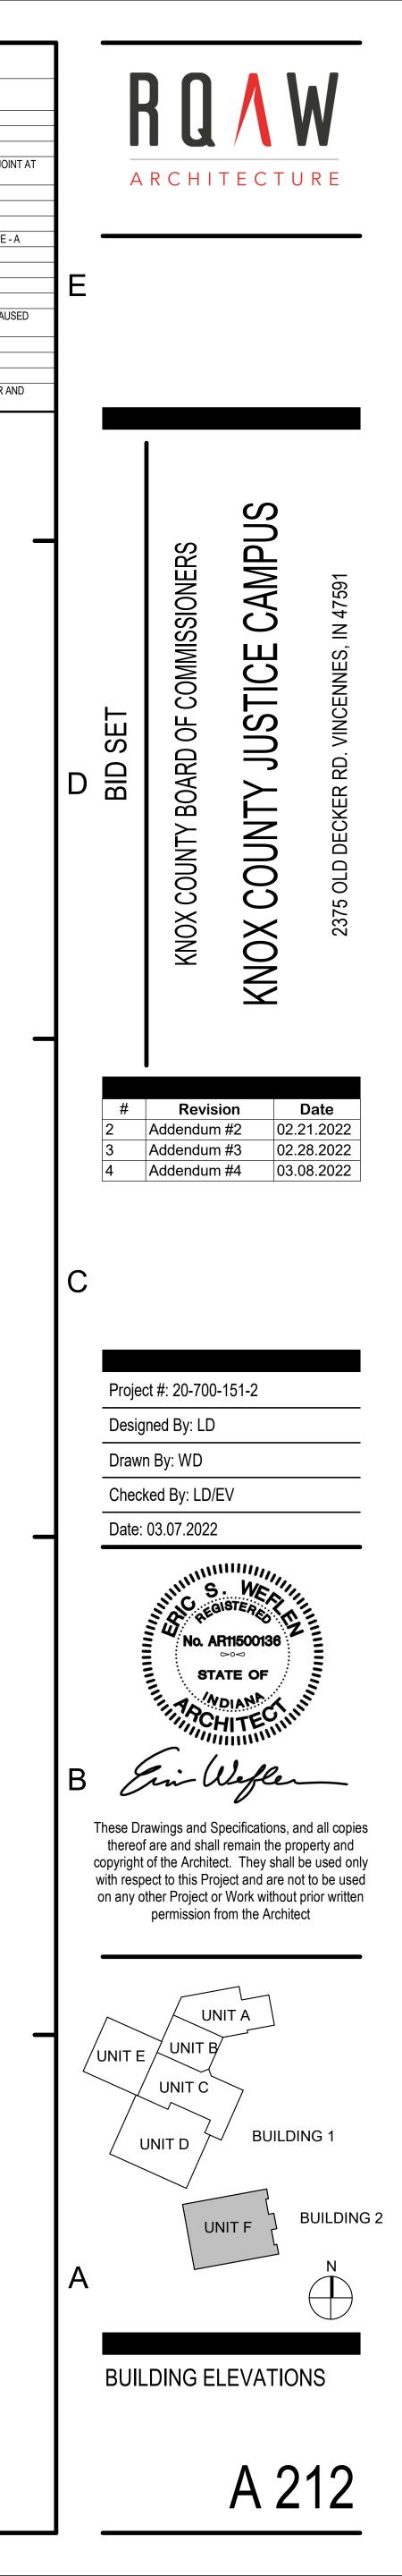

	_	
	٦	
-	,	

			5.4.0	601 - DOO	OR & FRA	AME	SCHI	EDULE -	BASE B	BID				
	From Room:	To Room:		D	OOR PAI	NEL	SIZ	Έ		FRAME		_	-	
MARK	PADDED	SECURED CORRIDOR	SGS5	MATL SHM	GLAZ	H 7' - 0"	W 3' - 0"	2"		MATL SHM	GLAZ	45 MIN.	HW Set	NOTE
1113 1114 1115.1	RR PADDED PADDED	SECURED CORRIDOR SECURED CORRIDOR SECURED CORRIDOR	SGS1 SGS5 SGS5	SHM SHM SHM	SG-FR2	7' - 0'	3' - 0" 3' - 6" 3' - 6"	2" b"A4	S1	SHM SHM SHM	 	45 MIN. 45 MIN.	S04.4 S01.5 S01.5	
1117 1119 1120.1	WAITING DAYROOM SECURED CORRIDOR	RR DAYROOM NURSE OFFICE	SGS1 SF SN	SHM SHM SHM		7' - 0" 7' - 0" 7' - 0"	3' - 0" 3' - 0" 3' - 0"	2" 2" 2"	S1	SHM SHM SHM	 SG2	45 MIN.	S04.1 S06.1 S04.1	
1120.2 1125	SECURED CORRIDOR BOOK IN CENTER	NURSE OFFICE PROPERTY STORAGE	SN SF	SHM SHM	SG2 	7' - 0" 7' - 0"	3' - 0" 3' - 0"	2" 2"	S6 S1	SHM SHM	SG2	90 MIN.	S04.1 S04.1	
1126 1127 1128A	NURSE OFFICE SECURED CORRIDOR	NURSE STORAGE STOR. EXAM	F F N	HM HM HM	 SG2	7' - 0" 7' - 0" 7' - 0"	3' - 0" 3' - 0" 3' - 0"	1 3/4" 1 3/4" 1 3/4"	F2 F1	HM HM HM	 		14.0 21.0 24.0	
1128B 1129 1139A	SECURED CORRIDOR DRESS PADDED	EXAM SECURED CORRIDOR RR	N SGS1 SF	HM SHM SHM	SG2 	7' - 0" 7' - 0" 7' - 0"	3' - 0" 3' - 0" 3' - 0"	1 3/4" 2" 2"	S1	HM SHM SHM	 	45 MIN.	24.0 S04.1 S01.4	
1139A.2 1139B 1139C	PADDED SECURED CORRIDOR RR	SECURED CORRIDOR RR PADDED	SGS5 SGS1 SGS1	SHM SHM SHM	SG2	7' - 0" 7' - 0" 7' - 0"	3' - 0" 3' - 0" 3' - 0"	2" 2" 2"		SHM SHM	 	45 MIN.	S04.4 S01.4	
1246.1 1246.2 1301.1	ELECT. ELECT.	ELECT.	F F	HM HM HM		7' - 0" 7' - 0" 7' - 0"	3' - 0" 3' - 0" 6' - 0"	1 3/4" 1 3/4" 1 3/4"	F2	HM HM HM	 	90 MIN.	20.0 5.0 18.5	
1501.1 1501.2 1501.3	SALLYPORT SALLYPORT SALLYPORT		SF OH OH	SHM ST ST			3' - 0" 16' - 0" 16' - 0"	2" 2" 2"	-	SHM ST ST			S09.1	
1501.4 1501.5 1501.6	SALLYPORT SALLYPORT SALLYPORT		SF OH OH	SHM ST ST		7' - 0" 14' - 0"	3' - 0" 16' - 0" 16' - 0"	2" 2" 2"	S1 -	SHM ST ST			S09.1	
1502 1503	SALLYPORT SALLYPORT	MATERIAL STORAGE MAINTENANCE WORK AREA	F	HM HM		7' - 0"	6' - 0" 3' - 0"	1 3/4" 1 3/4" A4	F2	HM HM			27.0 21.0	
1504 1505 1506	SALLYPORT PRE-PROCESS PREPROCESS HOLD	MAINT. OFFICE SALLYPORT PRE-PROCESS	F SDG SGP3	HM SHM SHM	SG2	7' - 0" 7' - 0" 7' - 0"	3' - 0" 3' - 6" 3' - 0"	1 3/4" 2" 2"	S2	HM SHM SHM	 SG2		28.0 S04.1 S01.1	
1507 1508	PREPROCESS HOLD GROUP HOLD	PRE-PROCESS BOOK IN CENTER	SGP3 SGP3	SHM SHM	SG2 SG2	7' - 0" 7' - 0"	3' - 0" 3' - 0"	2" 2"	S1 S1	SHM SHM	 		S01.1 S04.5	
1509 1510.1 1510.2	FILE STOR. PRE-PROCESS BREATH	PRE-PROCESS BREATH SALLYPORT	F SG G	HM SHM HM	SG2 SG2	7' - 0" 7' - 0" 7' - 0"	3' - 0" 3' - 0" 3' - 0		S1 F2	HM SHM HM	 		25.0 S04.1 15.0	
1511.1 1511.2 1511.5	BOOK IN CENTER SECURED CORRIDOR SECURE CORR.	PRE-PROCESS BOOK IN CENTER BOOK IN CENTER	SN SN SN	SHM SHM SHM	SG2	7' - 0" 7' - 0" 7' - 0	3' - 6" 3' - 6" 3' - 6"	2"A4 2" 2"		SHM SHM	SG2 	90 MIN. 90 MIN.	S04.1 S04.1	
1513 1514 1515	GROUP HOLD IT ROOM BOOK IN COUNTER	BOOK IN CENTER BOOK IN CENTER STAFF RR	SGP3 F	SHM HM HM		7' - 0" 7' - 0" 7' - 0"	3' - 0" 3' - 0" 3' - 0"	2" 1 3/4" 1 3/4"	F2	SHM HM HM	 		S01.1 25.0 31.0	
1516 1517 1518	BOOK IN COUNTER JAN DAYROOM	OFFICE BOOK IN CENTER BOOK IN CENTER	SN SF SGP2	SHM SHM SHM	SG2 	7' - 0" 7' - 0" 7' - 0"	3' - 0" 3' - 0" 3' - 0"	1 3/4" 2" 2"	S5 S1	SHM SHM SHM	SG2 SG2		S04.1 S04.1 S04.1	
1519 1520	DAYROOM DAYROOM	ISO.	SGS2 F	SHM HM	SG2 	7' - 0" 7' - 0"	3' - 0" 2' - 4"	2" 1 3/4"	S1 F2	SHM HM			S01.2 24.0	
1521 1522 1523	DAYROOM GROUP HOLDING DAYROOM	ISO. DAYROOM ISO.	SGS2 SGP3 SGS2	SHM SHM SHM	SG2 SG2	7' - 0" 7' - 0" 7' - 0"	3' - 0" 3' - 0" 3' - 0"	2" 2" 2"	S1 S1	SHM SHM SHM	 		S01.2 S01.2 S01.2 S01.2	
1524 1525 1526	DAYROOM DAYROOM DAYROOM	ISO. ISO.	F SGS2 SGS2	HM SHM SHM	SG2 SG2	7' - 0" 7' - 0" 7' - 0"	2' - 4" 3' - 0" 3' - 0"	1 3/4" 2" 2"	S1 S1	HM SHM SHM	 		24.0 S01.2 S01.2	
1527 1528 1529	DAYROOM DAYROOM ISO.	ISO. DAYROOM	F SGS2 SGS2	HM SHM SHM	SG2	7' - 0" 7' - 0" 7' - 0"	2' - 4" 3' - 0" 3' - 0"	1 3/4" 2" 2"	S1	HM SHM SHM	 		24.0 S01.2 S01.2	
1531.1 1531.2 1531A	SHOWER SHOWER STORAGE	DAYROOM BOOK IN CENTER BOOK IN CENTER	SGS1 SGS1 F	SHM SHM HM	SG2	7' - 0"	3' - 0" 3' - 0" 2' - 4"	2" 2" 1 3/4"	S1	SHM SHM HM	 		S04.2 S04.1 24.0	
1532 1542 1544	MECHANICAL DRY STORAGE PADDED	KITCHEN STORAGE	F F SF	HM HM SHM			6' - 0" 3' - 0" 3' - 0"	1 3/4" 1 3/4" 2"	F2	HM HM SHM		90 MIN.	7.0 S01.4	
1546 1559.6 1559.7	PADDED	RR MECHANICAL MECHANICAL	SF F SF	SHM HM SHM		7' - 0" 7' - 0" 7' - 0"	3' - 0" 6' - 0" 3' - 0"	2" 1 3/4" 2"		SHM		90 MIN. 90 MIN.	S01.4	
1559.8 1602.1	OFFICE	MECHANICAL OUTDOOR RECREATION	F SF	HM SHM		7' - 0" 7' - 0"	3' - 0"	1 3/4" 2"	F2	SHM		90 MIN.	S04.1	
1603 1604 1604.2	DETENTION CORRIDOR STOR. OUTDOOR RECREATION	PROGRAMMING PROGRAMMING	SG F SGS4	SHM HM SHM			3' - 6" 3' - 0" 3' - 0"	2" 1 3/4" 2"	F2	SHM SHM SHM		90 MIN.	S04.1 21.0 S04.3	
1605 1606	DETENTION CORRIDOR STOR.	VIDEO COURT VIDEO COURT	SF F	SHM HM	SG2 	7' - 0" 7' - 0"	3' - 0" 3' - 0"	2" 1 3/4"	S1 F2	SHM SHM			S04.1 24.0	
1607 1608.1 1608.2	JAN. INDOOR/OUTDOOR REC OUTDOOR RECREATION	DETENTION CORRIDOR DETENTION CORRIDOR INDOOR/OUTDOOR REC		HM SHM SHM	SG-FR2	7' - 0" 7' - 0" 7' - 0"	3' - 0" 3' - 0" 3' - 0"	1 3/4" 2" 2"	S1	SHM SHM SHM	 	45 MIN. 45 MIN.	24.0 S04.3 S04.1	
1609 1610.1	INDOOR/OUTDOOR REC	RR SALLYPORT	SF SF	SHM SHM		7' - 0" 7' - 0"	3' - 0"	2" 2"	S1	SHM SHM	 		S04.4 S04.1	
1610.2 1611 1612.1	SALLYPORT STOR. MECHANICAL	SALLYPORT SALLYPORT	SF F F	SHM HM HM	SG2 SG2	7' - 0" 7' - 0" 7' - 0"	3' - 0" 3' - 0" 6' - 0"	2" 1 3/4" 1 3/4"	F2 F2	SHM HM HM	 		S09.1 21.0 27.5	
1612.2 1612.3 1614.1	MECH. DETENTION CORRIDOR	MECHANICAL MECHANICAL DAYROOM	F F SGS4	HM HM SHM	SG2	7' - 0" 7' - 0" 7' - 0"	6' - 0" 3' - 0" 3' - 0"	1 3/4" 1 3/4" 2"	F2	HM HM SHM	 	45 MIN.	27.5 24.0 S04.3	
1614.2 1614.3 1615.1	DAYROOM INDOOR/OUTDOOR REC DAYROOM	DAYROOM DAYROOM DETENTION CORRIDOR	SF SF SGS4	SHM SHM SHM		7' - 0" 7' - 0" 7' - 0"	3' - 0" 3' - 0" 3' - 0"	2" 2" 2"	S1	SHM SHM SHM	 	45 MIN.	S06.1 S06.1 S04.3	
1616.1 1616.2 1617	DETENTION CORRIDOR DAYROOM DAYROOM	DAYROOM DAYROOM 4 BED ADA CELL	SGS4 SF SGP2	SHM SHM SHM		7' - 0" 7' - 0" 7' - 0"	3' - 0" 3' - 0" 3' - 0"	2" 2" 2"	S1	SHM SHM SHM	 SG2		S04.3 S06.1 S01.3	
1618 1619 1620	DAYROOM DAYROOM DAYROOM	4 BED CELL 4 BED CELL 4 BED CELL	SGP2 SGP2 SGP2	SHM SHM SHM	SG2 SG2	7' - 0" 7' - 0"	3' - 0" 3' - 0" 3' - 0"	2" 2" 2"	S2 S2	SHM SHM SHM	SG2 SG2 SG2		S01.3 S01.3 S01.3	
1621 1622 1623	DETENTION CORRIDOR DAYROOM DAYROOM	A BED CELL 4 BED CELL	SGS4 SGP2 SGP2	SHM SHM SHM	SG2 SG2	7' - 0" 7' - 0" 7' - 0"	3' - 0" 3' - 0" 3' - 0"	2" 2" 2"	S1 S2	SHM SHM SHM	 SG2 SG2		S01.3 S01.3 S01.3 S01.3	
1624 1639	DAYROOM ATRNY/CLIENT DETENTION CORRIDOR	4 BED CELL DETENTION CORRIDOR ATRNY/CLIENT	SGP2 SG	SHM SHM SHM	SG2 SG2	7' - 0" 7' - 0" 7' - 0"	3' - 0" 3' - 0" 3' - 0"	2" 2" 2"	S2 S1	SHM SHM SHM	SG2		S01.3 S04.3 S04.1	
1640 1641.1 1642	DETENTION CORRIDOR DETENTION CORRIDOR DETENTION CORRIDOR	CLASSROOM OFFICE	SG SG SG	SHM SHM	SG2 SG2	7' - 0" 7' - 0"	3' - 0" 3' - 0"	2" 2"	S1 S1	SHM SHM	 		S04.1 S04.1	
1643 1644.1 1644.2		OFFICE TRAINING ROOM TRAINING ROOM	F F	HM HM HM		7' - 0"	3' - 0" 3' - 0" 3' - 0"	1 3/4" 1 3/4" 1 3/4"	F2 F2	HM HM HM	 	90 MIN. 90 MIN. 90 MIN.	29.5 29.5 29.5	
1644A.1 1644A.2 1659	STORAGE STORAGE MECH.	TRAINING ROOM TRAINING ROOM	F F F	HM HM HM		7' - 0" 7' - 0" 7' - 0"	6' - 0" 6' - 0" 3' - 0"	1 3/4" 1 3/4" 1 3/4"	F1	HM HM HM	 		27.5 27.5 24.5	
1659.1 1659.5 1661.1	SALLYPORT	MECHANICAL MECHANICAL MECHANICAL	SF F F	SHM HM HM		7' - 0" 7' - 0" 7' - 0"	3' - 6" 6' - 0" 8' - 0"	2" 1 3/4" 1 3/4"	F2	HM HM HM	 	90 MIN. 45 MIN.	7.0	
1661.2 1661.3 2601A	MECH. MECHANICAL CORRIDOR	MECHANICAL MECH. STORAGE	F F F	HM HM HM		7' - 0" 7' - 0" 7' - 0"	3' - 0" 3' - 0" 3' - 0"	1 3/4" 1 3/4" 1 3/4"	F2	HM HM HM	 	45 MIN. 45 MIN.	23.5 23.5 24.5	
2602 2603 2604	CONTROL SECURITY ELECTRONICS CORRIDOR	CORRIDOR CONTROL RR	F F	HM HM HM		7' - 0" 7' - 0" 7' - 0"	3' - 0" 3' - 0" 3' - 0"	1 3/4" 1 3/4" 1 3/4"	F2	HM HM HM			24.5 13.0 31.0	
2606 2608 2608.1	DORM MEZZANINE MEZZ.	DORM MEZZANINE 4 BED CELL	SF SGP2 OH	SHM SHM ST	 SG2	7' - 0" 7' - 0" 6' - 0"	3' - 0" 3' - 0" 7' - 4"	2" 2" 1 3/4"	S1 S2	SHM SHM ST	 SG2		S06.1 S01.3	
2610 2611	MEZZ. MEZZ.	4 BED CELL 4 BED CELL	SGP2 SGP2	SHM SHM	SG2 SG2	7' - 0" 7' - 0"	3' - 0" 3' - 0"	2" 2"	S2 S2	SHM SHM	SG2 SG2		S01.3 S01.3	
2612 2613 2614	MEZZ. MEZZ. MEZZ.	4 BED CELL MEZZ. 4 BED CELL	SGP2 SF SGP2	SHM SHM SHM	 SG2	7' - 0" 7' - 0" 7' - 0"	3' - 0" 3' - 0" 3' - 0"	2" 2" 2"	S1 S2	SHM SHM SHM	SG2 SG2		S01.3 S06.1 S01.3	
2615 2616 ST01.1	MEZZ. MEZZ. DETENTION CORRIDOR	4 BED CELL 4 BED CELL STAIRS	SGP2 SGP2 SN	SHM SHM SHM	SG2 SG-FR2	7' - 0" 7' - 0"	3' - 0"	2" 2" 2"	S2 S1	SHM SHM SHM	SG2 SG2 	45 MIN.	S01.3 S01.3 S04.1	
ST01.2			F		SG2	-	3' - 0" SIZE	1 3/4"			 		8.0	
MARK	DAYROOM	To Room: Name	SGP2	SHM SC		- 0" 3'.	W - 0" 2	" S6		M SG		S0	6.1	OTES
1534 1535 1536	ISO. CHASE ISO.	DAYROOM DAYROOM DAYROOM	F SGS2	SHM SC HM SHM SC	7' - G2 7' -	0" 2'· 0" 3'·	- 4" 1 - 0" 2	3/4" F2 " S1	SH	M		S0 24. S0	0 1.2	
1537 1538 1539	ISO. DAYROOM ISO.	DAYROOM GROUP HOLDING DAYROOM	SGS2 SGP3	SHM SC SHM SC SHM SC	G2 7' - G2 7' -	0" 3'· 0" 3'·	- 0" 2 - 0" 2	" S1 " S1	SH SH SH	M M		S0 S0 S0	1.2 1.2	
1539	CHASE ISO.	DAYROOM DAYROOM DAYROOM	F	HM SHM SC	7' -		- 4" 1	3/4" F2 " S1				24. S0	0	

•

•	5.4.601 - DOOR & FRAME SCHEDULE - ALTERNATE "D"													•			5.4.6	601 - DC	OOR &	FRAM	E SCHE		E - CO	MMUN	ITY CO	RRE	CTIONS				
					DOOR P				FRAME												DOOR	PANE	L			FR					
MARK	From Room: Name	To Room: Name	TYPE	MAT	L GLAZ		SIZE N 1			GLAZ	LABEL	HW Set	NOTES	MARK	MAF		From Room: Name	To Room: Name	TYPE	ΜΑΤΙ			SI		H MA			GLAZ LABEL	HDWR SET	NOTES	MARK
1630.1	DETENTION CORRIDOR DETENTION CORRIDOR	FUTURE BUILD-OUT FUTURE BUILD-OUT	SGS4 SGS4	SHM SHM	SG2 SG2	7' - 0" 3' - 0 7' - 0" 3' - 0	0" 2"	S1 S1	SHM SHM			S04.3 S04.3		1625.1 1630.1	100A.1 100A.2		TIBULE LIC LOBBY	VESTIBULE	DG DG	AL	IG		6' - 0" 6' - 0"	1 3/4" 1 3/4"	A2 A2	AL		IG	1.0		100A.1 100A.2
	FUTURE BUILD-OUT FUTURE BUILD-OUT	DETENTION CORRIDOR	F	SHM HM ST	SG2	7' - 0" 3' - 0 7' - 0" 8' - 0 18' - 0" 12' - 0	0" 1 3/4	S1 4" F2	SHM HM ST			S04.3 7.0		1635.1 1646.1 1646.2	101 102	PUB PUB	LIC LOBBY LIC LOBBY	WOMEN RR MEN RR	F F	WD WD		7' - 0' 7' - 0'	3' - 0" 3' - 0"	1 3/4" 1 3/4"	F1 F1	HM HM			31.0 31.0		101 102
1663.5	DETENTION CORRIDOR FUTURE BUILD-OUT	FUTURE BUILD-OUT	SGS4	SHM SHM	 SG2 	7' - 0" 3' - 0 7' - 0" 3' - 0	0" 2"	- S1 S1	SHM SHM			S04.1 S09.1		1663.5 1663.6	103 104 105	COR	LIC LOBBY	STAFF WORK AREA STAFF RR CORRIDOR	F	WD WD WD		7' - 0'	3' - 0" 3' - 0"	1 3/4" 1 3/4"	F1 F1	HM HM HM			9.0 31.0		103 104
					·		•							<u> </u>	105 106 106.2	OFF OFF	ICE	CORRIDOR CORRIDOR OFFICE	G N	WD WD HM	 TG TG	7' - 0'	3' - 0" 3' - 0" 3' - 0"	1 3/4" 1 3/4" 1 3/4"	F1 F3 F1	HM HM HM		 TG 	21.0 28.0 28.0		105 106 106.2
			546	601 - D		RAME SO		JLE - ALTE	RNATF "	'D1"					107 108	COR COR	RIDOR RIDOR	BREAK ROOM OFFICE	G G	WD WD	TG TG	7' - 0" 7' - 0"	3' - 0" 3' - 0"	1 3/4" 1 3/4"	F3 F3	HM HM		TG TG	33.0 28.0		107 108
											1				109 110 111	COR	RIDOR RIDOR RIDOR	JAN. OFFICE OFFICE	G G	WD WD WD	 TG TS	7' - 0'	3' - 0" 3' - 0" 3' - 0"	1 3/4" 1 3/4" 1 3/4"	F1 F3 F3	HM HM HM	-	 TG TG	21.0 28.0 28.0		109 110 111
	From Room:	To Room:			DOOR P		SIZE		FRAME		-				112.1 112.2	COR COR	RIDOR RIDOR	A4		HM HM	TG TG	7' - 0' 7' - 0'	3' - 0" 3' - 0"	1 3/4" 1 3/4"	F2 F2	HM HM	-		3.0 3.0		112.1 112.2
MARK	Name	Name	TYPE	MAT	L GLAZ	Η \	N 7	TH MAR	MATL	GLAZ	LABEL	HW Set	NOTES	MARK	113 114 115		A RIDOR RIDOR	CORRIDOR STAFF RR CONFERENCE	F	WD WD	 TG	7' - 0'	3' - 0" 3' - 0" 3' - 0"	1 3/4" 1 3/4" 1 3/4"	F1 F1 F3	HM HM HM	-	 TG	24.0 31.0 33.0		113 114 115
	DAYROOM	DAYROOM FUTURE BUILD-OUT	SF SF	SHM SHM		7' - 0" 3' - 0 7' - 0" 3' - 0 7' - 0" 3' - 0)" 2"	S1 S1	SHM			S06.1 S06.1	N/A N/A	1625 1625.2	116 117.1	COR	RIDOR GRAMMING	OFFICE CORRIDOR	G G	WD WD	TG TG	7' - 0'	3' - 0" 3' - 0"	1 3/4" 1 3/4"	F3 F3	HM HM		TG TG	28.0 17.0		116 117.1
1627	DAYROOM DAYROOM DAYROOM	4 BED ADA CELL 4 BED CELL 4 BED CELL	SGP2 SGP2 SGP2	SHM SHM SHM	SG2 SG2 SG2	7' - 0" 3' - 0 7' - 0" 3' - 0 7' - 0" 3' - 0 7' - 0" 3' - 0)" 2"	S2 S2 S2	SHM SHM SHM	SG2 SG2 SG2		S01.3 S01.3 S01.3	N/A N/A N/A	1626 1627 1628	117.2 118	COR	I'S CORRIDOR RIDOR	PROGRAMMING OFFICE	G G	HM WD	TG TG	7' - 0'	3' - 0" 3' - 0"	1 3/4" 1 3/4"	F1 F3	HM HM	-	 TG	30.0 28.0		117.2 118
1629	DAYROOM CLASSROOM	4 BED CELL STOR.	SGP2 F	SHM HM	SG2 	7' - 0" 3' - 0 7' - 0" 3' - 0)" 2"	S2 4" F2	SHM HM	SG2 		S01.3 21.0	N/A N/A	1629 1650	118.2 119 120		ICE RIDOR IY SCAN	OFFICE OFFICE CORRIDOR	G	HM WD HM	TG TG 	7' - 0'	3' - 0" 3' - 0" 3' - 0"	1 3/4"	F1 F3 F1	HM HM HM		 TG 	28.0 28.0 10.0		118.2 119 120
1658 2617.1	FUTURE BUILD-OUT	STORAGE MEZZANINE	F SF	HM SHM		7' - 0" 3' - 0 7' - 0" 3' - 0 7' - 0" 3' - 0)" 2"	4" F2 S1	HM			24.5 S06.1	N/A	1658 2617.1 2618	121 122		Y SCAN	WAITING DRUG	N F	HM	TG 	7' - 0'	3' - 0" 3' - 0"	1 3/4"	F1 F1	HM HM			10.0 31.0		121 122
2618 2619 2620		4 BED CELL 4 BED CELL 4 BED CELL	SGP2 SGP2 SGP2	SHM SHM SHM	SG2 SG2 SG2	7' - 0" 3' - 0 7' - 0" 3' - 0 7' - 0" 3' - 0 7' - 0" 3' - 0	D" 2"	S2 S2 S2	SHM SHM SHM	SG2 SG2 SG2		S01.3 S01.3 S01.3	N/A N/A N/A	2618 2619 2620	123 124		RIDOR	TEST RR RR CORRIDOR	F	WD WD	 TG		3' - 0" 3' - 0"	1 3/4" 1 3/4"	F1	HM		 TG	31.0 30.0		123
2621		4 BED CELL	SGP2	SHM	SG2	7' - 0" 3' - ()" 2"	S2		SG2		S01.3	N/A	2621	125.1 125.2	COR	RIDOR MEN'S CORRIDOR	PROGRAMMING PROGRAMMING	G	WD HM	TG TG	7' - 0'	3' - 0" 3' - 0"	1 3/4" 1 3/4"	F3 F1	HM HM		TG	17.0 30.0		125.1 125.2
			5.4.6	601 - D	OOR & FF	RAME SC	CHEDU	JLE - ALTE	RNATE "	D2"					126.1 126.2	WON	CORRIDOR MEN'S CORRIDOR	WOMEN'S CORRIDOR	N N	HM	TG	7' - 0'	3' - 0" 3' - 0"	1 3/4"	F1 F2	HM HM	-		14.0 3.0		126.1 126.2
					DOOR P				FRAME						127 128.1	WON WAI	MEN'S CORRIDOR	EXIT CORRIDOR WOMEN'S LOCKER	F	НМ	A		3' - 0" 3' - 0"	1 3/4" 1 3/4"	F3 F1	HM HM		TG 	14.0 30.7		127 128.1
MARK	From Room: Name	To Room: Name	TYPE	MAT	L GLAZ		SIZE N 1	TH MARK	MATL	GLAZ	LABEL	HW Set	NOTES	MARK	128.2		MEN'S CORRIDOR	WOMEN'S LOCKER	F	HM	-		3' - 0"		F1	HM			30.7		128.2
	DAYROOM	4 BED ADA CELL	SGP2	SHM	SG2	7' - 0" 3' - (S2		SG2		S01.3		1631	129 130	WAI WAI	IY SCAN TING	WAITING DRUG TEST RR	F	HM HM	TG 		3' - 0" 3' - 0"	1 3/4" 1 3/4"	F1 F1	HM HM			10.0 17.0		129 130
1633	DAYROOM DAYROOM DAYROOM	4 BED CELL 4 BED CELL 4 BED CELL	SGP2 SGP2 SGP2	SHM SHM SHM	SG2 SG2 SG2	7' - 0" 3' - 0 7' - 0" 3' - 0 7' - 0" 3' - 0 7' - 0" 3' - 0)" 2"	S2 S2 S2	SHM SHM SHM	SG2 SG2 SG2		S01.3 S01.3 S01.3		1632 1633 1634	131.1	MEN LOC	KER	WAITING	F	HM			3' - 0"		F1	HM			30.7		131.1
2622 2623	MEZZANINE	MEZZANINE 4 BED CELL	SF SGP2	SHM SHM	 SG2	7' - 0" 3' - 0 7' - 0" 3' - 0)" 2")" 2"	S1 S2	SHM SHM	 SG2		S06.1 S01.3		2622 2623	131.2 132		I'S CORRIDOR	MEN'S LOCKER JAN.	F	HM			3' - 0" 3' - 0"		F1	HM			30.7		131.2
2624 2625	MEZZANINE MEZZANINE	4 BED CELL 4 BED CELL 4 BED CELL	SGP2	SHM SHM	SG2 SG2 SG2	7' - 0" 3' - 0 7' - 0" 3' - 0)" 2"	S2 S2	SHM	SG2 SG2 SG2		S01.3 S01.3 S01.3		2624 2625	133 134.1			RR MENS CORRIDOR	F	WD	 TG	7' - 0' 7' - 0'	3' - 0" 3' - 0"	1 3/4" 1 3/4"	F1 F1	HM HM			31.0 14.0		133 134.1
2020	MEZZANINE	4 BED CELL	SGP2	SHM	362	7' - 0" 3' - (J 2	52		562		501.3		2626	A4 134.2	MEN	I'S CORRIDOR I'S SOKRIDOR MEN'S CORRIDOR	EXIT CORRIDOR MED. STORAGE	N	HM	IG IG	7' - 0'	3' - 0" 3' - 0" 3' - 0"	1 3/4" 1 3/4" 1 3/4"	F2 F3 F1	HM HM HM		 TG	3.0 10.0 13.0		134.2 135 136
			5.4.6	601 - D	OOR & FI	RAME SO	CHEDI	JLE - ALTE	RNATE '	'D3''					137 138	WOM	MEN'S CORRIDOR	JANITOR MED. STORAGE	F N	HM	 TG	7' - 0'	3' - 0" 3' - 0"	1 3/4" 1 3/4"	F1 F1	HM HM			21.0 13.0		137 138
					DOOR P				FRAME			_			139 140	MEN	I'S CORRIDOR I'S CORRIDOR	COMMISSARY JANITOR	N F	HM HM	TG 	7' - 0'	3' - 0" 3' - 0"	1 3/4" 1 3/4"	F1 F1	HM HM			13.0 21.0		139 140
MARK	From Room: Name	To Room: Name	TYPE	МАТ	L GLAZ		SIZE N 1		MATL	GLAZ	LABEL	HW Set	NOTES	MARK	141 142 144.1	EXIT	ERVATION CORRIDOR CORRIDOR	MEN'S CORRIDOR STORAGE MEAL PREP	GS F N	HM HM HM	SG1 TG	7' - 0'	3' - 0" 3' - 0" 3' - 0"	1 3/4" 1 3/4" 1 3/4"	F2 F1 F1	HM HM HM	-		17.5 21.0 30.5		141 142 144.1
1630.2	DAVROOM	DAYROOM	SF	SHM		7' - 0" 3' - (7' - 0" 3' - (S1	SHM			S06.1		1630.2	144.2 145	IT	MEN'S CORRIDOR	MEAL PREP WOMEN'S CORRIDOR	N F	HM HM	TG 	7' - 0" 7' - 0"	3' - 0" 3' - 0"		F1 F1	HM HM	-		30.5 13.0		144.2 145
1637	DAYROOM DAYROOM DAYROOM	4 BED ADA CELL A BED CELL 4 BED CELL	SGP2 SGP2 SGP2	SHM SHM SHM	SG2 SG2 SG2	7' - 0" 3' - 0 7' - 0" 3' - 0 7' - 0" 3' - 0)" 2"	S2 S2 S2	SHM SHM SHM	SG2 SG2 SG2		S01.3 S01.3 S01.3		1636 1637 1638	146 147 148	WON	ERVATION MEN'S CORRIDOR FF RR	WOMEN'S CORRIDOR COMMISSARY WOMEN'S CORRIDOR	GS F	HM HM HM	SG1 	7' - 0'	3' - 0" 3' - 0" 3' - 0"	1 3/4" 1 3/4" 1 3/4"	F2 F2 F2	HM HM HM	-		17.5 13.0 31.0		146 147 148
2628	MEZZANINE MEZZANINE	4 BED CELL	SF SGP2	SHM SHM	 SG2	7' - 0" 3' - 0 7' - 0" 3' - 0)" 2")" 2"	S1 S2		 SG2		S06.1 S01.3		2627 2628	149 150.1	BOD	Y SCAN Y SCAN	WOMEN'S CORRIDOR MEN'S CORRIDOR	F F	HM		7' - 0'	3' - 0" 3' - 0"	1 3/4"	F1 F1	HM HM			15.0 15.0		149 150.1
	MEZZANINE MEZZANINE	4 BED CELL 4 BED CELL	SGP2 SGP2	SHM SHM	SG2 SG2	7' - 0" 3' - 0 7' - 0" 3' - 0		S2 S2		SG2 SG2		S01.3 S01.3		2629 2630	150.2 151.1	WO	MEN'S CORRIDOR MEN'S CORRIDOR	MEN'S CORRIDOR CONTROL	F G	HM HM	 SG1	7' - 0'	3' - 0" 3' - 6"		F2 F5	HM HM	;	 SG1	17.5 13.0		150.2 151.1
															151.2 152.1 152.2	MEC	I'S CORRIDOR CHANICAL	CONTROL MEN'S CORRIDOR	F F	HM HM HM	SG1 	7' - 0'	3' - 6" 3' - 0" 3' - 0"		F2 F2 F1	HM HM HM			13.0 23.0 6.0		151.2 152.1 152.2
															152.3 153.1	SALI WON	LYPORT MEN'S CORRIDOR	MECHANICAL MECHANICAL	F	HM HM		7' - 0'	3' - 0" 3' - 0"	1 3/4" 1 3/4"	F2 F2	HM HM		45 MIN. 45 MIN.	23.5 23.5		152.3 153.1
															153.2 153.3 154.1	SALI	CHANICAL LYPORT CHANICAL	MECHANICAL MECHANICAL	F F	HM HM HM		7' - 0'	3' - 0" 3' - 0" 3' - 0"	1 3/4" 1 3/4" 1 3/4"	F1 F2	HM HM HM			6.0 20.0 21.0		153.2 153.3 154.1
															154.1 154.2 155.1	MEC	HANICAL CHANICAL CHANICAL		F	HM HM HM		7' - 0'	3 - 0 6' - 0" 3' - 0"	1 3/4"	F1 F2	HM HM HM	-		7.0 19.0		154.1 154.2 155.1
															155.2 156.1	ELE(CTRICAL CTRICAL	MECHANICAL	F	HM HM		7' - 0' 7' - 0'	4' - 0" 3' - 0"	1 3/4" 1 3/4"	F1 F2	HM HM			5.0 19.0		155.2 156.1
							7	<u>GENERAL NO</u>	<u>TES</u>						156.2 157.1 157.2	SEC	CTRICAL URE VEST. URE VEST.	ELECTRICAL DAYROOM SALLYPORT	r N N	HM HM HM	 TG TG	7' - 0'	4' - 0" 3' - 0" 3' - 0"	1 3/4" 1 3/4" 1 3/4"	F2 F2 F2	HM HM HM	-		32.0 10.0 23.0		156.2 157.1 157.2
	IAL GLAZING REFERENCE	SPECIFICATION SECTION	ON 08 80 00) - GL A7INI	3		-	AFFORD THE	CONTRACTO	R. DO NOT (CONSIDER IT	OR WHATEVER A AS ENTIRELY INC PLANS) AND THE	LUSIVE. CAREF	ULLY	158.1 158.2	SEC SEC	URE VEST. URE VEST.	DAYROOM SALLYPORT	N N	HM HM	TG TG	7' - 0' 7' - 0'	3' - 0" 3' - 0"	1 3/4" 1 3/4"	F2 F2	HM HM	•	45 MIN. 45 MIN.	10.5 23.5		158.1 158.2
IG - TG -	1" CLEAR INSULAT 1/4" CLEAR TEMPE	ED TEMPERED GLAZIN	G WITH LOV	W-E COAT	ING.			DETERMINE T BORROWED L	HE EXTENT Ò ITE OR SIDEL	OF DOOR AN	id Frame Qu Igs). Shoule	PLANS) AND THE ANTITIES REQUIR ANY PARTICULA	RED (INCLUDING AR DOOR, FRAME	INTERIOR E, OR	159.1 159.2 162.1	DAY	ROOM ROOM ROOM	WOMEN'S CORRIDOR DAYROOM WOMEN'S CORRIDOR	F	HM HM HM	SG1 SG1	7' - 0'	3' - 0" 3' - 0" 3' - 0"	1 3/4"	F11 F2 F12	HM HM HM		SG1 45 MIN. SG1 45 MIN.	10.5 18.0		159.1 159.2 162.1
SP - FR1 -	FIRE LIGHT 90 MIN	l.						OMITTED FRO	M THIS SCHE	EDULE, SUPF	PLY SAME AS	N THE DRAWINGS REQUIRED FOR \$	SIMILAR OPENIN		162.1 162.2 165.1	DAY	ROOM ROOM ROOM	WOMEN'S CORRIDOR DAYROOM WOMEN'S CORRIDOR	F	HM HM HM	SG1 SG1	7' - 0'	3' - 0" 3' - 0" 3' - 0"	1 3/4" 1 3/4" 1 3/4"	F12 F2 F11	HM HM HM	-	SG1 45 MIN. SG1 45 MIN.	10.5 18.0 10.5		162.1 162.2 165.1
SECURITY GLAZING	ECURITY GLAZING REFERENCE SPECIFICATION SECTION 11 19 50 - DETENTION AND SECURITY AZING C. ALL COMMERCIAL 4'-0" WIDE DOORS TO HAVE CONTINUOUS HINGES. ALL SECURITY								RITY 4'-0"	165.2 168.1	DAY DAY	ROOM ROOM	DAYROOM MEN'S CORRIDOR	F DG	HM HM	 SG1	7' - 0' 7' - 0'	3' - 0" 3' - 0"	1 3/4" 1 3/4"	F2 F12	HM HM	-	 SG1 45 MIN.	18.0 10.5		165.2 168.1					
	YPE: SG-1 – 9/16" Nominal, glass clad polycarbonate Global Security Glazing SecurTem+Poly 2117 clear, asis of design. ASTM F-1915 security grade 4, 10 minute containment rated. D. ALL COMMERCIAL DOORS IN DETENTION/SECURITY AREAS TO RECEIVED DETENTION									168.2 171.1 171.2	DAY	ROOM ROOM ROOM	DAYROOM MEN'S CORRIDOR DAYROOM	F DG F	HM HM HM	 SG1 	7' - 0'	3' - 0" 3' - 0" 3' - 0"	1 3/4" 1 3/4" 1 3/4"	F2 F12 F2	HM HM HM	:	45 MIN. SG1	18.0 10.0 18.0		168.2 171.1 171.2					
	– 11/16" Nominal, glass clad 5 Security Grade 3 (20 min) a					ear,		GLAZING SG-			TION/SEGUK	III ANEAG IU KE	JEIVED DETEN		171.2 171.3 174.1	STO	ROOM RAGE ROOM	MEN'S CORRIDOR	F F DG	HM HM HM	 SG1	7' - 0'		1 3/4"	F1 F13	HM HM HM		 SG1	27.5 10.0		171.2 171.3 174.1
	M – 15/16" Nominal Mirrored SG-2 above + mirror) Note: Li				g SecurTem+Po	ly		REMARKS	HEDULE						174.2 177.1	DAY DAY	ROOM ROOM	DAYROOM MEN'S CORRIDOR	F DG	HM HM	 SG1	7' - 0' 7' - 0'	3' - 0" 3' - 0"	1 3/4" 1 3/4"	F2 F11	HM HM	-	 SG1	18.0 10.0		174.2 177.1
TYPE: SG-3	-3/4" Nominal, clear glass cla gn. ASTM F-1915 Security G	ad polycarbonate, Global	Security Glaz	zing Secur				1. MODIFY H	ARDWARE SE			PADDED PANEL I ALLATION IN COI		R PANFI	177.2 180 183		ROOM ROOM	DAYROOM MEN'S CORRIDOR SALLYPORT	F DG N	HM HM HM	 SG1	7' - 0'	3' - 0" 3' - 0" 3' - 0"	1 3/4"	F2 F13 F2	HM HM HM	;	 SG1	18.0 10.0 3.0		177.2 180 183
TYPE:SG-3	M – 1" Nominal, mirrored glas	s clad polycarbonate, Glo	bal Security	Glazing Se	curTem+Poly Se	ecurity		3. DOOR SCO ALTERNAT)PE AND ALL . E.	ASSOCIATE	D FRAMES, AI	NCHORS AND INS	TALLATION IS P.	ART OF	200 201		ZANINE	MEZZANINE MEZZANINE	F	HM HM HM		7' - 0'	3' - 0" 3' - 0" 3' - 0"	1 3/4"	F2	HM HM HM	-		18.0 18.0		200 201
product.	min) and ASTM F-1233 body	-	-	-				STEEL SH 5. EXTERIOF	ELF ON BOTT	OM LEAF SS DOOR, PI		ACH DOOR LEAF. ESHOLDS AND DC			202 203	MEZ MEZ	ZANINE ZANINE	MEZZANINE MEZZANINE	F	HM HM		7' - 0' 7' - 0'	3' - 0" 3' - 0"	1 3/4" 1 3/4"	F2 F2	HM HM			18.0 18.0		202 203
of design. A	- 1" nominal, clear glass clad STM F-1915 Security Grade 1	1 (60 min) rated.	-	-							THRESHOLDS	, AND PASS PRO	OF DOOR SEALS	AT THE	204 206 207	MEZ	ZANINE ZANINE ZANINE	MEZZANINE MEZZANINE MEZZANINE	F F	HM HM HM		7' - 0'			F2 F2 F2	HM HM HM	-		18.0 18.0 18.0		204 206 207
SP-028M ba	M 1-1/8" nominal, mirrored gl sis of design. ASTM F-1915 \$ 8:1 lighting ratio required to b	Security Grade 1 (60 min)	ilobal Securi rated. Note:	ity Glazing : mirrored g	SecurTem+Poly lass to be on #1			7. DOOR IS E 8. PROVIDE	ELETED FRO			ALTERNATE IS A DOR, AND FRAME			201		····· ·=		1	1	1	1, -0	10 0		1, 2	1 1111	<u> </u>	l			<u> </u>

5.4.601 - DOOR & FRAME SCHEDULE - ALTERNATE "D"												•		5.4.0	601 - DC	DOR & FR	AME SCH	EDULE	- CON	IMUNITY C	ORRE	CTIONS			
			DOOR P			FRAME		_	_				_			D	OOR PANI	EL		F	RAME				
From Room:MARKName	To Room: Name	TYPE MATL	L GLAZ	H W		RK MATL	GLAZ	LABEL	HW Set	NOTES	MARK	MAR	From Room: Name	To Room: Name	TYPE	MATL	GLAZ H	SIZ I W		MARK	MATL	GLAZ LABEL	HDWR SET	NOTES	MARK
	FUTURE BUILD-OUT FUTURE BUILD-OUT	SGS4 SHM SGS4 SHM	SG2 SG2	7' - 0" 3' - 0" 7' - 0" 3' - 0"	2" S1 2" S1	SHM SHM			S04.3 S04.3		1625.1 1630.1	100A.1 100A.2	VESTIBULE PUBLIC LOBBY	VESTIBULE	DG DG	AL I)" 6' - 0")" 6' - 0"	1 3/4" 1 3/4"	A2 A A2 A	AL	IG IG	1.0		100A.1 100A.2
1635.1 FUTURE BUILD-OUT 1646.1 FUTURE BUILD-OUT 1646.2 Image: Constraint of the second	DETENTION CORRIDOR	C SGS4 SHM F HM OH ST	SG2	7' - 0" 3' - 0" 7' - 0" 8' - 0" 18' - 0" 12' - 0"		SHM HM ST	 		S04.3 7.0		1635.1 1646.1 1646.2	101 102	PUBLIC LOBBY PUBLIC LOBBY	WOMEN RR MEN RR	F	WD - WD -	- 7' - - 7' -)" 3' - 0")" 3' - 0"	1 3/4" 1 3/4"		HM HM		31.0 31.0		101 102
1663.5DETENTION CORRIDOR1663.6FUTURE BUILD-OUT	FUTURE BUILD-OUT	SGS4SHMSFSHM	SG2	10''''''''''''''''''''''''''''''''''''	2" S1	SHM SHM			S04.1 S09.1		1663.5 1663.6	103 104 105	PUBLIC LOBBY CORRIDOR STORAGE	STAFF WORK AREA STAFF RR CORRIDOR	F	WD - WD - WD -	- 7' -)" 3' - 0")" 3' - 0")" 3' - 0"	1 3/4" 1 3/4" 1 3/4"	F1 H	HM HM HM		9.0 31.0 21.0		103 104 105
												105 106 106.2	OFFICE OFFICE	CORRIDOR OFFICE	G N	WD 1 WD 1 HM 1	G 7'-)" <u>3'-0"</u>)" <u>3'-0"</u>)" <u>3'-0"</u>	1 3/4" 1 3/4" 1 3/4"	F3 H	HM HM HM	 TG 	28.0 28.0		105 106 106.2
		5.4.601 - DC	OOR & F	RAME SCHI	EDULE - AL	ERNATE	"D1"					107 108	CORRIDOR CORRIDOR CORRIDOR	BREAK ROOM OFFICE	G G	WD 1 WD 1 WD -	-G 7'-)" 3' - 0")" 3' - 0"	1 3/4" 1 3/4"	F3 H	HM HM HM	TG TG	33.0 28.0 21.0		107 108 109
												109 110 111	CORRIDOR CORRIDOR CORRIDOR	JAN. OFFICE OFFICE	G G	WD 1	-G 7'-)" 3' - 0")" 3' - 0")" 3' - 0"	1 3/4" 1 3/4" 1 3/4"	F3 H	HM HM	TG TG	28.0 28.0 28.0		1109 110 111
From Room:	To Room:		DOOR P	ANEL SIZ	E	FRAME		_				112.1 112.2	CORRIDOR CORRIDOR	A4		HM 1 HM 1	G 7'-)" 3' - 0")" 3' - 0"	1 3/4" 1 3/4"	F2 H	HM HM		3.0 3.0		112.1 112.2
MARK Name	Name					RK MATL	GLAZ	LABEL		NOTES	MARK	113 114 115	DATA CORRIDOR CORRIDOR	CORRIDOR STAFF RR CONFERENCE	F G	WD - WD -	- 7' -)" 3' - 0")" 3' - 0")" 3' - 0"	1 3/4" 1 3/4" 1 3/4"	F1 H	HM HM HM	 TG	24.0 31.0 33.0		113 114 115
1625.2 DAYROOM	DAYROOM FUTURE BUILD-OUT 4 BED ADA CELL	SF SHM SF SHM SGP2 SHM	 SG2	7' - 0" 3' - 0" 7' - 0" 3' - 0" 7' - 0" 3' - 0"	2" S1 2" S1 2" S2	SHM	 SG2		S06.1 S06.1 S01.3	N/A N/A N/A	1625 1625.2 1626	116 117.1 117.2	CORRIDOR PROGRAMMING MEN'S CORRIDOR	OFFICE CORRIDOR PROGRAMMING	G G	WD 1 WD 1 HM 1	-G 7'-)" 3' - 0")" 3' - 0")" 3' - 0"	1 3/4" 1 3/4" 1 3/4"	F3 H	HM HM HM	TG TG	28.0 17.0 30.0		116 117.1 117.2
1627 DAYROOM 1628 DAYROOM	4 BED CELL 4 BED CELL	SGP2 SHM SGP2 SHM	SG2 SG2	7' - 0" 3' - 0" 7' - 0" 3' - 0"	2" S2 2" S2	SHM SHM	SG2 SG2		S01.3 S01.3	N/A N/A	1627 1628	117.2 118 118.2	CORRIDOR OFFICE	OFFICE OFFICE	G N	WD 1 HM 1	-G 7'-)" 3'-0")" 3'-0")" 3'-0"	1 3/4" 1 3/4" 1 3/4"	F3 H	HM HM	 TG 	28.0 28.0		117.2 118 118.2
1650 CLASSROOM	4 BED CELL STOR. STORAGE	SGP2 SHM F HM F HM	SG2 	7' - 0" 3' - 0" 7' - 0" 3' - 0" 7' - 0" 3' - 0"	2" S2 1 3/4" F2 1 3/4" F2	HM HM	SG2 		S01.3 21.0 24.5	N/A N/A	1629 1650 1658	119 120	CORRIDOR BODY SCAN	OFFICE CORRIDOR	G F	WD 1 HM -	- 7' -)" 3' - 0")" 3' - 0"	1 3/4" 1 3/4"	F1 H	HM HM	TG	28.0 10.0		119 120
2617.1	MEZZANINE 4 BED CELL	SF SHM SGP2 SHM	 SG2	7' - 0" 3' - 0" 7' - 0" 3' - 0"	2" S1 2" S2	SHM	 SG2		S06.1 S01.3	N/A	2617.1 2618	121 122	BODY SCAN WAITING	WAITING DRUG TEST RR	F	HM -)" 3' - 0")" 3' - 0"	1 3/4"		HM HM		10.0 31.0		121 122
2620	4 BED CELL 4 BED CELL	SGP2 SHM SGP2 SHM	SG2 SG2	7' - 0" 3' - 0" 7' - 0" 3' - 0"	2" S2 2" S2	SHM SHM	SG2 SG2		S01.3 S01.3	N/A N/A	2619 2620	123 124	CORRIDOR CORRIDOR	RR CORRIDOR	F G	WD - WD 1	-G 7'-)" 3' - 0")" 3' - 0"	1 3/4" 1 3/4"	F3 H	HM HM	 TG	31.0 30.0		123 124
	4 BED CELL	SGP2 SHM 5.4.601 - DC	SG2	7'-0" 3'-0"	2" S2		SG2		S01.3	N/A	2621	125.1 125.2 126.1	CORRIDOR WOMEN'S CORRIDOR EXIT CORRIDOR	PROGRAMMING PROGRAMMING WOMEN'S CORRIDOR	G G N	WD 1 HM 1	-G 7'-)" 3' - 0")" 3' - 0")" 3' - 0"	1 3/4" 1 3/4" 1 3/4"	F1 H	HM HM HM	IG	17.0 30.0 14.0		125.1 125.2 126.1
					, \ ,			1				126.1 126.2 127	WOMEN'S CORRIDOR WOMEN'S CORRIDOR	EXIT CORRIDOR	N		-G 7'-)" 3'-0")" 3'-0")" 3'-0"	1 3/4" 1 3/4"	F2 H	HM HM	 TG	3.0 14.0		126.2 127
From Room:	To Room:		DOOR P	ANEL SIZ	E	FRAME	-	-				128.1 128.2	WAITING WOMEN'S CORRIDOR	WOMEN'S LOCKER WOMEN'S	F	HM -)" 3' - 0")" 3' - 0"	1 3/4"		HM HM		30.7 30.7		128.1 128.2
MARK Name	Name	TYPE MATL	L GLAZ	H W	TH MA	RK MATL	GLAZ	LABEL	HW Set	NOTES	MARK	120.2	BODY SCAN	LOCKER WAITING	N	HM 1)" 3'-0"	1 3/4"		HM		10.0		120.2
1632 DAYROOM	4 BED ADA CELL 4 BED CELL	SGP2 SHM SGP2 SHM	SG2 SG2	7' - 0" 3' - 0" 7' - 0" 3' - 0"		SHM SHM	SG2 SG2		S01.3 S01.3		1631 1632	130 131.1	WAITING MEN'S	DRUG TEST RR WAITING	F	HM -)" 3' - 0")" 3' - 0"	1 3/4"		HM HM	-	17.0 30.7		130
1634 DAYROOM	4 BED CELL 4 BED CELL MEZZANINE	SGP2 SHM SGP2 SHM SF SHM	SG2 SG2	7' - 0" 3' - 0" 7' - 0" 3' - 0" 7' - 0" 3' - 0"	2" S2 2" S2 2" S1	SHM SHM SHM	SG2 SG2		S01.3 S01.3 S06.1		1633 1634 2622	131.2	LOCKER MEN'S CORRIDOR	MEN'S	F	HM -)" 3'-0"	1 3/4"		HM	-	30.7		131.2
2623 MEZZANINE	4 BED CELL 4 BED CELL	SFIM SFIM SGP2 SHM SGP2 SHM	SG2 SG2	7' - 0" 3' - 0" 7' - 0" 3' - 0" 7' - 0" 3' - 0"	2" S1 2" S2 2" S2	SHM SHM SHM	SG2 SG2		S01.3 S01.3		2623 2624	132	MEN'S CORRIDOR PROGRAMMING	LOCKER JAN. RR	F	HM -)" 3' - 0")" 3' - 0"	1 3/4"		HM HM		21.0 31.0		132 133
	4 BED CELL 4 BED CELL	SGP2SHMSGP2SHM	SG2 SG2	7' - 0" 3' - 0" 7' - 0" 3' - 0"	2" S2 2" S2	SHM SHM	SG2 SG2		S01.3 S01.3		2625 2626	134.2		MENSCORRIDOR	N	HM 1	G 7'- G 7'-)" 3' - 0")" 3' - 0"	1 3/4" 1 3/4"		HM HM		14.0 3.0		134.1 134.2
		5.4.601 - D0	OOR & F	RAME SCH	EDULE - AL	ERNATE	"D3"				/	135 136 137	MEN'S CORRIDOR WOMEN'S CORRIDOR WOMEN'S CORRIDOR	EXIT CORRIDOR MED. STORAGE JANITOR	N F	HM 1 HM -	G 7'- G 7'-)" 3' - 0")" 3' - 0")" 3' - 0"	1 3/4" 1 3/4" 1 3/4"	F1 H	HM HM HM	TG	10.0 13.0 21.0		135 136 137
												138 139	MEN'S CORRIDOR MEN'S CORRIDOR	MED. STORAGE COMMISSARY	N N	HM 1 HM 1	-G 7'- -G 7'-)" 3' - 0")" 3' - 0"	1 3/4" 1 3/4"		HM HM		13.0 13.0		138 139
From Room:	To Room:		DOOR P	ANEL SIZ	E	FRAME						140 141	MEN'S CORRIDOR OBSERVATION EXIT CORRIDOR	JANITOR MEN'S CORRIDOR STORAGE	F GS	HM - HM S HM -	G1 7' -)" 3' - 0")" 3' - 0")" 3' - 0"	1 3/4" 1 3/4" 1 3/4"	F2 H	HM HM HM		21.0 17.5 21.0		140 141 142
MARK Name	Name	TYPE MATL	L GLAZ	H W	TH MA	RK MATL	GLAZ	LABEL	HW Set	NOTES	MARK	142 144.1 144.2	EXIT CORRIDOR EXIT CORRIDOR WOMEN'S CORRIDOR	MEAL PREP MEAL PREP	N N	HM 1	-G 7'-)" 3'-0")" 3'-0")" 3'-0"	1 3/4"		HM HM		30.5 30.5		142 144.1 144.2
1636 DAYROOM	DAYROOM 4 BED ADA CELL A BED CELL	SFSHMSGP2SHMSGP2SHM	 SG2 SG2	7' - 0" 3' - 0" 7' - 0" 3' - 0" 7' - 0" 3' - 0"	2" S1 2" S2 2" S2	SHM SHM SHM	 SG2 SG2		S06.1 S01.3 S01.3		1630.2 1636 1637	145 146	IT OBSERVATION	WOMEN'S CORRIDOR WOMEN'S CORRIDOR	F GS		G1 7' -)" 3' - 0")" 3' - 0"	1 3/4" 1 3/4"	F2 H	HM HM		13.0 17.5		145 146
	4 BED CELL	SGP2 SHM SGP2 SHM SGP2 SHM SF SHM	SG2 SG2 	7' - 0" 3' - 0" 7' - 0" 3' - 0" 7' - 0" 3' - 0"		SHM SHM SHM	SG2 		S01.3 S01.3 S06.1		1638 2627	147 148 149	WOMEN'S CORRIDOR STAFF RR BODY SCAN	COMMISSARY WOMEN'S CORRIDOR WOMEN'S CORRIDOR		HM - HM - HM -	- 7' -)" 3' - 0")" 3' - 0")" 3' - 0"	1 3/4" 1 3/4" 1 3/4"	F2 H	HM HM HM		13.0 31.0 15.0		147 148 149
2629 MEZZANINE	4 BED CELL 4 BED CELL	SGP2 SHM SGP2 SHM	SG2 SG2	7' - 0" 3' - 0" 7' - 0" 3' - 0" 7' - 0" 3' - 0"		SHM SHM	SG2 SG2		S01.3 S01.3		2628 2629	150.1 150.2	BODY SCAN WOMEN'S CORRIDOR	MEN'S CORRIDOR MEN'S CORRIDOR	F F	HM - HM -	- 7' - - 7' -)" 3' - 0")" 3' - 0"	1 3/4" 1 3/4"	F2 H	HM HM		15.0 17.5		150.1 150.2
2630 MEZZANINE	4 BED CELL	SGP2 SHM	SG2	7' - 0" 3' - 0"	2" S2	SHM	SG2		S01.3		2630	151.1 151.2 152.1	WOMEN'S CORRIDOR MEN'S CORRIDOR MECHANICAL	CONTROL CONTROL MEN'S CORRIDOR	G G F		G1 7' -)" 3' - 6")" 3' - 6")" 3' - 0"	1 3/4" 1 3/4" 1 3/4"	F2 H	HM HM HM	SG1	13.0 13.0 23.0		151.1 151.2 152.1
												152.2 152.3	MECHANICAL SALLYPORT	MECHANICAL	F	HM - HM -	- 7' -)" 3' - 0")" 3' - 0"	1 3/4" 1 3/4"	F1 H	HM HM	45 MIN.	6.0 23.5		152.2 152.3
												153.1 153.2 153.3	WOMEN'S CORRIDOR MECHANICAL SALLYPORT	MECHANICAL	F	HM - HM - HM -	- 7' -)" 3' - 0")" 3' - 0")" 3' - 0"	1 3/4" 1 3/4"	F1 H	HM HM HM	45 MIN. 	23.5 6.0 20.0		153.1 153.2 153.3
												153.3 154.1 154.2	MECHANICAL MECHANICAL	MECHANICAL	F F	нм - НМ - НМ -	- 7' -)" 3' - 0")" 3' - 0")" 6' - 0"	1 3/4" 1 3/4" 1 3/4"	F2 H	HM HM HM		20.0 21.0 7.0		153.3 154.1 154.2
												155.1 155.2	MECHANICAL ELECTRICAL	ELECTRICAL	F	HM - HM -	- 7' - - 7' -)" 3' - 0")" 4' - 0"	1 3/4" 1 3/4"	F1 H	HM HM		19.0 5.0		155.1 155.2
Γ												156.1 156.2 157.1	ELECTRICAL ELECTRICAL SECURE VEST.	MECHANICAL ELECTRICAL DAYROOM	F N	HM - HM - HM 1	- 7' -)" 3' - 0")" 4' - 0")" 3' - 0"	1 3/4" 1 3/4" 1 3/4"	F2 H	HM HM HM		19.0 32.0 10.0		156.1 156.2 157.1
GLAZING						HIS DOOR SCHI				ASSISTANCE IT M		157.2 158.1	SECURE VEST. SECURE VEST.	SALLYPORT DAYROOM	N N	HM 1 HM 1	-G 7' - -G 7' -)" 3' - 0")" 3' - 0"	1 3/4" 1 3/4"	F2 H	HM HM	45 MIN.	23.0 10.5		157.2 158.1
COMMERCIAL GLAZING REFERENCE S IG 1" CLEAR INSULATE	D TEMPERED GLAZINO	ON 08 80 00 - GLAZING G WITH LOW-E COATII	G NG.		EXAMINE DETERMIN	HE DRAWINGS	(ESPECIALL OF DOOR A	Y THE FLOOF ND FRAME QU	R PLANS) AND TH JANTITIES REQUI	CLUSIVE. CAREF E SPECIFICATION RED (INCLUDING	s to Interior	158.2 159.1	SECURE VEST. DAYROOM DAYROOM	SALLYPORT WOMEN'S CORRIDOR DAYROOM	N DG	HM 1 HM 5 HM -	G1 7'-)" 3' - 0")" 3' - 0"	1 3/4" 1 3/4"	F11 H	HM HM HM	45 MIN. SG1 45 MIN.	23.5 10.5		158.2 159.1
TG - 1/4" CLEAR TEMPER SP - 1" INSULATED SPAN FR1 - FIRE LIGHT 90 MIN.	RED GLAZING. NDREL GLAZING PANEL				INTERIOR	BORROWED LIT	E OR SIDEL	ITE ŚHOWN C	N THE DRAWING	AR DOOR, FRAME S BE INADVERTEN SIMILAR OPENING	NTLY	159.2 162.1 162.2	DAYROOM DAYROOM DAYROOM	WOMEN'S CORRIDOR	F DG F		G1 7' -)" 3' - 0")" 3' - 0")" 3' - 0"	1 3/4" 1 3/4" 1 3/4"	F12 H	HM HM HM	 SG1 45 MIN. 	18.0 10.5 18.0		159.2 162.1 162.2
	R1 - FIRE LIGHT 90 MIN. ECURITY GLAZING REFERENCE SPECIFICATION SECTION 11 19 50 - DETENTION AND SECURITY LAZING									165.1 165.2	DAYROOM DAYROOM	WOMEN'S CORRIDOR DAYROOM	F	HM S HM -	G1 7' - - 7' -)" 3' - 0")" 3' - 0"	1 3/4" 1 3/4"	F11 H F2 H	HM HM	SG1 45 MIN.	10.5 18.0		165.1 165.2		
TYPE: SG-1 – 9/16" Nominal, glass clad po			+Poly 2117 clea	ar,		MMERCIAL 4'-0" RS TO HAVE 4 F		RS TO HAVE C	CONTINUOUS HIN	GES. ALL SECURI	TY 4'-0"	168.1 168.2 171 1	DAYROOM DAYROOM DAYROOM	MEN'S CORRIDOR DAYROOM MEN'S CORRIDOR	DG F	HM -	- 7' -)" 3' - 0")" 3' - 0")" 3' - 0"	1 3/4" 1 3/4" 1 3/4"	F2 H	HM HM HM	SG1 45 MIN. 45 MIN. SG1	10.5 18.0 10.0		168.1 168.2 171.1
basis of design. ASTM F-1915 security grad TYPE: SG-2 – 11/16" Nominal, glass clad p	polycarbonate Global Sec	curity Glazing SecurTem		lear,	D. ALL CO GLAZING S		ORS IN DETE	NTION/SECU	RITY AREAS TO R	ECEIVED DETENT	ION	171.1 171.2 171.3	DAYROOM STORAGE	DAYROOM	F F	HM - HM -	- 7' - - 7' -)" 3' - 0")" 3' - 0")" 6' - 0"	1 3/4" 1 3/4" 1 3/4"	F2 H	HM HM HM		18.0 27.5		171.1 171.2 171.3
ASTM F-1915 Security Grade 3 (20 min) ar TYPE: SG-2M – 15/16" Nominal Mirrored g	glass clad polycarbonate,	Global Security Glazing		oly	<u>REMARKS</u>							174.1 174.2	DAYROOM DAYROOM	MEN'S CORRIDOR DAYROOM	F	HM -	- 7' -)" 3' - 0")" 3' - 0"	1 3/4" 1 3/4"	F2 H	HM	SG1	10.0 18.0		174.1 174.2
2116 (Type SG-2 above + mirror) Note: Lig TYPE: SG-3 -3/4" Nominal, clear glass clad	phting ratio of 8:1 is requir	ed for this product.	-			SCHEDULE	ΕΤ ΤΟ ΔΗ Ο	W FOR FLUS	H PADDED PANEL	DESIGN		177.1 177.2 180	DAYROOM DAYROOM DAYROOM	MEN'S CORRIDOR DAYROOM MEN'S CORRIDOR	DG F DG	HM -	- 7' -)" 3' - 0")" 3' - 0")" 3' - 0"	1 3/4" 1 3/4" 1 3/4"	F2 H	HM HM HM	SG1 SG1	10.0 18.0 10.0		177.1 177.2 180
basis of design. ASTM F-1915 Security Gra TYPE:SG-3M – 1" Nominal, mirrored glass	ade 2 (40 min) and ASTM	I F-1233 body passage	level 2.8 rated		2. DESIGI 3. DOOR	I INTENT IS FOR SCOPE AND ALL	R SECURITY	GLAZING INS	TALLATION IN CO	MMERCIAL DOOF		183 200	MEZZANINE	SALLYPORT MEZZANINE	N F	HM HM -	G 7' - - 7' -)" 3' - 0")" 3' - 0"	1 3/4" 1 3/4"	F2 H F2 H	HM HM		3.0 18.0		183 200
Grade 2 (40 min) and ASTM F-1233 body p product.					STEEL	E DUTCH DOOR SHELF ON BOT	TOM LEAF					201 202 202	MEZZANINE MEZZANINE MEZZANINE	MEZZANINE MEZZANINE MEZZANINE	F F	HM - HM - HM -	- 7' -)" 3' - 0")" 3' - 0")" 3' - 0"	1 3/4" 1 3/4" 1 3/4"	F2 H	HM HM HM	-	18.0 18.0 18.0		201 202 203
TYPE: SG-4 - 1" nominal, clear glass clad p of design. ASTM F-1915 Security Grade 1 (curity Glazing SecurTer	m+Poly SP-028	8 basis	EXTER 6. PROVII	OR INSTALLATI	ON.			OOR SWEEPS FO		203 204 206	MEZZANINE MEZZANINE MEZZANINE	MEZZANINE MEZZANINE MEZZANINE	F F	HM - HM - HM -	- 7' -)" 3' - 0")" 3' - 0")" 3' - 0"	1 3/4" 1 3/4" 1 3/4"	F2 H	HM HM HM		18.0 18.0 18.0		203 204 206
	 In. ASTM F-1915 Security Grade 1 (60 min) rated. SG-4M 1-1/8" nominal, mirrored glass clad polycarbonate, Global Security Glazing SecurTem+Poly M basis of design. ASTM F-1915 Security Grade 1 (60 min) rated. Note: mirrored glass to be on #1 PROVIDE PASS PROOF SECURITY THRESHOLDS, AND PASS PROOF DOOR SEALS AT TH DOOR RABBETS DOOR IS DELETED FROM SCOPE IF STEEL CELL ALTERNATE IS ACCEPTED. PROVIDE LEVEL III BALISTIC RATED GLAZING, DOOR, AND FRAME. PROVIDE FI USH PULLS DOOR HARDWARE 											207	MEZZANINE	MEZZANINE	F	HM -)" 3'-0"	1 3/4"	F2 H	ΗM		18.0		207

5.4.601 - DOOR & FRAME SCHEDULE - ALTERNATE "D"											•		5.4.0	601 - DC	OOR & FI	RAME SCH	EDULE	E - CON		CORRE	CTIONS			
			DOOR F		_	FRAME		_				_			D	OOR PANE	EL		F	RAME				
MARK Name	: To Room: Name	TYPE M	ATL GLAZ	Z H W		RK MATL	GLAZ LABEL	HW Set	NOTES	MARK	MAR	From Room: Name	To Room: Name	TYPE	MATL	GLAZ H	SIZ I W		MARK	MATL	GLAZ LABE	HDWR L SET	NOTES	MARK
1625.1DETENTION CORRIDO1630.1DETENTION CORRIDO1635.1FUTURE BUILD-OUT		SGS4 SHM SGS4 SHM DR SGS4 SHM		7' - 0" 3' - 0" 7' - 0" 3' - 0" 7' - 0" 3' - 0"	2" S1 2" S1 2" S1	SHM - SHM - SHM -	-	S04.3 S04.3 S04.3		1625.1 1630.1 1635.1	100A.1 100A.2	VESTIBULE PUBLIC LOBBY	VESTIBULE	DG DG	AL AL		0" 6' - 0" 0" 6' - 0"	1 3/4" 1 3/4"	A2 A2	AL AL	IG IG	1.0 33.5		100A.1 100A.2
1646.1 FUTURE BUILD-OUT 1646.2 FUTURE BUILD-OUT		F HM OH ST		7'-0" 5'-0" 7'-0" 8'-0" 18'-0" 12'-0"	1 3/4" F2	HM - ST -	······································	7.0		1646.1 1646.2	101 102 103	PUBLIC LOBBY PUBLIC LOBBY PUBLIC LOBBY	WOMEN RR MEN RR STAFF WORK AREA	F F	WD WD WD	7'-(0" 3' - 0" 0" 3' - 0" 0" 3' - 0"	1 3/4" 1 3/4" 1 3/4"	F1	HM HM	 	31.0 31.0 9.0		101 102 103
1663.5DETENTION CORRIDO1663.6FUTURE BUILD-OUT	R FUTURE BUILD-OUT	SGS4 SHM SF SHM		7' - 0" 3' - 0" 7' - 0" 3' - 0"	2" S1 2" S1	SHM - SHM -		S04.1 S09.1		1663.5 1663.6	103 104 105	CORRIDOR STORAGE	STAFF RR CORRIDOR	F	WD WD	7'-(0" 3'-0" 0" 3'-0" 0" 3'-0"	1 3/4" 1 3/4" 1 3/4"	F1	HM HM	 	31.0 21.0		104 105
											106 106.2	OFFICE OFFICE CORRIDOR	CORRIDOR OFFICE BREAK ROOM	G N	WD HM WD	TG 7'-(0" 3' - 0" 0" 3' - 0" 0" 3' - 0"	1 3/4" 1 3/4" 1 3/4"	F1	HM HM HM	TG	28.0 28.0 33.0		106 106.2 107
		5.4.601 ·	DOOR & F	RAME SCH	EDULE - AL	TERNATE "I	D1"				108 109	CORRIDOR CORRIDOR	OFFICE JAN.	G F	WD WD	TG 7'-(7'-(0" 3' - 0" 0" 3' - 0"	1 3/4" 1 3/4"	F3 F1	HM HM	TG	28.0 21.0		108 109
			DOOR F	PANEL		FRAME		_			110 111 112.1	CORRIDOR CORRIDOR CORRIDOR	OFFICE OFFICE	G	WD WD HM	TG 7'-(0" 3' - 0" 0" 3' - 0" 0" 3' - 0"	1 3/4" 1 3/4" 1 3/4"	10	HM HM HM	TG TG	28.0 28.0 3.0		110 111 112.1
From Room MARK Name	n: To Room: Name	TYPE M	ATL GLAZ	Z H W		RK MATL	GLAZ LABEL	HW Set	NOTES	MARK	112.2 113	CORRIDOR DATA CORRIDOR	CORRIDOR STAFF RR		HM HM WD	TG 7'-(7'-(0" 3' - 0" 0" 3' - 0" 0" 3' - 0"	1 3/4" 1 3/4" 1 3/4"	F1	HM HM HM		3.0 24.0 31.0		112.2 113 114
1625 1625.2 DAYROOM	DAYROOM FUTURE BUILD-OUT	SF SHM SF SHM		7' - 0" 3' - 0" 7' - 0" 3' - 0"	2" S1	SHM		S06.1 S06.1	N/A N/A	1625 1625.2	114 115 116	CORRIDOR CORRIDOR	CONFERENCE OFFICE	G G	WD WD	TG 7'-0 TG 7'-0	0" 3' - 0" 0" 3' - 0"	1 3/4" 1 3/4"	F3	HM HM HM	TG TG	33.0 28.0		115 116
1626 DAYROOM 1627 DAYROOM	4 BED ADA CELL 4 BED CELL	SGP2 SHM SGP2 SHM	SG2	7' - 0" 3' - 0" 7' - 0" 3' - 0" 7' - 0" 3' - 0"	2" S2 2" S2	SHM	SG2 SG2	S01.3 S01.3	N/A N/A	1626 1627	117.1 117.2 118	PROGRAMMING MEN'S CORRIDOR CORRIDOR	CORRIDOR PROGRAMMING OFFICE	G G G	HM	TG 7'-(0" 3' - 0" 0" 3' - 0" 0" 3' - 0"	1 3/4" 1 3/4" 1 3/4"	F1	HM HM HM	TG TG	17.0 30.0 28.0		117.1 117.2 118
1628 DAYROOM 1629 DAYROOM 4659 CLASSBOOM	4 BED CELL 4 BED CELL	SGP2 SHM SGP2 SHM		7' - 0" 3' - 0" 7' - 0" 3' - 0" 7' - 0" 3' - 0"	2" S2 2" S2 1 3/4" F2		SG2 SG2	S01.3 S01.3	N/A N/A	1628 1629	118.2 119	OFFICE CORRIDOR	OFFICE OFFICE	N G	HM WD	TG 7'-0 TG 7'-0	0" 3' - 0" 0" 3' - 0"	1 3/4" 1 3/4"	F1 F3	HM HM	 TG	28.0 28.0		118.2 119
1650 CLASSROOM 1658 FUTURE BUILD-OUT 2617.1	STOR. STORAGE MEZZANINE	F HM F HM SF SHM		7' - 0" 3' - 0" 7' - 0" 3' - 0" 7' - 0" 3' - 0"	1 3/4" F2 1 3/4" F2 2" S1			21.0 24.5 S06.1	N/A N/A	1650 1658 2617.1	120 121 122	BODY SCAN BODY SCAN WAITING	CORRIDOR WAITING DRUG	F N F	HM HM HM	TG 7'-(0" 3' - 0" 0" 3' - 0" 0" 3' - 0"	1 3/4" 1 3/4" 1 3/4"		HM HM HM		10.0 10.0 31.0		120 121 122
2618 2619	4 BED CELL 4 BED CELL 4 BED CELL	SGP2 SHM SGP2 SHM		7' - 0" 3' - 0" 7' - 0" 3' - 0" 7' - 0" 3' - 0"	2" S2 2" S2	SHM	SG2 SG2	S01.3 S01.3	N/A N/A	2618 2619	123	CORRIDOR	TEST RR RR	F	WD	7'-(0" 3'-0"	1 3/4"		HM		31.0		123
2620 2621	4 BED CELL	SGP2 SHM SGP2 SHM		7' - 0" 3' - 0" 7' - 0" 3' - 0"	2" S2 2" S2		SG2 SG2	S01.3 S01.3	N/A N/A	2620 2621	124 125.1 125.2	CORRIDOR CORRIDOR WOMEN'S CORRIDOR	CORRIDOR PROGRAMMING PROGRAMMING	G G G	WD WD HM	TG 7'-(0" 3' - 0" 0" 3' - 0" 0" 3' - 0"	1 3/4" 1 3/4" 1 3/4"	F3	HM HM HM	TG TG 	30.0 17.0 30.0		124 125.1 125.2
		5.4.601 -	DOOR & F	RAME SCHI	EDULE - AL	FERNATE "I	02"				126.1 126.2	EXIT CORRIDOR WOMEN'S CORRIDOR	WOMEN'S CORRIDOR	N	HM HM	TG 7'-(TG 7'-(0" 3' - 0" 0" 3' - 0"	1 3/4" 1 3/4"		HM HM		14.0 3.0		126.1 126.2
			DOOR F			FRAME		-			127 128.1	WOMEN'S CORRIDOR WAITING	EXIT CORRIDOR WOMEN'S LOCKER	F	HM		0" 3' - 0" 0" 3' - 0"	1 3/4" 1 3/4"	F3 F1	HM HM	TG 	14.0 30.7		127 128.1
From Room MARK Name	n: To Room: Name	TYPE M	ATL GLAZ	Z H W		RK MATL	GLAZ LABEL	HW Set	NOTES	MARK	128.2	WOMEN'S CORRIDOR	WOMEN'S LOCKER	F	НМ		0" 3' - 0"	1 3/4"		НМ		30.7		128.2
1631 DAYROOM 1632 DAYROOM	4 BED ADA CELL 4 BED CELL	SGP2 SHM SGP2 SHM	SG2 SG2	7' - 0" 3' - 0" 7' - 0" 3' - 0"	2" S2 2" S2		SG2	S01.3 S01.3		1631 1632	129	BODY SCAN WAITING	WAITING DRUG TEST RR	F	HM		0" 3' - 0" 0" 3' - 0"	1 3/4" 1 3/4"		HM HM		10.0 17.0		129 130
1632 DAYROOM 1633 DAYROOM 1634 DAYROOM	4 BED CELL 4 BED CELL 4 BED CELL	SGP2 SHM SGP2 SHM	SG2	7' - 0" 3' - 0" 7' - 0" 3' - 0" 7' - 0" 3' - 0"	2" S2 2" S2 2" S2	SHM	502 5G2 5G2	S01.3 S01.3		1633 1634	131.1 131.2	MEN'S LOCKER MEN'S CORRIDOR	WAITING MEN'S	F	HM		0" 3' - 0" 0" 3' - 0"	1 3/4"		НМ		30.7 30.7		131.1 131.2
2622 2623 MEZZANINE 2624 MEZZANINE	MEZZANINE 4 BED CELL 4 BED CELL	SF SHM SGP2 SHM SGP2 SHM	SG2	7' - 0" 3' - 0" 7' - 0" 3' - 0" 7' - 0" 3' - 0"	2" S1 2" S2 2" S2			S06.1 S01.3 S01.3		2622 2623 2624	132	MEN'S CORRIDOR	LOCKER JAN.	F	HM	7'-(0" 3'-0"	1 3/4"	F1	НМ		21.0		132
2625 MEZZANINE 2626 MEZZANINE	4 BED CELL 4 BED CELL 4 BED CELL	SGP2 SHM SGP2 SHM SGP2 SHM	SG2	7' - 0" 3' - 0" 7' - 0" 3' - 0" 7' - 0" 3' - 0"	2" S2 2" S2 2" S2	SHM	562 562 562	S01.3 S01.3		2625 2626	133 134.1 134.2	PROGRAMMING EXIT CORRIDOR MEN'S CORRIDOR	RR MENS CORRIDOR		WD HM HM	TG 7'-(0" 3' - 0" 0" 3' - 0" 0" 3' - 0"	1 3/4" 1 3/4" 1 3/4"	F1	HM HM HM	 	31.0 14.0 3.0		133 134.1 134.2
		5 4 601		RAME SCH		TERNATE "	ח3"				14 135 136	MEN'S CORRIDOR WOMEN'S CORRIDOR	EXIT CORRIDOR MED. STORAGE	N	HM	1G 7'-(TG 7'-(0" 3' - 0" 0" 3' - 0"	1 3/4" 1 3/4"	F3 F1	HM HM	TG	10.0 13.0		135 136
			boontar								137 138 139	WOMEN'S CORRIDOR MEN'S CORRIDOR MEN'S CORRIDOR	JANITOR MED. STORAGE COMMISSARY	N N	HM HM HM	TG 7'-(0" 3' - 0" 0" 3' - 0" 0" 3' - 0"	1 3/4" 1 3/4" 1 3/4"	1.1	HM HM HM	 	21.0 13.0 13.0		137 138 139
From Room	: To Room:		DOOR F	PANEL SIZ	E	FRAME					140 141	MEN'S CORRIDOR OBSERVATION	JANITOR MEN'S CORRIDOR	F GS	HM HM	SG1 7'-(0" 3' - 0" 0" 3' - 0"	1 3/4" 1 3/4"	F1 F2	HM HM		21.0 17.5		140 141
MARK Name	Name		ATL GLAZ	Z H W	TH MA	RK MATL	GLAZ LABEL	HW Set	NOTES	MARK	142 144.1 144.2	EXIT CORRIDOR EXIT CORRIDOR WOMEN'S CORRIDOR	STORAGE MEAL PREP MEAL PREP	F N N	HM HM HM	TG 7'-(0" 3' - 0" 0" 3' - 0" 0" 3' - 0"	1 3/4" 1 3/4" 1 3/4"	F1 F1 F1	HM HM HM	 	21.0 30.5 30.5		142 144.1 144.2
1630.2 1636 DAYROOM	DAYROOM 4 BED ADA CELL	SF SHM SGP2 SHM	SG2	7' - 0" 3' - 0" 7' - 0" 3' - 0" 7' - 0" 3' - 0"	2" S1 2" S2			S06.1 S01.3		1630.2 1636	145 146	IT OBSERVATION	WOMEN'S CORRIDOR WOMEN'S CORRIDOR		HM HM	7' - (SG1 7' - (0" 3' - 0" 0" 3' - 0"	1 3/4" 1 3/4"	F2	HM HM		13.0 17.5		145 146
1637 DAYROOM 1638 DAYROOM 2627 MEZZANINE	A BED CELL 4 BED CELL	SGP2 SHM SGP2 SHM SF SHM	SG2	7' - 0" 3' - 0" 7' - 0" 3' - 0" 7' - 0" 3' - 0"	2" S2 2" S2 2" S1		5G2 5G2 -	S01.3 S01.3 S06.1		1637 1638 2627	147 148 149	WOMEN'S CORRIDOR STAFF RR BODY SCAN	COMMISSARY WOMEN'S CORRIDOR WOMEN'S CORRIDOR		HM HM HM	7'-(0" 3' - 0" 0" 3' - 0" 0" 3' - 0"	1 3/4" 1 3/4" 1 3/4"	F2	HM HM HM	 	13.0 31.0 15.0		147 148 149
2628MEZZANINE2629MEZZANINE2620MEZZANINE	4 BED CELL 4 BED CELL	SGP2 SHM SGP2 SHM	SG2	7' - 0" 3' - 0" 7' - 0" 3' - 0" 7' - 0" 3' - 0"	2" S2 2" S2 2" S2	SHM	SG2 SG2	S01.3 S01.3		2628 2629	150.1 150.2	BODY SCAN WOMEN'S CORRIDOR	MEN'S CORRIDOR MEN'S CORRIDOR	F F	HM HM	7' - (7' - (0" 3' - 0" 0" 3' - 0"	1 3/4" 1 3/4"	F2	HM HM		15.0 17.5		150.1 150.2
2630 MEZZANINE	4 BED CELL	SGP2 SHM	SG2	7' - 0" 3' - 0"	2 32	SHM S	5G2	S01.3		2630	151.1 151.2 152.1	WOMEN'S CORRIDOR MEN'S CORRIDOR MECHANICAL	CONTROL CONTROL MEN'S CORRIDOR	G G F		SG1 7'- (0" 3' - 6" 0" 3' - 6" 0" 3' - 0"	1 3/4" 1 3/4" 1 3/4"	F2	HM HM HM	SG1 	13.0 13.0 23.0		151.1 151.2 152.1
											152.2 152.3	MECHANICAL SALLYPORT	MECHANICAL	F F	HM HM	7' - (7' - (0" 3' - 0" 0" 3' - 0"	1 3/4" 1 3/4"	F2	HM HM	45 MIN.	6.0 23.5		152.2 152.3
											153.1 153.2 153.3	WOMEN'S CORRIDOR MECHANICAL SALLYPORT	MECHANICAL	F F F	HM HM HM	7'-(0" 3' - 0" 0" 3' - 0" 0" 3' - 0"	1 3/4" 1 3/4" 1 3/4"	12	HM HM HM	45 MIN. 	23.5 6.0 20.0		153.1 153.2 153.3
											154.1 154.2	MECHANICAL MECHANICAL	MECHANICAL	F	HM HM	7' - (7' - (0" 3' - 0" 0" 6' - 0"	1 3/4" 1 3/4"	F1	HM HM		21.0 7.0		154.1 154.2
											155.1 155.2 156.1	MECHANICAL ELECTRICAL ELECTRICAL	ELECTRICAL MECHANICAL	F F F	HM HM HM	7'-(0" 3' - 0" 0" 4' - 0" 0" 3' - 0"	1 3/4" 1 3/4" 1 3/4"	F1	HM HM HM	 	19.0 5.0 19.0		155.1 155.2 156.1
					<u>GENERAL</u>	<u>NOTES</u>					156.2 157.1	ELECTRICAL SECURE VEST.	ELECTRICAL DAYROOM	F N	HM HM	7'-(0" 4' - 0" 0" 3' - 0"	1 3/4" 1 3/4"	12	HM HM		32.0 10.0		156.2 157.1
GLAZING	_				Α.	HIS DOOR SCHED	DULE(S) IS FURNISHED I DO NOT CONSIDER I				157.2 158.1 158.2	SECURE VEST. SECURE VEST. SECURE VEST.	SALLYPORT DAYROOM SALLYPORT	N N		TG 7'-(0" 3' - 0" 0" 3' - 0" 0" 3' - 0"	1 3/4" 1 3/4" 1 3/4"	F2	HM HM HM	45 MIN. 45 MIN.	23.0 10.5 23.5		157.2 158.1 158.2
IG - 1" CLEAR INSU TG - 1/4" CLEAR TE	NCE SPECIFICATION SECT JLATED TEMPERED GLAZIN MPERED GLAZING.	TION 08 80 00 - GLA NG WITH LOW-E C	zing Dating.		EXAMINE DETERMI	THE DRAWINGS (E IE THE EXTENT OI	SPECIALLY THE FLOOF F DOOR AND FRAME QU TE OPENINGS). SHOUL	R PLANS) AND THE JANTITIES REQUI	E SPECIFICATION RED (INCLUDING	S TO INTERIOR	159.1 159.2	DAYROOM DAYROOM	WOMEN'S CORRIDOR DAYROOM	DG F	HM HM	SG1 7'- (0" 3'-0" 0" 3'-0" 0" 3'-0"	1 3/4" 1 3/4" 1 3/4"	F11	HM HM	SG1 45 MIN.	10.5 18.0		159.1 159.2
SP - 1" INSULATED FR1 - FIRE LIGHT 90	SPANDREL GLAZING PAN	EL.			INTERIOR	BORROWED LITE	OR SIDELITE SHOWN C DULE, SUPPLY SAME AS	N THE DRAWING	S BE INADVERTEN	NTLY	162.1 162.2	DAYROOM DAYROOM	WOMEN'S CORRIDOR DAYROOM	F	HM HM	7'-(0" 3' - 0" 0" 3' - 0"	1 3/4" 1 3/4"	F12 F2	HM HM HM	SG1 45 MIN. 	10.5 18.0		162.1 162.2
SECURITY GLAZING REFERENCE GLAZING	SPECIFICATION SECTION	l 11 19 50 - DETENT	ION AND SECURI	ITY						אי היי	165.1 165.2 168.1	DAYROOM DAYROOM DAYROOM	WOMEN'S CORRIDOR DAYROOM MEN'S CORRIDOR	DG F DG	HM HM HM	7'-(0" 3' - 0" 0" 3' - 0" 0" 3' - 0"	1 3/4" 1 3/4" 1 3/4"	F2	HM HM HM	SG1 45 MIN.	10.5 18.0 10.5		165.1 165.2 168.1
TYPE: SG-1 – 9/16" Nominal, glass basis of design. ASTM F-1915 secur			Tem+Poly 2117 cle	ear,	WIDE DOO	ORS TO HAVE 4 HI					168.2 171.1	DAYROOM DAYROOM	DAYROOM MEN'S CORRIDOR	F DG		7' - (SG1 7' - (0" 3' - 0" 0" 3' - 0"	1 3/4" 1 3/4"	F12	HM HM	45 MIN. SG1	18.0 10.0		168.2 171.1
TYPE: SG-2 – 11/16" Nominal, glass ASTM F-1915 Security Grade 3 (20				clear,	GLAZING	SG-2.	S IN DETENTION/SECUI	KILY AREAS TO R	ECEIVED DETENT	IUN	171.2 171.3 174.1	DAYROOM STORAGE DAYROOM	DAYROOM MEN'S CORRIDOR	F F DG	HM HM HM	7'-(0" 3' - 0" 0" 6' - 0" 0" 3' - 0"	1 3/4" 1 3/4" 1 3/4"	F1	HM HM HM	 SG1	18.0 27.5 10.0		171.2 171.3 174.1
TYPE: SG-2M – 15/16" Nominal Mirr 2116 (Type SG-2 above + mirror) No				Poly	REMARKS	R SCHEDULE					174.2 177.1	DAYROOM DAYROOM	DAYROOM MEN'S CORRIDOR	F DG	HM HM	7' - (SG1 7' - (0" 3' - 0" 0" 3' - 0"	1 3/4" 1 3/4"	F2 F11	HM HM	 SG1	18.0 10.0		174.2 177.1
TYPE: SG-3 -3/4" Nominal, clear gla basis of design. ASTM F-1915 Secu					1. MODIF	Y HARDWARE SET	TO ALLOW FOR FLUSH SECURITY GLAZING INS			R PANEL	177.2 180 183	DAYROOM DAYROOM	DAYROOM MEN'S CORRIDOR SALLYPORT	F DG N	HM HM HM	SG1 7'- (0" 3' - 0" 0" 3' - 0" 0" 3' - 0"	1 3/4" 1 3/4" 1 3/4"	F13	HM HM HM	 SG1 	18.0 10.0 3.0		177.2 180 183
TYPE:SG-3M – 1" Nominal, mirrored Grade 2 (40 min) and ASTM F-1233					3. DOOR ALTEF	SCOPE AND ALL A NATE.	SSOCIATED FRAMES, A	ANCHORS AND IN	STALLATION IS P	ART OF	200 201	MEZZANINE MEZZANINE	MEZZANINE MEZZANINE	F	HM HM	7' - (7' - (0" 3' - 0" 0" 3' - 0"	1 3/4" 1 3/4"	F2	HM HM		18.0 18.0		200 201
product. TYPE: SG-4 - 1" nominal, clear glass					STEEL 5. EXTEF	SHELF ON BOTTO)m leaf S door, provide thr				202 203 204	MEZZANINE MEZZANINE MEZZANINE	MEZZANINE MEZZANINE MEZZANINE	F F	HM HM HM	7'-(0" 3' - 0" 0" 3' - 0" 0" 3' - 0"	1 3/4" 1 3/4" 1 3/4"	F2	HM HM HM		18.0 18.0 18.0		202 203 204
of design. ASTM F-1915 Security Gr TYPE: SG-4M 1-1/8" nominal, mirror	ade 1 (60 min) rated.		·		6. PROV DOOR	DE PASS PROOF S RABBETS	N. SECURITY THRESHOLD: M SCOPE IF STEEL CELI			AT THE	206 207	MEZZANINE MEZZANINE	MEZZANINE MEZZANINE	F F	HM HM	7'-(0" 3' - 0" 0" 3' - 0"	1 3/4"	F2	HM HM	 	18.0 18.0		206 207
SP-028M basis of design. ASTM F-1 surface, and 8:1 lighting ratio require	915 Security Grade 1 (60 mir				8. PROV		TIC RATED GLAZING, D																	

•	5.4.601 - DOOR & FRAME SCHEDULE - ALTERNATE "D"													5.4.0	601 - DC	DOR & F	RAME SCH	IEDULE	E - CON	MUNITY (CORRE	ECTIONS				
			DOOR P	ANEL	F	F	RAME		_								DOOR PAN				FRAME					
From Room: MARK Name	To Room: Name	TYPE MATI	L GLAZ			MARK	MATL	GLAZ LABEL	. HW Set	NOTES	MARK	MAR	From Room: Name	To Room: Name	TYPE	MATL	GLAZ	SIZ H W		MARK	MATL	GLAZ		HDWR SET M	NOTES	MARK
	FUTURE BUILD-OUT FUTURE BUILD-OUT DETENTION CORRIDOF	SGS4 SHM SGS4 SHM SGS4 SHM	SG2 SG2 SG2	7' - 0" 3' - 0" 7' - 0" 3' - 0" 7' - 0" 3' - 0"	2" S 2" S 2" S	1 S	SHM SHM SHM		S04.3 S04.3 S04.3		1625.1 1630.1 1635.1	100A.1 100A.2	VESTIBULE PUBLIC LOBBY	VESTIBULE	DG DG	AL AL	IG 7'-	- 0" 6' - 0" - 0" 6' - 0"	1 3/4" 1 3/4"	A2 A2	AL	IG IG	:	1.0 33.5		100A.1 100A.2
1646.1 FUTURE BUILD-OUT 1646.2		F HM OH ST		7' - 0" 8' - 0" 18' - 0" 12' - 0"	-	2 F	HM ST		7.0		1646.1 1646.2	101 102 103	PUBLIC LOBBY PUBLIC LOBBY PUBLIC LOBBY	WOMEN RR MEN RR STAFF WORK AREA	F F F	WD WD WD	7'·	- 0" 3' - 0" - 0" 3' - 0" - 0" 3' - 0"	1 3/4" 1 3/4" 1 3/4"	F1	HM HM HM		:	31.0 31.0 9.0		101 102 103
1663.5DETENTION CORRIDOR1663.6FUTURE BUILD-OUT	FUTURE BUILD-OUT	SGS4 SHM SF SHM	SG2 	7' - 0" 3' - 0" 7' - 0" 3' - 0"	2" S 2" S		SHM SHM		S04.1 S09.1		1663.5 1663.6	104 105	CORRIDOR STORAGE	STAFF RR CORRIDOR	F F	WD WD	7' · 7' ·	- 0" 3' - 0" - 0" 3' - 0"	1 3/4" 1 3/4"		HM HM			31.0 21.0		104 105
												106 106.2 107	OFFICE OFFICE CORRIDOR	CORRIDOR OFFICE BREAK ROOM	G N G	WD HM WD	TG 7'-	- 0" 3' - 0" - 0" 3' - 0" - 0" 3' - 0"	1 3/4" 1 3/4" 1 3/4"	F1	HM HM HM	TG TG		28.0 28.0 33.0		106 106.2 107
		5.4.601 - DO	OOR & FI	RAME SCH	EDULE - A	ALTERN	NATE "	D1"				108 109	CORRIDOR CORRIDOR	OFFICE JAN.	G F	WD WD	TG 7' · 7' ·	- 0" 3' - 0" - 0" 3' - 0"	1 3/4" 1 3/4"	F1	HM HM	TG	2	28.0 21.0		108 109
			DOOR P	ANEL		F	RAME		_			110 111 112.1	CORRIDOR CORRIDOR CORRIDOR	OFFICE OFFICE	G G N	WD WD HM	TG 7'.	- 0" 3' - 0" - 0" 3' - 0" - 0" 3' - 0"	1 3/4" 1 3/4" 1 3/4"	10	HM HM HM	TG TG 	2	28.0 28.0 3.0		110 111 112.1
From Room: MARK Name	To Room: Name		L GLAZ	SIZ H W		MARK	MATL	GLAZ LABEI	. HW Set	NOTES	MARK	112.2 113	CORRIDOR DATA CORRIDOR	CORRIDOR STAFF RR		HM HM WD	TG 7' · 7' ·	- 0" 3' - 0" - 0" 3' - 0" - 0" 3' - 0"	1 3/4" 1 3/4" 1 3/4"	F1	HM HM HM			3.0 24.0 31.0		112.2 113 114
1625 1625.2 DAYROOM	DAYROOM FUTURE BUILD-OUT	SF SHM SF SHM		7' - 0" 3' - 0" 7' - 0" 3' - 0"	2" S		SHM		S06.1 S06.1	N/A N/A	1625 1625.2	115 116	CORRIDOR CORRIDOR	CONFERENCE OFFICE	G	WD WD	TG 7' · TG 7' ·	- 0" 3' - 0" - 0" 3' - 0"	1 3/4" 1 3/4"	F3	HM HM	TG TG		33.0 28.0		115 116
1626 DAYROOM 1627 DAYROOM	4 BED ADA CELL 4 BED CELL	SGP2 SHM SGP2 SHM	SG2 SG2	7' - 0" 3' - 0" 7' - 0" 3' - 0"	2" Si 2" Si	2 S	SHM SHM	SG2 SG2	S01.3 S01.3	N/A N/A	1626 1627	117.1 117.2 118	PROGRAMMING MEN'S CORRIDOR CORRIDOR	CORRIDOR PROGRAMMING OFFICE	G G G	WD HM WD	TG 7'-	- 0" 3' - 0" - 0" 3' - 0" - 0" 3' - 0"	1 3/4" 1 3/4" 1 3/4"	F1	HM HM HM	 TG	:	17.0 30.0 28.0		117.1 117.2 118
1628 DAYROOM 1629 DAYROOM 1650 CLASSROOM	4 BED CELL 4 BED CELL STOR.	SGP2 SHM SGP2 SHM F HM	SG2 SG2	7' - 0" 3' - 0" 7' - 0" 3' - 0" 7' - 0" 3' - 0"	2" Si 2" Si 1 3/4" Fi	2 8		SG2 SG2	S01.3 S01.3 21.0	N/A N/A N/A	1628 1629 1650	118.2 119	OFFICE CORRIDOR	OFFICE OFFICE	N G	HM WD	TG 7'-	- 0" 3' - 0" - 0" 3' - 0"		F3	HM HM	 TG	2	28.0		118.2 119
1658 FUTURE BUILD-OUT 2617.1	STORAGE MEZZANINE	F HM SF SHM	 	7' - 0" 3' - 0" 7' - 0" 3' - 0"	1 3/4" F2 2" S	2 H	HM		24.5 S06.1	N/A	1658 2617.1	120 121 122	BODY SCAN BODY SCAN WAITING	CORRIDOR WAITING DRUG	F N F	HM HM HM	TG 7'-	- 0" 3' - 0" - 0" 3' - 0" - 0" 3' - 0"	1 3/4" 1 3/4" 1 3/4"	1 1	HM HM HM	 		10.0 10.0 31.0		120 121 122
2618 2619 2620	4 BED CELL 4 BED CELL 4 BED CELL	SGP2 SHM SGP2 SHM SGP2 SHM	SG2 SG2 SG2	7' - 0" 3' - 0" 7' - 0" 3' - 0" 7' - 0" 3' - 0"	2" Si 2" Si 2" Si	2 8	SHM SHM SHM	SG2 SG2 SG2	S01.3 S01.3 S01.3	N/A N/A N/A	2618 2619 2620	123	CORRIDOR CORRIDOR	TEST RR RR CORRIDOR	F	WD WD		- 0" 3' - 0" - 0" 3' - 0"	1 3/4"		HM	 TG		31.0		123 124
2621	4 BED CELL	SGP2 SHM	SG2	7' - 0" 3' - 0"	2" S	2	SHM	SG2	S01.3	N/A	2621	125.1 125.2	CORRIDOR CORRIDOR WOMEN'S CORRIDOR	PROGRAMMING PROGRAMMING	G G G	WD WD HM	TG 7'-	- 0" 3' - 0" - 0" 3' - 0"	1 3/4" 1 3/4" 1 3/4"	F3	HM HM	TG TG 		17.0 30.0		125.1 125.2
		5.4.601 - D0	OOR & FI	RAME SCHI	EDULE - /	ALTERN	IATE "	D2"				126.1 126.2	EXIT CORRIDOR WOMEN'S CORRIDOR	WOMEN'S CORRIDOR	N	HM	TG 7'-	- 0" 3' - 0" - 0" 3' - 0"	1 3/4" 1 3/4"	· ·	HM HM		:	14.0 3.0		126.1 126.2
			DOOR P	ANEL	-	F	RAME		_			127 128.1	WOMEN'S CORRIDOR WAITING	EXIT CORRIDOR WOMEN'S LOCKER	F	HM		- 0" 3' - 0" - 0" 3' - 0"	1 3/4"	F3 F1	HM HM			14.0 30.7		127 128.1
From Room: MARK Name	To Room: Name		L GLAZ			MARK	MATL	GLAZ LABEL	. HW Set	NOTES	MARK	128.2	WOMEN'S CORRIDOR BODY SCAN	WOMEN'S LOCKER WAITING	F	HM		- 0" 3' - 0" - 0" 3' - 0"	1 3/4"		НМ			30.7		128.2 129
1631 DAYROOM 1632 DAYROOM	4 BED ADA CELL 4 BED CELL	SGP2 SHM SGP2 SHM	SG2 SG2	7' - 0" 3' - 0" 7' - 0" 3' - 0"	2" Si 2" Si	-		SG2 SG2	S01.3 S01.3		1631 1632	130	WAITING	DRUG TEST RR	F	НМ	7' ·	- 0" 3' - 0"	1 3/4"	F1	HM			17.0		130
1633 DAYROOM 1634 DAYROOM	4 BED CELL 4 BED CELL	SGP2 SHM SGP2 SHM	SG2 SG2	7' - 0" 3' - 0" 7' - 0" 3' - 0"	2" Si 2" Si	2 S	SHM SHM	SG2 SG2	S01.3 S01.3		1633 1634	131.1 131.2	MEN'S LOCKER MEN'S CORRIDOR	WAITING MEN'S	F	HM		- 0" 3' - 0" - 0" 3' - 0"			HM HM			30.7		131.1
2622 2623 MEZZANINE 2624 MEZZANINE	MEZZANINE 4 BED CELL 4 BED CELL	SF SHM SGP2 SHM SGP2 SHM	 SG2 SG2	7' - 0" 3' - 0" 7' - 0" 3' - 0" 7' - 0" 3' - 0"	2" S 2" S 2" S	2 8		 SG2 SG2	S06.1 S01.3 S01.3		2622 2623 2624	132	MEN'S CORRIDOR	LOCKER JAN. RR	F	HM	7'·	- 0" 3' - 0"	1 3/4"	· ·	HM			21.0		132
2625MEZZANINE2626MEZZANINE	4 BED CELL 4 BED CELL	SGP2 SHM SGP2 SHM	SG2 SG2	7' - 0" 3' - 0" 7' - 0" 3' - 0"	2" Si 2" Si		ынм	SG2 SG2	S01.3 S01.3		2625 2626	135 194.1 134.2	MEN'S CORRIDOR	MENSCORRIDOR	N	НМ	TG 7'- TG 7'-	- 0" 3' - 0" - 0" 3' - 0" - 0" 3' - 0"	1 3/4" 1 3/4" 1 3/4"	F1	HM HM	 	•	31.0 14.0 3.0		133 134.1 134.2
		5.4.601 - D	OOR & F	RAME SCH	EDULE	ALTERI	NATE "	D3"				4 1 35 136 137	MEN'S SOKRIDOR WOMEN'S CORRIDOR WOMEN'S CORRIDOR	EXIT CORRIDOR MED. STORAGE JANITOR	N F	HM HM	TG 7'-	- 0" 3' - 0" - 0" 3' - 0" - 0" 3' - 0"	1 3/4" 1 3/4" 1 3/4"	F3 F1 F1	HM HM HM	TG	•	10.0 13.0 21.0		135 136 137
			DOOR P			F	RAME					138 139	MEN'S CORRIDOR MEN'S CORRIDOR	MED. STORAGE COMMISSARY	N N	HM HM	TG 7'-	- 0" 3' - 0" - 0" 3' - 0"	1 3/4" 1 3/4"	1 1	HM HM			13.0 13.0 21.0		138 139
From Room:	To Room:			SIZ								140 141 142	MEN'S CORRIDOR OBSERVATION EXIT CORRIDOR	JANITOR MEN'S CORRIDOR STORAGE	GS F	HM HM HM	SG1 7'-	- 0" 3' - 0" - 0" 3' - 0" - 0" 3' - 0"	1 3/4" 1 3/4" 1 3/4"	12	HM HM HM	 	•	17.5 21.0		140 141 142
MARK Name		SF SHM		H W 7' - 0" 3' - 0"	TH I			GLAZ LABEL	. HW Set	NOTES	1630.2	144.1 144.2	EXIT CORRIDOR WOMEN'S CORRIDOR	MEAL PREP MEAL PREP	N N	HM HM	TG 7'-	- 0" 3' - 0" - 0" 3' - 0"		F1 F1	HM HM	 		30.5 30.5		144.1 144.2
1636 DAYROOM 1637 DAYROOM	4 BED ADA CELL A BED CELL	SF SHM SGP2 SHM SGP2 SHM	SG2 SG2	7'-0" 3'-0" 7'-0" 3'-0" 7'-0" 3'-0"	2" Si 2" Si 2" Si	2 5	ынм	 SG2 SG2	S01.3 S01.3		1636 1637	145 146 147	OBSERVATION WOMEN'S CORRIDOR	WOMEN'S CORRIDOR WOMEN'S CORRIDOR COMMISSARY		HM HM HM	SG1 7'-	- 0" 3' - 0" - 0" 3' - 0" - 0" 3' - 0"	1 3/4" 1 3/4" 1 3/4"	F2	HM HM HM	 	•	13.0 17.5 13.0		145 146 147
1638 DAYROOM 2627 MEZZANINE 2628 MEZZANINE	4 BED CELL 4 BED CELL	SGP2 SHM SF SHM SGP2 SHM	SG2 SG2	7' - 0" 3' - 0" 7' - 0" 3' - 0" 7' - 0" 3' - 0"	2" Si 2" S 2" S	1 5	ым	SG2 SG2	S01.3 S06.1 S01.3		1638 2627 2628	148 149	STAFF RR BODY SCAN	WOMEN'S CORRIDOR WOMEN'S CORRIDOR		HM HM	7' · 7' ·	- 0" 3' - 0" - 0" 3' - 0"	1 3/4" 1 3/4"	F1	HM HM		•	31.0 15.0		148 149
2629MEZZANINE2630MEZZANINE	4 BED CELL 4 BED CELL 4 BED CELL	SGP2 SHM SGP2 SHM SGP2 SHM SGP2 SHM	SG2 SG2 SG2	7'-0" 3'-0" 7'-0" 3'-0" 7'-0" 3'-0"	2" Si 2" Si 2" Si	2 5	ым	SG2 SG2 SG2	S01.3 S01.3 S01.3		2629 2630	150.1 150.2 151.1	BODY SCAN WOMEN'S CORRIDOR WOMEN'S CORRIDOR	MEN'S CORRIDOR MEN'S CORRIDOR CONTROL	F G	HM HM HM	7'·	- 0" 3' - 0" - 0" 3' - 0" - 0" 3' - 6"	1 3/4" 1 3/4" 1 3/4"	F2	HM HM HM	 SG1		15.0 17.5 13.0		150.1 150.2 151.1
												151.2 152.1	MEN'S CORRIDOR MECHANICAL	CONTROL MEN'S CORRIDOR	G F	HM HM	7'·	- 0" 3' - 6" - 0" 3' - 0"	1 3/4"	F2	HM HM		2	13.0 23.0		151.2 152.1
												152.2 152.3 153.1	MECHANICAL SALLYPORT WOMEN'S CORRIDOR	MECHANICAL MECHANICAL	F F F	HM HM HM	7'·	- 0" 3' - 0" - 0" 3' - 0" - 0" 3' - 0"	1 3/4" 1 3/4" 1 3/4"	F2	HM HM HM		5 MIN.	6.0 23.5 23.5		152.2 152.3 153.1
												153.2 153.3	MECHANICAL SALLYPORT	MECHANICAL	F	HM HM	7' · 7' ·	- 0" 3' - 0" - 0" 3' - 0"	1 3/4" 1 3/4"	F2	HM HM		6	6.0 20.0		153.2 153.3
												154.1 154.2 155.1	MECHANICAL MECHANICAL MECHANICAL	MECHANICAL	F F	HM HM HM	7'·	- 0" 3' - 0" - 0" 6' - 0" - 0" 3' - 0"	1 3/4" 1 3/4" 1 3/4"	F1	HM HM HM	 		21.0 7.0 19.0		154.1 154.2 155.1
												155.2 156.1	ELECTRICAL ELECTRICAL	MECHANICAL	F	HM HM	7' · 7' ·	- 0" 4' - 0" - 0" 3' - 0"	1 3/4" 1 3/4"	F1 F2	HM HM			5.0 19.0		155.2 156.1
GLAZING					<u>GENE</u>	RAL NOTES	<u>i</u>					156.2 157.1 157.2	ELECTRICAL SECURE VEST. SECURE VEST.	ELECTRICAL DAYROOM SALLYPORT	N N	HM HM HM	TG 7'-	- 0" 4' - 0" - 0" 3' - 0" - 0" 3' - 0"	1 3/4" 1 3/4" 1 3/4"	F2	HM HM HM	 		32.0 10.0 23.0		156.2 157.1 157.2
COMMERCIAL GLAZING REFERENCE S	SPECIFICATION SECTION	ON 08 80 00 - GI AZING	3			RD THE CO	NTRACTOF	DULE(S) IS FURNISHED R. DO NOT CONSIDER ESPECIALLY THE FLOO	T AS ENTIRELY IN	CLUSIVE. CAREF	ULLY	158.1 158.2	SECURE VEST. SECURE VEST.	DAYROOM SALLYPORT	N N	HM HM	TG 7' · TG 7' ·	- 0" 3' - 0" - 0" 3' - 0"	1 3/4" 1 3/4"	F2 F2 F2	HM HM	45	5 MIN. 5 MIN. 2	10.5 23.5		158.1 158.2
IG - 1" CLEAR INSULATE TG - 1/4" CLEAR TEMPER	ED TEMPERED GLAZIN	G WITH LOW-E COATI	ING.		DETE BORR	RMINE THE OWED LITE	EXTENT Ò OR SIDEL	F DOOR AND FRAME Q TE OPENINGS). SHOU	UANTITIÉS REQUI LD ANY PARTICUL	RED (INCLUDING AR DOOR, FRAME	INTERIOR E, OR	159.1 159.2 162.1	DAYROOM DAYROOM DAYROOM	WOMEN'S CORRIDOR DAYROOM WOMEN'S CORRIDOR	F	HM HM HM	7'.	- 0" 3' - 0" - 0" 3' - 0" - 0" 3' - 0"	1 3/4" 1 3/4" 1 3/4"		HM HM HM			10.5 18.0 10.5		159.1 159.2 162.1
FR1 - FIRE LIGHT 90 MIN.						ED FROM 1	HIS SCHE	OR SIDELITE SHOWN DULE, SUPPLY SAME A	S REQUIRED FOR	SIMILAR OPENIN		162.2 165.1	DAYROOM DAYROOM DAYROOM	DAYROOM WOMEN'S CORRIDOR	F	HM HM	7'·	- 0" 3' - 0" - 0" 3' - 0"		F2	HM HM		•	18.0 10.5		162.2 165.1
SECURITY GLAZING REFERENCE SPEC							CIAL 4'-0" V	S WITH THE OWNER DU			TY 4'-0"	165.2 168.1	DAYROOM DAYROOM DAYROOM	DAYROOM MEN'S CORRIDOR DAYROOM	F DG	HM HM HM	SG1 7'-	- 0" 3' - 0" - 0" 3' - 0" - 0" 3' - 0"	1 3/4" 1 3/4" 1 3/4"	=	HM HM HM		5 MIN.	18.0 10.5 18.0		165.2 168.1 168.2
TYPE: SG-1 – 9/16" Nominal, glass clad p basis of design. ASTM F-1915 security gra	ade 4, 10 minute containr	nent rated.	-		D. AL			NGES IS IN DETENTION/SECU	IRITY AREAS TO R	ECEIVED DETENT	ION	168.2 171.1 171.2	DAYROOM DAYROOM	MEN'S CORRIDOR DAYROOM	DG F	HM HM	SG1 7' - 7' -	- 0" 3' - 0" - 0" 3' - 0"	1 3/4" 1 3/4"	F12 F2 F2	HM HM	SG1 45		10.0 18.0		171.1 171.2
TYPE: SG-2 – 11/16" Nominal, glass clad ASTM F-1915 Security Grade 3 (20 min) a TYPE: SG-2M – 15/16" Nominal Mirrored g	and ASTM F-1233 Level 2	2.7 body passage rated`			GLAZI <u>Rema</u>	NG SG-2. <u>RKS</u>						171.3 174.1 174.2	STORAGE DAYROOM DAYROOM	MEN'S CORRIDOR DAYROOM	F DG F	HM HM HM	SG1 7' · 7' ·	- 0" 6' - 0" - 0" 3' - 0" - 0" 3' - 0"	1 3/4" 1 3/4"	F13 F2	HM HM HM	 SG1 		27.5 10.0 18.0		171.3 174.1 174.2
2116 (Type SG-2 above + mirror) Note: Lig TYPE: SG-3 -3/4" Nominal, clear glass cla	ghting ratio of 8:1 is requi	red for this product.	-					T TO ALLOW FOR FLUS	H Pannen daniei	DESIGN		177.1 177.2 180	DAYROOM DAYROOM DAYROOM	MEN'S CORRIDOR DAYROOM MEN'S CORRIDOR	DG F DG	HM HM HM	7'·	- 0" 3' - 0" - 0" 3' - 0" - 0" 3' - 0"		F2	HM HM HM	SG1 SG1	•	10.0 18.0 10.0		177.1 177.2 180
basis of design. ASTM F-1915 Security Gr TYPE:SG-3M – 1" Nominal, mirrored glass	rade 2 (40 min) and AST	M F-1233 body passage	e level 2.8 rated.		2. DE 3. DC	SIGN INTEN	NT IS FOR	SECURITY GLAZING IN ASSOCIATED FRAMES,	STALLATION IN CO	MMERCIAL DOOF		183 200	MEZZANINE	SALLYPORT MEZZANINE	N F	HM HM	IG 7' · 7' ·	- 0" 3' - 0" - 0" 3' - 0"	1 3/4" 1 3/4"	F2 F2	HM HM			3.0 18.0		183 200
Grade 2 (40 min) and ASTM F-1233 body product.					4. DC ST	EEL SHELF	ON BOTTO					201 202 203	MEZZANINE MEZZANINE MEZZANINE	MEZZANINE MEZZANINE MEZZANINE	F F	HM HM HM	7'·	- 0" 3' - 0" - 0" 3' - 0" - 0" 3' - 0"		F2	HM HM HM		•	18.0 18.0 18.0		201 202 203
TYPE: SG-4 - 1" nominal, clear glass clad of design. ASTM F-1915 Security Grade 1		ecurity Glazing SecurTe	m+Poly SP-028	3 basis	EX 6. PF	TERIOR INS	STALLATIO	S DOOR, PROVIDE TH N. SECURITY THRESHOLE				203 204 206	MEZZANINE MEZZANINE	MEZZANINE MEZZANINE	F F	HM HM	7' · 7' ·	- 0" 3' - 0" - 0" 3' - 0"	1 3/4" 1 3/4"	F2	HM HM HM			18.0 18.0		204 206
TYPE: SG-4M 1-1/8" nominal, mirrored gla SP-028M basis of design. ASTM F-1915 S surface, and 8:1 lighting ratio required to b	Security Grade 1 (60 min)				7. DC 8. PF	OVIDE LEV	eted froi El III Bali	M SCOPE IF STEEL CEL STIC RATED GLAZING, DOOR HARDWARE				207	MEZZANINE	MEZZANINE	F	HM	7'.	- 0" 3' - 0"	1 3/4"	F2	HM			18.0		207

COMMERCIAL GLAZING REFERENCE SPECIFICATION SECTION 08 80 00 - GLAZING IG - IG - </th
SECURITY GLAZING REFERENCE SPECIFICATION SECTION 11 19 50 - DETENTION AND SECURITY
GLAZING
TYPE: SG-1 – 9/16" Nominal, glass clad polycarbonate Global Security Glazing SecurTem+Poly 2117 clear, basis of design. ASTM F-1915 security grade 4, 10 minute containment rated.
TYPE: SG-2 – 11/16" Nominal, glass clad polycarbonate Global Security Glazing SecurTem+Poly 2116, clear, ASTM F-1915 Security Grade 3 (20 min) and ASTM F-1233 Level 2.7 body passage rated`
TYPE: SG-2M – 15/16" Nominal Mirrored glass clad polycarbonate, Global Security Glazing SecurTem+Poly 2116 (Type SG-2 above + mirror) Note: Lighting ratio of 8:1 is required for this product.
TYPE: SG-3 -3/4" Nominal, clear glass clad polycarbonate, Global Security Glazing SecurTem+Poly SP-019 basis of design. ASTM F-1915 Security Grade 2 (40 min) and ASTM F-1233 body passage level 2.8 rated.
TYPE:SG-3M – 1" Nominal, mirrored glass clad polycarbonate, Global Security Glazing SecurTem+Poly Security Grade 2 (40 min) and ASTM F-1233 body passage level 2.8 rated. Note: Lighting ratio of 8:1 is required for this product.
TYPE: SG-4 - 1" nominal, clear glass clad polycarbonate, Global Security Glazing SecurTem+Poly SP-028 basis of design. ASTM F-1915 Security Grade 1 (60 min) rated.
TYPE: SG-4M 1-1/8" nominal, mirrored glass clad polycarbonate, Global Security Glazing SecurTem+Poly SP-028M basis of design. ASTM F-1915 Security Grade 1 (60 min) rated. Note: mirrored glass to be on #1 surface, and 8:1 lighting ratio required to be effective.
TYPE: SG-FR1 – 13/16" Nominal UL Fire rated UL9 & 10B for 45 min, and ASTM F-1915 Security Grade 4 (10 min), square wire.(baroque). Max length 42" not to exceed 1296 sq inches. Install using Blazeseal tape per UL installation and mfgers instructions.
TYPE: SG-FR2 – 1" Nominal, UL Fire rated UL 9 & 10C for 90 min, and ASTM F-1915 Security Grade 3 (20 min), square wire, (baroque). Max length 33" not to exceed 330 sq inches. Install using Blazeseal tape per UL installation and mfger's instructions.
TYPE MP-1 – Monolithic Polycarbonate with abrasion resistant coating. Product: Lexgard MR-10 1/2", ASTM F1233 Class II/ASTM 1915 Grade 4, HP White Level 1-TP-0500.02. (10 Minute containment).
TYPE LP-1 – Laminated Polycarbonate – Product Lexgard MPC375, 3/8" ASTM F1233 Class II/ASTM 1915 Grade 3, HP White Level II-TP-0500.02, WFML Level III. Security Level 3. (20 Minute containment).
TYPE LP-2 – Laminated Polycarbonate – Product Lexgard MPC500, 1/2" ASTM F1233 Class III/ASTM 1915 Grade 2, HP White Level II-TP-0500.02, WMFL Level II. (40 Minute containment).
TYPE LP-3 – Laminated Polycarbonate – Product Lexgard RC750, 3/4" ASTM F1233 Class IV/ASTM 1915 Grade 1, HP White Level III-TP-0500.02. (60 Minute Containment).
TYPE LP-4 – Laminated Polycarbonate-Product Lexgard MP 1000, 1" ASTM F1233 Class V, HP White Level IV- TP-0500.02 (60 Minute Containment)
TYPE BR – Laminated Polycarbonate – Product Lexgard SP1250, 1.25" ASTM F1233 Class V/ASTM 1915 Grade 1, (60 Minute Containment) HP White Level V-TP-0500.02/WMFL Level I and UL 752 Bullet Resistant level 3, .44 magnum rated.


- PROVIDE LEVEL III BALISTIC RATED GLAZING, DOOR, AND FRAME.
 PROVIDE FLUSH PULLS DOOR HARDWARE


ABBREVIATIONS

AL	ALUMINUM	TG	1/4" TEMPERED GLAZ
HM	HOLLOW METAL	IG	1" INSULATED GLAZI
SHM	SECURITY HOLLOW METAL	LG	LAMINATED GLAZING
ST	STEEL	FG	FROSTED GLAZING
WD	WOOD	SP	SPANDREL PANEL

2	
L	

D GLAZING GLAZING LAZING JZING

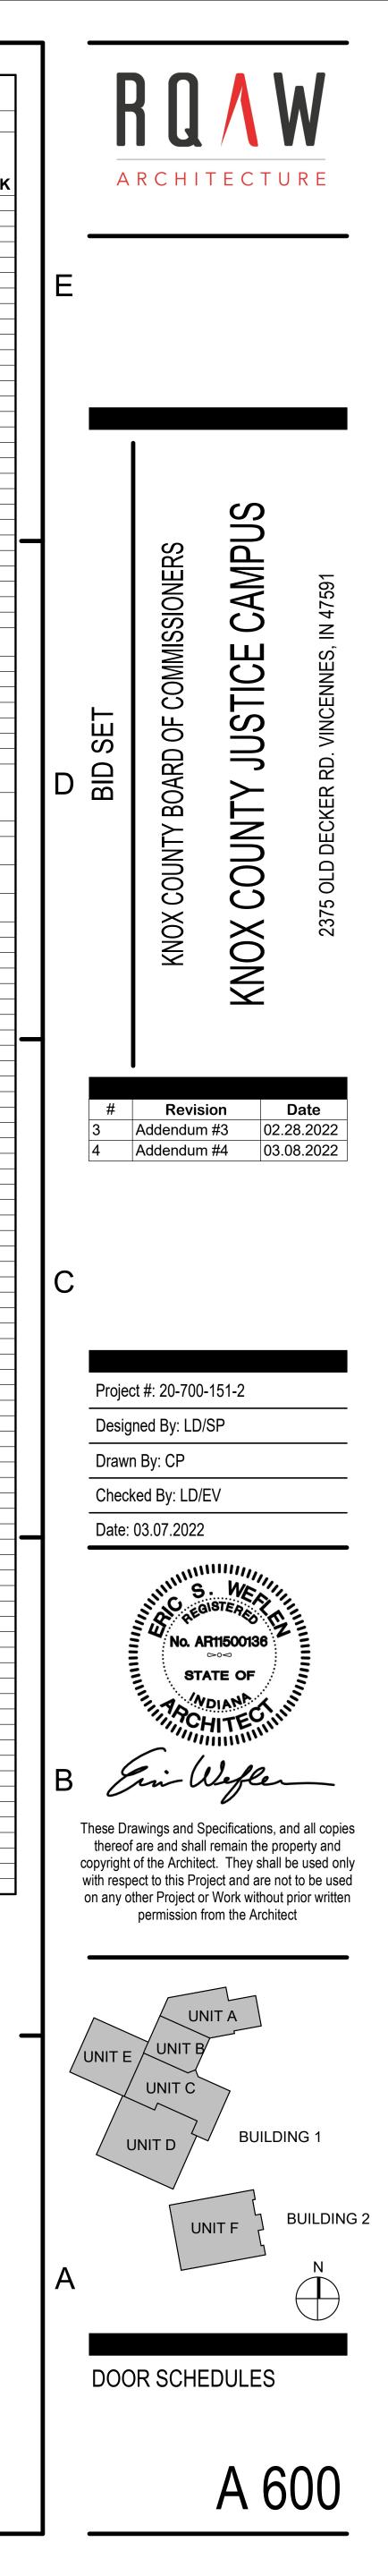

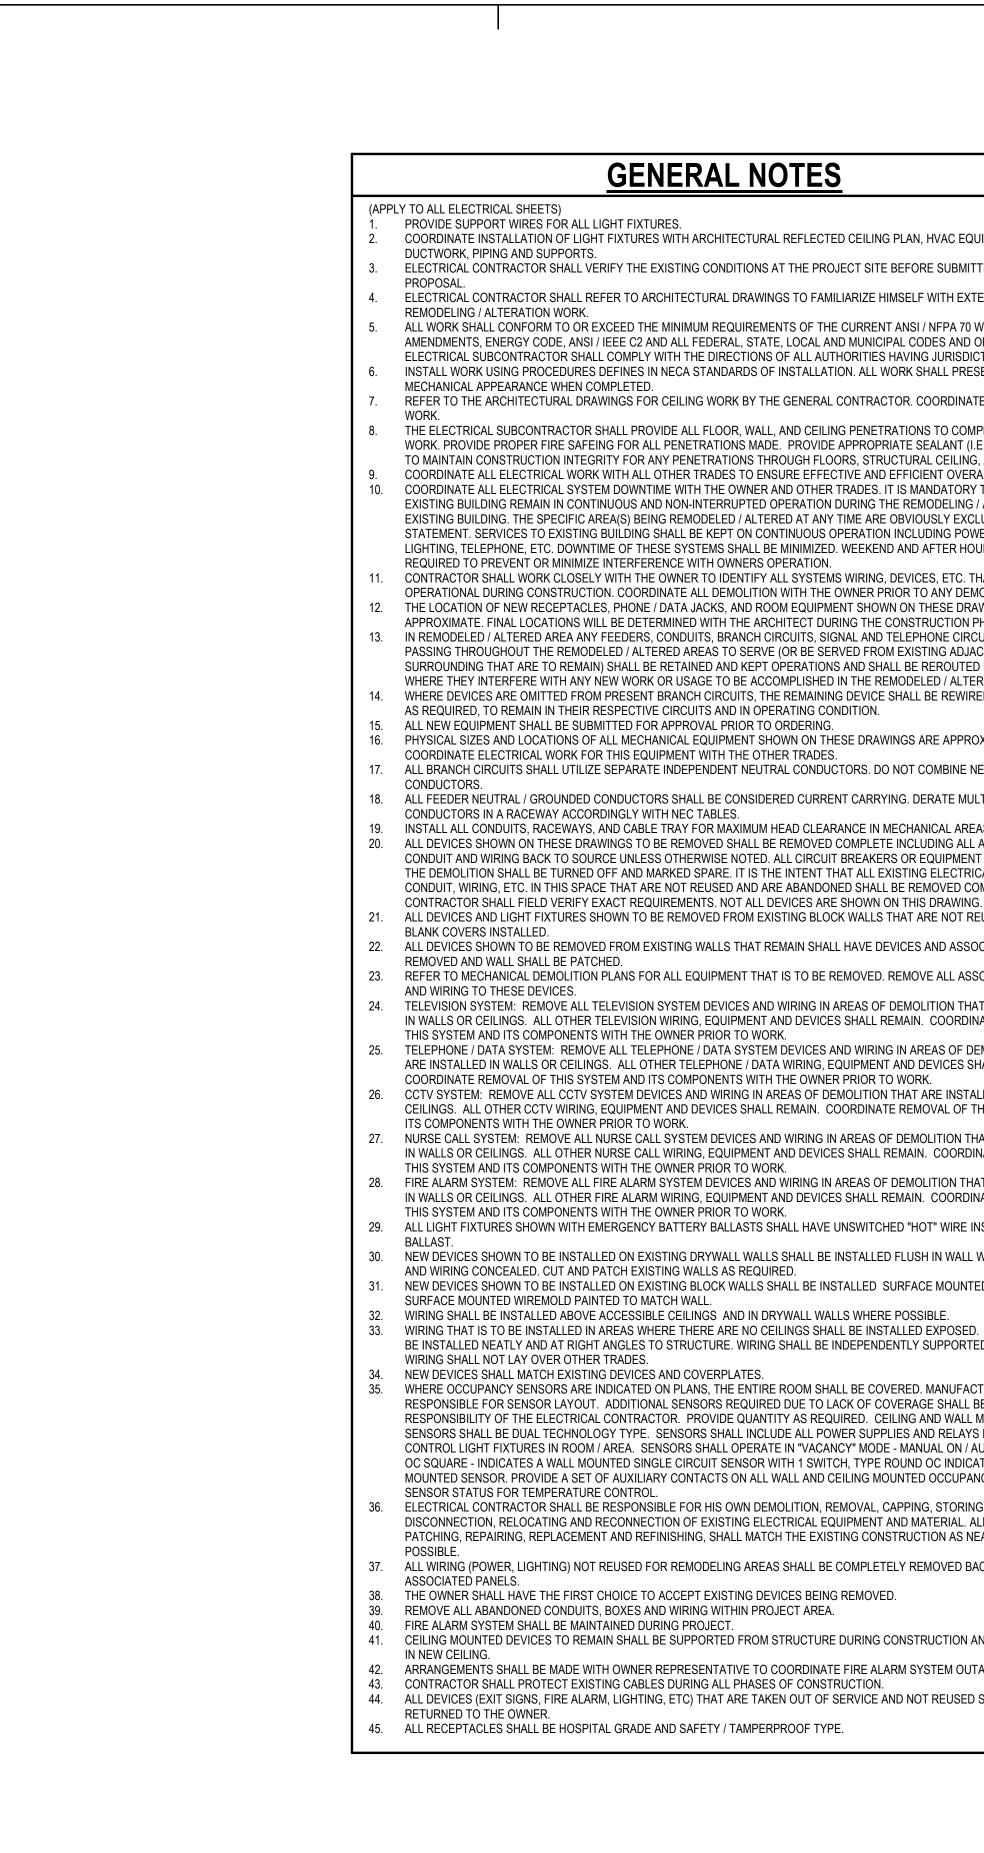

					7						
				j	LOW	VOLTAGE SY	STEM				
#NO.	LOW VOLTAGE SYSTEM RESPONSIBILITY	FIRE ALARM	LIGHTING CONTROL	SECURE AREA LTG. CONTROL	IT PHONE / DATA	SECURITY SYSTEMS	AUDIO / VISUAL SYSTEM	CABLE TV	RADIO COMM. SYSTEM	ABBR	EVIATIONS
1.	WHO WILL FURNISH THE SYSTEM EQUIPMENT?	EC	EC	SEV	\ 0/V	SEV	O/V	O/V	O/V	N/A	NOT APPLICABLE
2.	WHO WILL INSTALL THE SYSTEM EQUIPMENT?	EC	EC	EC	O/V	EC	O/V	O/V	O/V	EC	ELECTRICAL
3.	WHO WILL FURNISH THE SYSTEM WIRING?	EC	EC	EC	EC	EC	EC	EC	O/V	LU	CONTRACTOR
4.	WHO WILL INSTALL THE SYSTEM WIRING?	EC	EC	EC	EC 3	EC	EC	EC	O/V	0	OWNER
5.	WHO WILL PROVIDE ROUGH-INS (CONDUIT AND BOXES) TO THE SYSTEM?	EC	EC	EC	EC	SEV / EC	EC	EC	EC	V	OWNER'S VENDOR
6.	WHO WILL PROVIDE POWER CONNECTION TO THE SYSTEM PANEL?	EC	EC	EC	EC	EC	EC	EC	EC		SECURITY
7.	WHO WILL PROVIDE TELECOM CONNECTION TO THE SYSTEM PANEL?	EC	EC	EC	EC	EC	O/V	O/V	O/V	SEV	ELECTRONICS
8.	WHO WILL PROVIDE FINAL TERMINATION TO THE SYSTEM DEVICES?	EC	EC	EC	EC	EC	O/V	O/V	O/V		VENDOR
9.	WHO WILL PROVIDE TESTING AND ACCEPTANCE OF THE INSTALLED SYSTEM?	EC	EC	EC	EC	EC	O/V	O/V	O/V	-	-

|--|

- (APPLY TO ALL ELECTRICAL SHEETS)
- DIV. 28 SYSTEMS.

- ALL INSTALLED CABLING FOR THE SECURITY SYSTEMS.

В

A

		LIGHTING
	SYMBOL	DESCRIPTION
QUIPMENT,		NO SHADING INDICATES NORMAL POWER
ITTING COST		HALF SHADED INDICATES UNSWITCHED EMERGENCY POWER
KTENT OF		FULL SHADED INDICATES SWITCHED EMERGENCY POWER
) WITH STATE O ORDINANCES. THE		24" x 48" LIGHTING FIXTURE
DICTION. ESENT A NEAT		24" x 24" LIGHTING FIXTURE
ATE ALL ELECTRICAL		12" x 48" LIGHTING FIXTURE 12" x 36" LIGHTING FIXTURE
MPLETE HIS / HER		12" x 24" LIGHTING FIXTURE 12" x 12" LIGHTING FIXTURE
(I.E. FIRESAFEING) IG, AND FIRE WALLS.		12" x 96" LIGHTING FIXTURE 6" x 96" LIGHTING FIXTURE
RALL INSTALLATION. RY THAT THE		6" x 48" LIGHTING FIXTURE
G / ALTERING OF THE CLUSIVE OF THE		6" x 36" LIGHTING FIXTURE 6" x 24" LIGHTING FIXTURE
WER, FIRE ALARM, OURS WORK MAY BE	\bigcirc	8" DOWNLIGHT
THAT MUST REMAIN	Ø Ø	6" DOWNLIGHT 4" DOWNLIGHT
MOLITION WORK. RAWINGS ARE	Q	WALL MOUNTED LIGHT
PHASE. RCUITS, ETC.	100 100	CEILING EXIT LIGHT (DUAL FACED) CEILING EXIT LIGHT (SINGLE FACE)
ACENT, REMOTE, OR ED IN ALL CASES		WALL EXIT LIGHT
ERED AREA. RED. IF NEEDED AND		WALL EXIT WITH EMERGENCY LIGHTS
ROXIMATE.		WALL EXIT WITH INTERIOR AND EXTERIOR EMERGENCY LIGHTS
NEUTRAL		EXIT LIGHT DIRECTIONAL ARROWS
ULTIPLE		WALL EMERGENCY BATTERY LIGHT
EAS. L ASSOCIATED	. ↓ P	CEILING EMERGENCY BATTERY LIGHT
NT MADE SPARE BY RICAL DEVICES,	-0 0+0	EXTERIOR POLE LIGHT (ONE HEAD) EXTERIOR POLE LIGHT (TWO HEADS)
COMPLETE.	_₽o	EXTERIOR POLE LIGHT (THREE HEADS)
REUSED SHALL HAVE		EXTERIOR POLE LIGHT (FOUR HEADS)
OCIATED CONDUIT	□	EXTERIOR POLE LIGHT (TOP MOUNT) EXTERIOR BOLLARD
SSOCIATED CONDUIT		
AT ARE INSTALLED		
DEMOLITION THAT SHALL REMAIN.		
ALLED IN WALLS OR THIS SYSTEM AND		
THAT ARE INSTALLED DINATE REMOVAL OF		
HAT ARE INSTALLED		
INSTALLED TO		
TED AND IN		
D. CABLING SHALL TED AS REQUIRED.		
CTURER IS		
BE THE L MOUNTED		
AUTO OFF. TYPE		
CATES A CEILING ANCY SENSORS FOR		
NG, ABANDONING, ALL CUTTING, NEARLY AS		
BACK TO		
AND REINSTALLED		
JTAGE.		
D SHALL BE		

LTY FOR DIV. 28 (SECURITY SYSTEMS)

THE DIVISION 26 ELECTRICAL CONTRACTOR WILL BE RESPONSIBLE FOR PROVIDING AND INSTALLING ALL 120/20VAC, CONDUITS/RACEWAYS, BOXES (BACK BOXES AND JUNCTION BOXES) AND FIBER OR COPPER CONDUCTORS REQUIRED FOR THE

2. THE ELECTRICAL CONTRACTOR IS ALSO RESPONSIBLE FOR MOUNTING AND INSTALLING ALL DIV. 28 SUPPLIED BACK BOXES, INCLUDING CAMERA HOUSINGS AND INTERCOM ENCLOSURES FOR THE DIV. 28 SYSTEMS.

3. THE DIV. 26 CONTRACTOR WILL BE RESPONSIBLE FOR INSTALLING DIV. 28 SECURITY FIELD AND HEADEND DEVICES AND TERMINATING THE CABLING AT THE FIELD DEVICE AND HEADEND LOCATIONS FOR ALL DIV. 28 DEVICES.

4. THE ELECTRICAL CONTRACTOR IS RESPONSIBLE FOR LABELING ALL RACEWAY AND CABLE SYSTEMS FOR DIV. 28 SYSTEMS. 5. THE ELECTRICAL CONTRACTOR SHALL PERFORM, PRIOR TO TERMINATION AT HEADEND DEVICES, AN ACCEPTANCE TEST OF


6. REFER TO "SE" SERIES DRAWINGS FOR ADDITIONAL INFORMATION ON SECURITY ELECTRONICS.


_ <u>EL</u>	ECTRICAL RECEPTACLES	<u> </u>	RE ALARM SYSTEM		ELECTRICAL A	BBREVIA	ATIONS
SYMBOL	DESCRIPTION	SYMBOL	DESCRIPTION	ABBREVIATION	DESCRIPTION AMPERE	ABBREVIATION HZ	DESCRIPTION HERTZ
₽	DUPLEX RECEPTACLE - NORMAL POWER CIRCUIT	M	MANUAL SENDING STATION	A OF AMP AC A/C	AMPERE ALTERNATING CURRENT AIR CONDITIONING	IC ID	INTERCOMMUNICATION
	DUPLEX RECEPTACLE - EMERGENCY POWER CIRCUIT DUPLEX GFCI RECEPTACLE - NORMAL POWER CIRCUIT	(SD)	WALL SMOKE DETECTOR	ACP ACU	ACCESS PANEL AIR CONDITIONING UNIT	INCAN INCL	INCANDESCENT INCLUDE
	DUPLEX GFCI RECEPTACLE - EMERGENCY POWER CIRCUIT		WALL SMOKE DETECTOR WITH SOUNDER BASE	ADD ADJ	ADDITION ADJUSTABLE	ISG JB	INCLUDE ISOLATED GROUND SURGE GUARD JUNCTION BOX
₽	QUADRAPLEX RECEPTACLE - NORMAL POWER CIRCUIT	(SD) (SD)	CEILING SMOKE DETECTOR CEILING SMOKE DETECTOR WITH SOUNDER BASE	ADJ AF AFC	AMPERE FRAME ABOVE FINISHED CEILING	JE JT KEC	JOINT KITCHEN EQUIPMENT CONTRACTOR
₽	QUADRAPLEX RECEPTACLE - EMERGENCY POWER CIRCUIT		AUTOMATIC DUCT DETECTOR ("X" DENOTES AS FOLLOWS)	AFC AFF AFG	ABOVE FINISHED FLOOR	KEC KT KVA	KITCHENETTE
╡ ■	QUADRAPLEX GFCI RECEPTACLE - NORMAL POWER CIRCUIT QUADRAPLEX GFCI RECEPTACLE - EMERGENCY POWER CIRCUIT	X	NONE - PHOTOELECTRIC TYPE S - SUPPLY	AHU	ABOVE FINISHED GRADE AIR HANDLING UNIT	KVAR	KILOVOLT AMPERE KILOVOLT AMPERE REACTIVE
Φ	QUADRAPLEX GFCI RECEPTACLE - EMERGENCY POWER CIRCUIT		R - RETURN	AIC AL	AMPERE INTERRUPTING CAPACITY	KW LAB	KILOWATT LABORATORY
	SIMPLEX RECEPTACLE - EMERGENCY POWER CIRCUIT	RT	REMOTE DETECTOR TEST STATION	AM AMB	AMMETER AMBIENT	LB LF	POUND LINEAR FEET
φ	SPECIAL RECEPTACLE - NORMAL POWER CIRCUIT	RI	REMOTE DETECTOR INDICATOR STATION	APPROX. ARCH	APPROXIMATELY ARCHITECT	LOC LS	LOCATION LIFE SAFETY
Ŷ	SPECIAL RECEPTACLE - EMERGENCY POWER CIRCUIT			ATS AUTO	AUTOMATIC TRANSFER SWITCH AUTOMATIC	LT LTG	LIGHT LIGHTING
Ψ	DUPLEX RECEPTACLE - TOP SWITCHED	(FD)	FLAME DETECTOR BEAM DETECTOR	AVG BC	AVERGE BARE COPPER	LV MATV	LOW VOLTAGE MASTER ANTENNA TELEVISION
RECE	PTACLE_LEGEND RECEPTACLE_ABOVE COUNTERTOP AT +2" ABOVE		WALL HORN ONLY	BKR BHP	BREAKER BRAKE HORSEPOWER	MAX MC	MAXIMUM MECHANICAL CONTRACTOR
Ψ	BACKSPLASH TO BOTTOM OF DEVICE. COORDINATE WITH CASEWORK TO BE INSTALLED.		WALL HORN STROBE	BL BLDG	BUILDING LINE BUILDING	MCB MCC	MAIN CIRCUIT BREAKER MOTOR CONTROL CENTER
₽ ₽	RECEPTACLE INSTALLED BELOW COUNTERTOP AT +18"	H XXX	CEILING HORN ONLY	BR BTM	BRANCH BOTTOM	MDP MECH	MAIN DISTRIBUTION PANEL MECHANICAL
₩ \$	A.F.F. COORDINATE WITH CASEWORK TO BE INSTALLED.		CEILING HORN STROBE	C °C	CONDUIT DEGREES CELSIUS	MH MIN	MANHOLE MINIMUM
πχ	"X" DENOTES AS FOLLOWS: NONE - 20 AMP, 125VAC	$\langle s \rangle$	WALL SPEAKER ONLY	CAB CB or C/B	CABINET CIRCUIT BREAKER	MISC MLO	MISCELLANEOUS MAIN LUGS ONLY
	HM - 20 AMP, 125VAC, HORIZONTAL MOUNT TYPE	Ś	WALL SPEAKER STROBE	C/C CCTV	CENTER TO CENTER CLOSED CIRCUIT TELEVISION	MTD MTG HT	MOUNTED MOUNTING HEIGHT
	IG - 20 AMP, 125VAC, ISOLATED GROUND TYPE S - 20 AMP, 125VAC, SURGE GUARD PROTECTION TYPE	ŝ	CEILING SPEAKER STROBE	CKT CL	CIRCUIT CENTER LINE	MU OD	MEDICINE UNIT OUTSIDE DIAMETER
	ST - 20 AMP, 125VAC, SAFETY TYPE		WALL VISUAL ONLY	CLG COL	CEILING COLUMN	OFCI OFOI	OWNER FURNISHED-CONTRACTOR INSTALLEI OWNER FURNISHED-OWNER INSTALLED
	WP - 20 AMP, 125VAC, WEATHERPROOF TYPE CEILING DUPLEX RECEPTACLE - NORMAL POWER CIRCUIT	$\widetilde{\mathbb{V}}$	CEILING VISUAL ONLY	COMM COMP	COLUMIN COMMUNICATION COMPRESSOR	OPNG OPP	OPENING OPPOSITE
	CEILING DUPLEX RECEPTACLE - EMERGENCY POWER CIRCUIT	ÂR	FIRE ALARM ADDRESSABLE RELAY	CONC CONST	COMPRESSOR CONCRETE CONSTRUCTION	OPP OR P	OPPOSITE OPERATING ROOM POLE
	CEILING QUADRAPLEX RECEPTACLE - NORMAL POWER CIRCUIT	$\langle \dot{\rangle}$	FIREMANS JACK	CONT	CONTINUOUS	P PB PBOX	PUSHBUTTON
	CEILING QUADRAPLEX RECEPTACLE - EMERGENCY POWER CIRCUIT	d	DOOR UNLOCK	CONTR CR	CONTRACTOR CRITICAL	PBOX PE	PULL BOX PNEUMATIC ELECTRIC CONVERTER
		OR	DOOR RELEASE	CT CU	CURRENT TRANSFORMER COPPER	PF PH or Ø	POWER FACTOR PHASE
	FLOOR BOX DUPLEX RECEPTACLE - EMERGENCY POWER CIRCUIT	FS	SPRINKLER SYSTEM FLOW SWITCH	DB DC	DIRECT BURIAL DIRECT CURRENT	PV PNL	POST INDICATOR VALVE PANELBOARD
	FLOOR BOX QUADRAPLEX RECEPTACLE - EMERGENCY POWER CIRCUIT	T S	SPRINKLER SYSTEM TAMPER SWITCH	DEPT DF	DEPARTMENT DRINKING FOUNTAIN	PL PREFAB	PILOT LIGHT PREFABRICATED
0	FLOOR BOX BLANK	PIV	POST INDICATOR VALVE	DIST DM	DISTRIBUTION DEMAND METER	PRES PT	PRESSURE PNEUMATIC TUBE
	FLOOR BOX POWER AND TELECOM MULTI-OUTLET ASSEMBLY (POWER AND/OR TELECOM)	FACP	FIRE ALARM CONTROL PANEL	DO DRS	DRAWOUT DOCTORS	PTS PW	PNEUMATIC TUBE STATION PART WINDING
****	MOLTI-OUTLET ASSEMIDLT (FOWER AND/OR TELECOM)	FAAP	FIRE ALARM ANNUNCIATOR PANEL	DWG EC	DRAWING ELECTRICAL CONTRACTOR	PWR RACU	POWER ROOM AIR CONDITIONING UNIT
		NAC	FIRE ALARM NOTIFICATION APPLIANCE CONTROL PANEL	EF ELEC	EXHAUST FAN ELECTRIC	RAD RECEPT	RADIATION RECEPTACLE
<u> </u>	LECTRICAL SWITCHES			ELEV ELV	ELEVATOR ELEVATION	REF or REFR REINF	REFRIGERATOR REINFORCED
<u>SYMBOL</u>	DESCRIPTION	<u>INF(</u>	DRMATION SYSTEMS	EMER ENCL	EMERGENCY ENCLOSURE	RGIP RM	REMOTE GROUND INDICATING PANEL ROOM
\$	TOGGLE SWITCH - 20 AMP, 120/277VAC	<u>SYMBOL</u>	DESCRIPTION	EP EQUIP	ELECTRIC PNEUMATIC EQUIPMENT	RPM SA	REVOLUTIONS PER MINUTE SUPPLY AIR
\$ ³	TOGGLE SWITCH - 3 WAY	▼ ×	VOICE AND DATA ONLY OUTLET	EWC EX	ELECTRIC WATER COOLER EXPLOSIONPROOF	SC SG	SHORT CIRCUIT SURGE GUARD PROTECTION
\$4 \$ ^к	TOGGLE SWITCH - 4 WAY TOGGLE SWITCH - KEY OPERATED		<u>"X" DENOTES AS FOLLOWS:</u>	EXH EXP	EXHAUST EXPANSION	SHT SIG	SHEET SIGNAL
Ψ \$⊺	TOGGLE SWITCH - HORSE POWER RATED MANUAL MOTOR		# - QUANTITY OF JACK(S) AND CABLE(S) R - ROUGH-IN ONLY	EXT ⁰F	EXTERIOR DEGREES FAHRENHEIT	SN SPEC	SOLID NEUTRAL SPECIFICATIONS
\$ ₽	STARTER WITH THERMAL OVERLOAD PROTECTION TOGGLE SWITCH - PILOT LIGHT	\mathbf{r}^{X}	CEILING - VOICE AND DATA WAP - WIRELESS ACCESS	FA FAAP	FIRE ALARM FIRE ALARM ANNUNCIATOR PANEL	SQ SS	SQUARE SAFETY SWITCH
	DIMMER SWITCH - 20 AMP, 120/277VAC	WAP	POINT	FACP FC	FIRE ALARM CONTROL PANEL FLAT CABLE	SSSS STD	SOLID STATE SOFT START STANDARD
D 3	DIMMER SWITCH - 3 WAY		FLOOR BOX - VOICE AND DATA	FCU FFC	FAN COIL UNIT FOOD FACILITY CONTRACTOR	STN STR	STATION STRUCTURAL
	DIMMER SWITCH - 4 WAY		TELECOMMUNICATIONS EQUIPMENT RACK TV SYSTEM OUTLET	FFS FHC	FOOD FACILITY SUPPLIER FIRE HOSE CABINET	SUSP SW	SUSPENDED SWITCH
OC1	WALL OCCUPANCY SENSOR - 1 BUTTON CONTROL	AV	AUDIO/VISUAL CONTROLLER	FIN FIXT	FINISH FIXTURE	SWBD SWGR	SWITCHBOARD SWITCHGEAR
OC2 OC3	WALL OCCUPANCY SENSOR - 2 BUTTON CONTROL WALL OCCUPANCY SENSOR - DUAL RELAY FOR	н©	CLOCK SYSTEM OUTLET	FL FLUOR	FLOOR FLUORESCENT	TCC	TEMPERATURE CONTROL CONTRACTOR
	EXHAUST FAN CONTROL CEILING OCCUPANCY SENSOR	Μ	MICROPHONE INPUT RECEPTACLE - WALL MOUNTED	FLEX-CONN FPC	FLOORESCENT FLEXIBLE CONNECTION FIRE PROTECTION CONTRACTOR	TEMP TMH	TELECOMMONICATION TEMPERATURE TOP OF MANHOLE
VS1	WALL VACANCY SENSOR - 1 BUTTON CONTROL	\mathbb{M}	MICROPHONE INPUT RECEPTACLE - CEILING MOUNTED	FSS FTG	FUSED SAFETY SWITCH FOOTING	TV TV TYP	TELEVISION TYPICAL
VS2	WALL VACANCY SENSOR - 2 BUTTON CONTROL	©	SPEAKER - CEILING MOUNTED	FVR FV	FUUTING FILMVIEWER FULL VOLTAGE	UC U/C	UNDER CARPET UNDER CABINET or UNDER COUNTER
LC	LOW VOLTAGE LIGHTING CONTROLLER	r© ∣	SPEAKER - WALL MOUNTED VOLUME CONTROL	FV FVNR G or GND	FULL VOLTAGE FULL VOLTAGE NON REVERSING GROUND	UH UV	UNDER CABINE I OF UNDER COUNTER UNIT HEATER UNIT VENTILATOR
T	0 - 3 HOUR TIMER SWITCH - 20 AMP, 120/277VAC PHOTO CELL			GALV GC	GROUND GALVANIZED GENERAL CONTRACTOR	V V VAC	VOLT VACUUM
IPCI				GEN	GENERAL CONTRACTOR GENERATOR	VAC	VACUUM BREAKER
PC			R SECURITY SYSTEM	GEOL			VACUUM CLEANING
			R SECURITY SYSTEM	GFCI GFI GEP	GROUND FAULT CKT. INTERRUPTER GROUND FAULT INTERRUPTER	VC VEL	VACUUM CLEANING VELOCITY VARIABLE EREQUENCY DRIVE
		<u>SYMBOL</u>	R SECURITY SYSTEM DESCRIPTION CCTV COAXIAL CABLE OUTLET AND POWER OUTLET	GFI GFP HGT	GROUND FAULT CKT. INTERRUPTER GROUND FAULT INTERRUPTER GROUND FAULT PROTECTION HEIGHT	VC VEL VFD VM	VELOCITY VARIABLE FREQUENCY DRIVE VOLTMETER












EL	ECTRICAL RECEPTACLES	<u>FI</u>	RE ALARM SYSTEM		ELECTRICAL A	BBREVIA	ATIONS
SYMBOL	DESCRIPTION	SYMBOL	DESCRIPTION	ABBREVIATION	DESCRIPTION	ABBREVIATION	DESCRIPTION
φ	DUPLEX RECEPTACLE - NORMAL POWER CIRCUIT	< M>	MANUAL SENDING STATION	A or AMP AC	AMPERE ALTERNATING CURRENT	HZ IC	HERTZ INTERCOMMUNICATION
Ŷ	DUPLEX RECEPTACLE - EMERGENCY POWER CIRCUIT	(SD)	WALL SMOKE DETECTOR	A/C	AIR CONDITIONING	ID	INSIDE DIAMETER
Ψ	DUPLEX GFCI RECEPTACLE - NORMAL POWER CIRCUIT	ŚD	WALL SMOKE DETECTOR WITH SOUNDER BASE	ACP ACU	ACCESS PANEL AIR CONDITIONING UNIT	INCAN INCL	INCANDESCENT INCLUDE
₽ ₽	DUPLEX GFCI RECEPTACLE - EMERGENCY POWER CIRCUIT	SD ××	CEILING SMOKE DETECTOR	ADD ADJ	ADDITION ADJUSTABLE	ISG JB	ISOLATED GROUND SUI JUNCTION BOX
₽	QUADRAPLEX RECEPTACLE - NORMAL POWER CIRCUIT		CEILING SMOKE DETECTOR WITH SOUNDER BASE	AF AFC	AMPERE FRAME ABOVE FINISHED CEILING	JT KEC	JOINT KITCHEN EQUIPMENT C
P	QUADRAPLEX RECEPTACLE - EMERGENCY POWER CIRCUIT	(SD)		AFF	ABOVE FINISHED FLOOR	KT	KITCHENETTE
Ħ	QUADRAPLEX GFCI RECEPTACLE - NORMAL POWER CIRCUIT	₩ x	AUTOMATIC DUCT DETECTOR ("X" DENOTES AS FOLLOWS) NONE - PHOTOELECTRIC TYPE	AFG AHU	ABOVE FINISHED GRADE AIR HANDLING UNIT	KVA KVAR	KILOVOLT AMPERE KILOVOLT AMPERE REA
#	QUADRAPLEX GFCI RECEPTACLE - EMERGENCY POWER CIRCUIT		S - SUPPLY R - RETURN	AIC AL	AMPERE INTERRUPTING CAPACITY ALUMINUM	KW LAB	KILOWATT LABORATORY
φ	SIMPLEX RECEPTACLE - NORMAL POWER CIRCUIT	ŔŢ	REMOTE DETECTOR TEST STATION	AM	AMMETER	LB	POUND
Ŧ	SIMPLEX RECEPTACLE - EMERGENCY POWER CIRCUIT	RI	REMOTE DETECTOR INDICATOR STATION	AMB APPROX.	AMBIENT APPROXIMATELY	LF LOC	LINEAR FEET LOCATION
Ψ	SPECIAL RECEPTACLE - NORMAL POWER CIRCUIT		HEAT DETECTOR	ARCH ATS	ARCHITECT AUTOMATIC TRANSFER SWITCH	LS I T	LIFE SAFETY LIGHT
Ψ	SPECIAL RECEPTACLE - EMERGENCY POWER CIRCUIT	L Å	FLAME DETECTOR	AUTO	AUTOMATIC	LTG	LIGHTING
Ψ	DUPLEX RECEPTACLE - TOP SWITCHED	(FD)		AVG BC	AVERGE BARE COPPER	LV MATV	LOW VOLTAGE MASTER ANTENNA TELI
	PTACLE_LEGEND RECEPTACLE_ABOVE COUNTERTOP AT +2" ABOVE	BD	BEAM DETECTOR	BKR BHP	BREAKER BRAKE HORSEPOWER	MAX MC	MAXIMUM MECHANICAL CONTRAC
Ŷ	BACKSPLASH TO BOTTOM OF DEVICE. COORDINATE WITH		WALL HORN ONLY	BL	BUILDING LINE	MCB	MAIN CIRCUIT BREAKER
	CASEWORK TO BE INSTALLED.	(H)	WALL HORN STROBE	BLDG BR	BUILDING BRANCH	MCC MDP	MOTOR CONTROL CEN MAIN DISTRIBUTION PA
₽	RECEPTACLE INSTALLED BELOW COUNTERTOP AT +18" A.F.F. COORDINATE WITH CASEWORK TO BE INSTALLED.	Н	CEILING HORN ONLY	BTM C	BOTTOM CONDUIT	MECH MH	MECHANICAL MANHOLE
Φx	"X" DENOTES AS FOLLOWS:	H	CEILING HORN STROBE	°C	DEGREES CELSIUS	MIN	MINIMUM
	NONE - 20 AMP, 125VAC	Ś	WALL SPEAKER ONLY	CAB CB or C/B	CABINET CIRCUIT BREAKER	MISC MLO	MISCELLANEOUS MAIN LUGS ONLY
	HM - 20 AMP, 125VAC, HORIZONTAL MOUNT TYPE	Ś	WALL SPEAKER STROBE	C/C CCTV	CENTER TO CENTER CLOSED CIRCUIT TELEVISION	MTD MTG HT	MOUNTED MOUNTING HEIGHT
	IG - 20 AMP, 125VAC, ISOLATED GROUND TYPE S - 20 AMP, 125VAC, SURGE GUARD PROTECTION TYPE	ŝ	CEILING SPEAKER STROBE	СКТ	CIRCUIT	MU	MEDICINE UNIT
	ST - 20 AMP, 125VAC, SAFETY TYPE		WALL VISUAL ONLY	CL CLG	CENTER LINE CEILING	OD OFCI	OUTSIDE DIAMETER OWNER FURNISHED-CC
-	WP - 20 AMP, 125VAC, WEATHERPROOF TYPE			COL COMM	COLUMN COMMUNICATION	OFOI OPNG	OWNER FURNISHED-OV OPENING
()	CEILING DUPLEX RECEPTACLE - NORMAL POWER CIRCUIT	\bigvee	CEILING VISUAL ONLY	COMP	COMPRESSOR	OPP	OPPOSITE
	CEILING DUPLEX RECEPTACLE - EMERGENCY POWER CIRCUIT	AR	FIRE ALARM ADDRESSABLE RELAY	CONC CONST	CONCRETE CONSTRUCTION	OR P	OPERATING ROOM POLE
	CEILING QUADRAPLEX RECEPTACLE - NORMAL POWER CIRCUIT		FIREMANS JACK	CONT CONTR	CONTINUOUS CONTRACTOR	PB PBOX	PUSHBUTTON PULL BOX
			DOOR UNLOCK	CR CT	CRITICAL CURRENT TRANSFORMER	PE	PNEUMATIC ELECTRIC
<u> </u>	FLOOR BOX DUPLEX RECEPTACLE - NORMAL POWER CIRCUIT	Ŕ	DOOR RELEASE	CU	COPPER	PH or Ø	PHASE
	FLOOR BOX DUPLEX RECEPTACLE - EMERGENCY POWER CIRCUIT	FS	SPRINKLER SYSTEM FLOW SWITCH	DB DC	DIRECT BURIAL DIRECT CURRENT	PV PNL	POST INDICATOR VALVI PANELBOARD
	FLOOR BOX QUADRAPLEX RECEPTACLE - NORMAL POWER CIRCUIT FLOOR BOX QUADRAPLEX RECEPTACLE - EMERGENCY POWER CIRCUIT	Ă A A A A A A A A A A A A A A A A A A A	SPRINKLER SYSTEM TAMPER SWITCH	DEPT DF	DEPARTMENT DRINKING FOUNTAIN	PL PREFAB	PILOT LIGHT PREFABRICATED
	FLOOR BOX BLANK	TS		DIST	DISTRIBUTION	PRES	PRESSURE
	FLOOR BOX POWER AND TELECOM	<u></u> €IV	POST INDICATOR VALVE	DM DO	DEMAND METER DRAWOUT	PT PTS	PNEUMATIC TUBE PNEUMATIC TUBE STAT
	MULTI-OUTLET ASSEMBLY (POWER AND/OR TELECOM)	FACP	FIRE ALARM CONTROL PANEL	DRS DWG	DOCTORS DRAWING	PW PWR	PART WINDING POWER
		FAAP	FIRE ALARM ANNUNCIATOR PANEL	EC	ELECTRICAL CONTRACTOR	RACU	ROOM AIR CONDITIONIN
		NAC	FIRE ALARM NOTIFICATION APPLIANCE CONTROL PANEL	EF ELEC	EXHAUST FAN ELECTRIC	RAD RECEPT	RADIATION RECEPTACLE
<u> </u>	LECTRICAL SWITCHES	[ELEV ELV	ELEVATOR ELEVATION	REF or REFR REINF	REFRIGERATOR REINFORCED
SYMBOL	DESCRIPTION	INF(DRMATION SYSTEMS	EMER	EMERGENCY	RGIP	REMOTE GROUND INDIC
¢	TOGGLE SWITCH - 20 AMP, 120/277VAC			ENCL EP	ENCLOSURE ELECTRIC PNEUMATIC	RM RPM	REVOLUTIONS PER MIN
⊅ \$3	TOGGLE SWITCH - 3 WAY	<u>SYMBOL</u>	DESCRIPTION	EQUIP EWC	EQUIPMENT ELECTRIC WATER COOLER	SA SC	SUPPLY AIR SHORT CIRCUIT
↓ \$4	TOGGLE SWITCH - 4 WAY	▼ ×	VOICE AND DATA ONLY OUTLET	EX EXH	EXPLOSIONPROOF EXHAUST	SG SHT	SURGE GUARD PROTEC
Ф \$ ^к	TOGGLE SWITCH - KEY OPERATED		<u>"X" DENOTES AS FOLLOWS:</u>	EXP	EXPANSION	SIG	SIGNAL
\$ ⊺	TOGGLE SWITCH - HORSE POWER RATED MANUAL MOTOR		# - QUANTITY OF JACK(S) AND CABLE(S) R - ROUGH-IN ONLY	EXT ⁰F	EXTERIOR DEGREES FAHRENHEIT	SN SPEC	SOLID NEUTRAL SPECIFICATIONS
ዋ ተ₽	STARTER WITH THERMAL OVERLOAD PROTECTION	\mathbf{r}^{X}	CEILING - VOICE AND DATA WAP - WIRELESS ACCESS	FA FAAP	FIRE ALARM FIRE ALARM ANNUNCIATOR PANEL	SQ SS	SQUARE SAFETY SWITCH
\$ ^P	TOGGLE SWITCH - PILOT LIGHT		POINT	FACP	FIRE ALARM CONTROL PANEL	SSSS	SOLID STATE SOFT STA
D D ³	DIMMER SWITCH - 20 AMP, 120/277VAC	X	FLOOR BOX - VOICE AND DATA	FC FCU	FLAT CABLE FAN COIL UNIT	STD STN	STANDARD STATION
	DIMMER SWITCH - 3 WAY DIMMER SWITCH - 4 WAY		TELECOMMUNICATIONS EQUIPMENT RACK	FFC FFS	FOOD FACILITY CONTRACTOR FOOD FACILITY SUPPLIER	STR SUSP	STRUCTURAL SUSPENDED
OC1	WALL OCCUPANCY SENSOR - 1 BUTTON CONTROL	TV	TV SYSTEM OUTLET	FHC	FIRE HOSE CABINET	SW	SWITCH
OC2	WALL OCCUPANCY SENSOR - 2 BUTTON CONTROL	AV	AUDIO/VISUAL CONTROLLER	FIN FIXT	FINISH FIXTURE	SWBD SWGR	SWITCHBOARD SWITCHGEAR
0C3	WALL OCCUPANCY SENSOR - DUAL RELAY FOR	н©	CLOCK SYSTEM OUTLET	FL FLUOR	FLOOR FLUORESCENT	TCC TELE	TEMPERATURE CONTR TELECOMMUNICATION
00	EXHAUST FAN CONTROL CEILING OCCUPANCY SENSOR	Μ	MICROPHONE INPUT RECEPTACLE - WALL MOUNTED	FLEX-CONN	FLEXIBLE CONNECTION	TEMP	TEMPERATURE
VS1	WALL VACANCY SENSOR - 1 BUTTON CONTROL	M	MICROPHONE INPUT RECEPTACLE - CEILING MOUNTED	FPC FSS	FIRE PROTECTION CONTRACTOR FUSED SAFETY SWITCH	TMH TV	TOP OF MANHOLE TELEVISION
VS2	WALL VACANCY SENSOR - 2 BUTTON CONTROL	Ś	SPEAKER - CEILING MOUNTED	FTG FVR	FOOTING FILMVIEWER	TYP UC	TYPICAL UNDER CARPET
LC	LOW VOLTAGE LIGHTING CONTROLLER	чS	SPEAKER - WALL MOUNTED	FV	FULL VOLTAGE	U/C	UNDER CABINET or UNE
T	0 - 3 HOUR TIMER SWITCH - 20 AMP, 120/277VAC	V	VOLUME CONTROL	FVNR G or GND	FULL VOLTAGE NON REVERSING GROUND	UH UV	UNIT HEATER UNIT VENTILATOR
PC	PHOTO CELL			GALV GC	GALVANIZED GENERAL CONTRACTOR	V VAC	VOLT VACUUM
			R SECURITY SYSTEM	GEN GFCI	GENERATOR GROUND FAULT CKT. INTERRUPTER	VB VC	VACUUM BREAKER VACUUM CLEANING
F	LECTRICAL EQUIPMENT			GFI	GROUND FAULT INTERRUPTER	VEL	VELOCITY
		<u>SYMBOL</u>	DESCRIPTION	GFP HGT	GROUND FAULT PROTECTION HEIGHT	VFD VM	VARIABLE FREQUENCY VOLTMETER
<u>SYMB</u>	OL DESCRIPTION	ссти	CCTV COAXIAL CABLE OUTLET AND POWER OUTLET	HH HID	HANDHOLE HIGH INTENSITY DISCHARGE	VOL VP	VOLUME VAPORPROOF
B	PAD MOUNTED TRANSFORMER	MTV		НО	HAND OPERATED	VSD/VFC	VARIABLE SPEED DRIVI
		С DR	DOOR BUZZER ELECTRIC DOOR OPENER	HOA HORZ	HAND-OFF-AUTOMATIC HORIZONTAL	W/ W/O	WITH WITHOUT
	SUSPENDED TRANSFORMER	DR ES	ELECTRIC DOOR OPENER	HP HPS	HORSEPOWER HIGH PRESSURE SODIUM	WTR WP	WATER WEATHERPROOF
			INTERCOM UNIT FLUSH MTD.	HTR	HEATER	WT	WEIGHT
	BRANCH PANELBOARD - RECESSED MOUNT	MI	MASTER INTERCOM AND DIRECTORY UNIT	HV	HIGH VOLTAGE	XFMR Z	TRANSFORMER IMPEDANCE
	BRANCH PANELBOARD - SURFACE MOUNT DISCONNECT SWITCH - NON-FUSED	DS	SECURITY DUTY STATION				
L' D'	DISCONNECT SWITCH - NON-FUSED	SS ML	SECURITY STAFF STATION		RACEWAY SY	STEM	
	MOTOR CONTROLLER		SECURITY DOOR ALARM MAGNETIC LOCK SECURITY CARD READER				
⊠r	COMBINATION MOTOR CONTROLLER / DISCONNECT	MD	MOTION DETECTOR				
	TELECOM TERMINAL BOARD	DC	SECURITY DOOR CONTACTS			R SIZE. (REFER TO FEED DITIONAL INFORMATION	
- -	- GROUND BAR JUNCTION OR PULL BOX	PB	SECURITY EXIT PUSH BUTTON		PHASE	CONDUCTORS	
Û ∎→	JUNCTION OR PULL BOX PUSHBUTTON OR PUSH PLATE	SM DE	SECURITY MONITOR SECURITY DOOR EGRESS			AL.	
Ū	ELECTRIC THERMOSTAT	DE K	SECURITY DOOR EGRESS			D	
\wedge		BS	BIOSCAN ACCESS PAD				
\sim			CAMERA		LINE SYMBOL	S	

] []			
	ECTRICAL RECEPTACLES		RE ALARM SYSTEM				
	DESCRIPTION DUPLEX RECEPTACLE - NORMAL POWER CIRCUIT	SYMBOL	DESCRIPTION MANUAL SENDING STATION	ABBREVIATION A or AMP	DESCRIPTION AMPERE	ABBREVIATION HZ	<u>DESCRIPTION</u> HERTZ
¶	DUPLEX RECEPTACLE - EMERGENCY POWER CIRCUIT	\$D	WALL SMOKE DETECTOR	AC A/C	ALTERNATING CURRENT AIR CONDITIONING	IC ID	INTERCOMMUNICATION
Ŧ	DUPLEX GFCI RECEPTACLE - NORMAL POWER CIRCUIT		WALL SMOKE DETECTOR WITH SOUNDER BASE	ACP ACU	ACCESS PANEL AIR CONDITIONING UNIT	INCAN INCL	INCANDESCENT INCLUDE
₽	DUPLEX GFCI RECEPTACLE - EMERGENCY POWER CIRCUIT	(SD)	CEILING SMOKE DETECTOR	ADD ADJ	ADDITION ADJUSTABLE	ISG JB	ISOLATED GROUND SURG
₽	QUADRAPLEX RECEPTACLE - NORMAL POWER CIRCUIT QUADRAPLEX RECEPTACLE - EMERGENCY POWER CIRCUIT	SD	CEILING SMOKE DETECTOR WITH SOUNDER BASE	AF AFC	AMPERE FRAME ABOVE FINISHED CEILING	JT KEC	JOINT KITCHEN EQUIPMENT CON
Ħ	QUADRAPLEX GFCI RECEPTACLE - NORMAL POWER CIRCUIT	₩ ×	AUTOMATIC DUCT DETECTOR ("X" DENOTES AS FOLLOWS) NONE - PHOTOELECTRIC TYPE	AFF AFG AHU	ABOVE FINISHED FLOOR ABOVE FINISHED GRADE AIR HANDLING UNIT	KT KVA KVAR	KITCHENETTE KILOVOLT AMPERE KILOVOLT AMPERE REACT
#	QUADRAPLEX GFCI RECEPTACLE - EMERGENCY POWER CIRCUIT	X	S - SUPPLY R - RETURN	AIC AL	AIR HANDLING UNIT AMPERE INTERRUPTING CAPACITY ALUMINUM	KVAR KW LAB	KILOVOLT AMPERE REACT KILOWATT LABORATORY
Ψ	SIMPLEX RECEPTACLE - NORMAL POWER CIRCUIT	RT	REMOTE DETECTOR TEST STATION	AL AM AMB	AMMETER AMBIENT	LAD LB I F	POUND LINEAR FEET
Ţ Ø	SIMPLEX RECEPTACLE - EMERGENCY POWER CIRCUIT SPECIAL RECEPTACLE - NORMAL POWER CIRCUIT	RI	REMOTE DETECTOR INDICATOR STATION	APPROX. ARCH	APPROXIMATELY	LOC LS	LINEARTIELT LOCATION LIFE SAFETY
Ŷ	SPECIAL RECEPTACLE - EMERGENCY POWER CIRCUIT		HEAT DETECTOR	ATS	AUTOMATIC TRANSFER SWITCH	LT LTG	LIGHT
Ŷ	DUPLEX RECEPTACLE - TOP SWITCHED	(FD)	FLAME DETECTOR	AVG BC	AVERGE BARE COPPER	LV MATV	LOW VOLTAGE MASTER ANTENNA TELEV
	TACLE LEGEND RECEPTACLE ABOVE COUNTERTOP AT +2" ABOVE	BD		BKR BHP	BREAKER BRAKE HORSEPOWER	MAX MC	MAXIMUM MECHANICAL CONTRACTO
Ŷ	BACKSPLASH TO BOTTOM OF DEVICE. COORDINATE WITH CASEWORK TO BE INSTALLED.		WALL HORN ONLY WALL HORN STROBE	BL BLDG	BUILDING LINE BUILDING	MCB MCC	MAIN CIRCUIT BREAKER MOTOR CONTROL CENTEI
₽	RECEPTACLE INSTALLED BELOW COUNTERTOP AT +18"		CEILING HORN ONLY	BR BTM	BRANCH BOTTOM	MDP MECH	MAIN DISTRIBUTION PANE MECHANICAL
₩ ¶x	A.F.F. COORDINATE WITH CASEWORK TO BE INSTALLED.	(I) (H)	CEILING HORN STROBE	C ℃	CONDUIT DEGREES CELSIUS	MH MIN	MANHOLE MINIMUM
ΠХ	"X" DENOTES AS FOLLOWS: NONE - 20 AMP, 125VAC	$\langle s \rangle$	WALL SPEAKER ONLY	CAB CB or C/B	CABINET CIRCUIT BREAKER	MISC MLO	MISCELLANEOUS MAIN LUGS ONLY
	HM - 20 AMP, 125VAC, HORIZONTAL MOUNT TYPE IG - 20 AMP, 125VAC, ISOLATED GROUND TYPE	Ś	WALL SPEAKER STROBE	C/C CCTV	CENTER TO CENTER CLOSED CIRCUIT TELEVISION	MTD MTG HT	MOUNTED MOUNTING HEIGHT
	S - 20 AMP, 125VAC, SURGE GUARD PROTECTION TYPE	Ś	CEILING SPEAKER STROBE	CKT CL	CIRCUIT CENTER LINE	MU OD	MEDICINE UNIT OUTSIDE DIAMETER
	ST - 20 AMP, 125VAC, SAFETY TYPE WP - 20 AMP, 125VAC, WEATHERPROOF TYPE	$\langle \rangle$	WALL VISUAL ONLY	CLG COL	CEILING COLUMN	OFCI OFOI	OWNER FURNISHED-CON OWNER FURNISHED-OWN
()	CEILING DUPLEX RECEPTACLE - NORMAL POWER CIRCUIT	V	CEILING VISUAL ONLY	COMM COMP	COMMUNICATION COMPRESSOR	OPNG OPP	OPENING OPPOSITE
Ó	CEILING DUPLEX RECEPTACLE - EMERGENCY POWER CIRCUIT	ÂR	FIRE ALARM ADDRESSABLE RELAY	CONC CONST	CONCRETE CONSTRUCTION	OR P	OPERATING ROOM POLE
	CEILING QUADRAPLEX RECEPTACLE - NORMAL POWER CIRCUIT CEILING QUADRAPLEX RECEPTACLE - EMERGENCY POWER CIRCUIT		FIREMANS JACK	CONT CONTR	CONTINUOUS CONTRACTOR	PB PBOX	PUSHBUTTON PULL BOX
	FLOOR BOX DUPLEX RECEPTACLE - NORMAL POWER CIRCUIT		DOOR UNLOCK	CR CT	CRITICAL CURRENT TRANSFORMER	PE PF	PNEUMATIC ELECTRIC CC POWER FACTOR
	FLOOR BOX DUPLEX RECEPTACLE - EMERGENCY POWER CIRCUIT		DOOR RELEASE	CU DB	COPPER DIRECT BURIAL	PH or Ø PV	PHASE POST INDICATOR VALVE
	FLOOR BOX QUADRAPLEX RECEPTACLE - NORMAL POWER CIRCUIT	FS	SPRINKLER SYSTEM FLOW SWITCH	DC DEPT	DIRECT CURRENT DEPARTMENT	PNL PL	PANELBOARD PILOT LIGHT
	FLOOR BOX QUADRAPLEX RECEPTACLE - EMERGENCY POWER CIRCUIT FLOOR BOX BLANK		SPRINKLER SYSTEM TAMPER SWITCH	DF DIST	DRINKING FOUNTAIN DISTRIBUTION	PREFAB PRES	PREFABRICATED PRESSURE
	FLOOR BOX POWER AND TELECOM			DM DO	DEMAND METER DRAWOUT	PT PTS	PNEUMATIC TUBE PNEUMATIC TUBE STATIO
	MULTI-OUTLET ASSEMBLY (POWER AND/OR TELECOM)	FACP	FIRE ALARM CONTROL PANEL	DRS DWG	DOCTORS DRAWING	PW PWR	PART WINDING POWER
		NAC	FIRE ALARM NOTIFICATION APPLIANCE CONTROL PANEL	EC EF	ELECTRICAL CONTRACTOR EXHAUST FAN	RACU RAD	ROOM AIR CONDITIONING RADIATION
El	LECTRICAL SWITCHES			ELEC ELEV	ELECTRIC ELEVATOR	RECEPT REF or REFR	RECEPTACLE REFRIGERATOR
<u>SYMBOL</u>	DESCRIPTION	INF	DRMATION SYSTEMS	ELV EMER	ELEVATION EMERGENCY	REINF RGIP	REINFORCED REMOTE GROUND INDICA
\$	TOGGLE SWITCH - 20 AMP, 120/277VAC	SYMBOL	DESCRIPTION	ENCL EP EQUIP	ENCLOSURE ELECTRIC PNEUMATIC EQUIPMENT	RM RPM	ROOM REVOLUTIONS PER MINUT SUPPLY AIR
\$ 3	TOGGLE SWITCH - 3 WAY	<u>▼</u> ×	VOICE AND DATA ONLY OUTLET	EWC	ELECTRIC WATER COOLER	SA SC	SHORT CIRCUIT
\$ ⁴	TOGGLE SWITCH - 4 WAY	•	<u>"X" DENOTES AS FOLLOWS:</u>	EX EXH EXP	EXPLOSIONPROOF EXHAUST EXPANSION	SG SHT SIG	SURGE GUARD PROTECTI SHEET
\$ĸ \$⊺	TOGGLE SWITCH - KEY OPERATED TOGGLE SWITCH - HORSE POWER RATED MANUAL MOTOR		# - QUANTITY OF JACK(S) AND CABLE(S) R - ROUGH-IN ONLY	EXP EXT °F	EXPANSION EXTERIOR DEGREES FAHRENHEIT	SIG SN SPEC	SIGNAL SOLID NEUTRAL SPECIFICATIONS
•	STARTER WITH THERMAL OVERLOAD PROTECTION	\mathbf{r}^{X}	CEILING - VOICE AND DATA	FA FA FAAP	FIRE ALARM	SQ	SQUARE
\$° ⊡	TOGGLE SWITCH - PILOT LIGHT DIMMER SWITCH - 20 AMP, 120/277VAC		WAP - WIRELESS ACCESS POINT	FAAP FACP FC	FIRE ALARM ANNUNCIATOR PANEL FIRE ALARM CONTROL PANEL FLAT CABLE	SS SSSS STD	SAFETY SWITCH SOLID STATE SOFT STAR STANDARD
	DIMMER SWITCH - 3 WAY	×	FLOOR BOX - VOICE AND DATA	FC FCU FFC	FLAT CABLE FAN COIL UNIT FOOD FACILITY CONTRACTOR	STD STN STR	STANDARD STATION STRUCTURAL
D 4	DIMMER SWITCH - 4 WAY		TELECOMMUNICATIONS EQUIPMENT RACK TV SYSTEM OUTLET	FFS FHC	FOOD FACILITY SUPPLIER FIRE HOSE CABINET	SUSP SW	SUSPENDED SWITCH
OC1	WALL OCCUPANCY SENSOR - 1 BUTTON CONTROL		AUDIO/VISUAL CONTROLLER	FIN FIN FIXT	FINISH FIXTURE	SWBD SWGR	SWITCHBOARD SWITCHGEAR
OC2 OC3	WALL OCCUPANCY SENSOR - 2 BUTTON CONTROL WALL OCCUPANCY SENSOR - DUAL RELAY FOR	н©	CLOCK SYSTEM OUTLET	FL FLUOR	FLOOR FLUORESCENT	TCC TELE	TEMPERATURE CONTROL TELECOMMUNICATION
©	EXHAUST FAN CONTROL CEILING OCCUPANCY SENSOR	Μ	MICROPHONE INPUT RECEPTACLE - WALL MOUNTED	FLEX-CONN FPC	FLEXIBLE CONNECTION FIRE PROTECTION CONTRACTOR	TEMP	TEMPERATURE TOP OF MANHOLE
VS1	WALL VACANCY SENSOR - 1 BUTTON CONTROL	M	MICROPHONE INPUT RECEPTACLE - CEILING MOUNTED	FSS FTG	FUSED SAFETY SWITCH	TV TYP	TELEVISION TYPICAL
VS2	WALL VACANCY SENSOR - 2 BUTTON CONTROL	S	SPEAKER - CEILING MOUNTED	FVR FV	FILMVIEWER FULL VOLTAGE	UC U/C	UNDER CARPET UNDER CABINET or UNDER
LC	LOW VOLTAGE LIGHTING CONTROLLER 0 - 3 HOUR TIMER SWITCH - 20 AMP, 120/277VAC	⊢S IV	SPEAKER - WALL MOUNTED VOLUME CONTROL	FVNR G or GND	FULL VOLTAGE NON REVERSING GROUND	UH	UNIT HEATER UNIT VENTILATOR
PC	PHOTO CELL			GALV GC	GALVANIZED GENERAL CONTRACTOR	V VAC	VOLT VACUUM
		DOO	R SECURITY SYSTEM	GEN GFCI	GENERATOR GROUND FAULT CKT. INTERRUPTER	VB VC	VACUUM BREAKER VACUUM CLEANING
E	LECTRICAL EQUIPMENT			GFI GFP	GROUND FAULT INTERRUPTER GROUND FAULT PROTECTION	VEL VFD	VELOCITY VARIABLE FREQUENCY DF
SYMB	· · · · · · · · · · · · · · · · · · ·	SYMBOL CCTV	DESCRIPTION CCTV COAXIAL CABLE OUTLET AND POWER OUTLET	HGT HH	HEIGHT HANDHOLE	VM VOL	VOLTMETER VOLUME
	PAD MOUNTED TRANSFORMER	MTV	CCTV MONITOR OUTLET	HID HO	HIGH INTENSITY DISCHARGE HAND OPERATED	VP VSD/VFC	VAPORPROOF VARIABLE SPEED DRIVE/C
		С DR	DOOR BUZZER ELECTRIC DOOR OPENER	HOA HORZ	HAND-OFF-AUTOMATIC HORIZONTAL	W/ W/O	WITH WITHOUT
		ES	ELECTRIC DOOR STRIKE	HP HPS	Horsepower High Pressure Sodium	WTR WP	WATER WEATHERPROOF
	DISTRIBUTION PANELBOARD BRANCH PANELBOARD - RECESSED MOUNT	IC	INTERCOM UNIT FLUSH MTD.	HTR HV	HEATER HIGH VOLTAGE	WT XFMR	WEIGHT TRANSFORMER
	BRANCH PANELBOARD - SURFACE MOUNT	MI DS	MASTER INTERCOM AND DIRECTORY UNIT SECURITY DUTY STATION			Z	IMPEDANCE
다 안	DISCONNECT SWITCH - NON-FUSED	SS	SECURITY STAFF STATION		RACEWAY SY	OTEM	
	DISCONNECT SWITCH - FUSED MOTOR CONTROLLER	ML CR	SECURITY DOOR ALARM MAGNETIC LOCK SECURITY CARD READER		RACEWAIJI	<u>JIEIVI</u>	
∑,	COMBINATION MOTOR CONTROLLER / DISCONNECT	MD	MOTION DETECTOR			RIPTION SIZE. (REFER TO FEED	
 	TELECOM TERMINAL BOARD GROUND BAR	DC PB	SECURITY DOOR CONTACTS SECURITY EXIT PUSH BUTTON		FOR AD	DITIONAL INFORMATIO	
\bigcirc	JUNCTION OR PULL BOX	SM	SECURITY MONITOR		FXX	CONDUCTORS AL	
₽	PUSHBUTTON OR PUSH PLATE ELECTRIC THERMOSTAT	DE	SECURITY DOOR EGRESS SECURITY KEYPAD			n	
Ň	MOTOR ("X" DENOTES HORSEPOWER)	BS	BIOSCAN ACCESS PAD				
	— MOLDED CASE CIRCUIT BREAKER	SCP	CAMERA SECURITY CONTROL PANEL		<u>LINE SYMBOL</u>	<u>.S</u>	
⊥ Ţ	GROUND CONNECTION				T/SCREENED SOLID OR DASHED LINES	INDICATE EXISTING TO	REMAIN
•	GROUND POINT				Y DASHED LINES INDICATE EXISTING T		
*	GROUND ROD			HEA	Y CONTINUOUS LINES INDICATE NEW V	VUKK	
\sum	GENERATOR			L			
N E	AUTOMATIC TRANSFER SWITCH						
L ●L							

\sim	$\mathbf{\gamma}$	\cdots
<u>}</u> <u>4</u>	GEN	NERAL NOTES - FIRE ALARM:
\	۹.	EXISTING JAIL FIRE ALARM SYSTEM IS SIMPLEX 4010 SERIES. THE EXISTING CONTROL PANEL IS LOCATED IN EXISTING UNIT E JAIL CONTROL ROOM ON THE SECOND FLOOR.
}	3.	ANY NEW FIRE ALARM DEVICES IN UNITS A,B,C SHALL BE CONNECTED TO EXISTING FIRE ALARM SYSTEM.
}	C.	ANY NEW FIRE ALARM DEVICES IN UNITS D,C SHALL BE CONNECTED TO NEW FIRE ALARM SYSTEM.
{	D.	PROVIDE INTERCONNECTION BETWEEN NEW AND EXISTING FIRE ALARM SYSTEMS IN THE JAIL.
<pre>{</pre>	Ξ.	UNIT F: PROVIDE NEW, HORN TYPE, FIRE ALARM SYSTEM IN ITS ENTIRTY FOR THE COMMUNITY CORRECTIONS BUILDING. REFER TO DRAWINGS AND SPECIFICATIONS FOR ADDITIONAL INFORMATION.
Lu	بىر	ununununununun

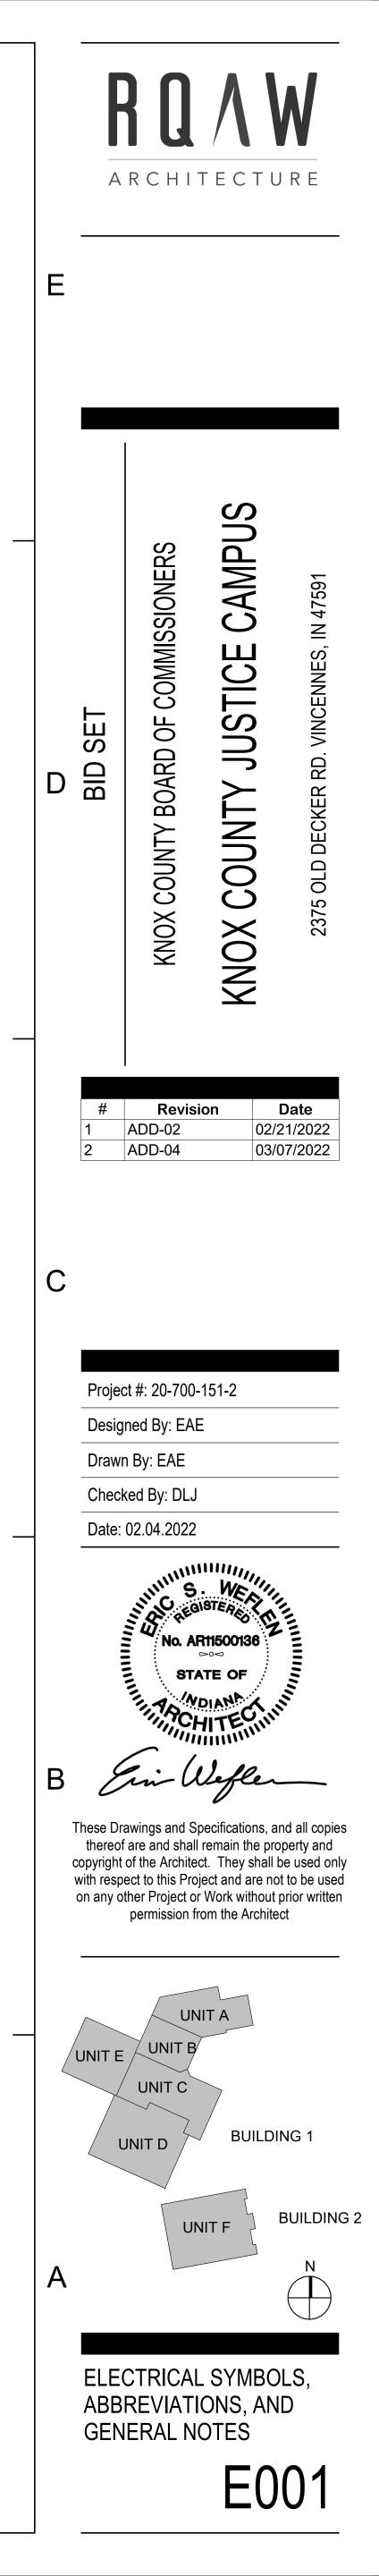

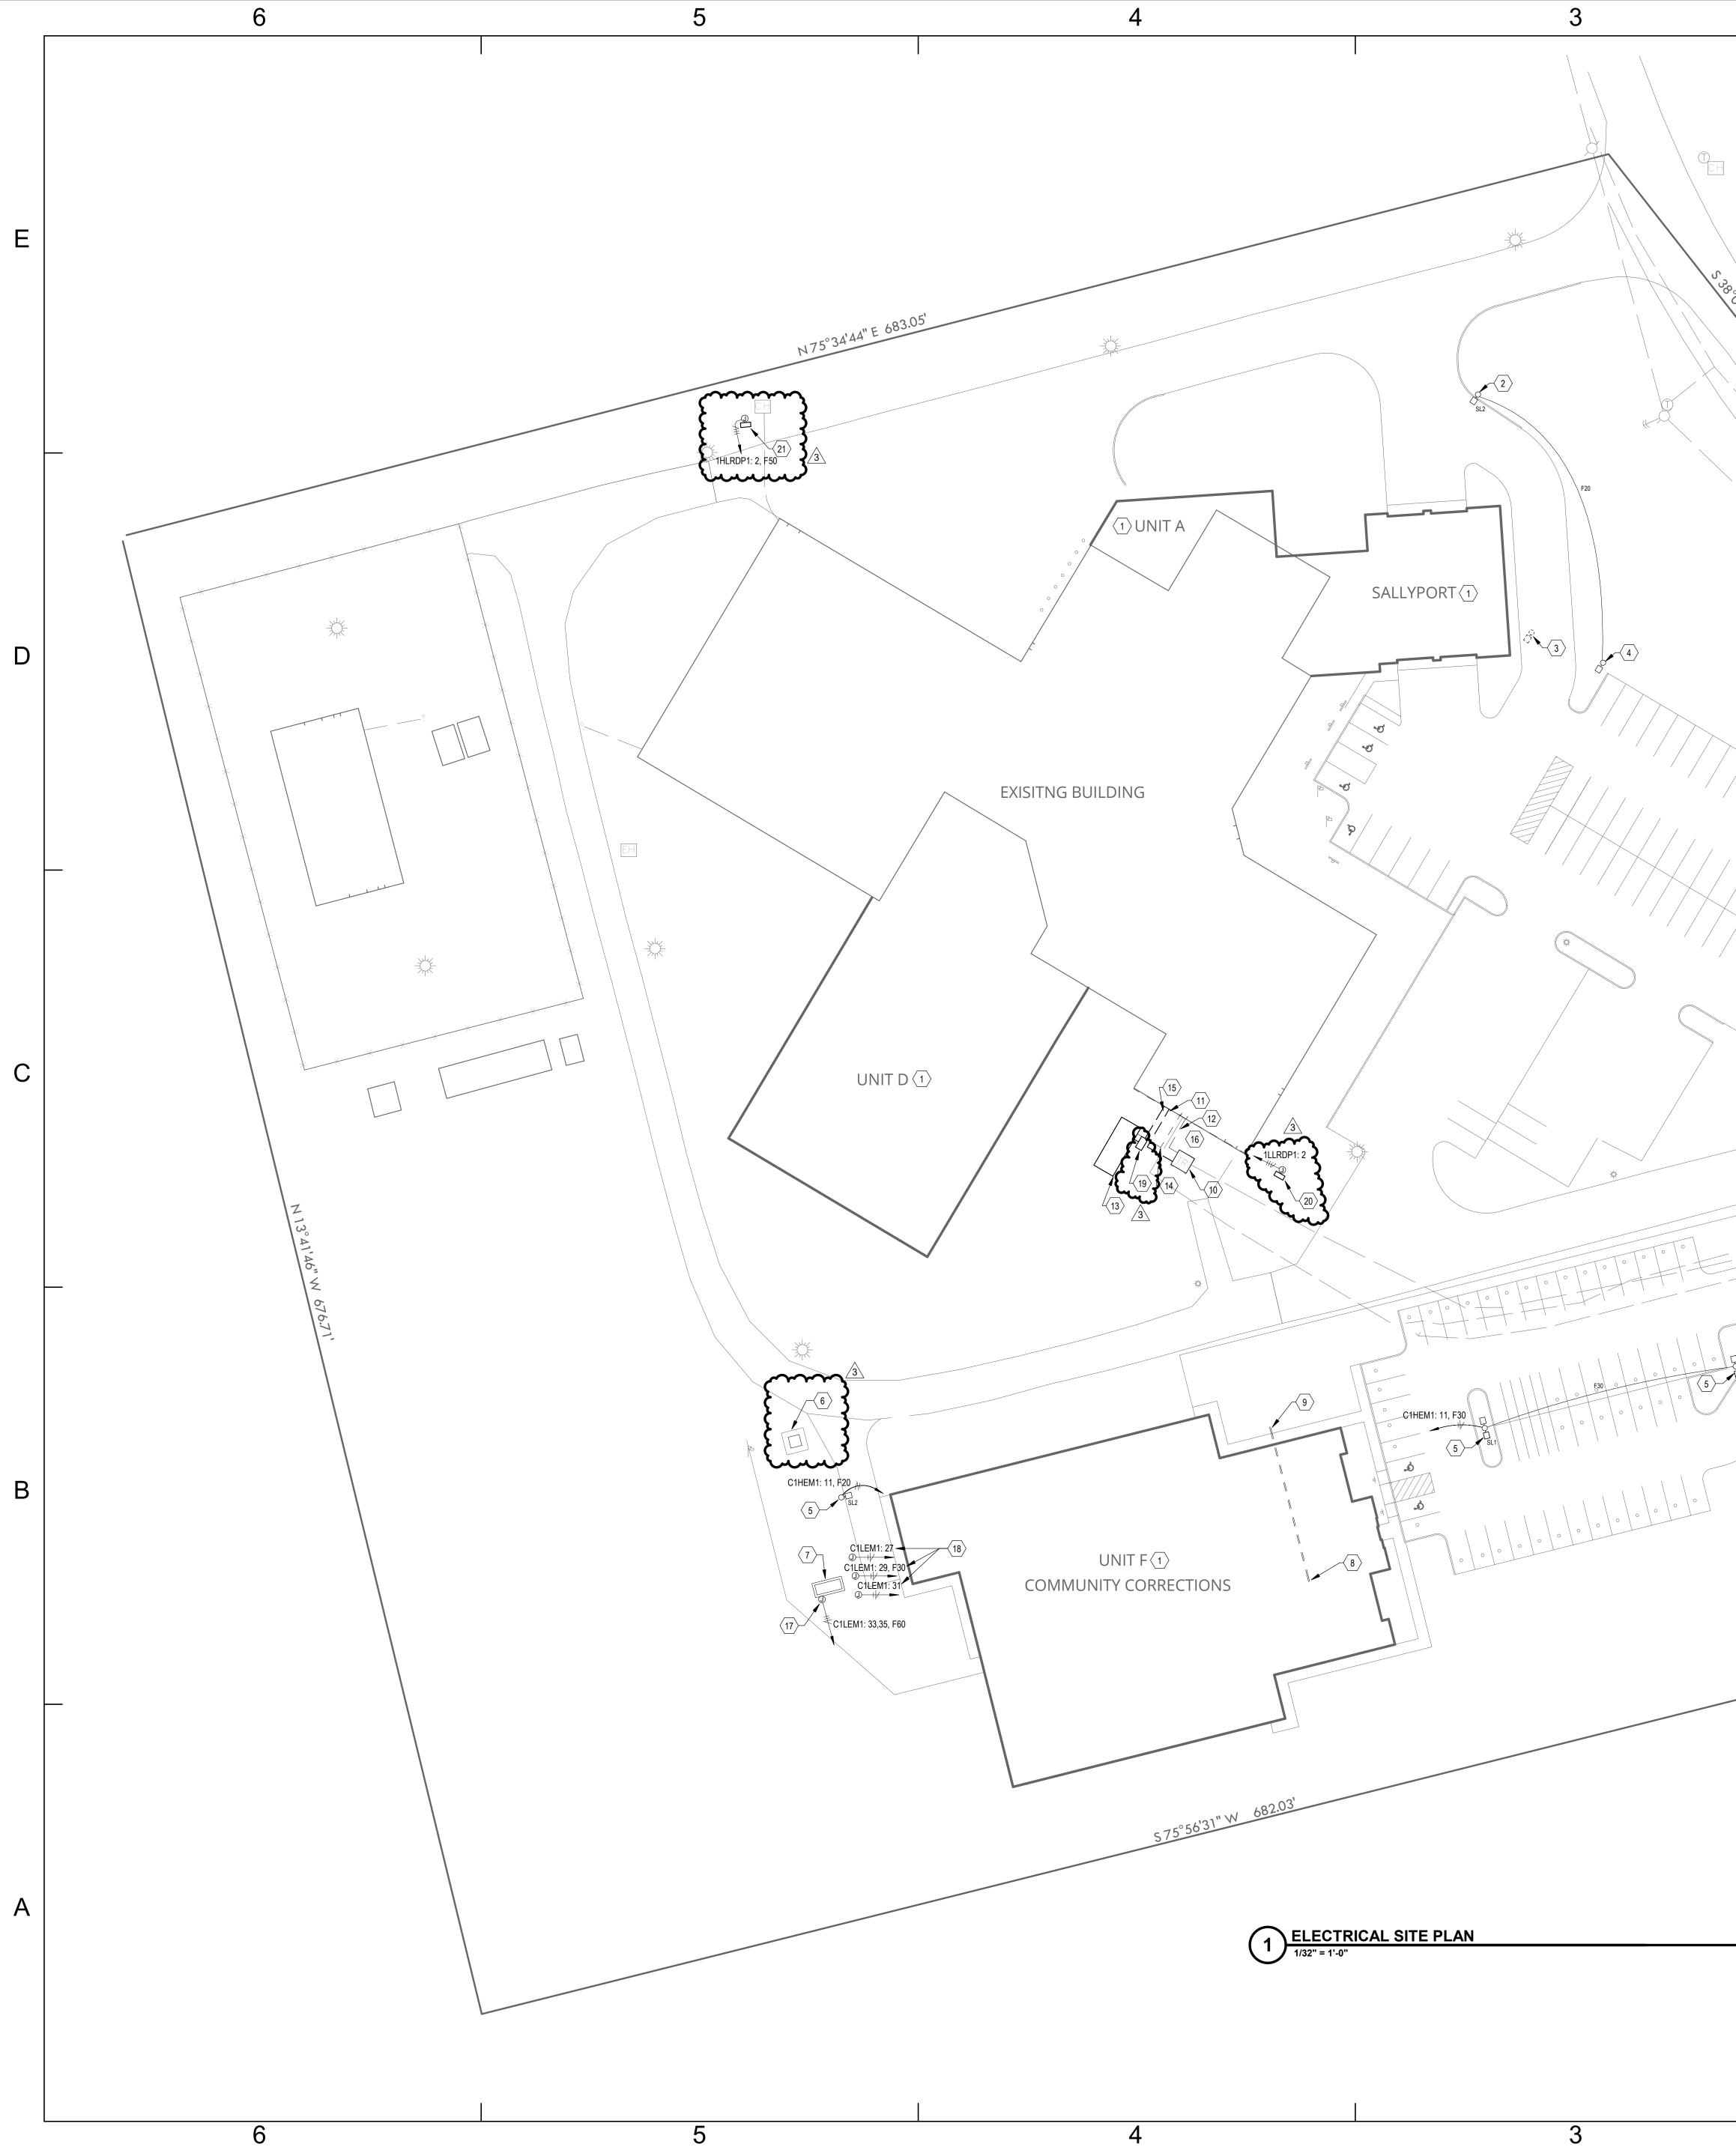

GENERAL NOTES - SITE:	

BUILDING.

Sr.

 \Diamond


- A. REFER TO SHEET E-001 FOR ELECTRICAL SYMBOLS AND ADDITIONAL GENERAL NOTES.
- B. COORDINATE ALL INCOMING ELECTRICAL SERVICE WORK WITH THE ELECTRICAL UTILITY COMPANY. PAY ALL FEES AND OTHER COSTS NOT BORNE BY THE ELECTRICAL UTILITY COMPANY TO PROVIDE NEW ELECTRICAL SERVICE TO THE PROJECT BUILDING. C. COORDINATE ALL INCOMING TELEPHONE SERVICE WORK WITH THE LOCAL TELEPHONE UTILITY COMPANY. PAY ALL FEES AND OTHER COSTS NOT BORNE BY THE LOCAL TELEPHONE UTILITY COMPANY TO PROVIDE NEW TELEPHONE SERVICE TO THE PROJECT
- D. PROVIDE PULL STRINGS IN ALL UTILITY CONDUITS.
- E. ALL EXTERIOR CONDUITS SHALL BE INSTALLED BELOW THE FROST LINE.
- F. COORDINATE LOCATIONS OF ALL UNDERGROUND CONDUITS, HANDHOLES AND MANHOLES, UNDERGROUND DRAINS, SERVICES, STRUCTURES, AND PAVING.
- G. PROVIDE ADDITIONAL HANDHOLES AND MANHOLES AS REQUIRED BY THE UTILITY COMPANIES. COORDINATE REQUIREMENTS WITH UTILITY COMPANIES PRIOR TO BID.
- H. COORDINATE ALL ROUTING AND TERMINATION LOCATIONS WITH THE UTILITY COMPANIES PRIOR TO BID.
- I. ALL CONDUCTORS FOR EXTERIOR LIGHTING AND POWER CIRCUITS SHALL BE #10 AWG MINIMUM.

	PLAN NOTES
#	NOTE
1	REFER TO LIGHTING FLOOR PLANS FOR BUILDING MOUNTED EXTERIOR LIGHTING.
2	CONNECT TO EXISTING SITE LIGHTING CIRCUIT. FIELD VERIFY CIRCUIT HAS SUFFICIENT CAPACITY PRIOR TO ANY MODIFICATIONS.
3	REMOVE AND SALVAGE EXISTING SITE LIGHTING FIXTURE. CLEAN AND PREPARE POLE AND FIXTURE FOR REINSTALLATION ON NEW POLE BASE. MODIFY EXISTING SITE LIGHTING CIRCUIT SO THAT ALL SITE LIGHTING REMAINS FUNCTIONAL. IF NECESSARY, EITHER INSTALL TRAFFIC RATED HANDHOLE, FLUSH WITH NEW PAVEMENT, OR MODIFY CONDUITS AND CIRCUIT WIRING TO REMOVE BACK TO LAST POINT.
4	REINSTALL EXISTING SITE FIXTURE, ON NEW POLE BASE. CONNECT TO EXISTING SITE LIGHTING CIRCUIT.
5	CONNECT COMPLETE VIA LIGHTING CONTROL PANEL SHOWN IN ROOM 156. REFER TO DRAWING E600 FOR ADDITIONAL INFORMATION.
6	PROPOSED UTILITY TRANSFORMER LOCATION. COORDINATE EXACT LOCATION WITH UTILITY. PROVIDE CONCRETE PIT / PAD AND ASSOCIATED BOLLARDS AS REQUIRED BY THE UTILITY. REFER TO ELECTRICAL ONELINE RISER DIAGRAM FOR ADDITIONAL INFORMATION.
7	PROPOSED DIESEL GENERATOR LOCATION. COORDINATE EXACT LOCATION WITH OTHER SITE UTILITIES AND CIVIL DRAWINGS. PROVIDE CONCRETE PAD AS PER MANUFACTURER'S REQUIREMENTS.
8	APPROXIMATE LOCATION OF DATA ROOM.
9	PROVIDE (2) 4" CONDUITS FROM DATA ROOM AND EXTEND TO PROPERTY LINE FOR TELECOM SERVICE ENTRANCE AS REQUIRED. COORDINATE EXACT LOCATION AND REQUIREMENTS WITH OWNER'S TELECOM PROVIDER. PROVIDE ADDITIONAL HANDHOLES AS REQUIRED.
10	EXISTING UTILITY PADMOUNT TRANSFORMER.
11	NEW UNDERGROUND FEED TO SWITHBOARD "1HNSB1".
12	EXISTING SERVICE FEED TO BE REMOVED COMPLETE.
13	EXISTING GENERATOR TO REMAIN UNDER BASE BID. GENERATOR SHALL BE DISCONNECTED FROM EXISTING "MSB" AND RECONNECTED TO "1HEMSB1" IN NEW ELECTRICAL ROOM.
14	EXISTING EMERGENCY SERVICE FEED TO BE REMOVED COMPLETE.
15	NEW UNDERGROUND FEED TO SWITHBOARD "1HNSB1".
16	CONTRACTOR SHALL MINIMIZE ANY OUTAGES DURING CONSTRUCTION WITH SERVICE RELOCATION. A TEMPORARY SERVICE SHALL BE PROVIDED VIA EXISTING GENERATOR OR PORTABLE GENERATOR DURING CHANGEOVER. CONTRACTOR SHALL COORDINATE ANY SERVICE DISRUPTIONS WITH OWNER AND ENGINEER.
17	CONNECT COMPLETE GENERATOR ACCESSORY LOAD CENTER PANEL. REFER TO RISER DIAGRAM AND ELECTRICAL SCHEDULES FOR ADDITIONAL INFORMATION.
18	PROVIDE CIRCUITS INDICATED TO GENERATOR DOCKING STATION ACCESSORIES AND CONNECT COMPLETE. REFER TO ASSOCIATED PANEL SCHEDULE FOR
\sim	LOCATION PRIOR TO INSTALLATION.
19	GENERATOR DOCKING STATION. VERIFY EXACT LOCATION.
20	LIFT STATION CONTROL PANEL. PROVIDE POWER FROM INDICATED CIRCUIT. PROVIDE 30A/3P DISCONNECT SWITCH IN NEMA 3R ENCLOSURE. PROVIDE INTERCONNECTION BETWEEN PUMPS AND CONTROL PANEL AS REQUIRED.
21	MUFFIN MONSTER CONTROL PANEL. PROVIDE POWER FROM INDICATED CIRCUIT. PROVIDE 60A/3P DISCONNECT SWITCH IN NEMA 3R ENCLOSURE. PROVIDE

23°. 51,

1

s75°56'31" W 165.12

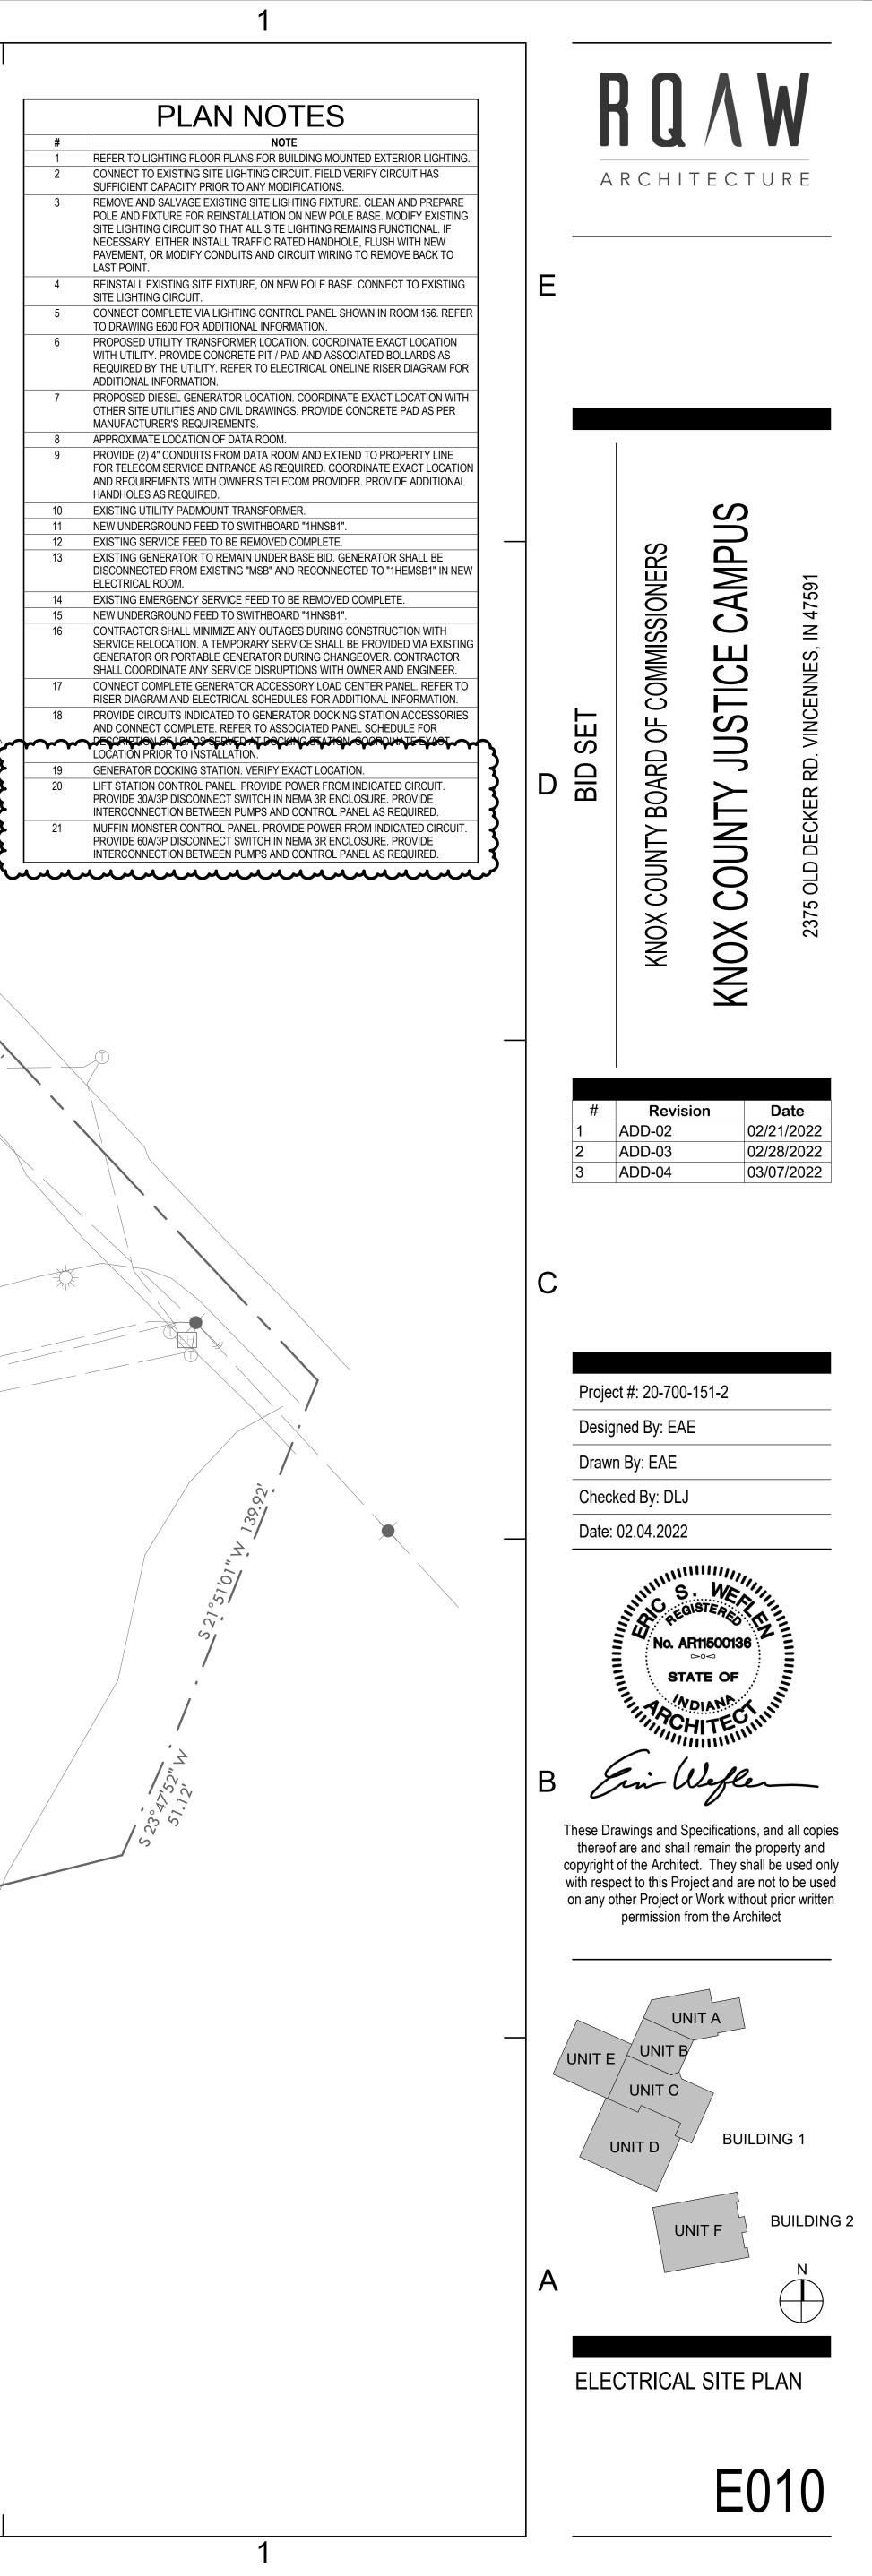



C. CA

GENERAL NOTES - SITE:

5

s75°56'31" W 165.12

- A. REFER TO SHEET E-001 FOR ELECTRICAL SYMBOLS AND ADDITIONAL GENERAL NOTES.
- B. COORDINATE ALL INCOMING ELECTRICAL SERVICE WORK WITH THE ELECTRICAL UTILITY COMPANY. PAY ALL FEES AND OTHER COSTS NOT BORNE BY THE ELECTRICAL UTILITY COMPANY TO PROVIDE NEW ELECTRICAL SERVICE TO THE PROJECT BUILDING.
- C. COORDINATE ALL INCOMING TELEPHONE SERVICE WORK WITH THE LOCAL TELEPHONE UTILITY COMPANY. PAY ALL FEES AND OTHER COSTS NOT BORNE BY THE LOCAL TELEPHONE UTILITY COMPANY TO PROVIDE NEW TELEPHONE SERVICE TO THE PROJECT BUILDING.
- D. PROVIDE PULL STRINGS IN ALL UTILITY CONDUITS.
- E. ALL EXTERIOR CONDUITS SHALL BE INSTALLED BELOW THE FROST LINE.
- F. COORDINATE LOCATIONS OF ALL UNDERGROUND CONDUITS, HANDHOLES AND MANHOLES, UNDERGROUND DRAINS, SERVICES, STRUCTURES, AND PAVING.
- G. PROVIDE ADDITIONAL HANDHOLES AND MANHOLES AS REQUIRED BY THE UTILITY COMPANIES. COORDINATE REQUIREMENTS WITH UTILITY COMPANIES PRIOR TO BID.
- H. COORDINATE ALL ROUTING AND TERMINATION LOCATIONS WITH THE UTILITY COMPANIES PRIOR TO BID.
- I. ALL CONDUCTORS FOR EXTERIOR LIGHTING AND POWER CIRCUITS SHALL BE #10 AWG MINIMUM.


PLAN NOTES

#	NOTE
1	EXISTING UTILITY PADMOUNT TRANSFORMER. TO BE RELOCATED. ADDITIONAL FEES FROM DUKE FOR RELOCATION SHALL BE VERIFIED WITH DUKE.
2	RELOCATED UTILITY PADMOUNT TRANSFORMER
3	NEW UNDERGROUND FEED TO SWITHBOARD "1HNSB1".
4	EXISTING SERVICE FEED TO BE REMOVED COMPLETE.
5	EXISTING GENERATOR TO BE RELOCATED UNDER ALTERNATE BID. GENERATOR SHALL BE DISCONNECTED FROM EXISTING "MSB" AND RECONNECTED TO "1HEMSB1" IN NEW ELECTRICAL ROOM.
6	RELOCATED GENERATOR. PROVIDE NEW CONCRETE BASE. REFER TO GENERATOR BAS DETAIL ON SHEET E800.
7	NEW UNDERGROUND FEED TO SWITHBOARD "1HNSB1".
8	PROVIDE FOUR (4) GROUNDING ELECTRODES ONE AT EACH CORNER OF ENCLOSURE. PROVIDE 3/4"(D) × 120"(L) COPPERCLAD GROUND ROD. DRIVE GROUND ROD TO WHERE TOP OF ROD IS APPROXIMATELY 36" BELOW FINISHED GRADE. BOND GROUND RODS TOGETHER USING #4/0 INSULATED COPPER CABLE. BONDS SHALL BE MADE WITH EXOTHERMIC WELDS OR IRREVERSIBLE COMPPRESSION TYPE FITTINGS.
9	PROVIDE #4/0 INSULATED COPPER CABLE WITHIN CONDUIT RACEWAY FROM GROUND RING TO WITHIN THE GENERATOR COMPARTMENT IN TWO LOCATIONS. BOND THE GENERATOR FRAME /METALLIC ENCLOSURE TO THE GROUND RING PER THE EQUIPMENT MANUFACTURER'S REQUIREMENTS.

5101

1


23°27.12 51.12

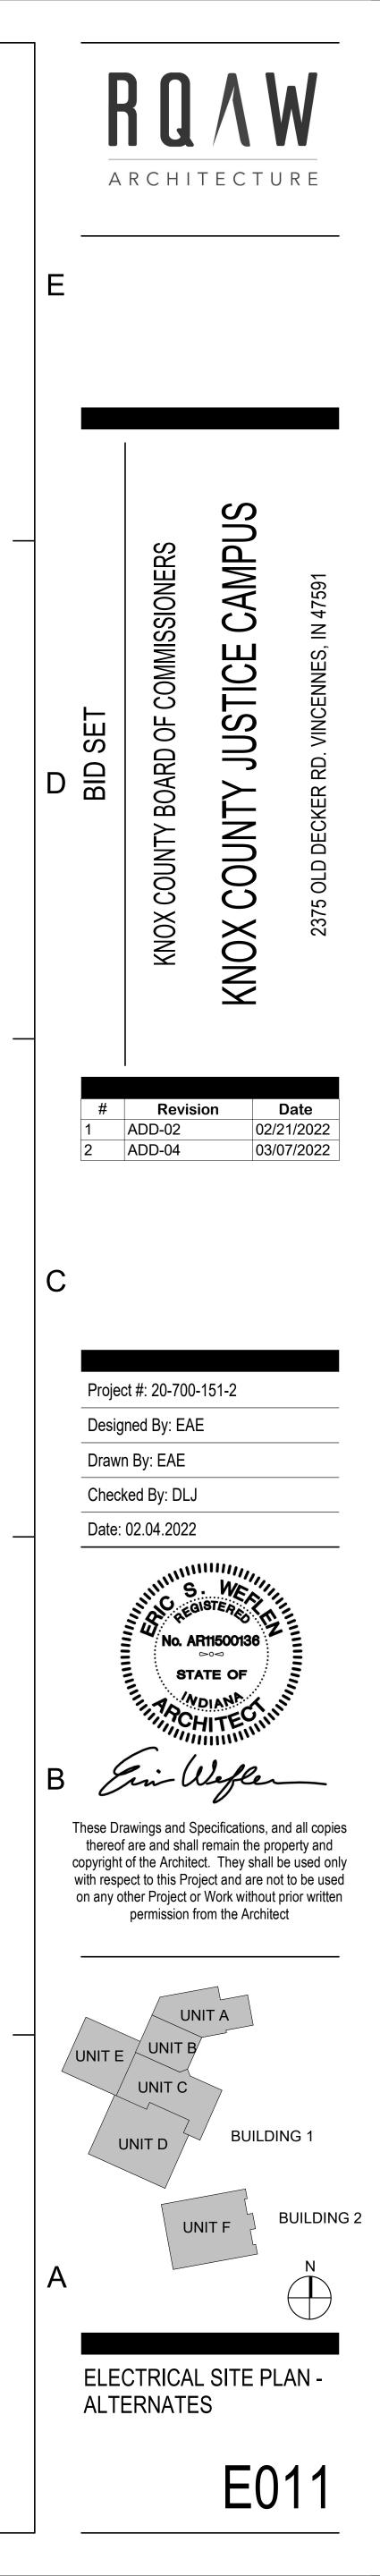







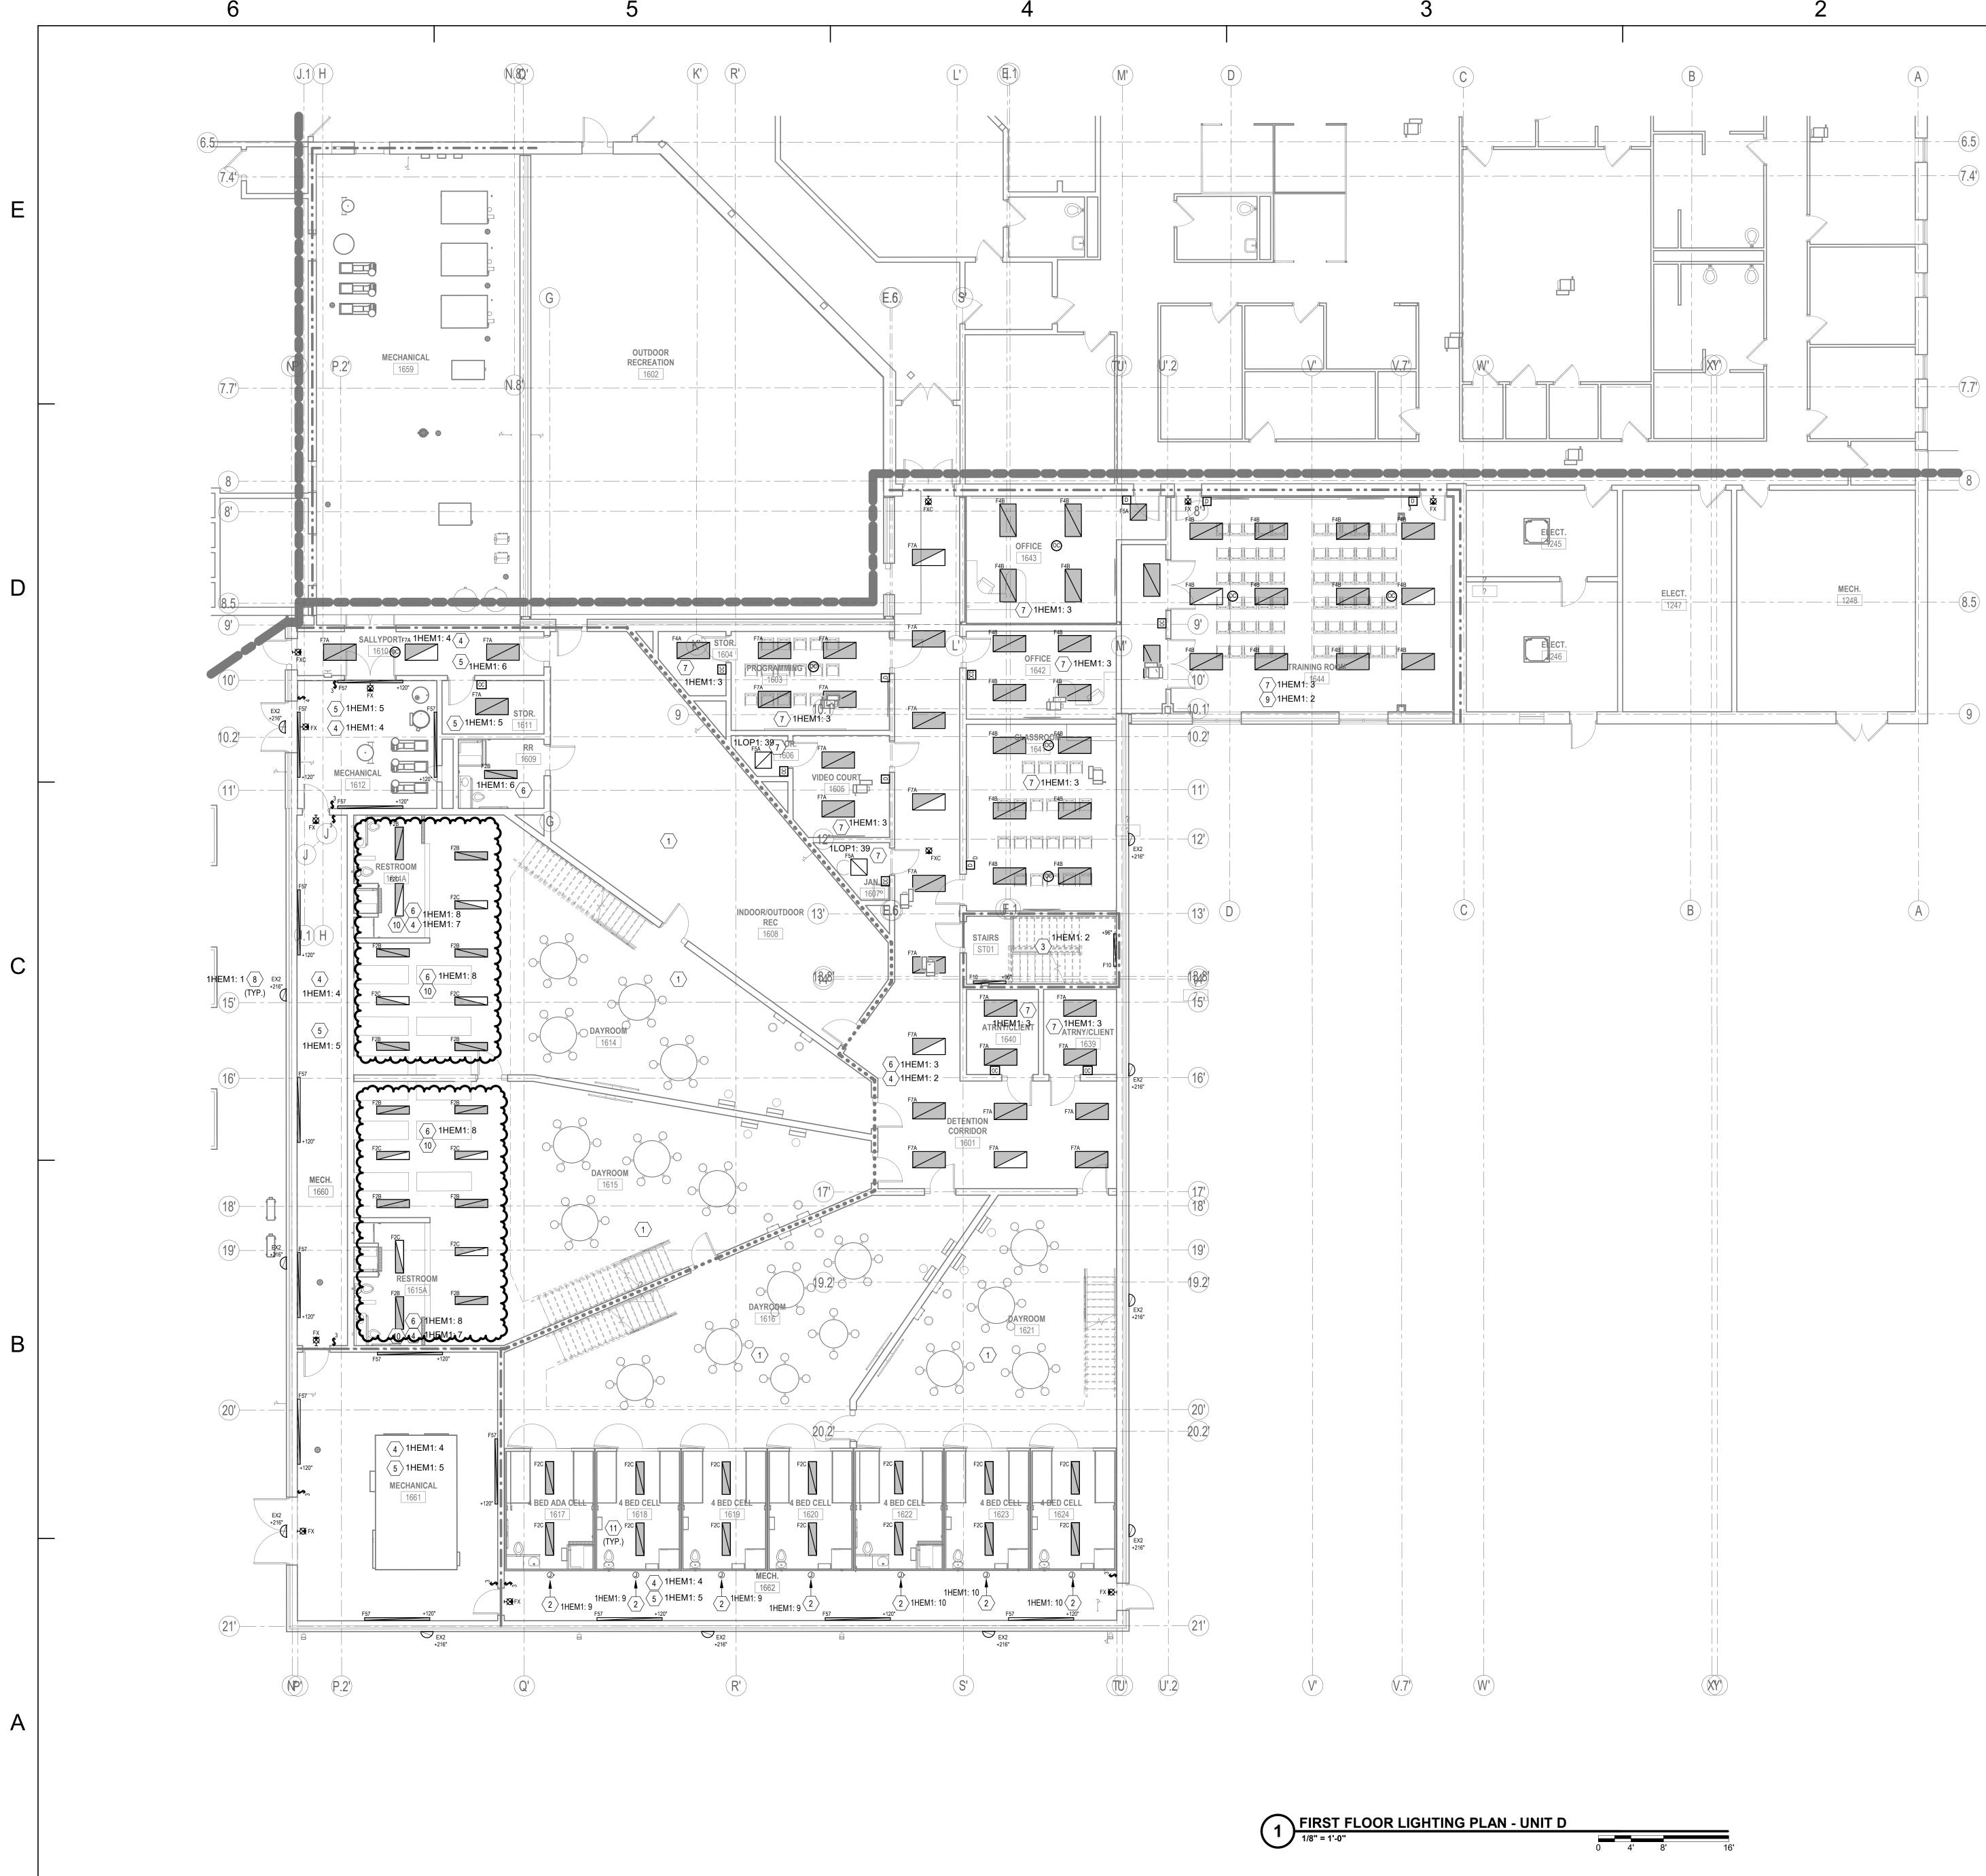

GENERAL NOTES - LIGHTING:

UNISTRUT BRACKET.

ADDITIONAL INFORMATION.

CONNECTIONS AS REQUIRED.

CIRCUIT INDICATED.

SWITCH LEG AND DRIVER.

INTEGRATION.

SENSOR

MANUAL CONTROL.

10

SPACE TYPE

OFFICES

TRAINING

ARMORY

ELECTRICAL ROOMS

TELECOM ROOMS SECURITY ROOMS

NON-CORRECTIONAL

CORRIDORS

BREAKROOMS

LOCKER ROOMS RESTROOMS

STORAGE

JANITORS CLOSETS

VESTIBULES

MECHANICAL CHASES

DESCRIBED ABOVE.

2

STAIRWELLS

INDICATED.

INDICATED.

- A. REFER TO SHEET E-001 FOR ELECTRICAL SYMBOLS AND ADDITIONAL GENERAL NOTES. B. REFER TO SPECIFICATION SECTION 260519 FOR MINIMUM CONDUCTOR SIZE REQUIRED
- BASED ON TOTAL CIRCUIT DISTANCE. C. CONNECT ALL EXIT AND EGRESS LIGHTING WITH A MINIMUM OF #10AWG UNLESS
- NOTED OTHERWISE.
- D. PROVIDE ALL OCCUPANCY/VACANCY SENSOR, POWER PACKS, AND ADDITIONAL RELAYS, ETC. AS REQUIRED FOR FULL COVERAGE OF ROOMS/AREAS INDICATED TO
- HAVE SUCH CONTROL. E. WALL MOUNTED EXIT LIGHTS SHALL BE MOUNTED AT LEAST 1'-0" ABOVE EXIT OPENING UNLESS NOTED OTHERWISE. CONTRACTOR TO VERIFY HEIGHT OF EXIT OPENING
- PRIOR TO ROUGH-IN.
- F. ALL OCCUPANCY SENSOR SHALL BE DUAL TECHNOLOGY (PASSIVE INFRARED AND
- ULTRASONIC) UNLESS NOTED OTHERWISE. G. SCHEDULE A MEETING WITH THE OWNER PRIOR TO PROGRAMMING OF LIGHTING
- CONTROL DEVICES TO DETERMINE DESIRED CONTROL, TIME DELAY SETTINGS,
- OCCUPANCY, ETC.

- H. ALL RECESSED LIGHTING FIXTURES IN LAY-IN CEILINGS SHALL BE INSTALLED WITH A

FLEXIBLE METAL CONDUIT WITH MAXIMUM LENGTH OF 6 FEET.

I. LIGHT FIXTURES THAT ARE INSTALLED WITHIN A FIRE-RATED CEILING SHALL BE

RATINGS. FIRE RATED COVERS SHALL BE COVERS SUCH AS TENMAT FIRE

FIRE RATED CEILING LOCATIONS AND PROVIDE COVERS ACCORDINGLY.

J. OCCUPANCY SENSORS LOCATED IN SECURE AREAS MUST BE SUPPORTED BY

PROVIDED WITH FIRE RATED COVERS IN ORDER TO MAINTAIN THE CEILING FIRE

PLAN NOTES

REFER TO LEVEL ABOVE FOR ADDITIONAL LIGHTING IN THIS AREA.

NOTE

LIGHTING IS PRE-WIRED TO JUNTION BOX ON BACK OF CELL. EACH JUNCTION BOX

CONTAINS LIGHT FIXTURE PIGTAILS WITH SWITCHED AND NIGHT LIGHT CIRCUITS.

CONNECT COMPLETE SWITCHED CIRCUIT LEG VIA SECURITY CONTROLS RELAY

CONTROL DEVICE SUCH THAT CELL LIGHTING IN EACH BLOCK IS CONTROLLED

VIA A DEDICATED REALY. REFER TO SECURITY DRAWINGS FOR ADDITIONAL

VIA CIRCUIT INDICATED. REFER TO SECOND FLOOR LIGHTING PLAN FOR

SENSORS. STAIRWELL LIGHTING SHALL OPERATE AT 50% LIGHT OUTPUT

WHEN SPACE IS OCCUPIED. CONNECT COMPLETE VIA CIRCUIT INDICATED.

CONNECT COMPLETE UNSWITCHED EXIT AND EGRESS LIGHTING VIA CIRCUIT

CONNECT COMPLETE SWITCHED LIGHTING IN THIS ROOM / AREA VIA CIRCUIT

CONNECT COMPLETE LIGHTING IN THIS ROOM / AREA VIA CIRCUIT INDICATED.

LIGHTS SHALL BE CONTROLLED VIA SECURITY CONTROLS RELAY. REFER TO

CONNECT COMPLETE LIGHT FIXTURES WITHIN THIS ROOM / AREA VIA LIGHTING

ALL NEW WALL PACKS SHALL MATCH EXISTING HEIGHTS AT APPROX. THE HEIGHT

SHOWN. EXTEND EXISTING SITE LIGHTING CONTROLS TO INCLUDE NEW CIRCUITS

CONNECT COMPLETE EMERGENCY LIGHT FIXTURES WITHIN THIS ROOM / AREA VIA

EMERGENCY LIGHTING IN THIS AREA SHALL SWITCH ON/OFF WITH GENERAL ROOM

AS SHOWN. CONNECT COMPLETE ALL EXTERIOR WALL PACKS IN AREA D VIA

PROVIDE EACH BUNK AREA FIXTURE WITH INTEGRAL DIMMABLE NIGHT LIGHT

PREMANUFACTURED CELL FIXTURES SHALL BE THE SAME TYPE AND DESIGN AS

DESCRIPTION

LIGHTING IN THIS SPACE SHALL OPERATE AS MANUAL ON; MANUAL OR

MANUAL LINE VOLTAGE SWITCH(ES). NO LIGHTING CONTROL SYSTEM

LIGHTING IN THIS ROOM SHALL OPERATE AS AUTO ON/ AUTO OFF. NO

LIGHTING IN THIS ROOM SHALL OPERATE AS AUTO ON/ AUTO OFF. CONTROL

LIGHTING SHALL DIM DOWN TO 50% OUTPUT, UNSWITCHED, IN UNOCCUPIED

STATE. LIGHT OUTPUT TO INCREASE TO 100% WHEN OCCUPANY SENSOR

THIS AREA IS CONTROLLED VIA DIGITAL PROGRAMMABLE TIMER SWITCH FOR TIME ON / TIME OFF OR MANUAL OFF OPERATION. TIME DURATION

SHALL BE SELECTABLE AT EACH SWITCH. PROVIDE BLINK WARNING OF

LIGHTS IN SPACE TWO MINUTES PRIOR TO TIME OFF.

DETENTION AREA, INMATE ACCESSIBLE AREAS DRIVE IN SALLY PORT SWITCHED CORRECTIONAL & DETENTION AREA LIGHTING CIRCUITS SHALL BE CONTROLLED VIA SECURITY RELAY PANEL.

NOTE: ROOM/SPACE CONTROL OPERATION SHALL NOT DEPEND ON "LAST STATE" USER INPUTS

PRESET TIME DELAY THEN THE ROOM CONTROLS SHALL REVERT BACK AND OPERATE AS

FOR HOW IT WILL OPERATE DAY TO DAY. REGARDLESS IF THE ROOM/SPACE HAS BEEN SHUT-OFF AUTOMATICALLY OR MANUALLY, AFTER ROOM SENSORS HAVE DETECTED NO OCCUPANTS FOR A

VIA MANUAL ON/OFF SWITCH AT WALL OR AUTO ON/OFF VIA OCCUPANCY

LIGHTING CONTROL DEVICE(S) SHOWN UTILIZING CIRCUIT INDICATED.

LIGHTING, WITH CONTROLS POWERED FROM EMERGENCY CIRCUIT.

TYPE F2C, AND PROVIDED BY CELL MANUFACTURER.

LIGHTING CONTROL INTENT

SCHEDULE

CONFERENCE ROOMS AUTO OFF. USER SHALL HAVE ON, OFF, RAISE, AND LOWER MANUAL

OVERRIDE BUTTONS AT WALL CONTROLS.

DETECTS THE SPACE IS OCCUPIED.

SECURITY DRAWINGS FOR ADDITIONAL INFORMATION AND PROVIDE

CONTROL DEVICE(S) SHOWN UTILIZING CIRCUIT INDICATED.

TOGETHER, WITH THE EXCEPTION OF THE ADA CELL, IT SHALL BE CONTROLLED


CONTROL INFORMATION AND PROVIDE CONNECTIONS ACCORDINGLY. CONNECT


STAIRWELL LIGHT FIXTURES SHALL BE PROVIDED WITH INTEGRAL OCCUPANCY

UNSWITCHED, IN UNOCCUPIED STATE. LIGHT OUTPUT SHALL INCREASE TO 100%

CELL LIGHTING PROVIDED INTEGRAL WITH CELL BY CELL MANUFACTURER. CELL


PROTECTION SOLUTIONS OR SIMILAR. REFER TO ARCHITECTURAL DRAWINGS FOR ALL

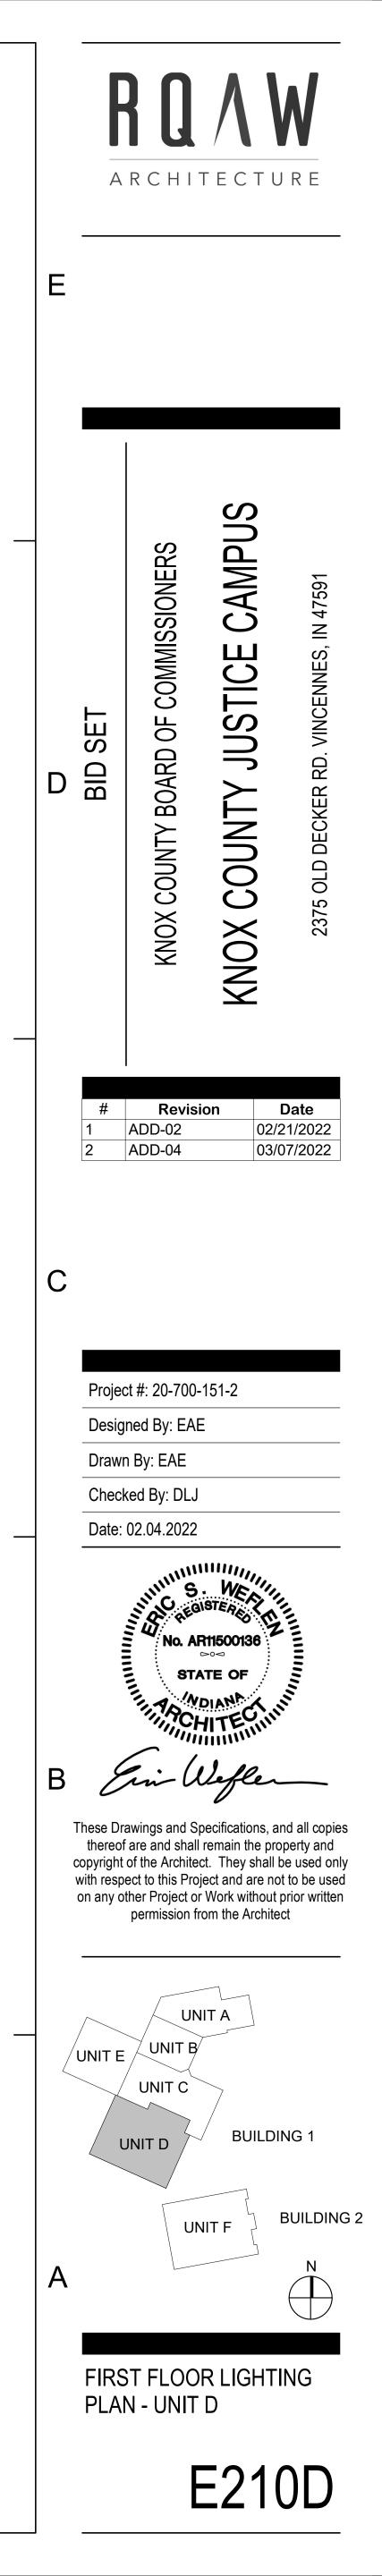

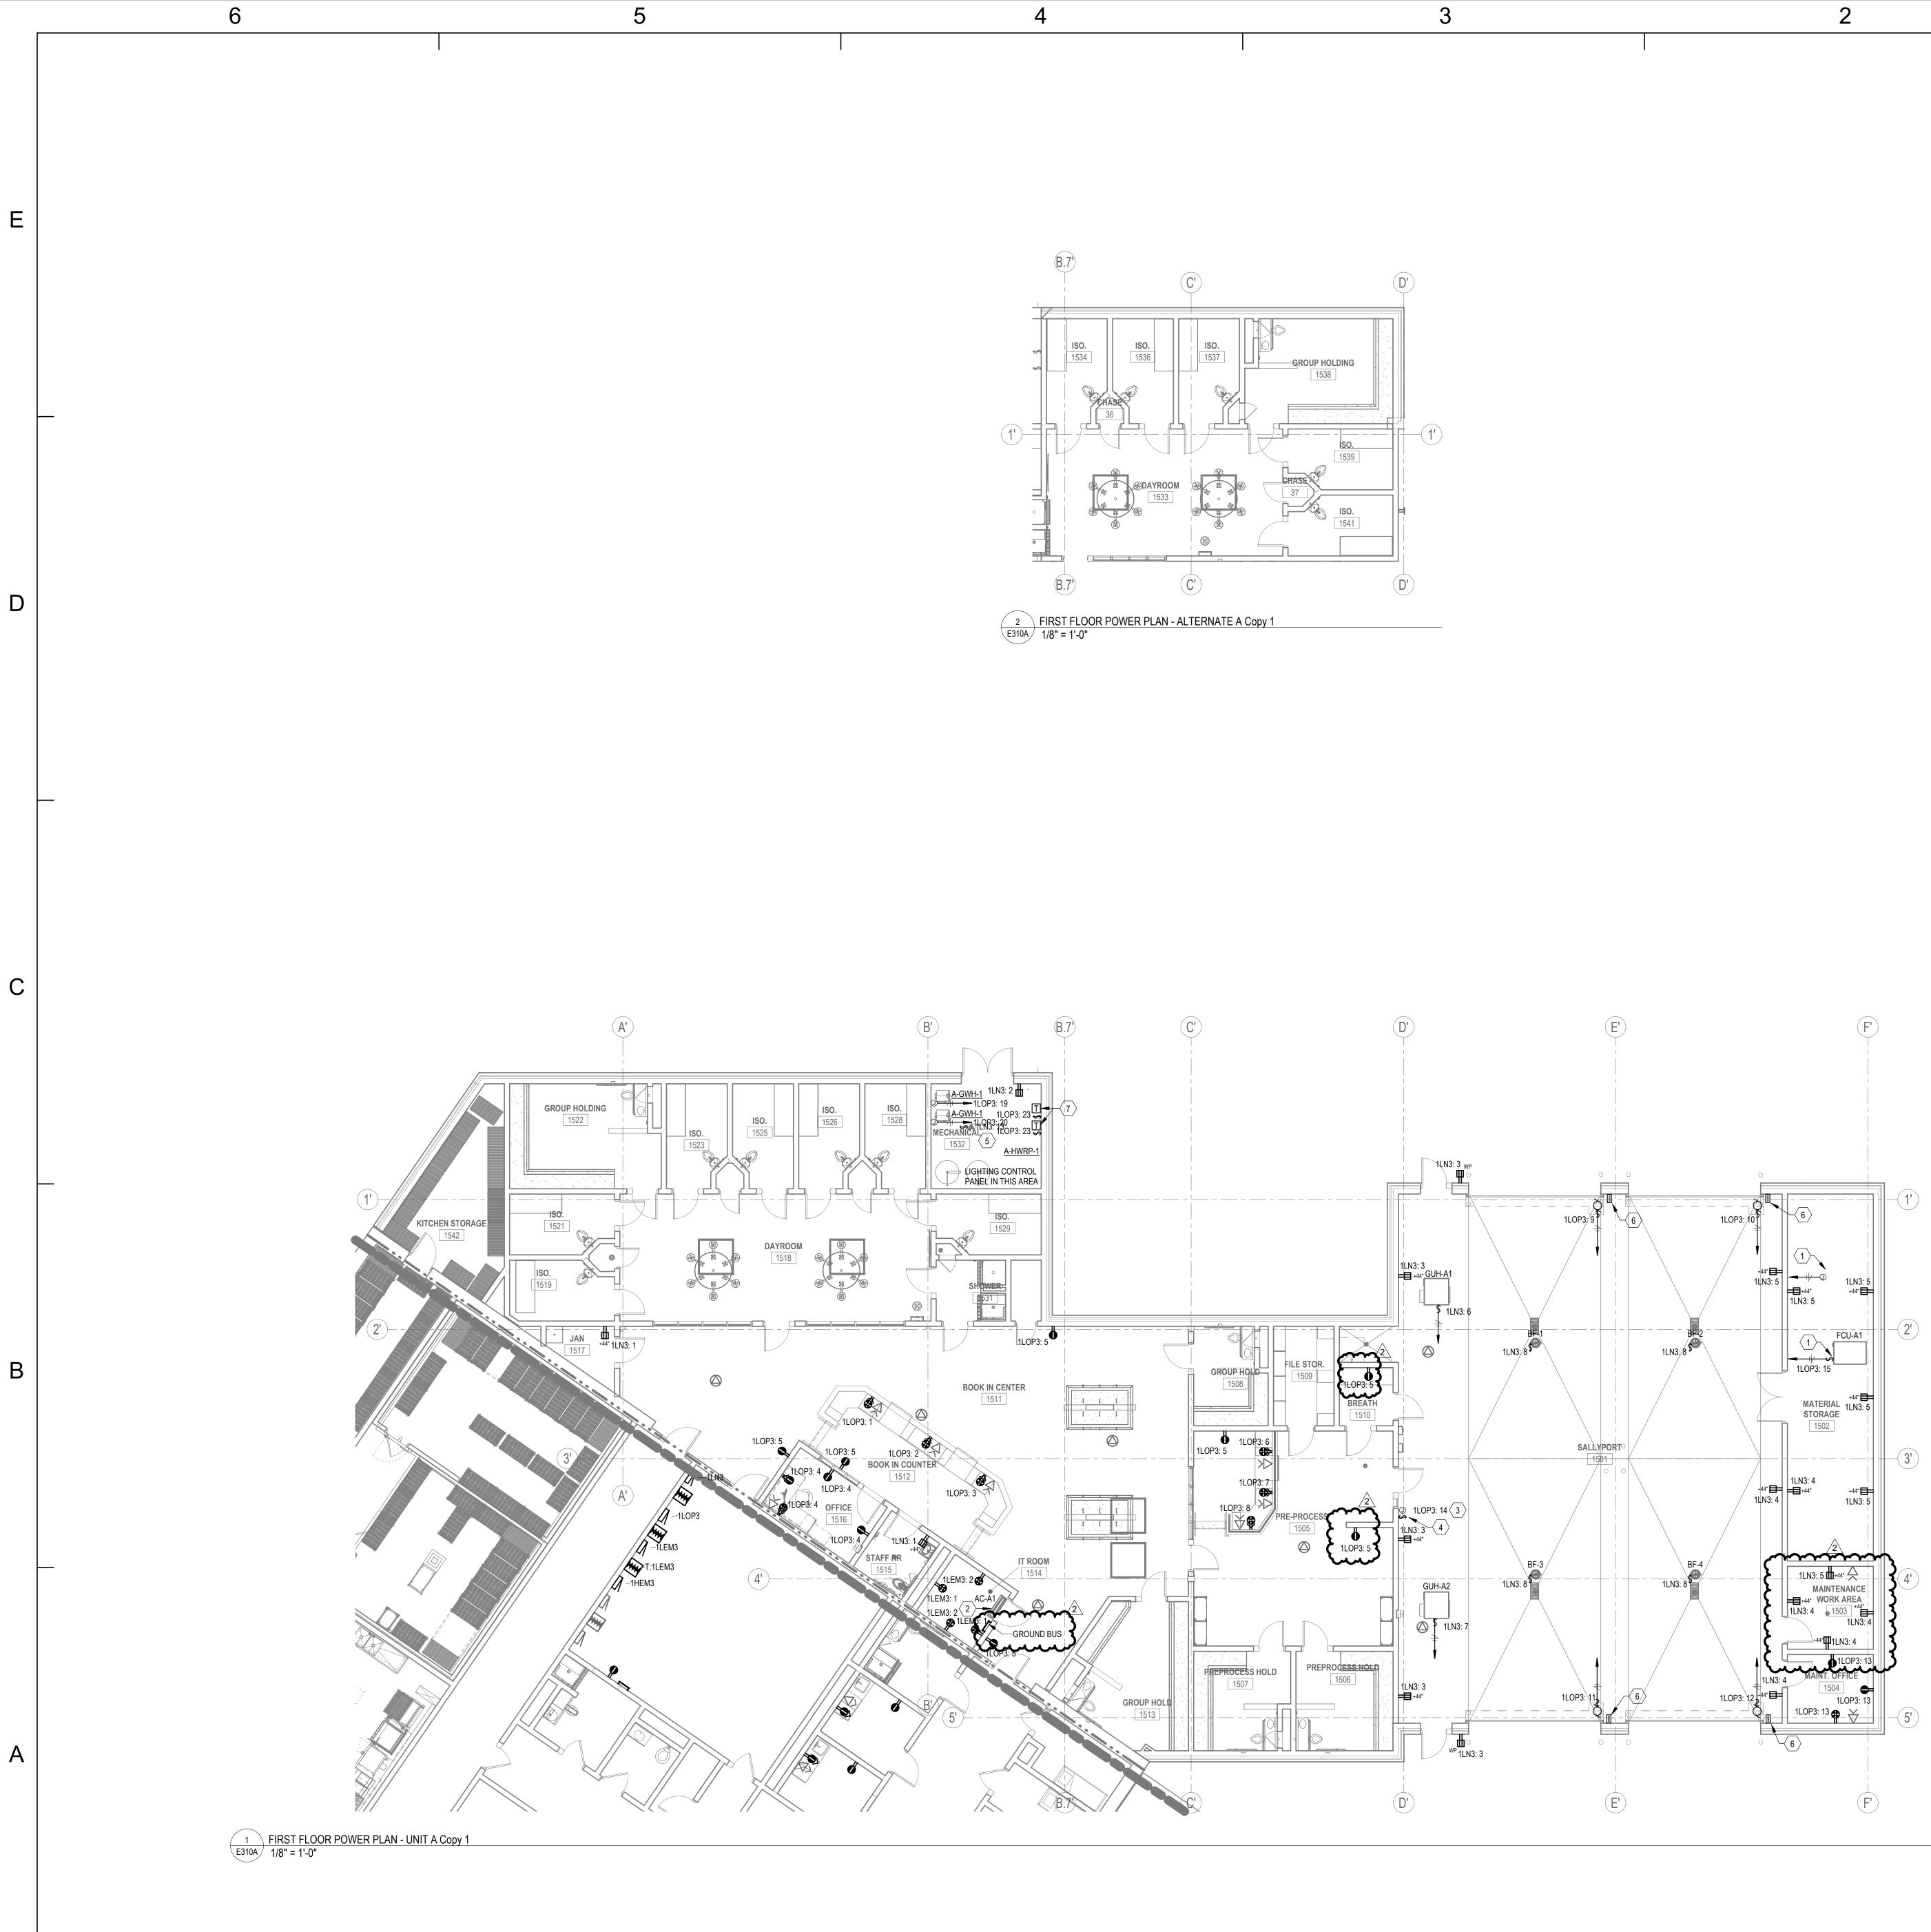





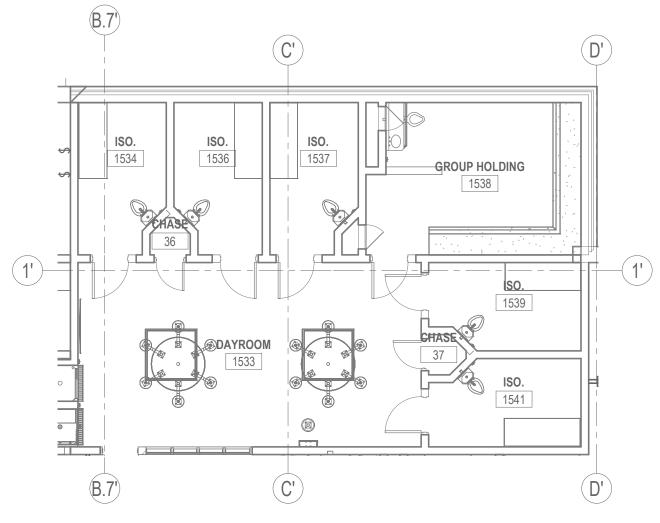



3

GENERAL NOTES - POWER:

1

2

3

7

INSTALLATION.

FANS BF-1 THRU BF-4.

SWITCH TO EQUIPMENT.

PRIOR TO INSTALLATION.

SWITCH.

- A. REFER TO SHEET E-001 FOR ELECTRICAL SYMBOLS AND ADDITIONAL GENERAL NOTES. B. REFER TO MECHANICAL AND PLUMBING SERIES DRAWINGS FOR ADDITIONAL SCOPE OF
- C. REFER TO SPECIFICATION SECTION 260519 FOR MINIMUM CONDUCTOR SIZE REQUIRED
- WORK.
- BASED ON THE TOTAL CIRCUIT DISTANCE.

- RECEPTACLES MAY NOT BE IDENTIFIED AS GFCI ON PLAN, BUT SHALL BE PROVIDED ACCORDING TO REQUIREMENT.

- D. ALL RECEPTACLES LOCATED WITHIN 6 FEET OF A SINK SHALL BE GFCI TYPE. ALL

- E. ALL SPECIAL TYPE RECEPTACLES SHALL BE NEMA 6-20R UNLESS NOTED OTHERWISE AND SHALL BE CIRCUITED WITH (2)#10 + (1)#10 NEUTRAL + (1)#10 GROUND. COORDINATE REQUIREMENTS WITH OWNER SUPPLIED EQUIPMENT PRIOR TO INSTALLATION.
- F. REFER TO ARCHITECTURAL SCHEDULES, DETAILS, AND ELEVATIONS FOR ADDITIONAL INFORMATION ON DEVICE LOCATIONS PRIOR TO ROUGH-IN.

- H. CIRCUIT NUMBERS AT DEVICES CORRESPOND TO PANELBOARD BREAKERS, REFER TO

PLAN NOTES

NOTE

DISCONNECT PROVIDED BY EQUIPMENT MANUFACTURER. COORDINATE EXACT

LOCATION AND REQUIREMENTS WITH EQUIPMENT MANUFACTURER PRIOR TO

EC SHALL PROVIDE DISCONNECT AND ALL ELECTRICAL INTERCONNECTIONS

BETWEEN INDOOR UNIT AND ASSOCIATED OUTDOOR UNIT AS REQUIRED.

4 PROVIDE ALL NECESSARY WIRING TO PROVIDE CONTROL SWITCH FOR BUCKET

5 PROVIDE DISCONNECT SWITCH NEAR EQUIPMENT, AND POWER WIRING FROM

6 MOTORIZED DOOR CONTROLS. PROVIDE ALL POWER AND CONTROL WIRING

DEVICES FOR THE OVERHEAD DOOR SYSTEM. COORDINATE EXACT

AND CONDUIT AS REQUIRED. CONNECT COMPLETE ALL ASSOCIATED

LOCATION AND REQUIREMENTS WITH OVERHEAD DOOR MANUFACTURER


COORDINATE FINAL LOCATION AND QUANTITY OF VAV CONTROL POWER TRANSFORMERS WITH MECHANICAL CONTRACTOR. PROVIDE LINE DISCONNECT


1

PROVIDE POWER TO CO MONITORING PANEL. COORDINATE FINAL LOCATION WITH

- G. UNLESS NOTED OTHERWISE, ALL NEW DEVICES SHALL BE INSTALLED FLUSH IN WALL.

- PANELBOARD SCHEDULES FOR ADDITIONAL INFORMATION.

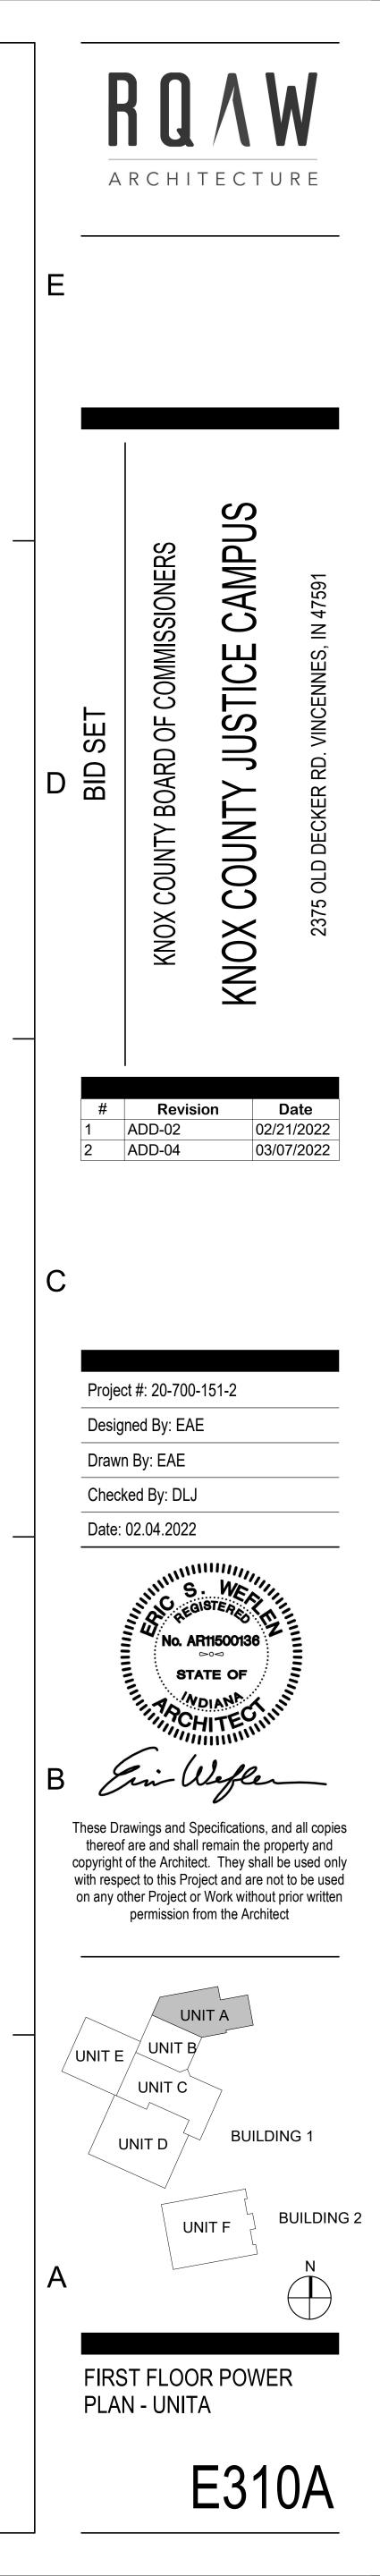


 

(K') ----T:1LN3 DRESS 1LOP3 FREEZER T:1LOP3 PROPERTY 1LEM3 1LEM3: 4 STORAGE EXAM 1125 T:1LEM3 I FM3 4 1HEM3 **N I 1B** Y STORAGE **++++** T:2 EXAM N20D ____EQUIPMENT GROUND BUS H1B 1LEM3: 7 1LEM3: 6 **COOLER** STAFF RR 1LN3: 15 1124 **ر آل**+ _EM3: { RR (**J'**) mann NURSE OFFICE 1120 SALLY PORT 1314 100 VID COURT 2 PADDED 1118 1122 1LEM3: 5 KITCHEN SECURE OFFICE 1LEM3: 5CORRIDOF 1309 mmm 1315 RR \bigcirc VID COURT 1/OFFICE PADDED 1111 RR 1112 WAITING 1110 HEM. STR. $^{ imes}$ ____ -(K') (R') (H.1) $(\mathbf{Q'})$ (L')

4

3

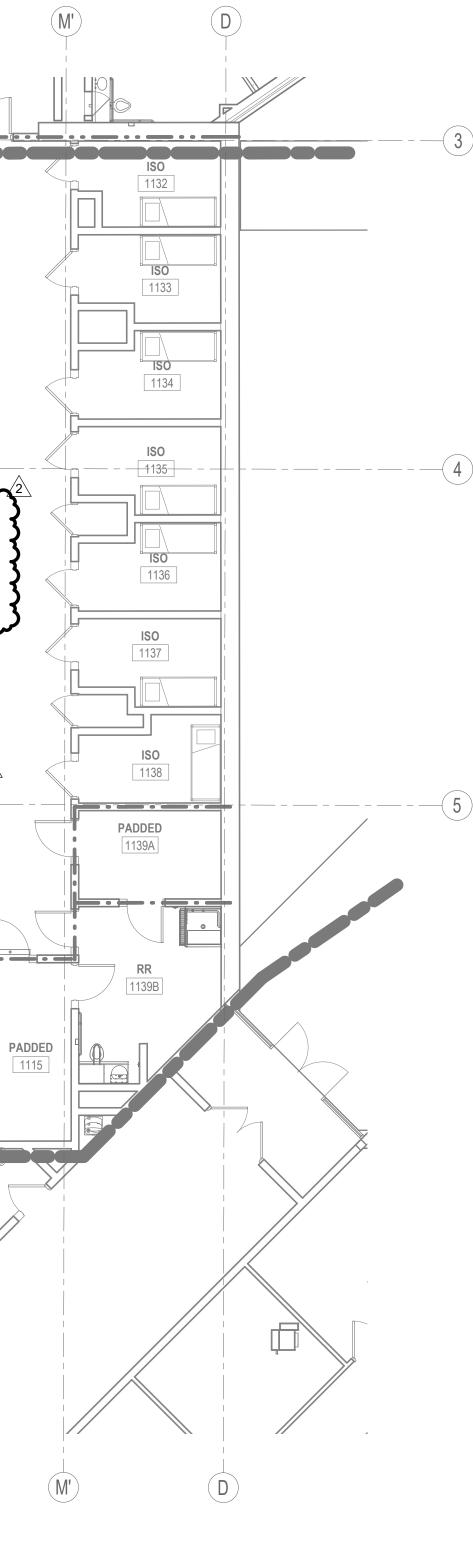

1) FIRST FLOOR POWER PLAN - UNIT B

0 4' 8'

2

GENERAL NOTES - POWER:

#

BASED ON THE TOTAL CIRCUIT DISTANCE.

ACCORDING TO REQUIREMENT.

REQUIREMENTS.

- WORK.
- B. REFER TO MECHANICAL AND PLUMBING SERIES DRAWINGS FOR ADDITIONAL SCOPE OF

E. ALL SPECIAL TYPE RECEPTACLES SHALL BE NEMA 6-20R UNLESS NOTED OTHERWISE AND SHALL BE CIRCUITED WITH (2)#10 + (1)#10 NEUTRAL + (1)#10 GROUND. COORDINATE REQUIREMENTS WITH OWNER SUPPLIED EQUIPMENT PRIOR TO INSTALLATION.

F. REFER TO ARCHITECTURAL SCHEDULES, DETAILS, AND ELEVATIONS FOR ADDITIONAL

G. UNLESS NOTED OTHERWISE, ALL NEW DEVICES SHALL BE INSTALLED FLUSH IN WALL.

H. CIRCUIT NUMBERS AT DEVICES CORRESPOND TO PANELBOARD BREAKERS, REFER TO

PLAN NOTES

1 EXISTING DISTRIBUTION RACEWAY SYSTEM TO BE MODIFIED TO ACCOMIDATE

NOTE

1

RELOCATED EQUIPMENT. REFER TO FOOD SERVICE DRAWINGS FOR ADDITIONAL

INFORMATION ON DEVICE LOCATIONS PRIOR TO ROUGH-IN.


PANELBOARD SCHEDULES FOR ADDITIONAL INFORMATION.


D. ALL RECEPTACLES LOCATED WITHIN 6 FEET OF A SINK SHALL BE GFCI TYPE. ALL RECEPTACLES MAY NOT BE IDENTIFIED AS GFCI ON PLAN, BUT SHALL BE PROVIDED

- C. REFER TO SPECIFICATION SECTION 260519 FOR MINIMUM CONDUCTOR SIZE REQUIRED

- A. REFER TO SHEET E-001 FOR ELECTRICAL SYMBOLS AND ADDITIONAL GENERAL NOTES.

^

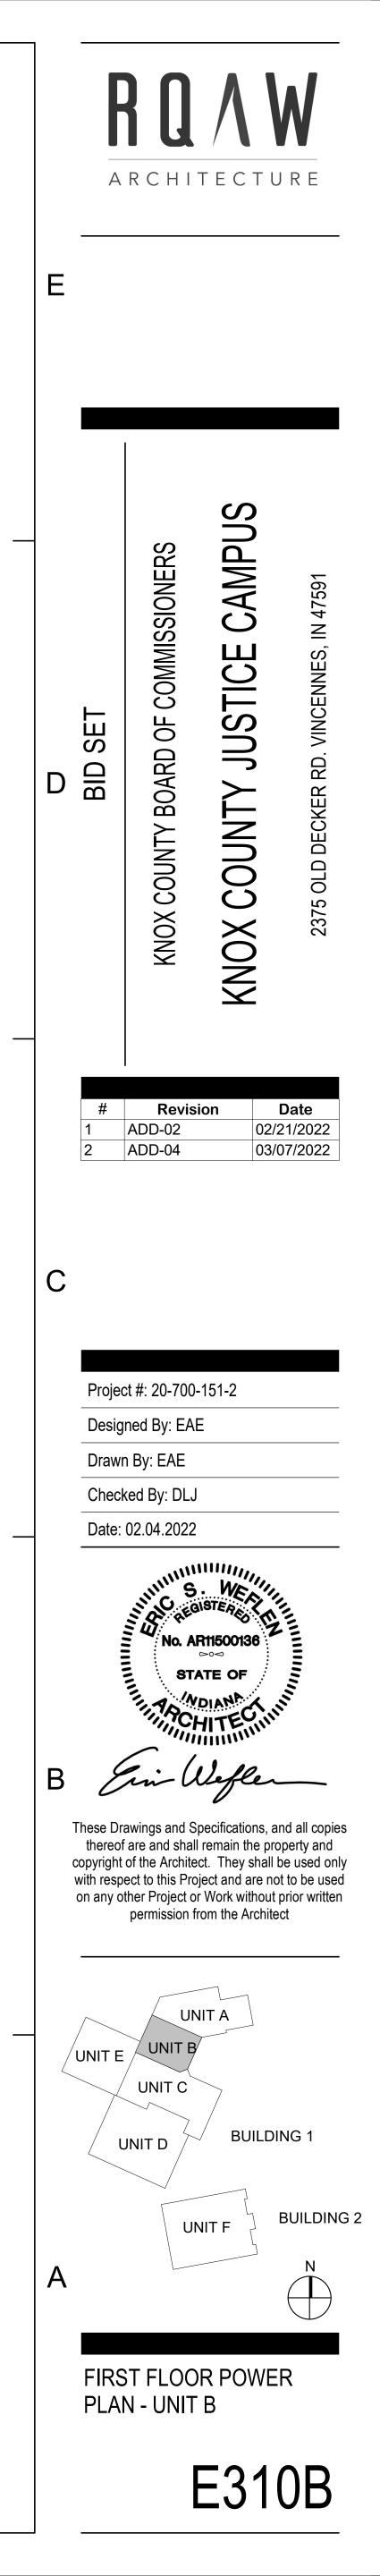

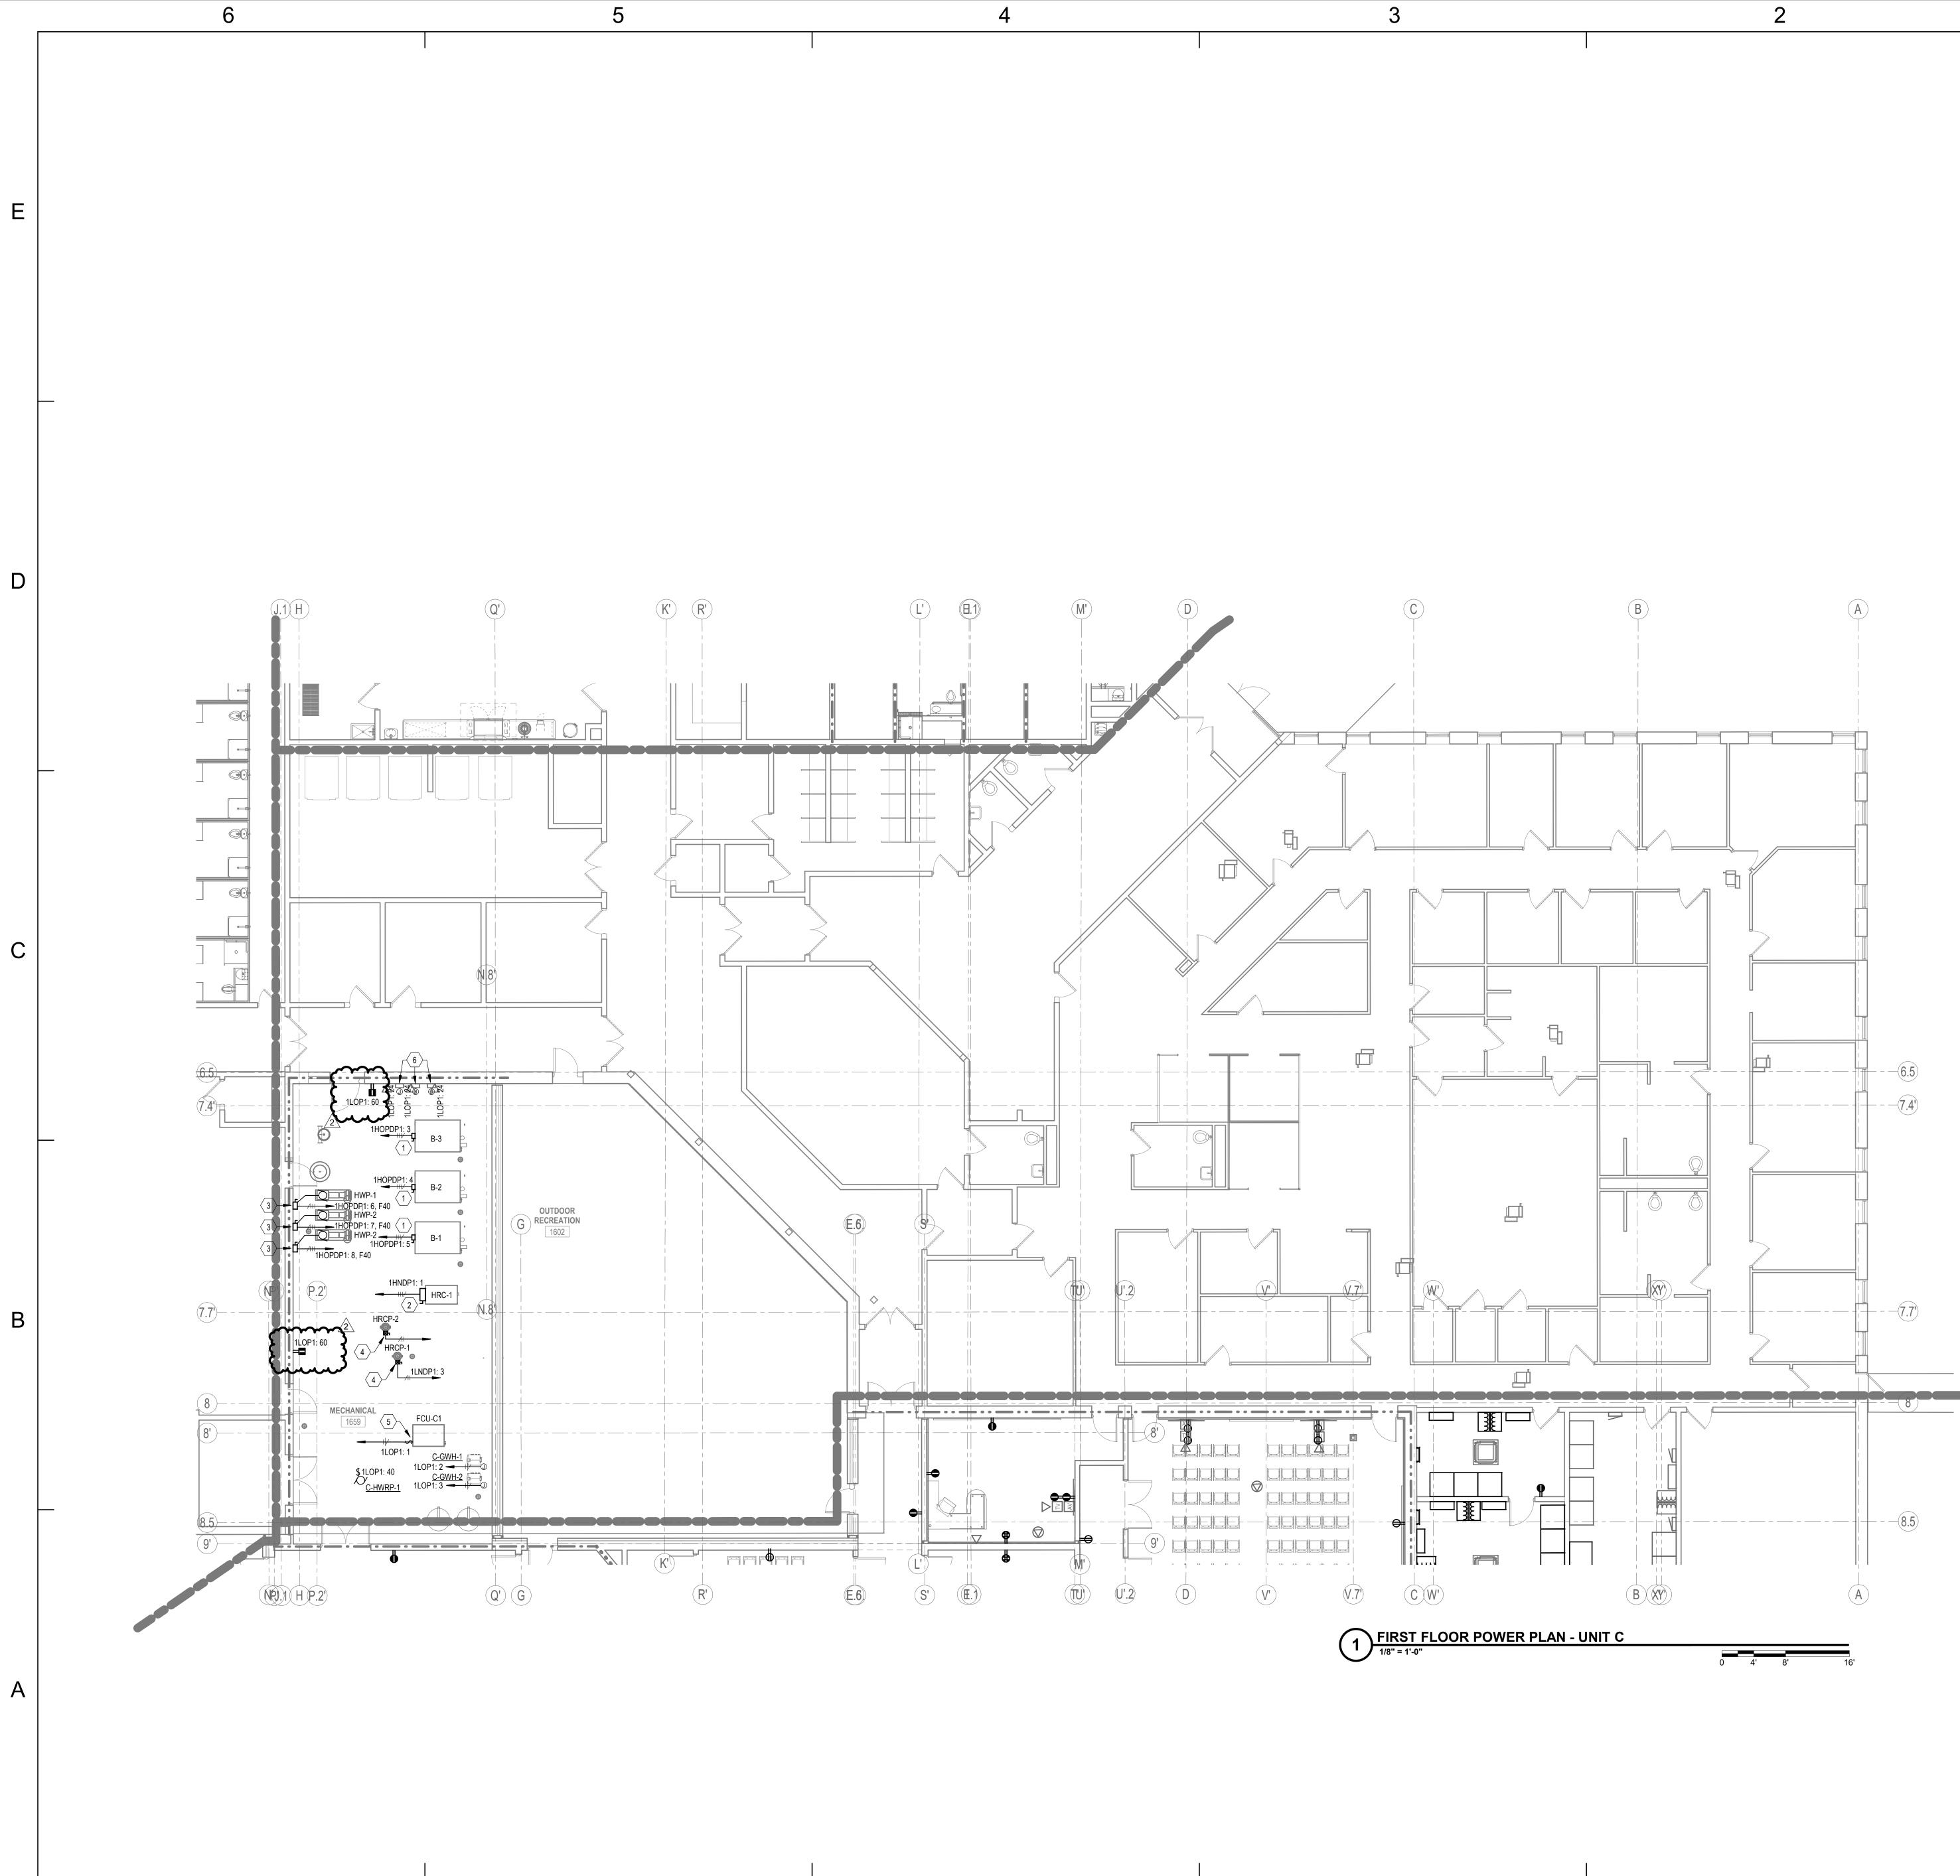

6


5

3

GENERAL NOTES - POWER:

- A. REFER TO SHEET E-001 FOR ELECTRICAL SYMBOLS AND ADDITIONAL GENERAL NOTES. B. REFER TO MECHANICAL AND PLUMBING SERIES DRAWINGS FOR ADDITIONAL SCOPE OF
- WORK. C. REFER TO SPECIFICATION SECTION 260519 FOR MINIMUM CONDUCTOR SIZE REQUIRED
- BASED ON THE TOTAL CIRCUIT DISTANCE.
- D. ALL RECEPTACLES LOCATED WITHIN 6 FEET OF A SINK SHALL BE GFCI TYPE. ALL RECEPTACLES MAY NOT BE IDENTIFIED AS GFCI ON PLAN, BUT SHALL BE PROVIDED ACCORDING TO REQUIREMENT.
- E. ALL SPECIAL TYPE RECEPTACLES SHALL BE NEMA 6-20R UNLESS NOTED OTHERWISE AND SHALL BE CIRCUITED WITH (2)#10 + (1)#10 NEUTRAL + (1)#10 GROUND. COORDINATE REQUIREMENTS WITH OWNER SUPPLIED EQUIPMENT PRIOR TO INSTALLATION.
- F. REFER TO ARCHITECTURAL SCHEDULES, DETAILS, AND ELEVATIONS FOR ADDITIONAL INFORMATION ON DEVICE LOCATIONS PRIOR TO ROUGH-IN.
- G. UNLESS NOTED OTHERWISE, ALL NEW DEVICES SHALL BE INSTALLED FLUSH IN WALL.
- H. CIRCUIT NUMBERS AT DEVICES CORRESPOND TO PANELBOARD BREAKERS, REFER TO PANELBOARD SCHEDULES FOR ADDITIONAL INFORMATION.


	PLAN NOTES
#	NOTE
1	DISCONNECT PROVIDED BY EQUIPMENT MANUFACTURER. COORDINATE EXACT LOCATION AND REQUIREMENTS WITH EQUIPMENT MANUFACTURER PRIOR TO INSTALLATION.
2	CONNECT COMPLETE VIA CIRCUIT INDICATED. CONNECTION POINT / DISCONNEC PROVIDED BY EQUIPMENT MANUFACTURER. COORDINATE EXACT LOCATION AND REQUIREMENTS WITH EQUIPMENT MANUFACTURER PRIOR TO INSTALLATION. PROVIDE ALL INTERNAL INTERCONNECTIONS AS REQUIRED.
3	PROVIDE 480V, 3PH, 60A DISCONNECT AND CONNECT COMPLETE VIA VARIABLE FREQUENCY CONTROLLER. VFC PROVIDED BY ECC, COORDINATE EXACT LOCATION PRIOR TO INSTALLATION.
4	PROVIDE COMBINATION STARTER / DISCONNECT, NEMA SIZE 00. FUSED AS PER MANUFACTURER'S RECOMMENDATIONS. CONNECT COMPLETE VIA CIRCUIT INDICATED. COORDINATE EXACT LOCATION PRIOR TO INSTALLATION.
5	DISCONNECT PROVIDED BY EQUIPMENT MANUFACTURER. COORDINATE EXACT LOCATION AND REQUIREMENTS WITH EQUIPMENT MANUFACTURER PRIOR TO INSTALLATION.
6	DDC PANELS FOR MECHANICAL EQUIPMENT CONTROLS. EXACT LOCATIONS SHA BE VERIFIED AND COORDINATED WITH TEMPERATURE CONTROLS CONTRACTOR PRIOR TO INSTALLATION.

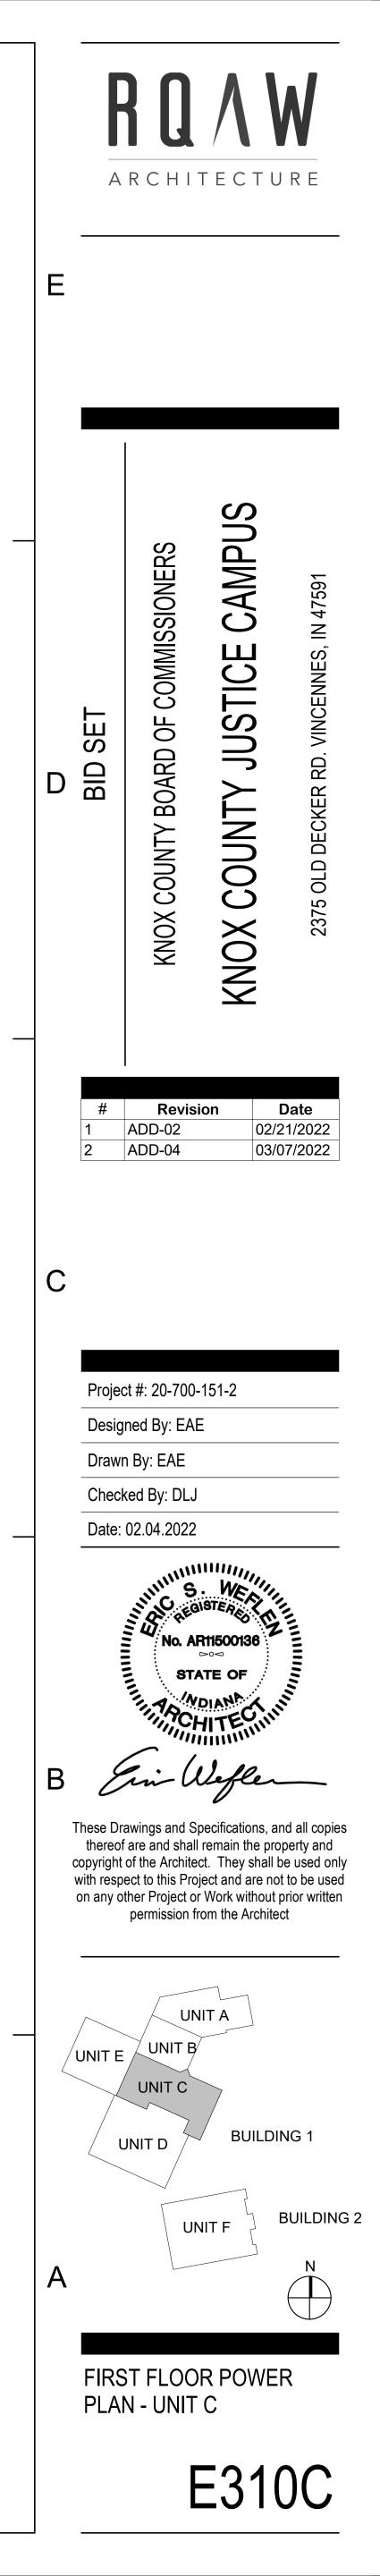







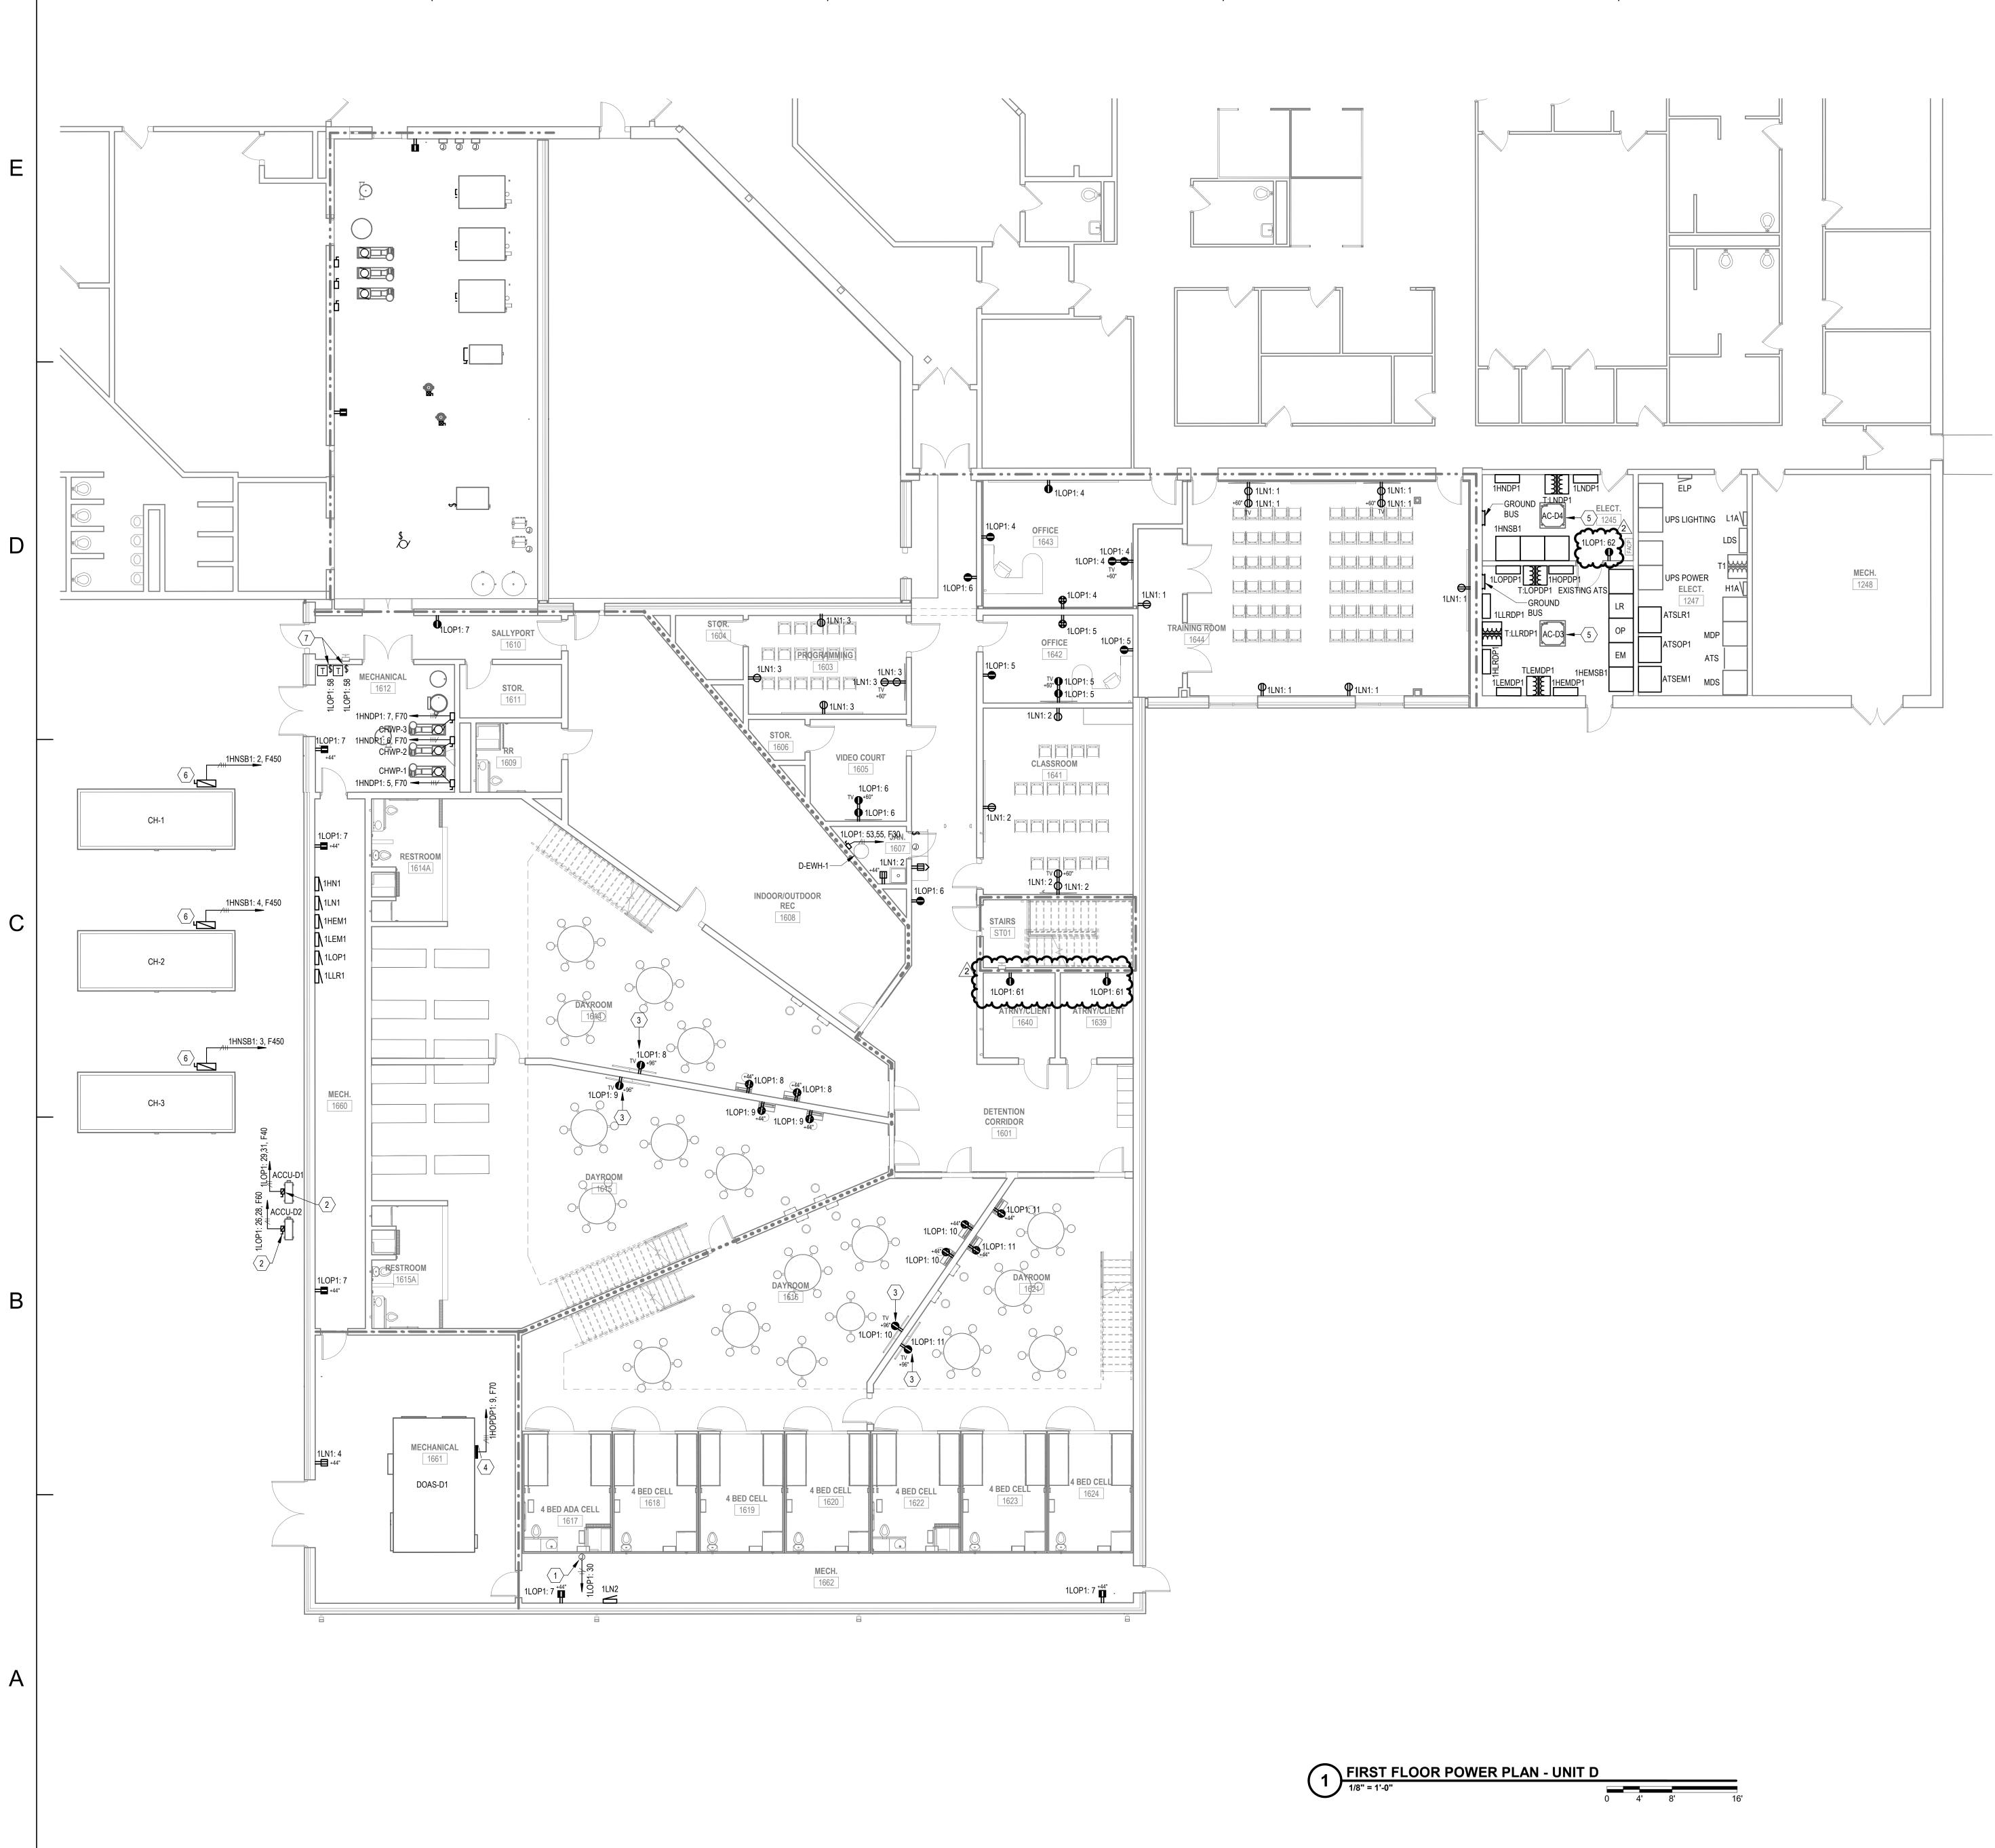

3




3




GENERAL NOTES - POWER:

- A. REFER TO SHEET E-001 FOR ELECTRICAL SYMBOLS AND ADDITIONAL GENERAL NOTES.
- B. REFER TO MECHANICAL AND PLUMBING SERIES DRAWINGS FOR ADDITIONAL SCOPE OF WORK.
- C. REFER TO SPECIFICATION SECTION 260519 FOR MINIMUM CONDUCTOR SIZE REQUIRED BASED ON THE TOTAL CIRCUIT DISTANCE. D. ALL RECEPTACLES LOCATED WITHIN 6 FEET OF A SINK SHALL BE GFCI TYPE. ALL
- RECEPTACLES MAY NOT BE IDENTIFIED AS GFCI ON PLAN, BUT SHALL BE PROVIDED ACCORDING TO REQUIREMENT.
- E. ALL SPECIAL TYPE RECEPTACLES SHALL BE NEMA 6-20R UNLESS NOTED OTHERWISE AND SHALL BE CIRCUITED WITH (2)#10 + (1)#10 NEUTRAL + (1)#10 GROUND. COORDINATE REQUIREMENTS WITH OWNER SUPPLIED EQUIPMENT PRIOR TO INSTALLATION.
- F. REFER TO ARCHITECTURAL SCHEDULES, DETAILS, AND ELEVATIONS FOR ADDITIONAL INFORMATION ON DEVICE LOCATIONS PRIOR TO ROUGH-IN.
- G. UNLESS NOTED OTHERWISE, ALL NEW DEVICES SHALL BE INSTALLED FLUSH IN WALL.
- H. CIRCUIT NUMBERS AT DEVICES CORRESPOND TO PANELBOARD BREAKERS, REFER TO PANELBOARD SCHEDULES FOR ADDITIONAL INFORMATION.

	PLAN NOTES
#	NOTE
1	CONNECT COMPLETE TO JUNCTION BOX ON BACK OF CELL FOR RECEPTACLE PROVIDED INTEGRAL TO ADA CELL. RECEPTACLE CIRCUIT SHALL BE CONTROLLEE VIA SECURITY CONTROLS. REFER TO SECURITY DRAWINGS FOR ADDITIONAL INFORMATION AND PROVIDE CONNECTIONS ACCORDINGLY.
2	PROVIDE NEMA 3R 208V, 2P-60A FUSIBLE DISCONNECT. FUSE AS PER MANUFACTURER'S RECOMMENDATIONS. PROVIDE ADDITIONAL SUPPORT STRUCTURE AS REQUIRED.
3	TV RECEPTACLE SHALL BE CONTROLLED VIA SECURITY SYSTEM RELAY. REFER TO SECURITY SYSTEMS DRAWINGS FOR ADDITIONAL INFORMATION AND CONNECT ACCORDINGLY VIA CONTROLLED RELAY. REFER TO DETAIL ON E800-SERIES DRAWINGS FOR ADDITIONAL INFORMATION. COORDINATE EXACT MOUNTING PRIOR TO INSTALLATION.
4	CONNECT COMPLETE VIA CIRCUIT INDICATED. CONNECTION POINT / DISCONNECT PROVIDED BY EQUIPMENT MANUFACTURER. COORDINATE EXACT LOCATION AND REQUIREMENTS WITH EQUIPMENT MANUFACTURER PRIOR TO INSTALLATION. PROVIDE ALL INTERNAL INTERCONNECTIONS AS REQUIRED.
5	EC SHALL PROVIDE DISCONNECT AND ALL ELECTRICAL INTERCONNECTIONS BETWEEN INDOOR UNIT AND ASSOCIATED OUTDOOR UNIT AS REQUIRED.
6	PROVIDE NEMA 3R, 600V, 600A, 3 POLE FUSED HEAVY-DUTY DISCONNECT SWITCH PROVIDE FUSES NOT EXCEEDING NAMEPLATE MAX. FUSE / OVERCURRENT RATING.
7	COORDINATE FINAL LOCATION AND QUANTITY OF VAV CONTROL POWER TRANSFORMERS WITH MECHANICAL CONTRACTOR. PROVIDE LINE DISCONNECT SWITCH.

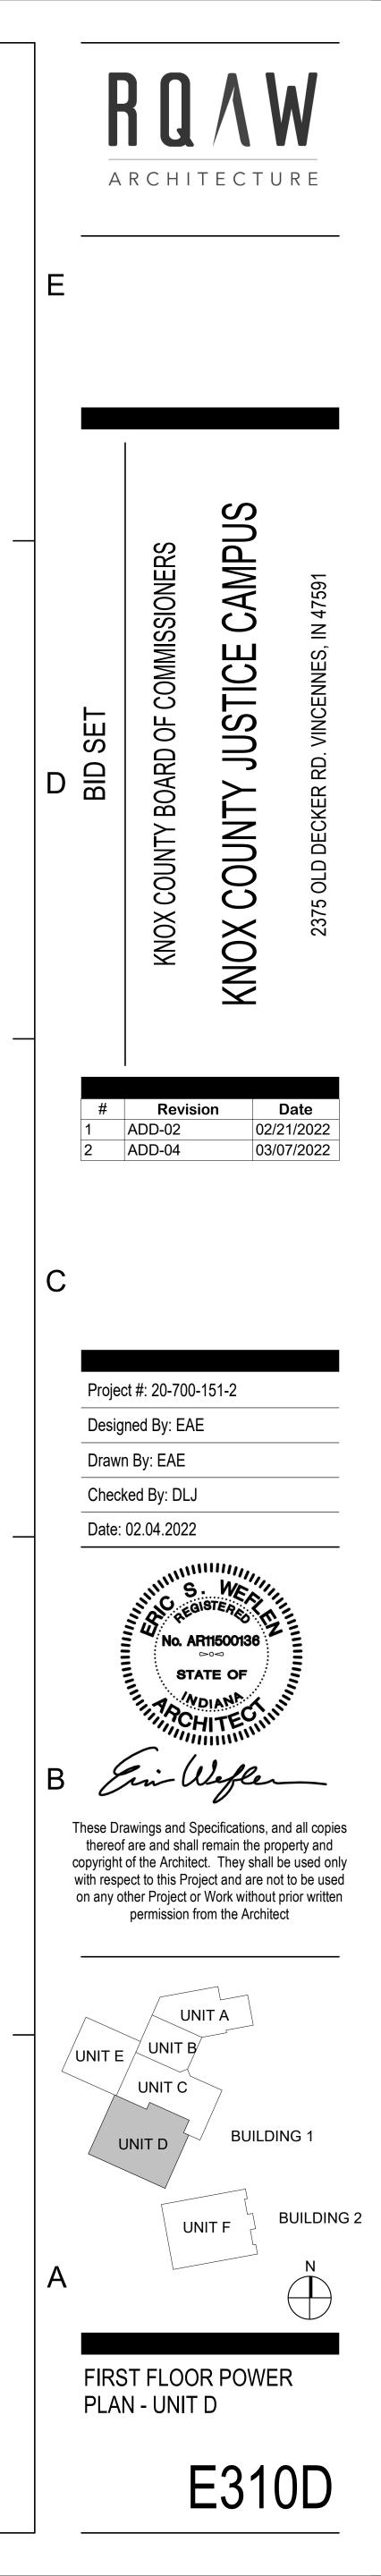

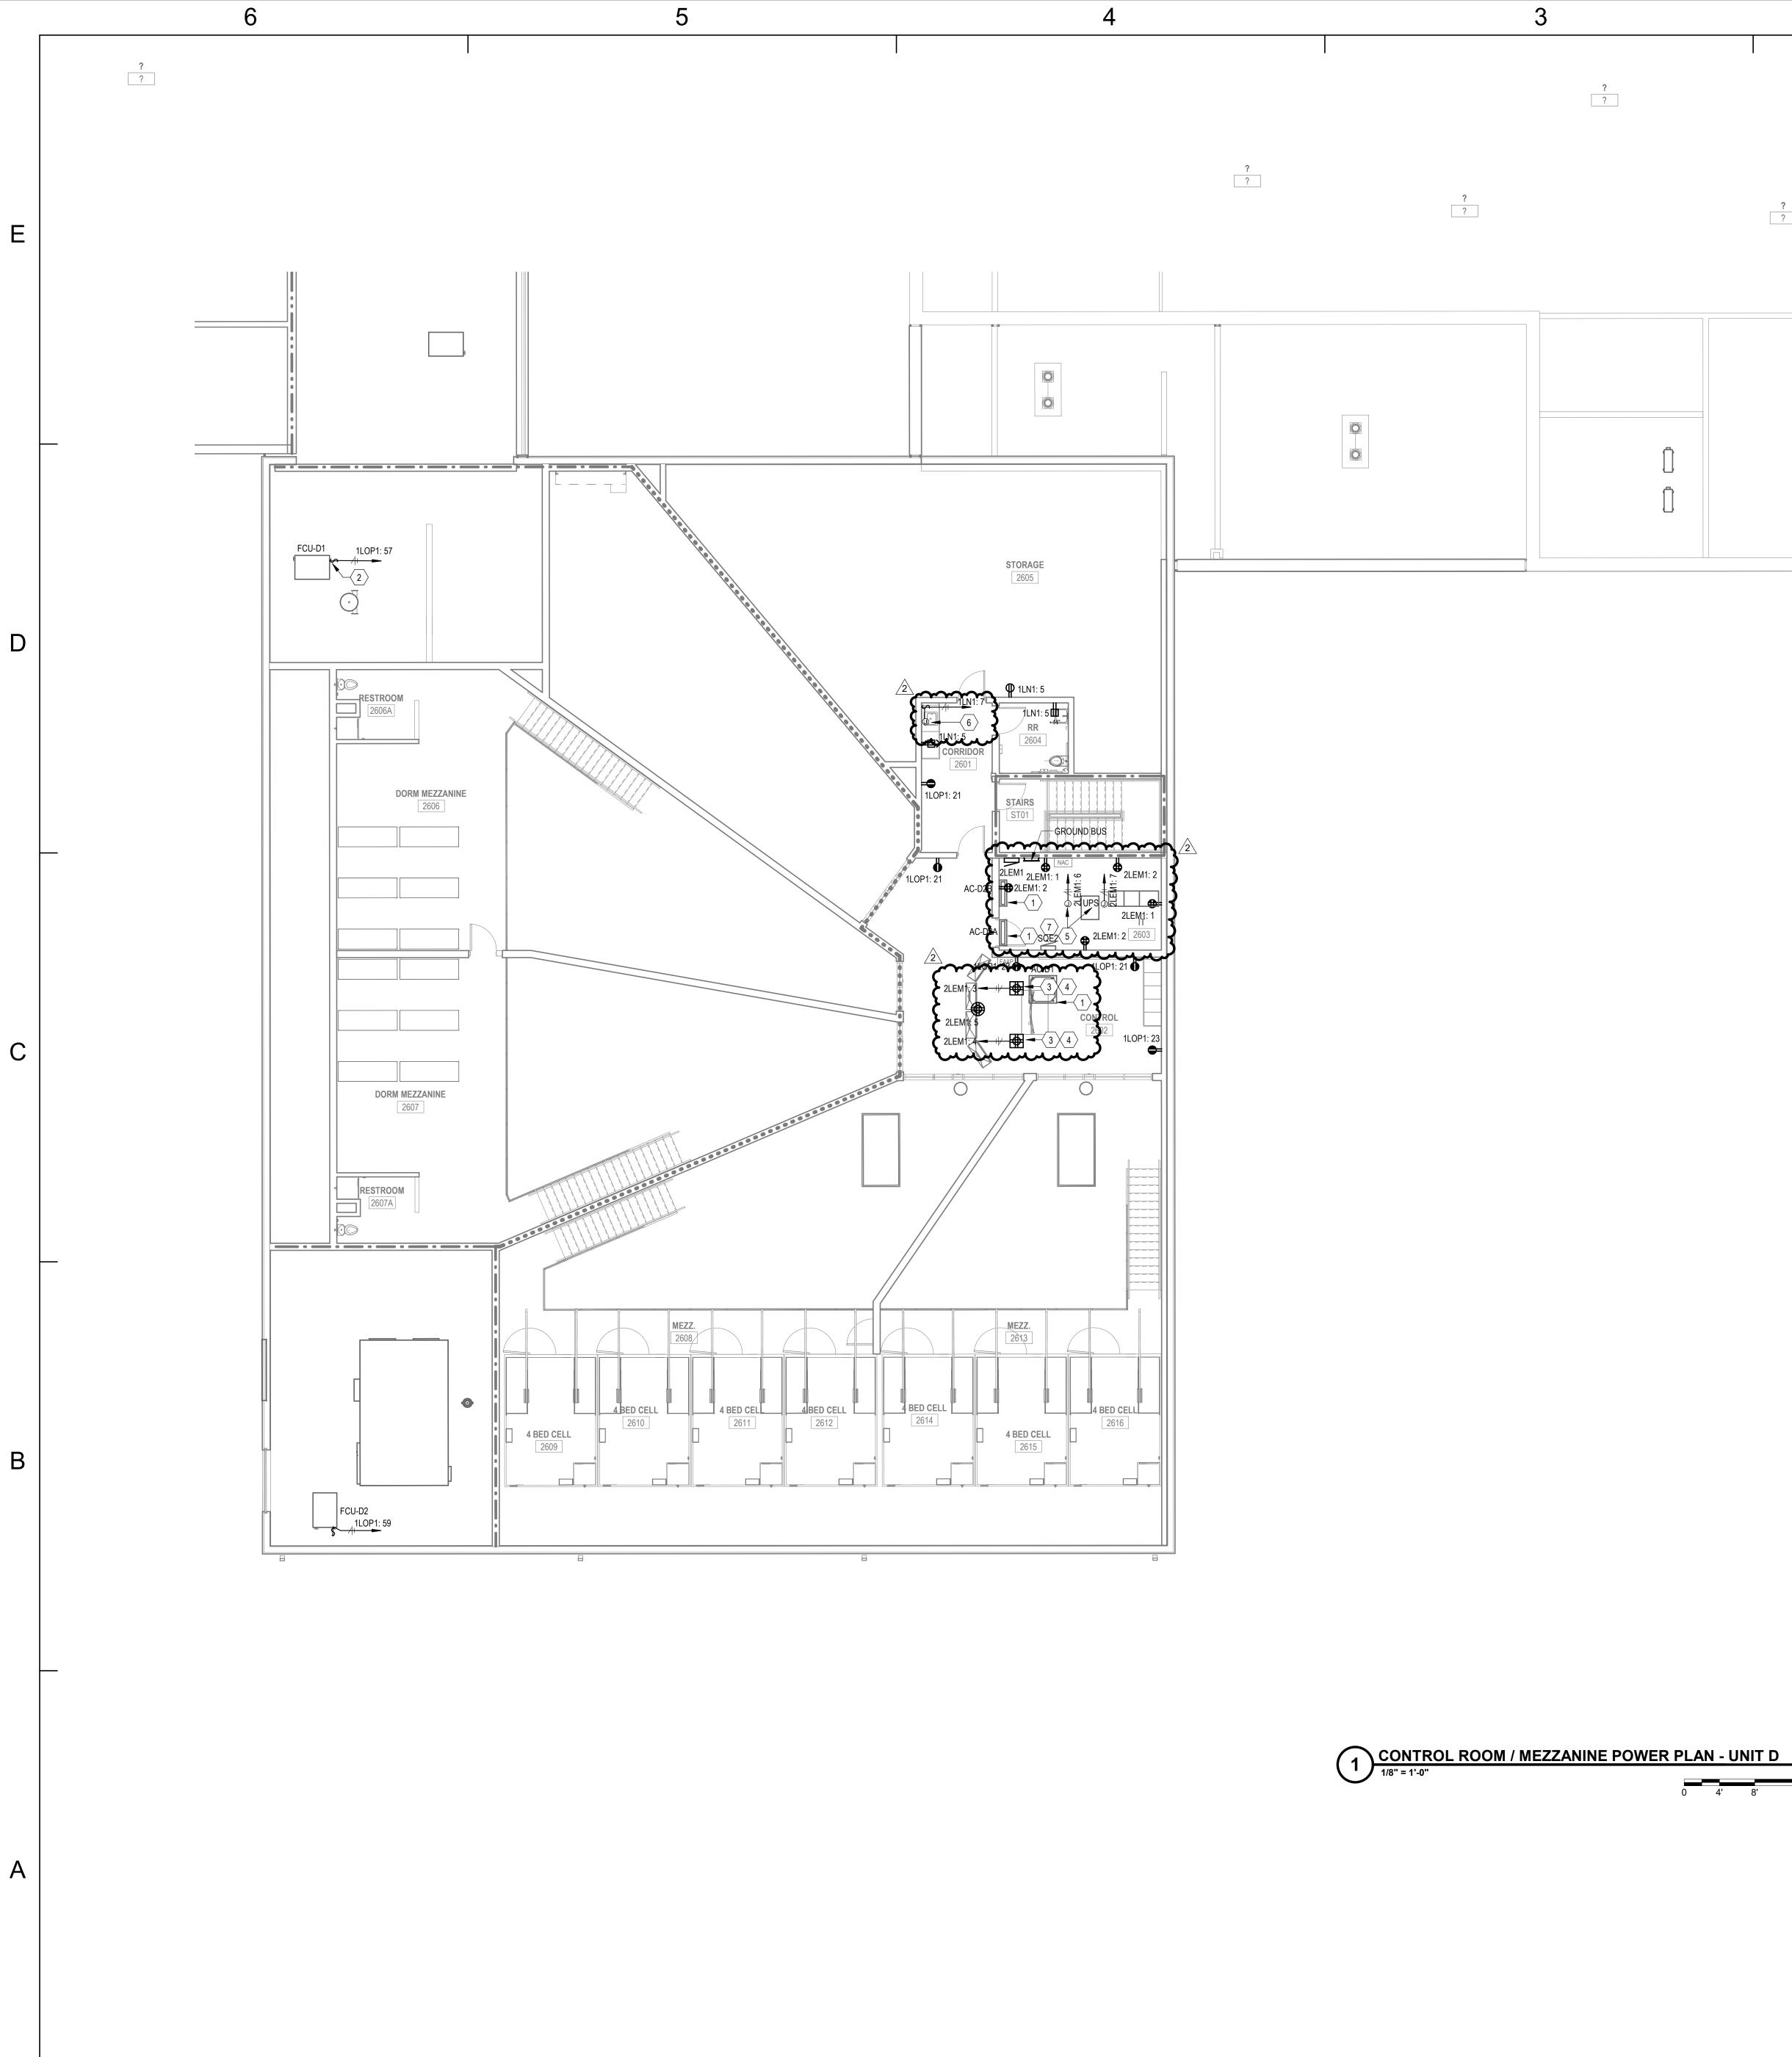



3



GENERAL NOTES - POWER:

- A. REFER TO SHEET E-001 FOR ELECTRICAL SYMBOLS AND ADDITIONAL GENERAL NOTES. B. REFER TO MECHANICAL AND PLUMBING SERIES DRAWINGS FOR ADDITIONAL SCOPE OF
- WORK. C. REFER TO SPECIFICATION SECTION 260519 FOR MINIMUM CONDUCTOR SIZE REQUIRED
- BASED ON THE TOTAL CIRCUIT DISTANCE. D. ALL RECEPTACLES LOCATED WITHIN 6 FEET OF A SINK SHALL BE GFCI TYPE. ALL RECEPTACLES MAY NOT BE IDENTIFIED AS GFCI ON PLAN, BUT SHALL BE PROVIDED ACCORDING TO REQUIREMENT.
- E. ALL SPECIAL TYPE RECEPTACLES SHALL BE NEMA 6-20R UNLESS NOTED OTHERWISE AND SHALL BE CIRCUITED WITH (2)#10 + (1)#10 NEUTRAL + (1)#10 GROUND. COORDINATE
- REQUIREMENTS WITH OWNER SUPPLIED EQUIPMENT PRIOR TO INSTALLATION. F. REFER TO ARCHITECTURAL SCHEDULES, DETAILS, AND ELEVATIONS FOR ADDITIONAL
- INFORMATION ON DEVICE LOCATIONS PRIOR TO ROUGH-IN.
- G. UNLESS NOTED OTHERWISE, ALL NEW DEVICES SHALL BE INSTALLED FLUSH IN WALL.
- H. CIRCUIT NUMBERS AT DEVICES CORRESPOND TO PANELBOARD BREAKERS, REFER TO PANELBOARD SCHEDULES FOR ADDITIONAL INFORMATION.

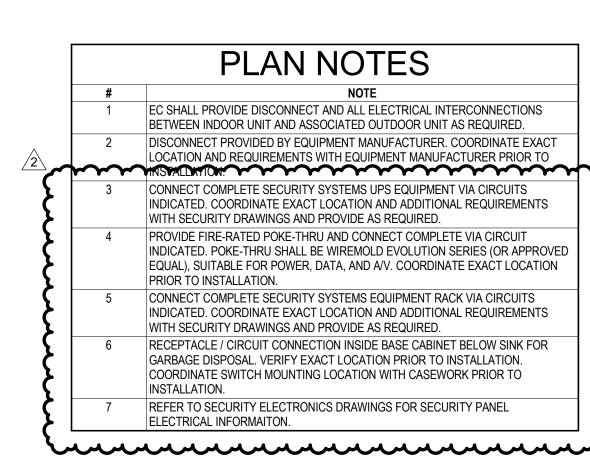


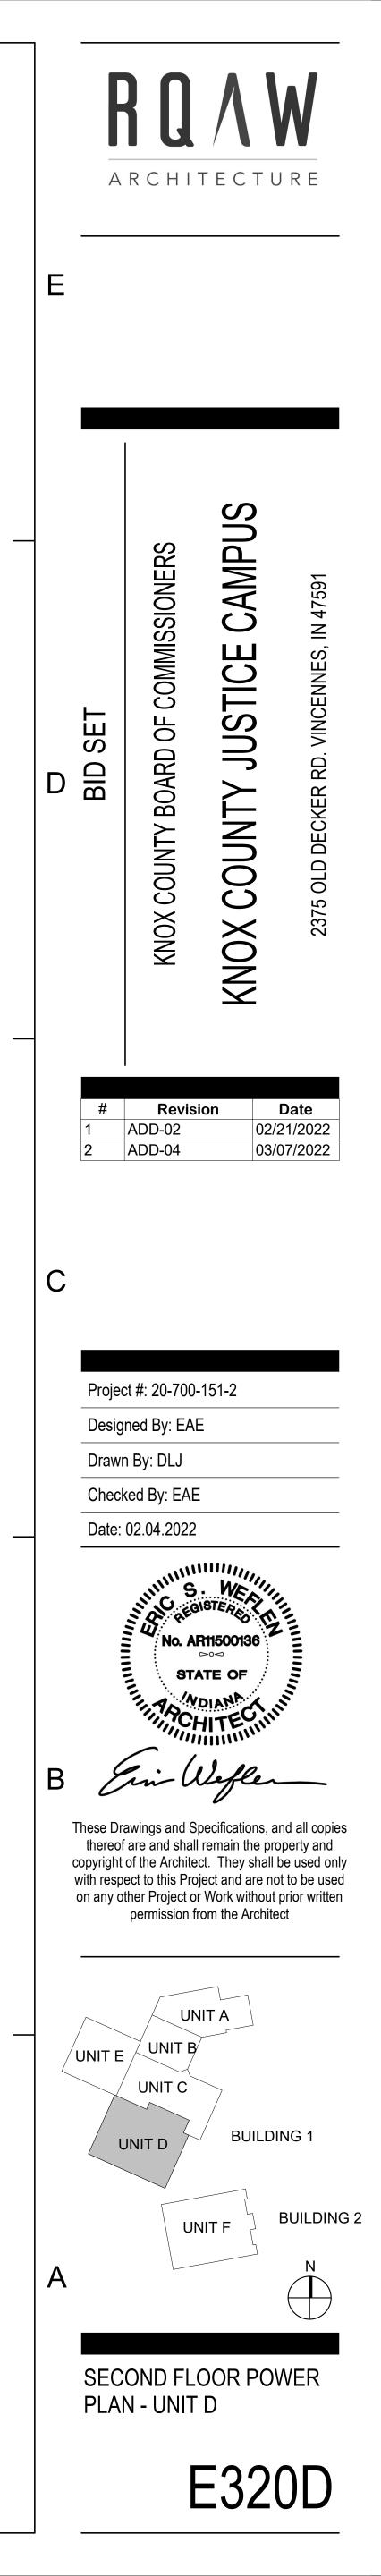









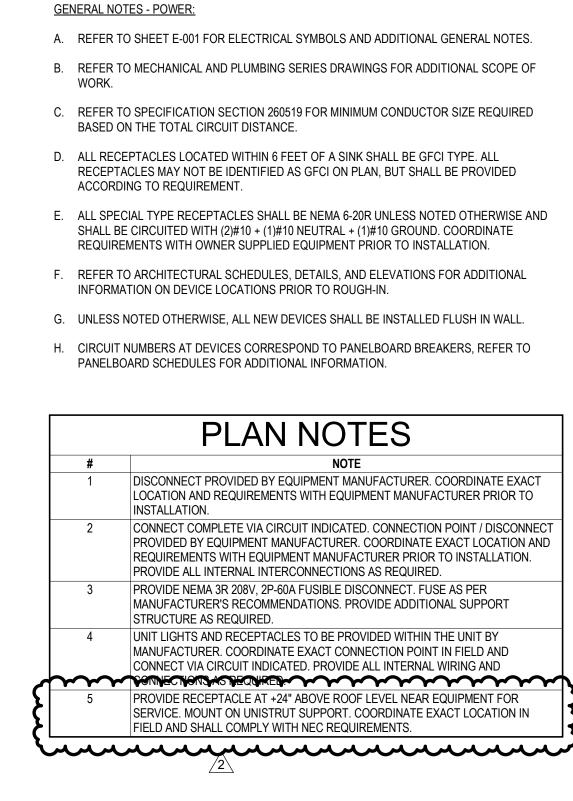

1 OVERALL ROOF ELECTRICAL PLAN 0 4' 8'

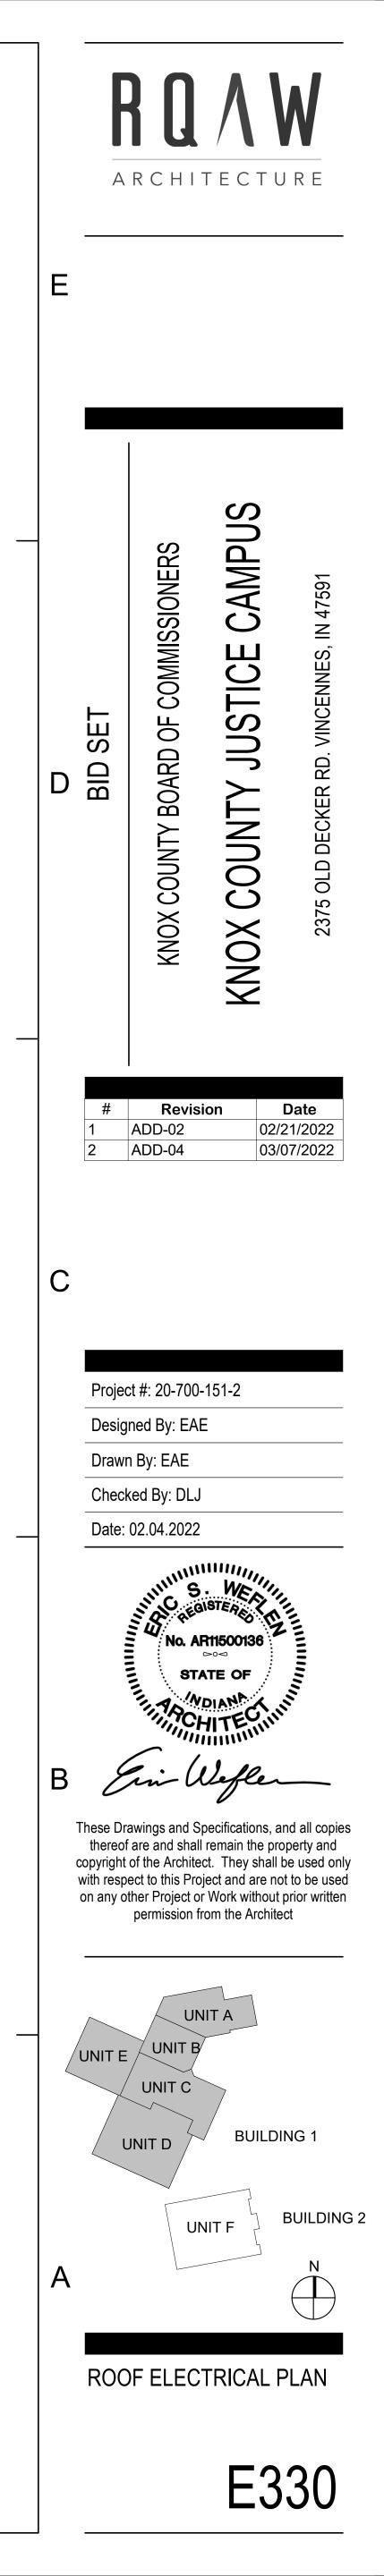

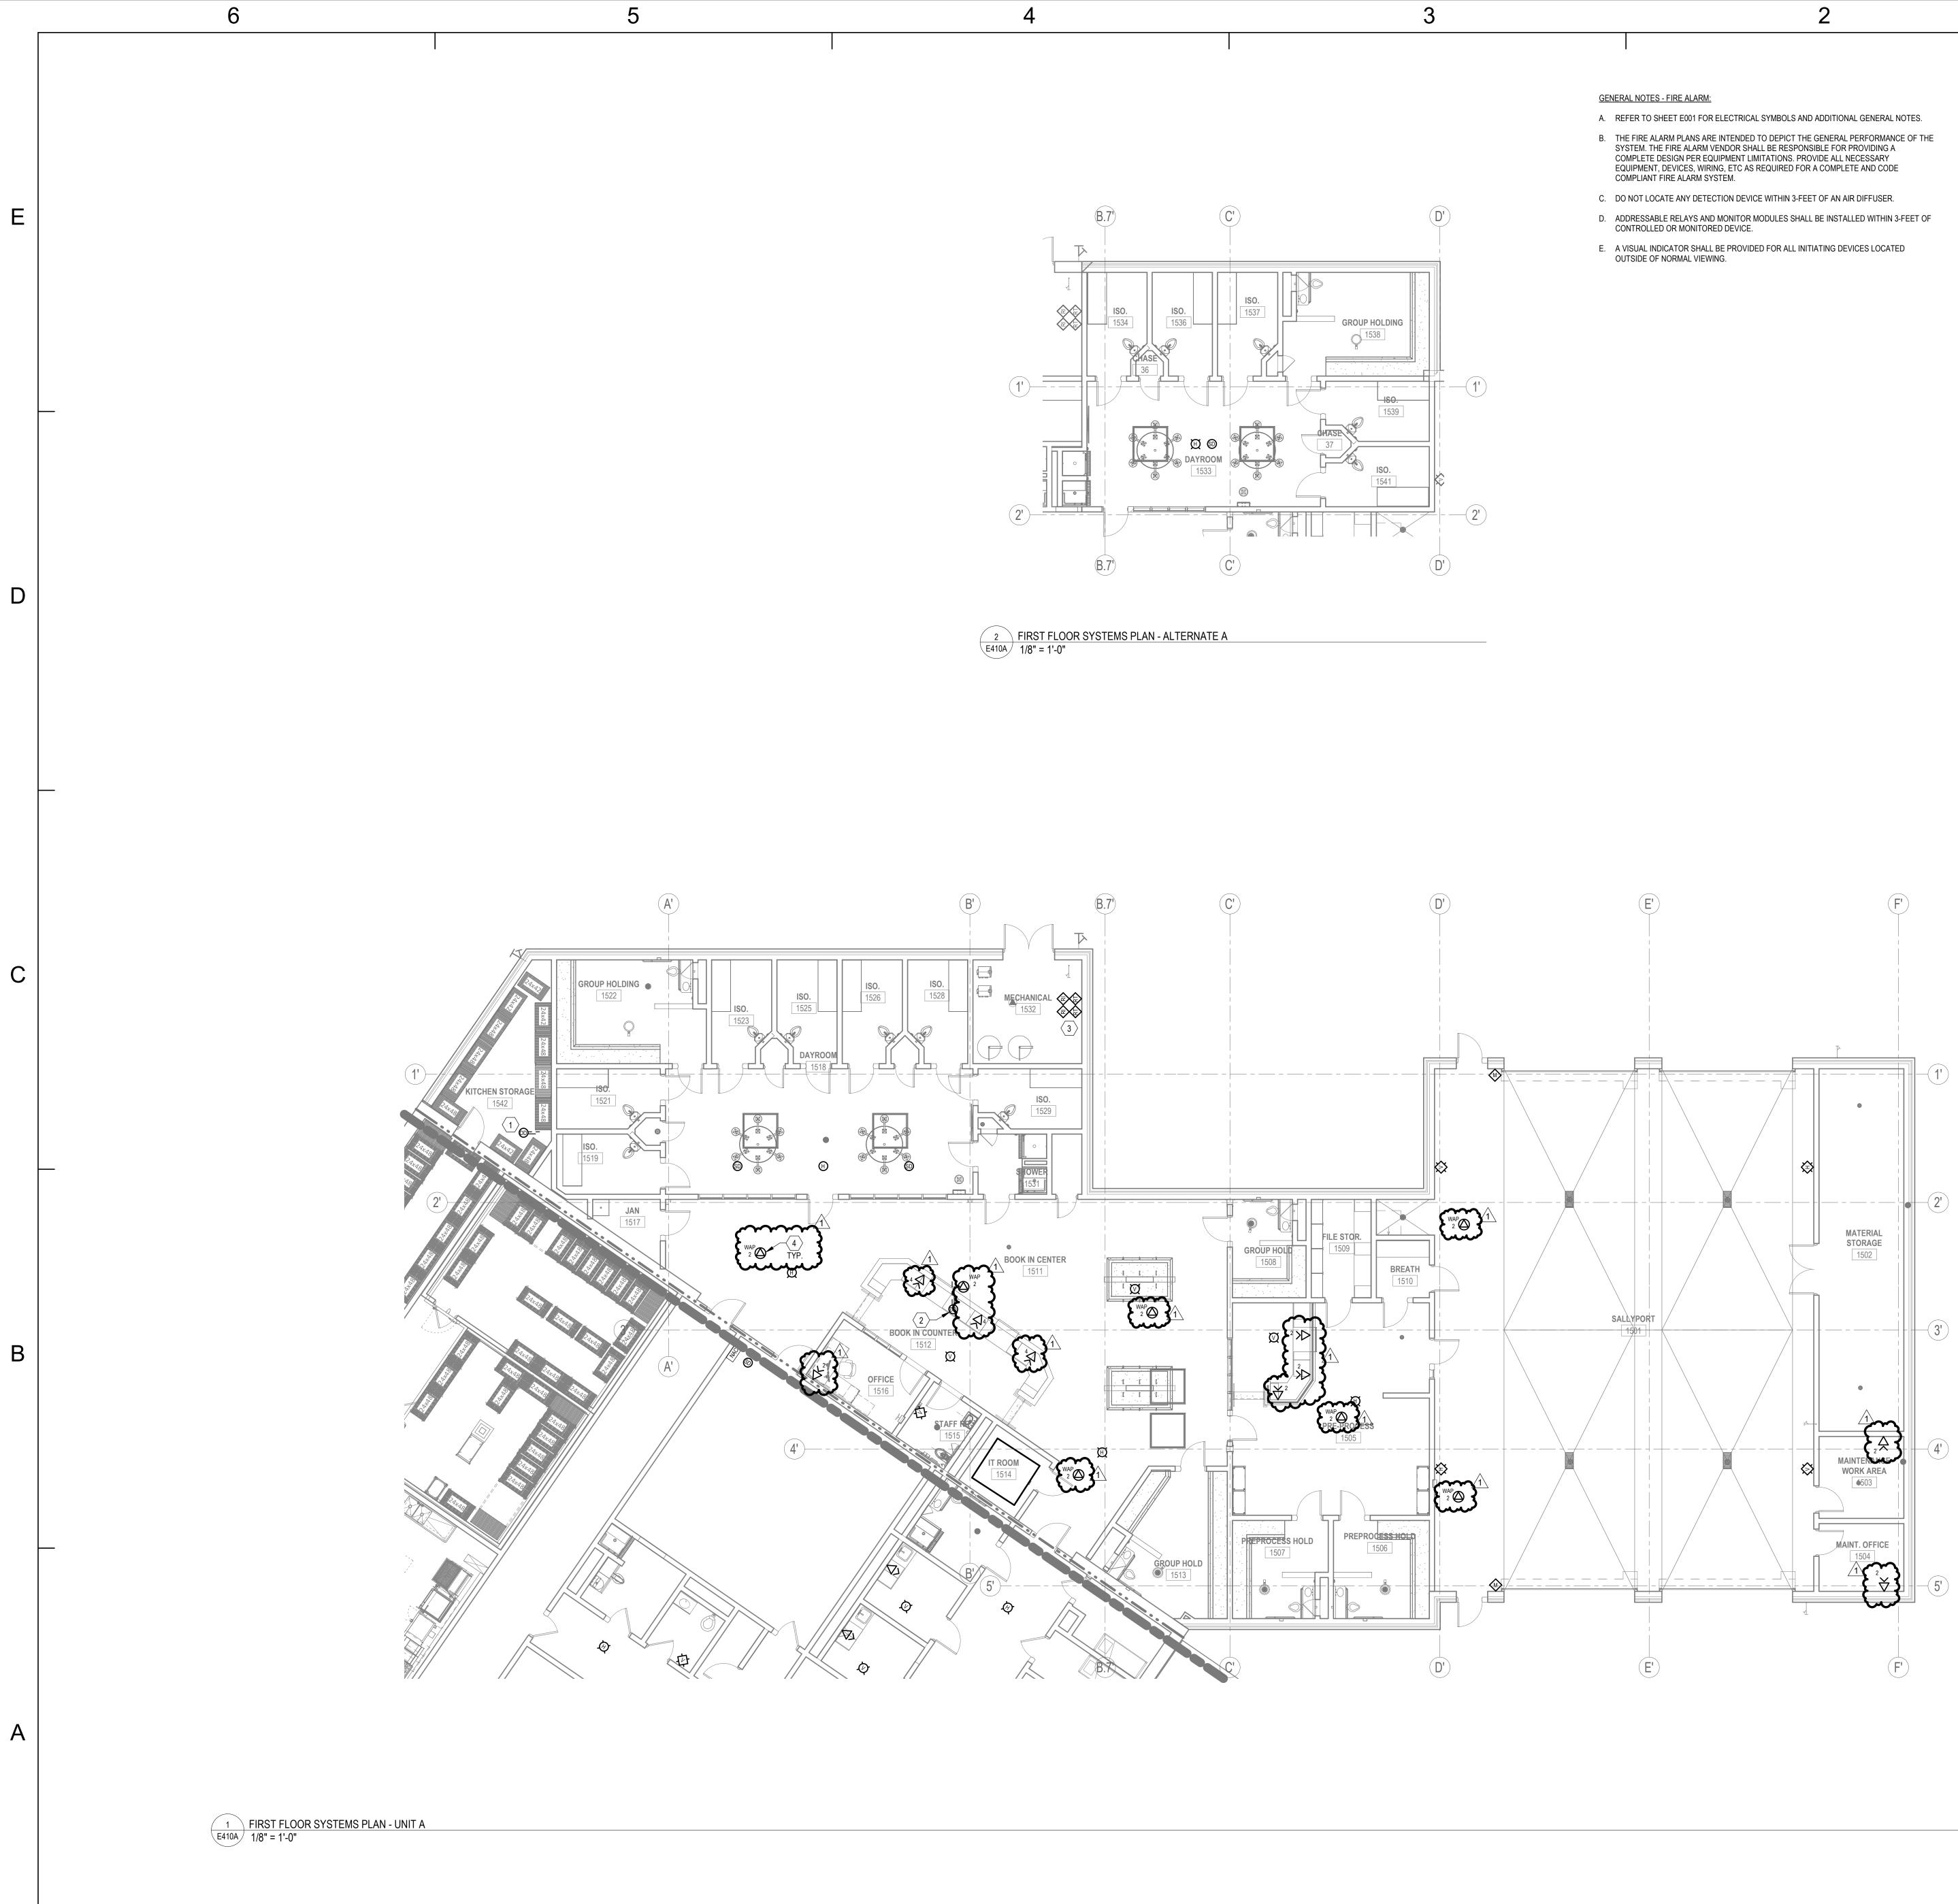

6

3


- **GENERAL NOTES SYSTEMS:**
- A. REFER TO SHEET E001 FOR ELECTRICAL SYMBOLS AND ADDITIONAL GENERAL NOTES. B. MAXIMUM NUMBER OF 4 INFORMATION OUTLET LOCATIONS PER CONDUIT HOME RUN TO MDF OR IDF IS PERMITTED. CONDUIT SHALL BE SIZED AS FOLLOWS:
- 1. (1) INFORMATION OUTLET LOCATION: 1"C 2. (2) INFORMATION OUTLET LOCATIONS: 1-1/4"C 3. (3) INFORMATION OUTLET LOCATIONS: 1-1/2"C
- C. ALL COMMUNICATIONS CABLES SHALL BE INSTALLED IN CONDUIT, CABLE TRAY, OR SUPPORTED BY CABLE HOOKS. PROVIDE BUSHINGS AT THE ENDS OF ALL CONDUIT WHERE STUBBED ABOVE ACCESSIBLE CEILINGS OR WHERE DROPPED INTO CABLE TRAY. PROVIDE CABLE HOOKS ABOVE ACCESSIBLE CEILINGS FOR CABLE INSTALLATION WHERE NOT INSTALLED IN CONDUIT OR CABLE TRAY.
- D. WHERE CONDUIT IS STUBBED ABOVE ACCESSIBLE CEILING, CABLES SHALL BE INSTALLED WITH SERVICE LOOPS. SERVICE LOOPS SHALL BE APPROXIMATELY TWO WRAPS, OR ABOUT 16" EXTRA INCHES FOR LOOP.
- E. ALL CABLEING SHALL BE CATEGORY 6.


PLAN NOTES

NOTE PROVIDE DUCT SMOKE DETECTOR DOWNSTREAM FROM ISO. SLEEPING UNITS. PROVIDE RETURN AIR DUCT SMOKE DETECTOR. - BROWDEREMOTEVEST INDICATORSTATIONOFOR DWCT SMOKE DETENTIONS. LAYOUT OF WIRELESS ACCESS POINTS IS DIAGRAMATICAL IN NATURE. HEAT MAP SHALL BE CONFIRMED WITH OWNER AND AME TELECOM. PROVIDE PROTECTIVE

WIRE GUARDS IN INMATE ACCESSIBLE AREAS AS REQUIRED.


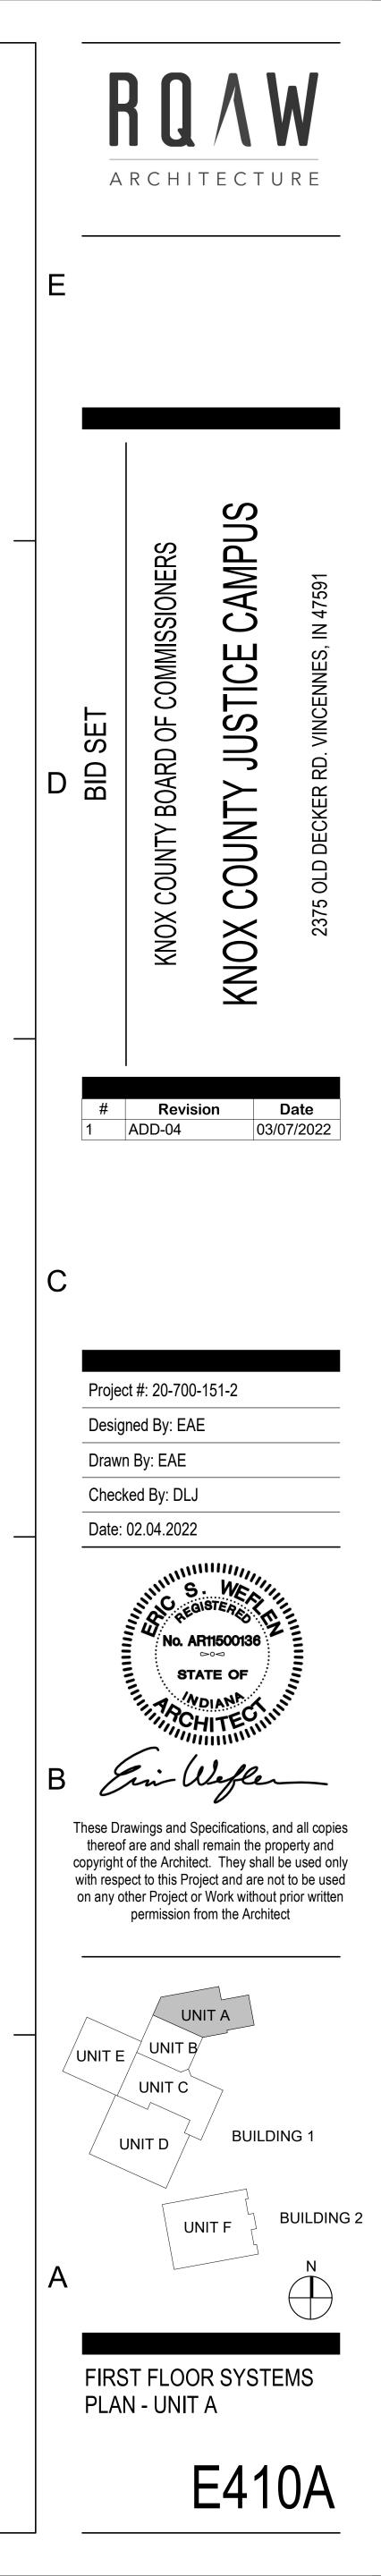

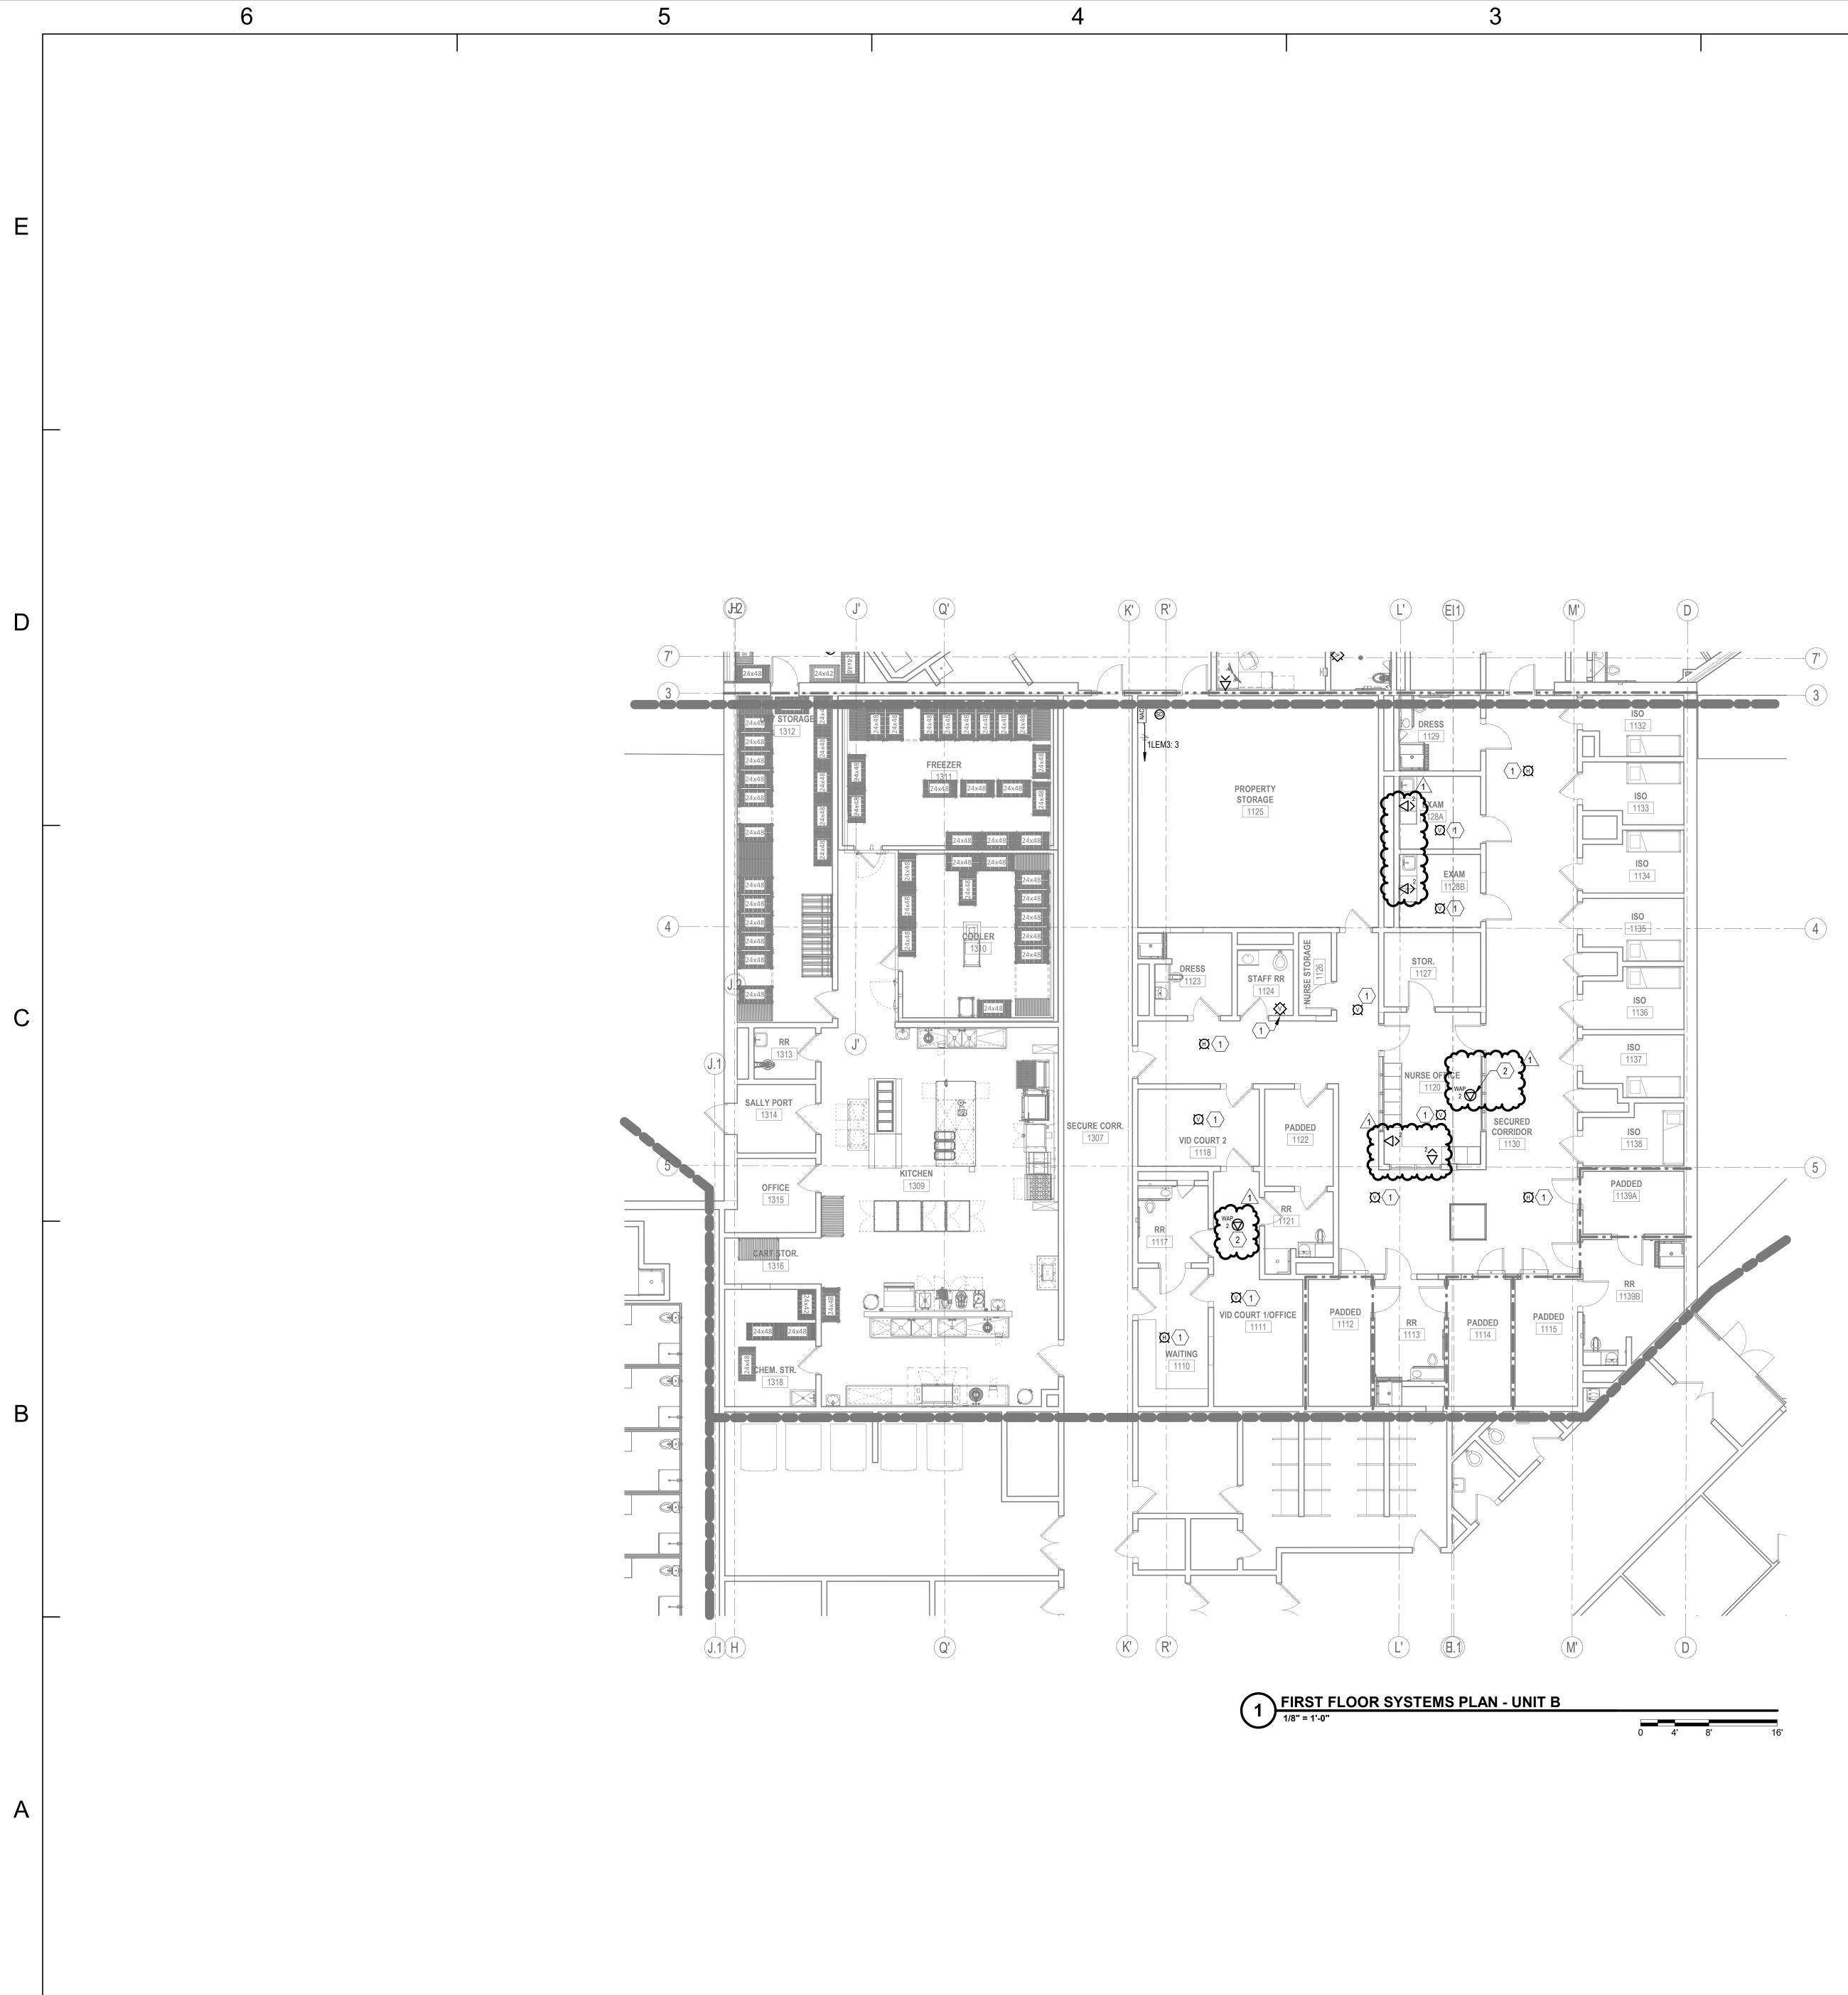


^


GENERAL NOTES - SYSTEMS:


- A. REFER TO SHEET E001 FOR ELECTRICAL SYMBOLS AND ADDITIONAL GENERAL NOTES. B. MAXIMUM NUMBER OF 4 INFORMATION OUTLET LOCATIONS PER CONDUIT HOME RUN TO MDF OR IDF IS PERMITTED. CONDUIT SHALL BE SIZED AS FOLLOWS:
- 1. (1) INFORMATION OUTLET LOCATION: 1"C 2. (2) INFORMATION OUTLET LOCATIONS: 1-1/4"C 3. (3) INFORMATION OUTLET LOCATIONS: 1-1/2"C
- C. ALL COMMUNICATIONS CABLES SHALL BE INSTALLED IN CONDUIT, CABLE TRAY, OR SUPPORTED BY CABLE HOOKS. PROVIDE BUSHINGS AT THE ENDS OF ALL CONDUIT WHERE STUBBED ABOVE ACCESSIBLE CEILINGS OR WHERE DROPPED INTO CABLE TRAY. PROVIDE CABLE HOOKS ABOVE ACCESSIBLE CEILINGS FOR CABLE INSTALLATION WHERE NOT INSTALLED IN CONDUIT OR CABLE TRAY.
- D. WHERE CONDUIT IS STUBBED ABOVE ACCESSIBLE CEILING, CABLES SHALL BE INSTALLED WITH SERVICE LOOPS. SERVICE LOOPS SHALL BE APPROXIMATELY TWO WRAPS, OR ABOUT 16" EXTRA INCHES FOR LOOP.
- E. ALL CABLEING SHALL BE CATEGORY 6.

GENERAL NOTES - FIRE ALARM:

- A. REFER TO SHEET E001 FOR ELECTRICAL SYMBOLS AND ADDITIONAL GENERAL NOTES. B. THE FIRE ALARM PLANS ARE INTENDED TO DEPICT THE GENERAL PERFORMANCE OF THE SYSTEM. THE FIRE ALARM VENDOR SHALL BE RESPONSIBLE FOR PROVIDING A COMPLETE DESIGN PER EQUIPMENT LIMITATIONS. PROVIDE ALL NECESSARY EQUIPMENT, DEVICES, WIRING, ETC AS REQUIRED FOR A COMPLETE AND CODE
- COMPLIANT FIRE ALARM SYSTEM. C. DO NOT LOCATE ANY DETECTION DEVICE WITHIN 3-FEET OF AN AIR DIFFUSER.
- D. ADDRESSABLE RELAYS AND MONITOR MODULES SHALL BE INSTALLED WITHIN 3-FEET OF CONTROLLED OR MONITORED DEVICE.
- E. A VISUAL INDICATOR SHALL BE PROVIDED FOR ALL INITIATING DEVICES LOCATED OUTSIDE OF NORMAL VIEWING.

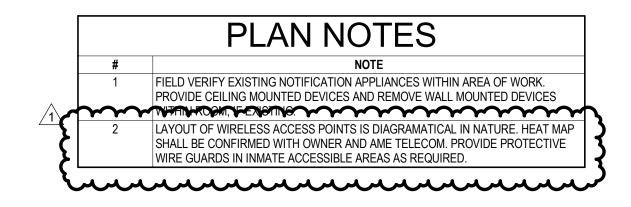

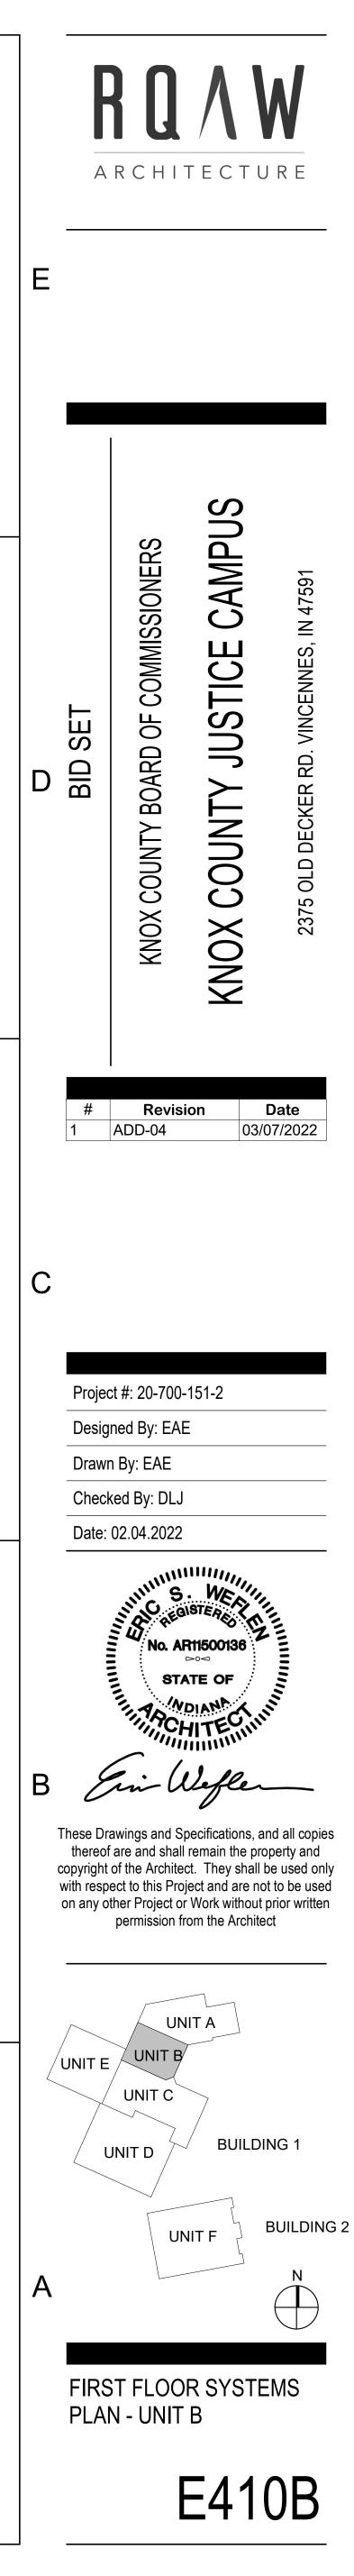

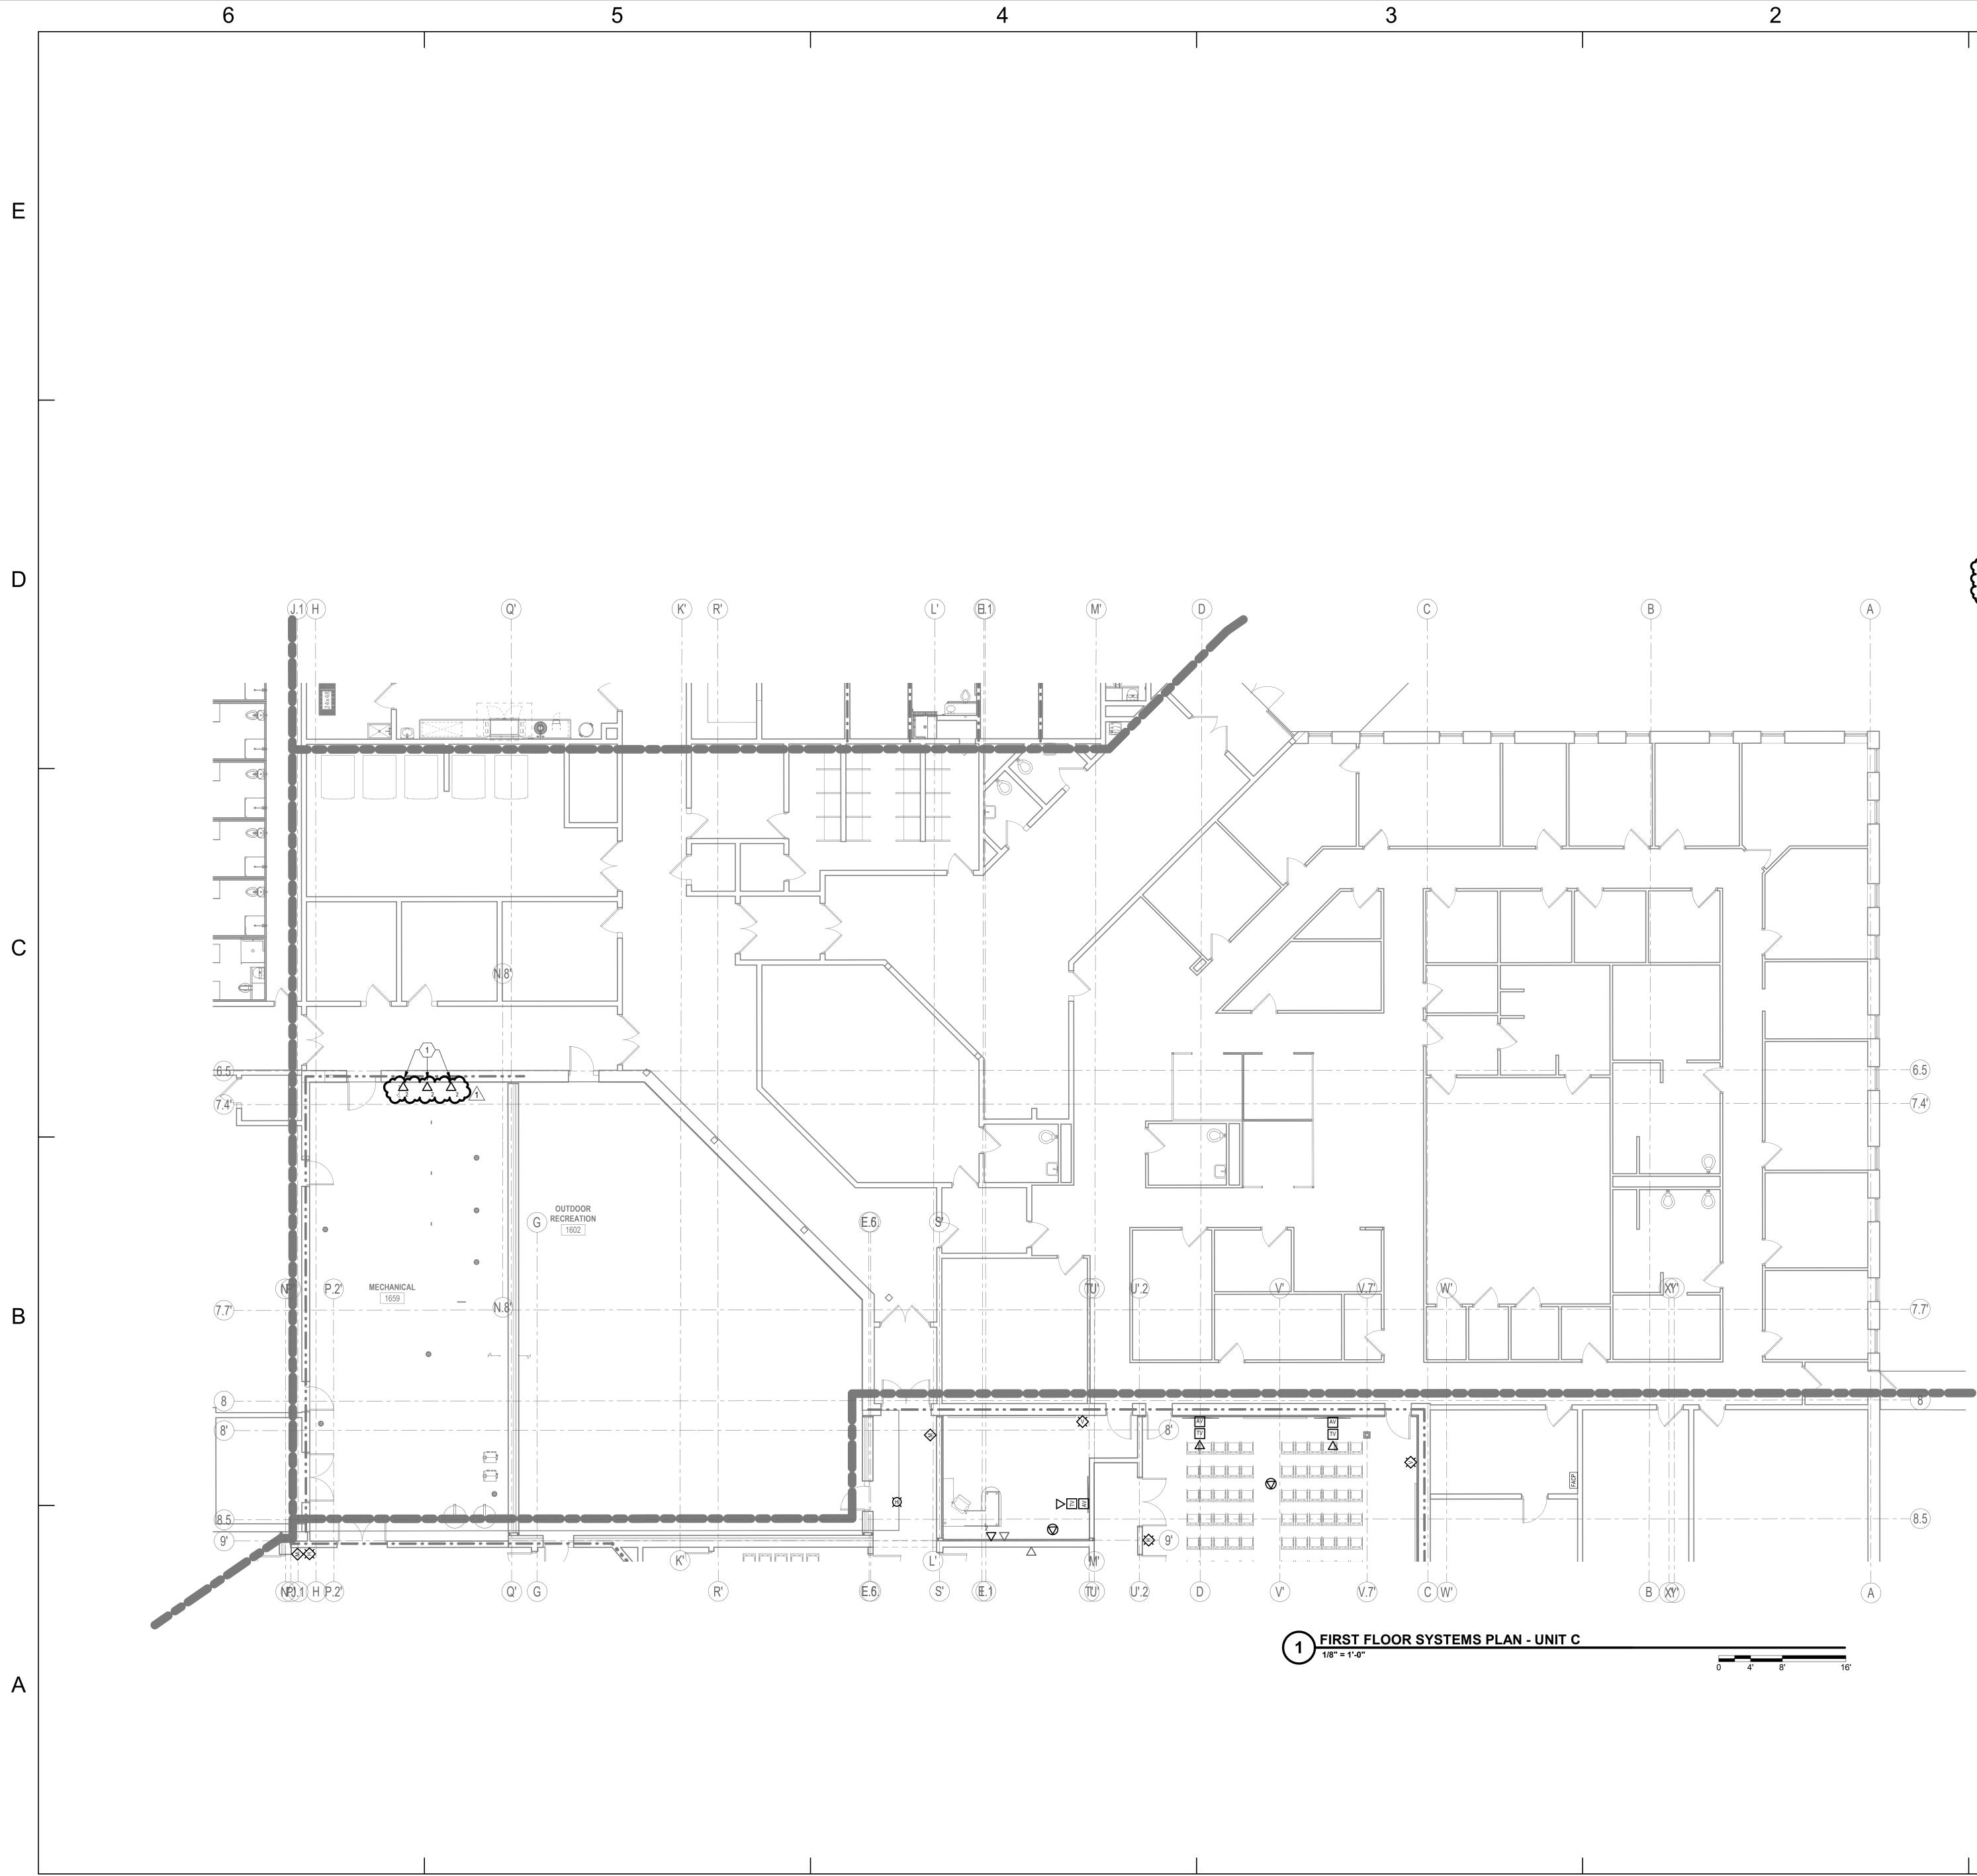


6

5


- MDF OR IDF IS PERMITTED. CONDUIT SHALL BE SIZED AS FOLLOWS:
- 1. (1) INFORMATION OUTLET LOCATION: 1"C 2. (2) INFORMATION OUTLET LOCATIONS: 1-1/4"C 3. (3) INFORMATION OUTLET LOCATIONS: 1-1/2"C
- SUPPORTED BY CABLE HOOKS. PROVIDE BUSHINGS AT THE ENDS OF ALL CONDUIT NOT INSTALLED IN CONDUIT OR CABLE TRAY.
- WRAPS, OR ABOUT 16" EXTRA INCHES FOR LOOP.

- SYSTEM. THE FIRE ALARM VENDOR SHALL BE RESPONSIBLE FOR PROVIDING A COMPLETE DESIGN PER EQUIPMENT LIMITATIONS. PROVIDE ALL NECESSARY EQUIPMENT, DEVICES, WIRING, ETC AS REQUIRED FOR A COMPLETE AND CODE
- CONTROLLED OR MONITORED DEVICE.

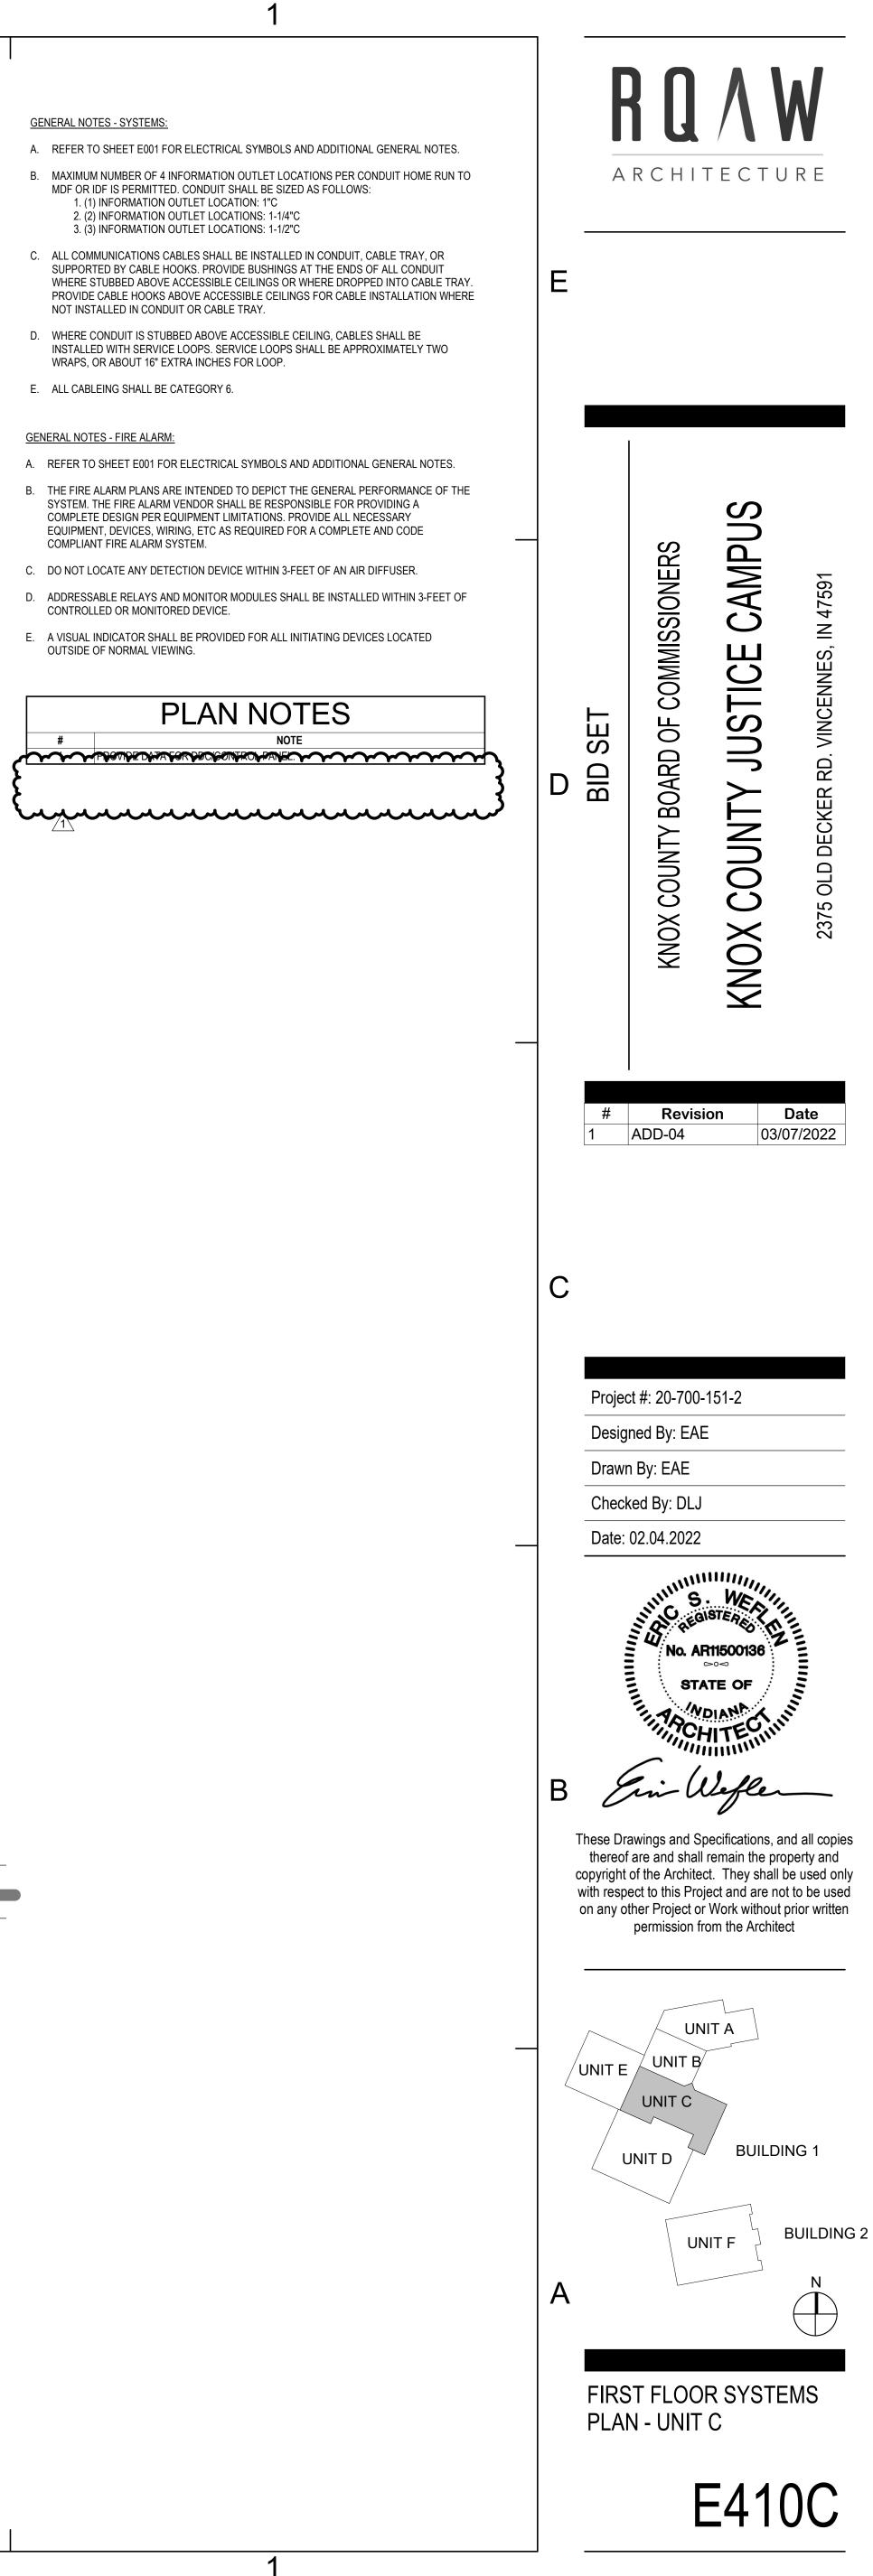





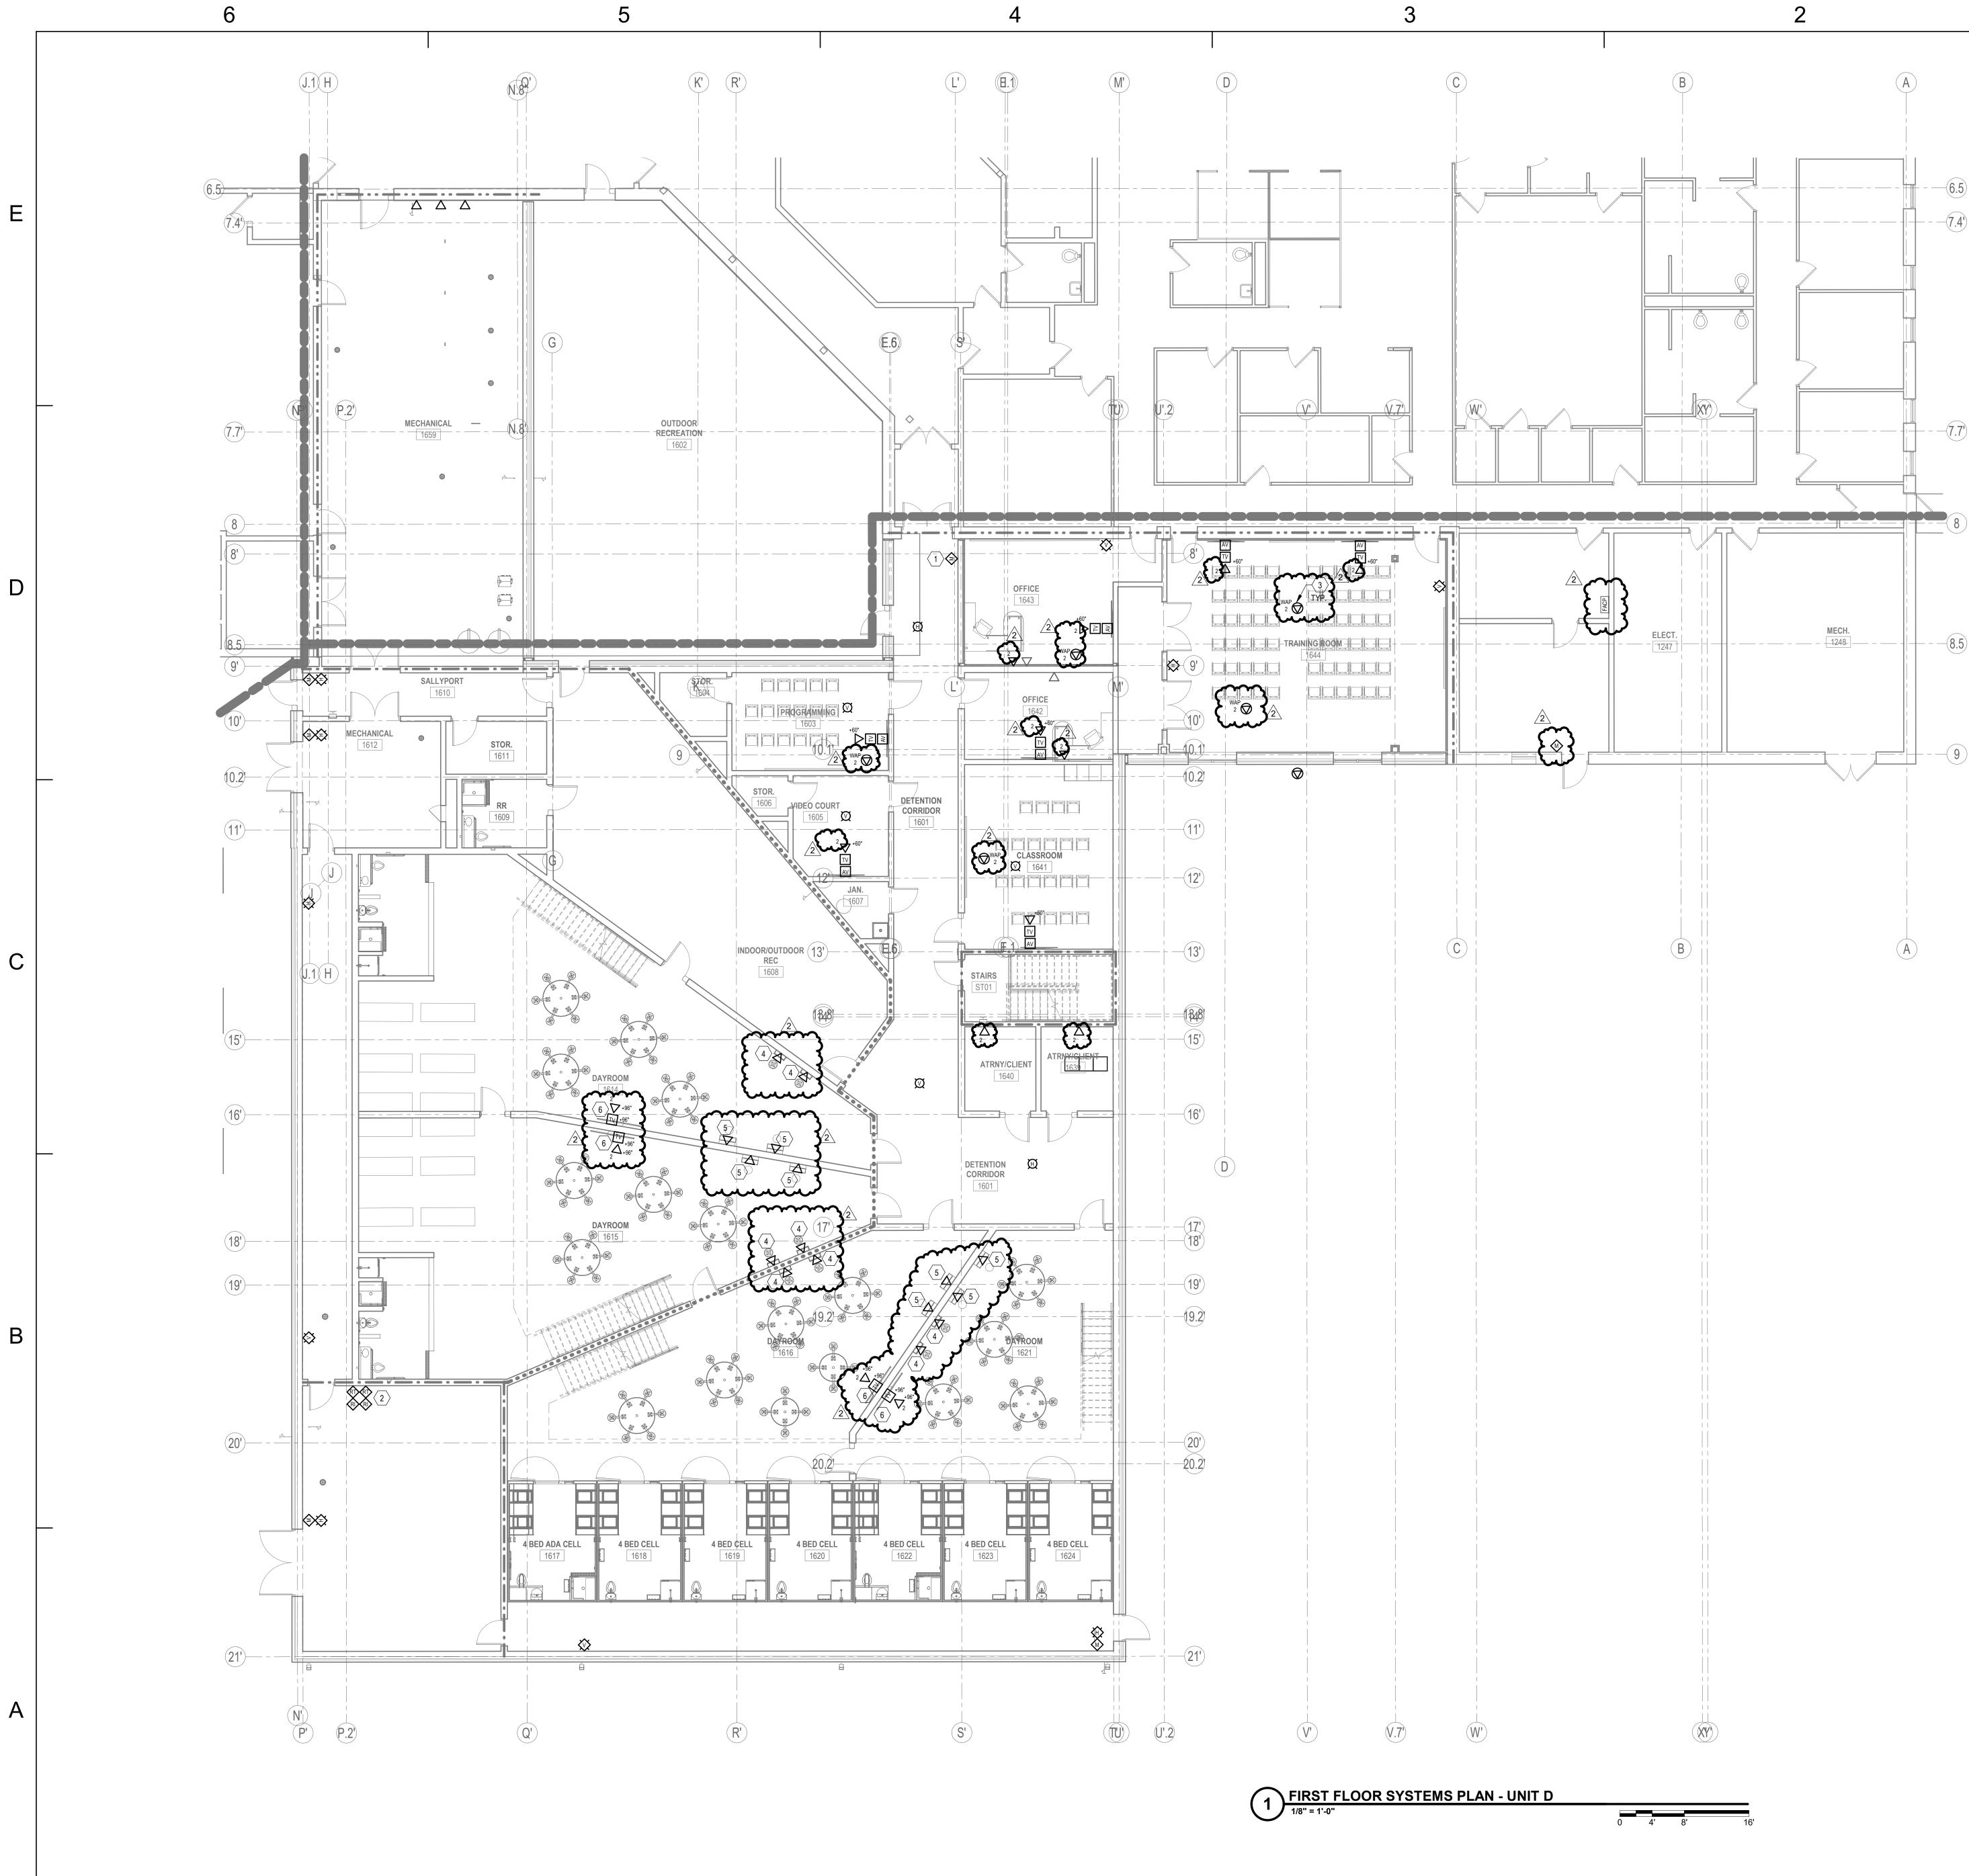


GENERAL NOTES - SYSTEMS:


- A. REFER TO SHEET E001 FOR ELECTRICAL SYMBOLS AND ADDITIONAL GENERAL NOTES. B. MAXIMUM NUMBER OF 4 INFORMATION OUTLET LOCATIONS PER CONDUIT HOME RUN TO MDF OR IDF IS PERMITTED. CONDUIT SHALL BE SIZED AS FOLLOWS:
- 1. (1) INFORMATION OUTLET LOCATION: 1"C 2. (2) INFORMATION OUTLET LOCATIONS: 1-1/4"C 3. (3) INFORMATION OUTLET LOCATIONS: 1-1/2"C
- ALL COMMUNICATIONS CABLES SHALL BE INSTALLED IN CONDUIT, CABLE TRAY, OR SUPPORTED BY CABLE HOOKS. PROVIDE BUSHINGS AT THE ENDS OF ALL CONDUIT WHERE STUBBED ABOVE ACCESSIBLE CEILINGS OR WHERE DROPPED INTO CABLE TRAY. PROVIDE CABLE HOOKS ABOVE ACCESSIBLE CEILINGS FOR CABLE INSTALLATION WHERE NOT INSTALLED IN CONDUIT OR CABLE TRAY.
- D. WHERE CONDUIT IS STUBBED ABOVE ACCESSIBLE CEILING, CABLES SHALL BE INSTALLED WITH SERVICE LOOPS. SERVICE LOOPS SHALL BE APPROXIMATELY TWO WRAPS, OR ABOUT 16" EXTRA INCHES FOR LOOP.
- E. ALL CABLEING SHALL BE CATEGORY 6.

GENERAL NOTES - FIRE ALARM:

- A. REFER TO SHEET E001 FOR ELECTRICAL SYMBOLS AND ADDITIONAL GENERAL NOTES. B. THE FIRE ALARM PLANS ARE INTENDED TO DEPICT THE GENERAL PERFORMANCE OF THE SYSTEM. THE FIRE ALARM VENDOR SHALL BE RESPONSIBLE FOR PROVIDING A COMPLETE DESIGN PER EQUIPMENT LIMITATIONS. PROVIDE ALL NECESSARY EQUIPMENT, DEVICES, WIRING, ETC AS REQUIRED FOR A COMPLETE AND CODE
- COMPLIANT FIRE ALARM SYSTEM. C. DO NOT LOCATE ANY DETECTION DEVICE WITHIN 3-FEET OF AN AIR DIFFUSER.
- D. ADDRESSABLE RELAYS AND MONITOR MODULES SHALL BE INSTALLED WITHIN 3-FEET OF CONTROLLED OR MONITORED DEVICE.
- E. A VISUAL INDICATOR SHALL BE PROVIDED FOR ALL INITIATING DEVICES LOCATED OUTSIDE OF NORMAL VIEWING.

#	NOTE
1	PROVIDE KEY OPERATED SINGLE ACTION MANUAL STATION WITH INSTITUTIONAL COVER.
	~ PROVIDE REMOVER FOR AND KATOR STATIONS FOR DUCT SINGKE DETECTORS.
3	LAYOUT OF WIRELESS ACCESS POINTS IS DIAGRAMATICAL IN NATURE. HEAT MAI SHALL BE CONFIRMED WITH OWNER AND AME TELECOM. PROVIDE PROTECTIVE WIRE GUARDS IN INMATE ACCESSIBLE AREAS AS REQUIRED.
4	VIDEO VISITATION STATION: PROVIDE FLUSH MOUNTED DATA OUTLET FROM SECURITY ELECTRONICS ROOM. REFER TO DETAIL AND POWER DRAWINGS FOR ADDITIONAL INFORMATION. COORDINATE EXACT LOCATION AND MOUNTING HEIGHT WITH ARCHITECTURAL DRAWINGS.
5	WALL MOUNTED TELEPHONE: REFER TO DETAIL AND SECURITY DRAWINGS FOR ADDITIONAL INFORMATION. COORDINATE EXACT LOCATION AND MOUNTING HEIGHT WITH ARCHITECTURAL DRAWINGS.
6	TELEVISION RECEPTACLE: REFER TO DETAIL, POWER DRAWINGS AND SECURITY DRAWINGS FOR ADDITIONAL ELECTRICAL INFORMATION. COORDINATE EXACT LOCATION AND MOUNTING HEIGHT WITH ARCHITECTURAL DRAWINGS.

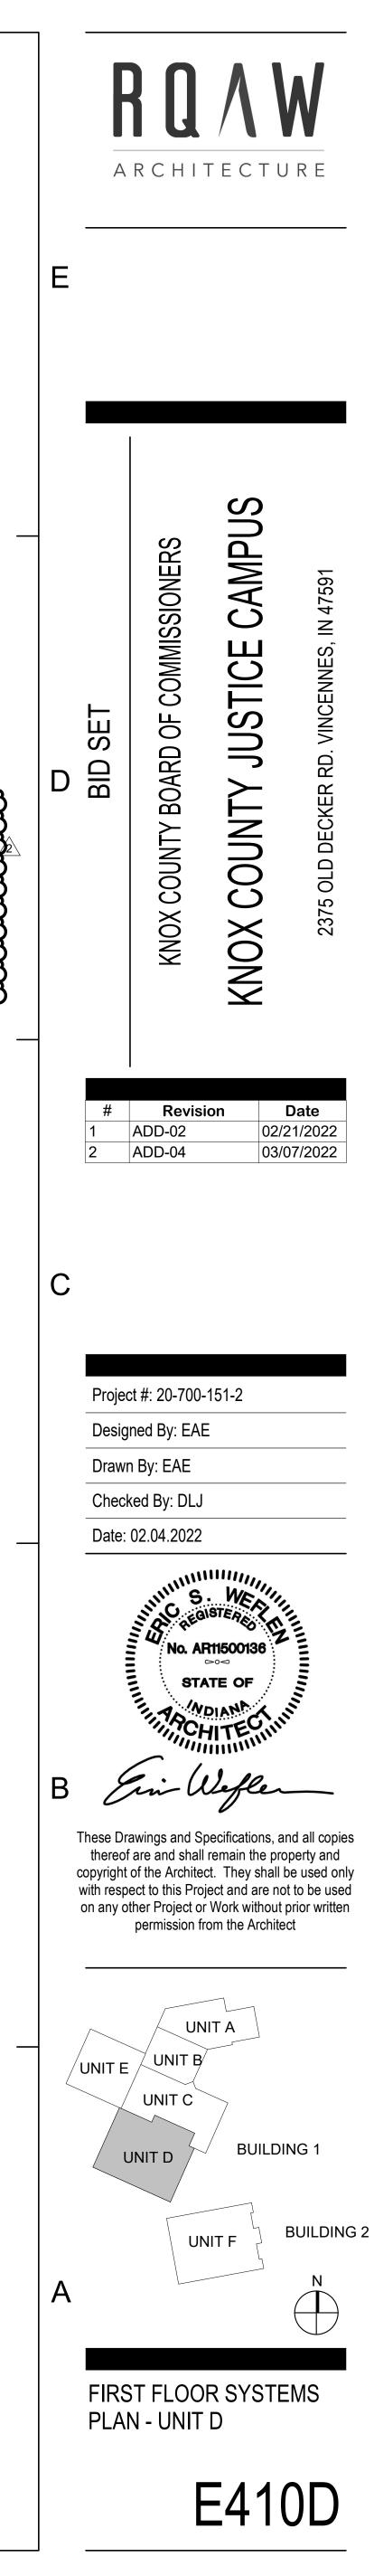

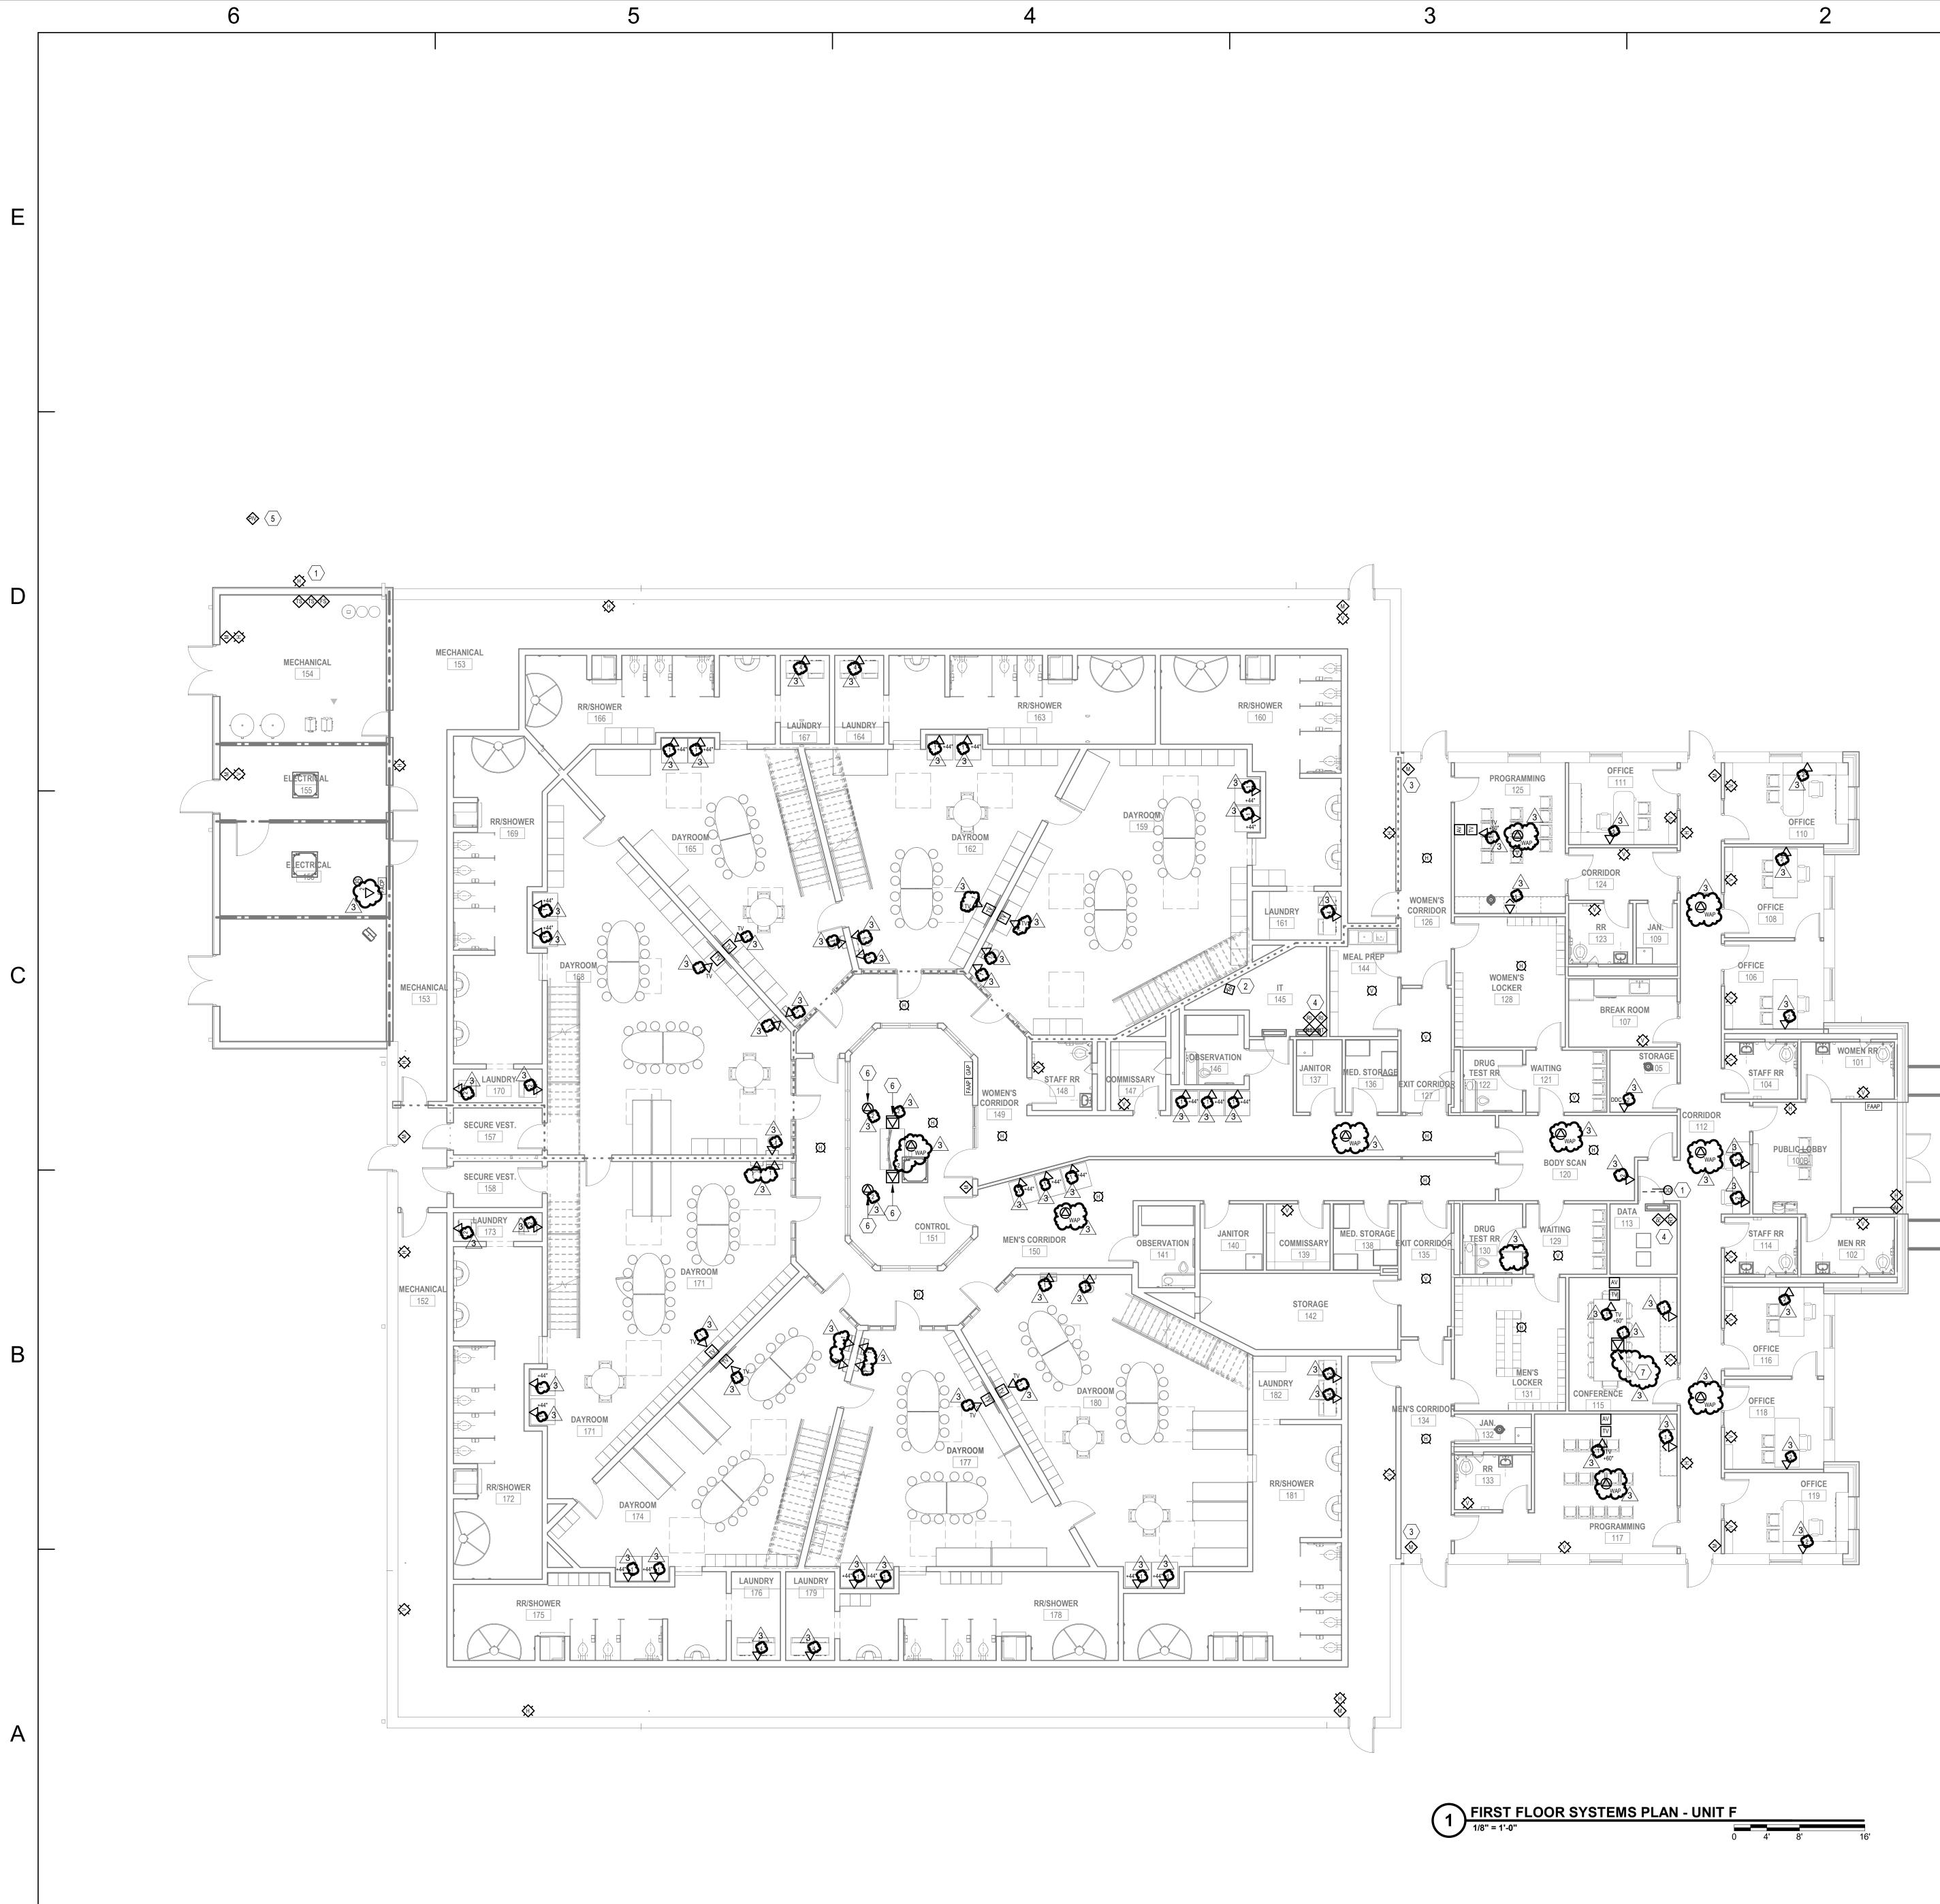

6

5


3


GENERAL NOTES - SYSTEMS:


- A. REFER TO SHEET E001 FOR ELECTRICAL SYMBOLS AND ADDITIONAL GENERAL NOTES. B. MAXIMUM NUMBER OF 4 INFORMATION OUTLET LOCATIONS PER CONDUIT HOME RUN TO MDF OR IDF IS PERMITTED. CONDUIT SHALL BE SIZED AS FOLLOWS:
- 1. (1) INFORMATION OUTLET LOCATION: 1"C 2. (2) INFORMATION OUTLET LOCATIONS: 1-1/4"C 3. (3) INFORMATION OUTLET LOCATIONS: 1-1/2"C
- C. ALL COMMUNICATIONS CABLES SHALL BE INSTALLED IN CONDUIT, CABLE TRAY, OR SUPPORTED BY CABLE HOOKS. PROVIDE BUSHINGS AT THE ENDS OF ALL CONDUIT WHERE STUBBED ABOVE ACCESSIBLE CEILINGS OR WHERE DROPPED INTO CABLE TRAY. PROVIDE CABLE HOOKS ABOVE ACCESSIBLE CEILINGS FOR CABLE INSTALLATION WHERE NOT INSTALLED IN CONDUIT OR CABLE TRAY.
- D. WHERE CONDUIT IS STUBBED ABOVE ACCESSIBLE CEILING, CABLES SHALL BE INSTALLED WITH SERVICE LOOPS. SERVICE LOOPS SHALL BE APPROXIMATELY TWO WRAPS, OR ABOUT 16" EXTRA INCHES FOR LOOP.
- E. ALL CABLEING SHALL BE CATEGORY 6.


GENERAL NOTES - FIRE ALARM:


- A. REFER TO SHEET E001 FOR ELECTRICAL SYMBOLS AND ADDITIONAL GENERAL NOTES. B. THE FIRE ALARM PLANS ARE INTENDED TO DEPICT THE GENERAL PERFORMANCE OF THE SYSTEM. THE FIRE ALARM VENDOR SHALL BE RESPONSIBLE FOR PROVIDING A COMPLETE DESIGN PER EQUIPMENT LIMITATIONS. PROVIDE ALL NECESSARY EQUIPMENT, DEVICES, WIRING, ETC AS REQUIRED FOR A COMPLETE AND CODE
- COMPLIANT FIRE ALARM SYSTEM. C. DO NOT LOCATE ANY DETECTION DEVICE WITHIN 3-FEET OF AN AIR DIFFUSER.
- D. ADDRESSABLE RELAYS AND MONITOR MODULES SHALL BE INSTALLED WITHIN 3-FEET OF CONTROLLED OR MONITORED DEVICE.
- E. A VISUAL INDICATOR SHALL BE PROVIDED FOR ALL INITIATING DEVICES LOCATED OUTSIDE OF NORMAL VIEWING.

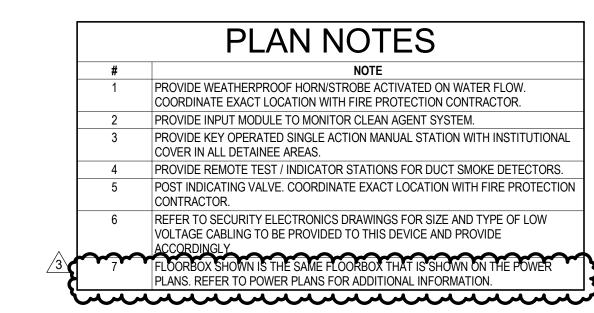


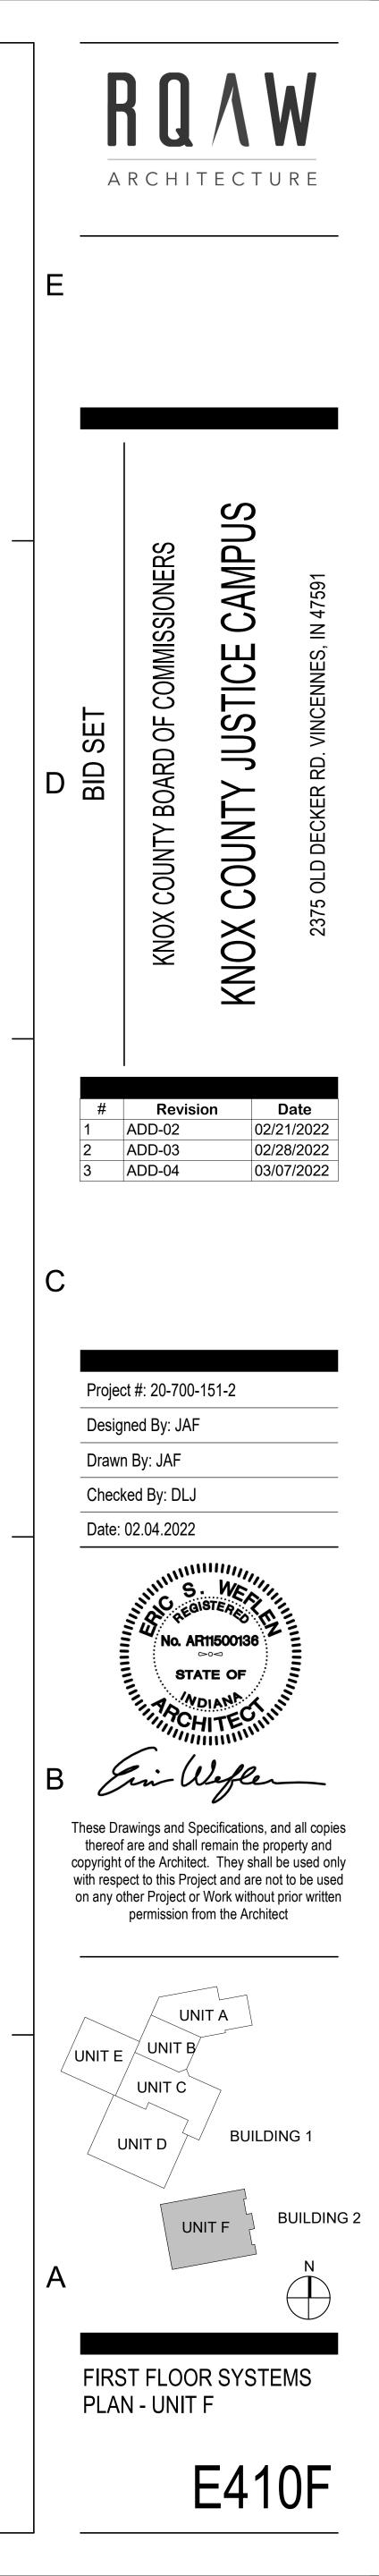


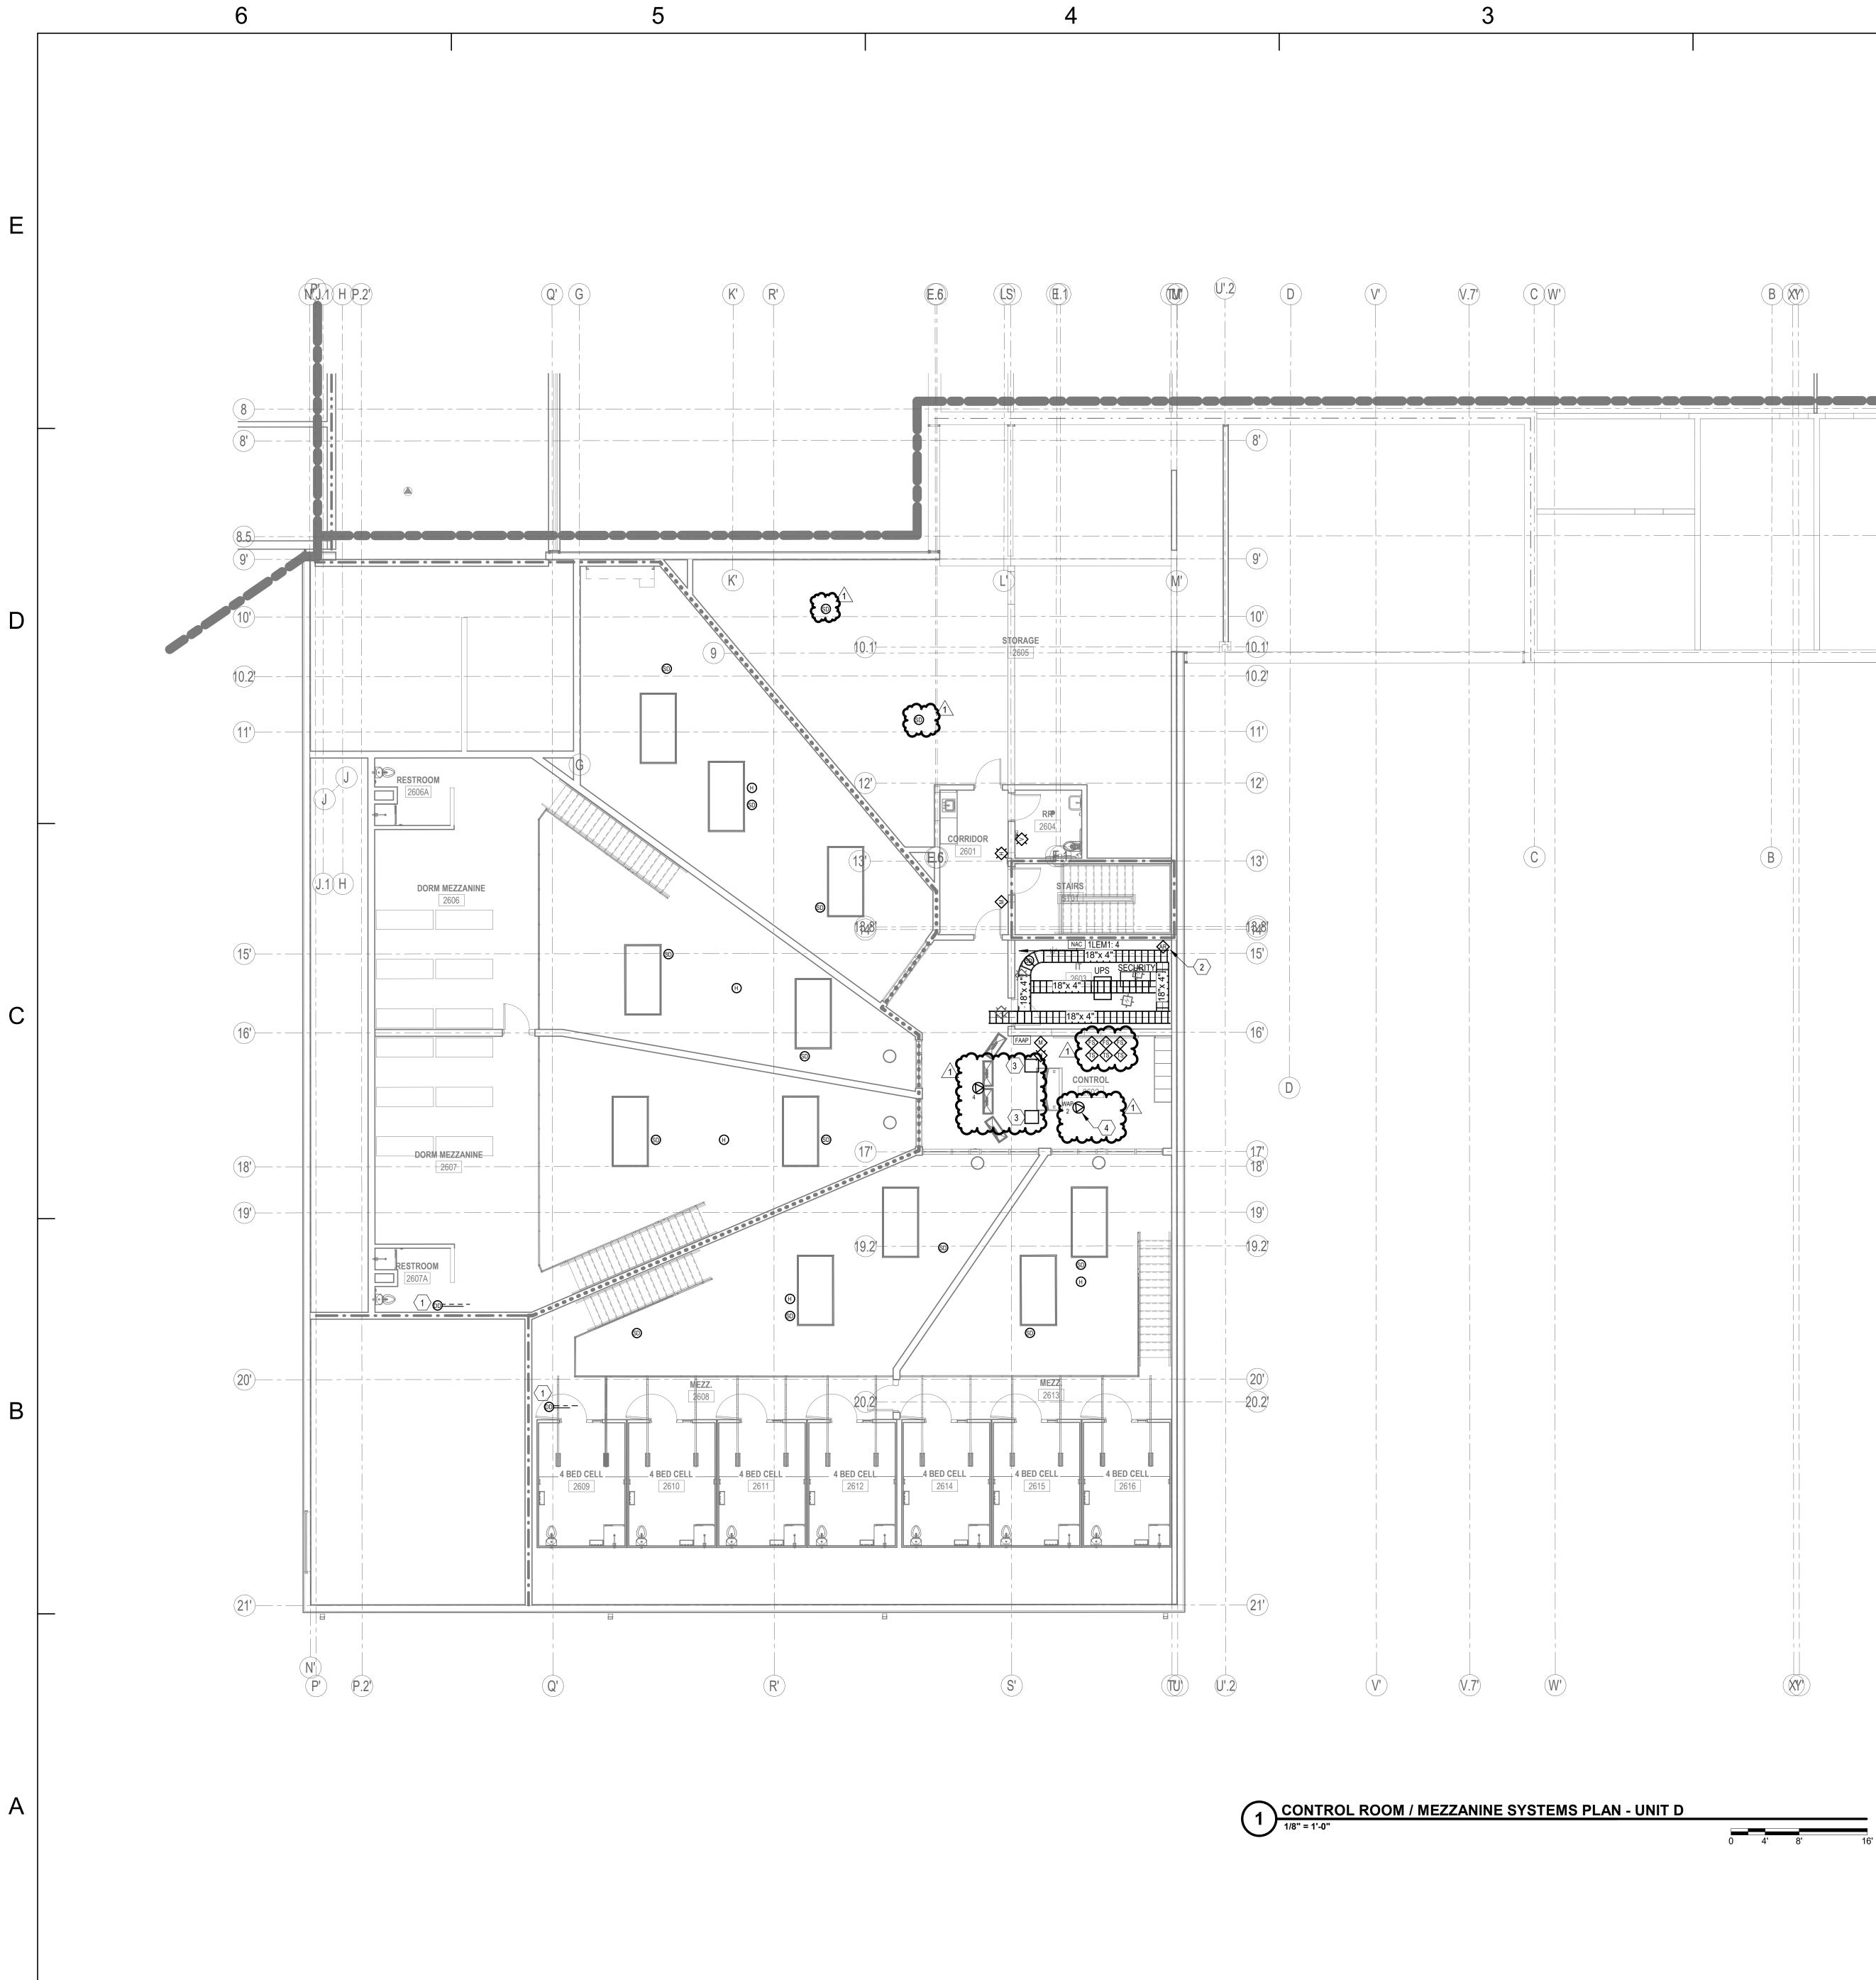

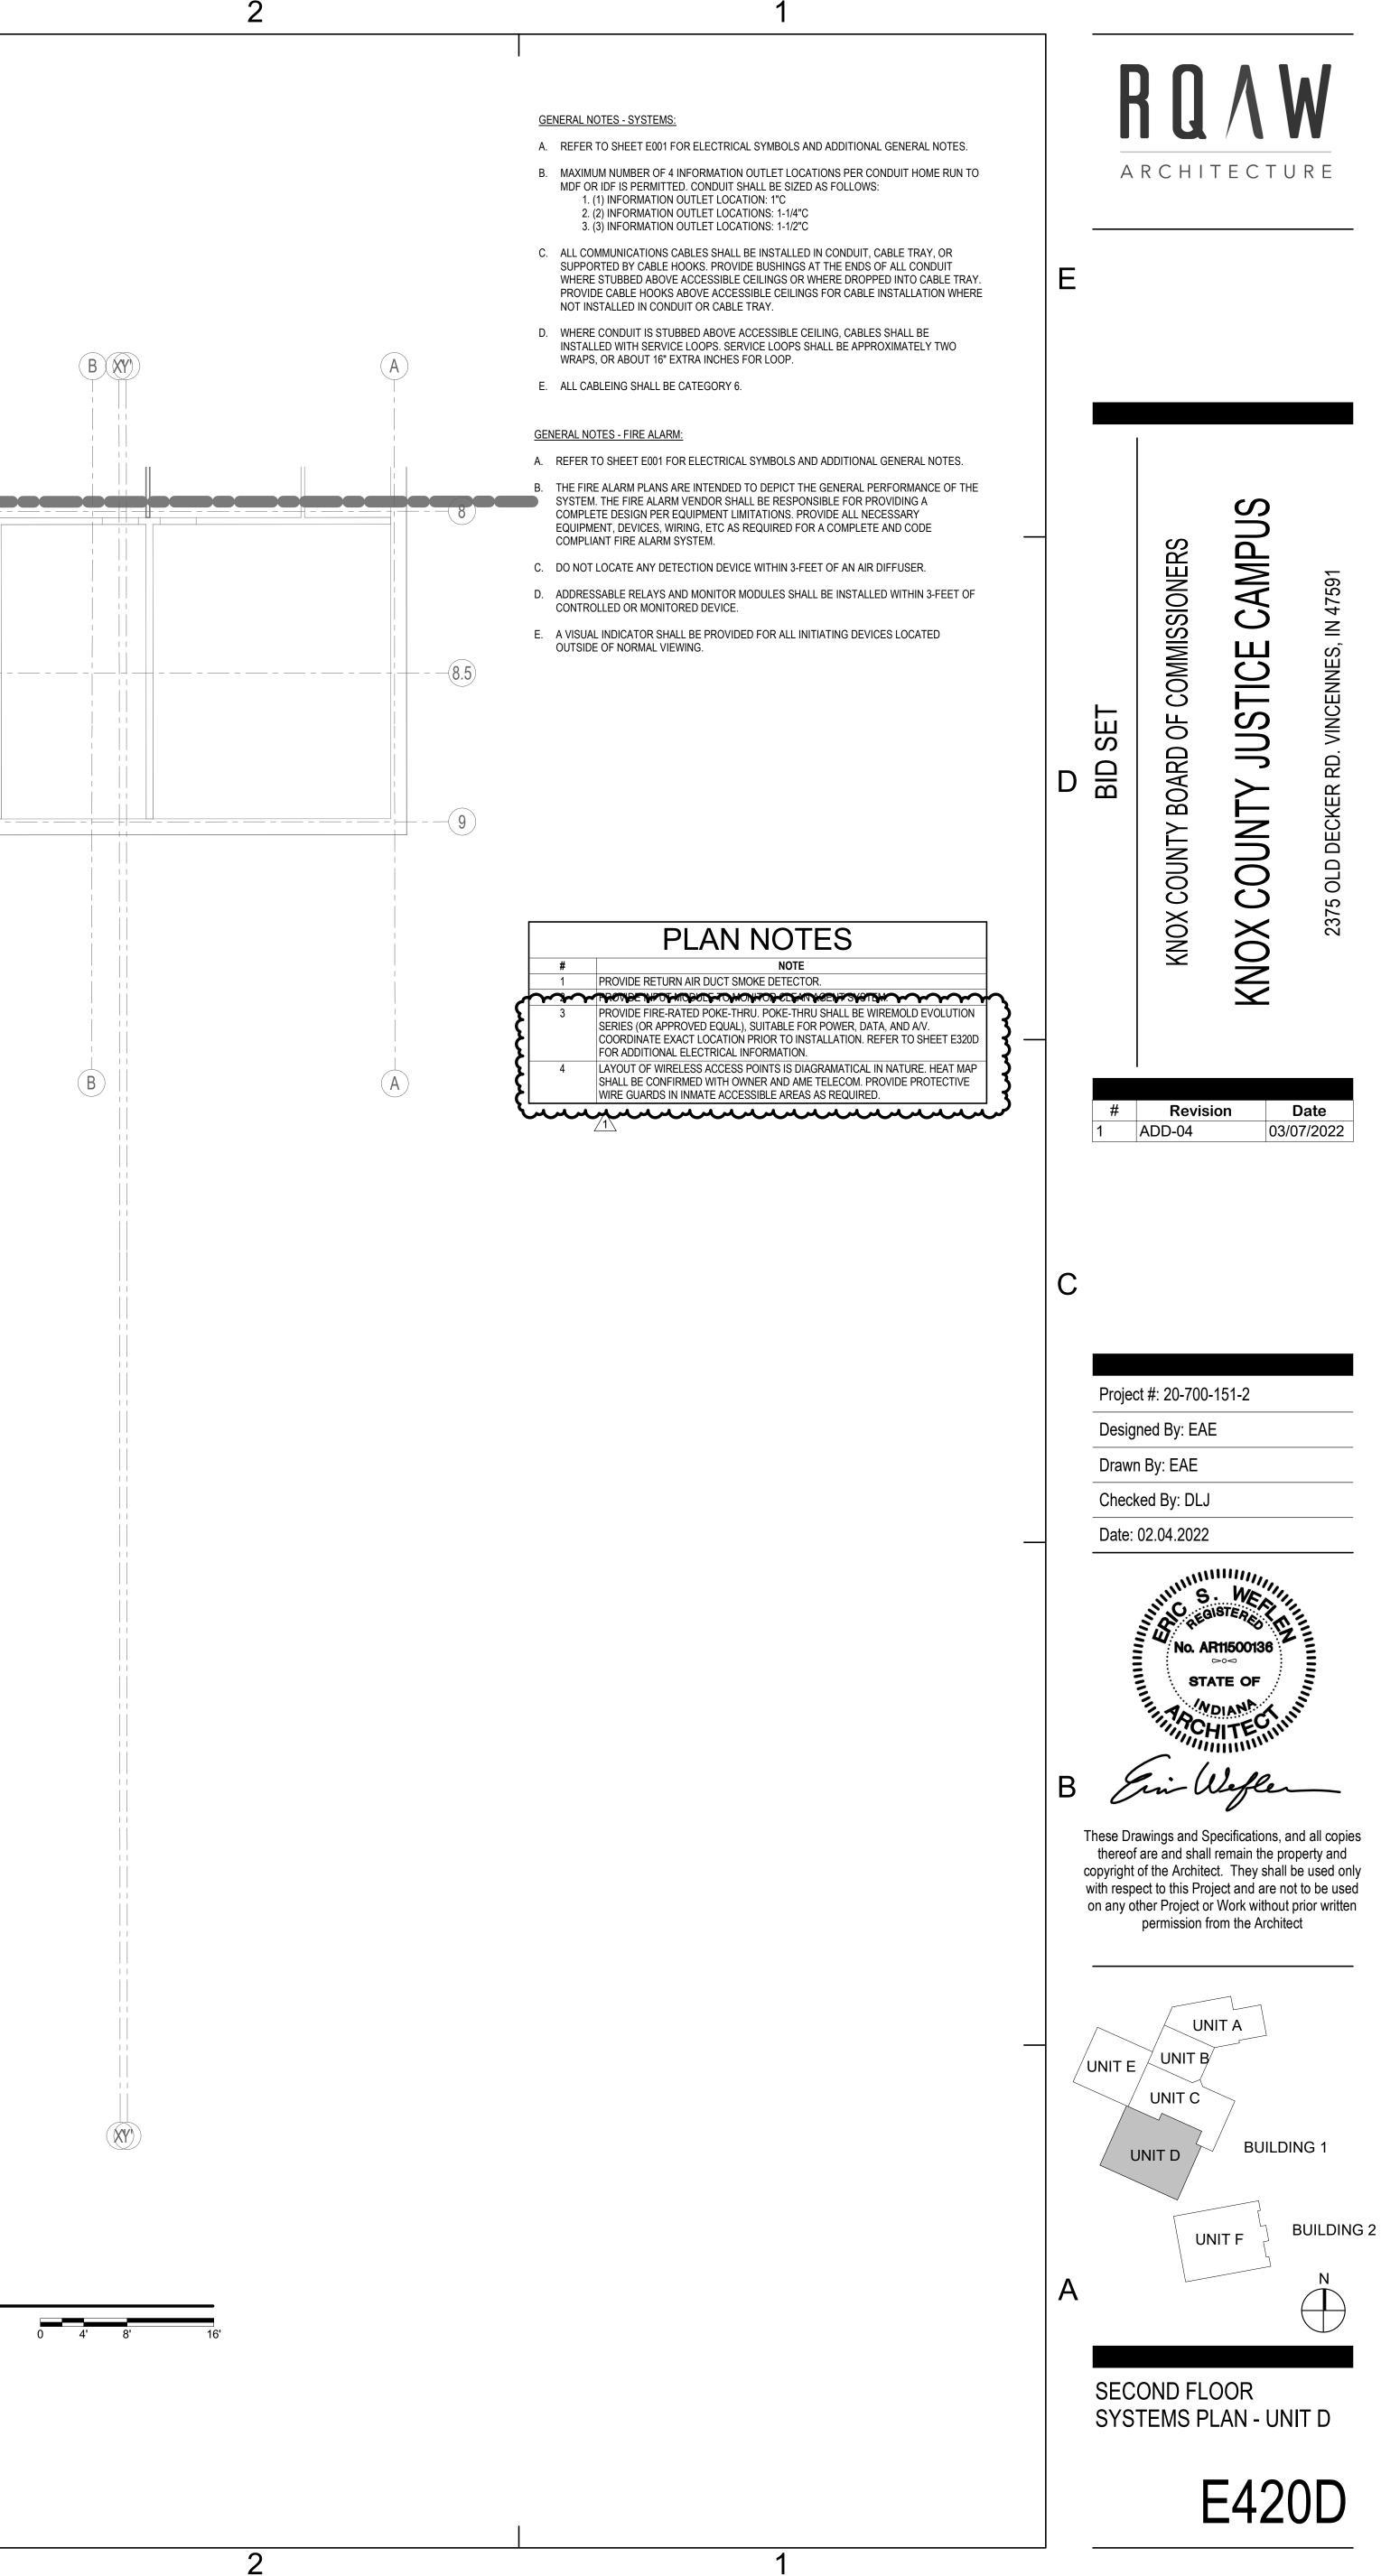

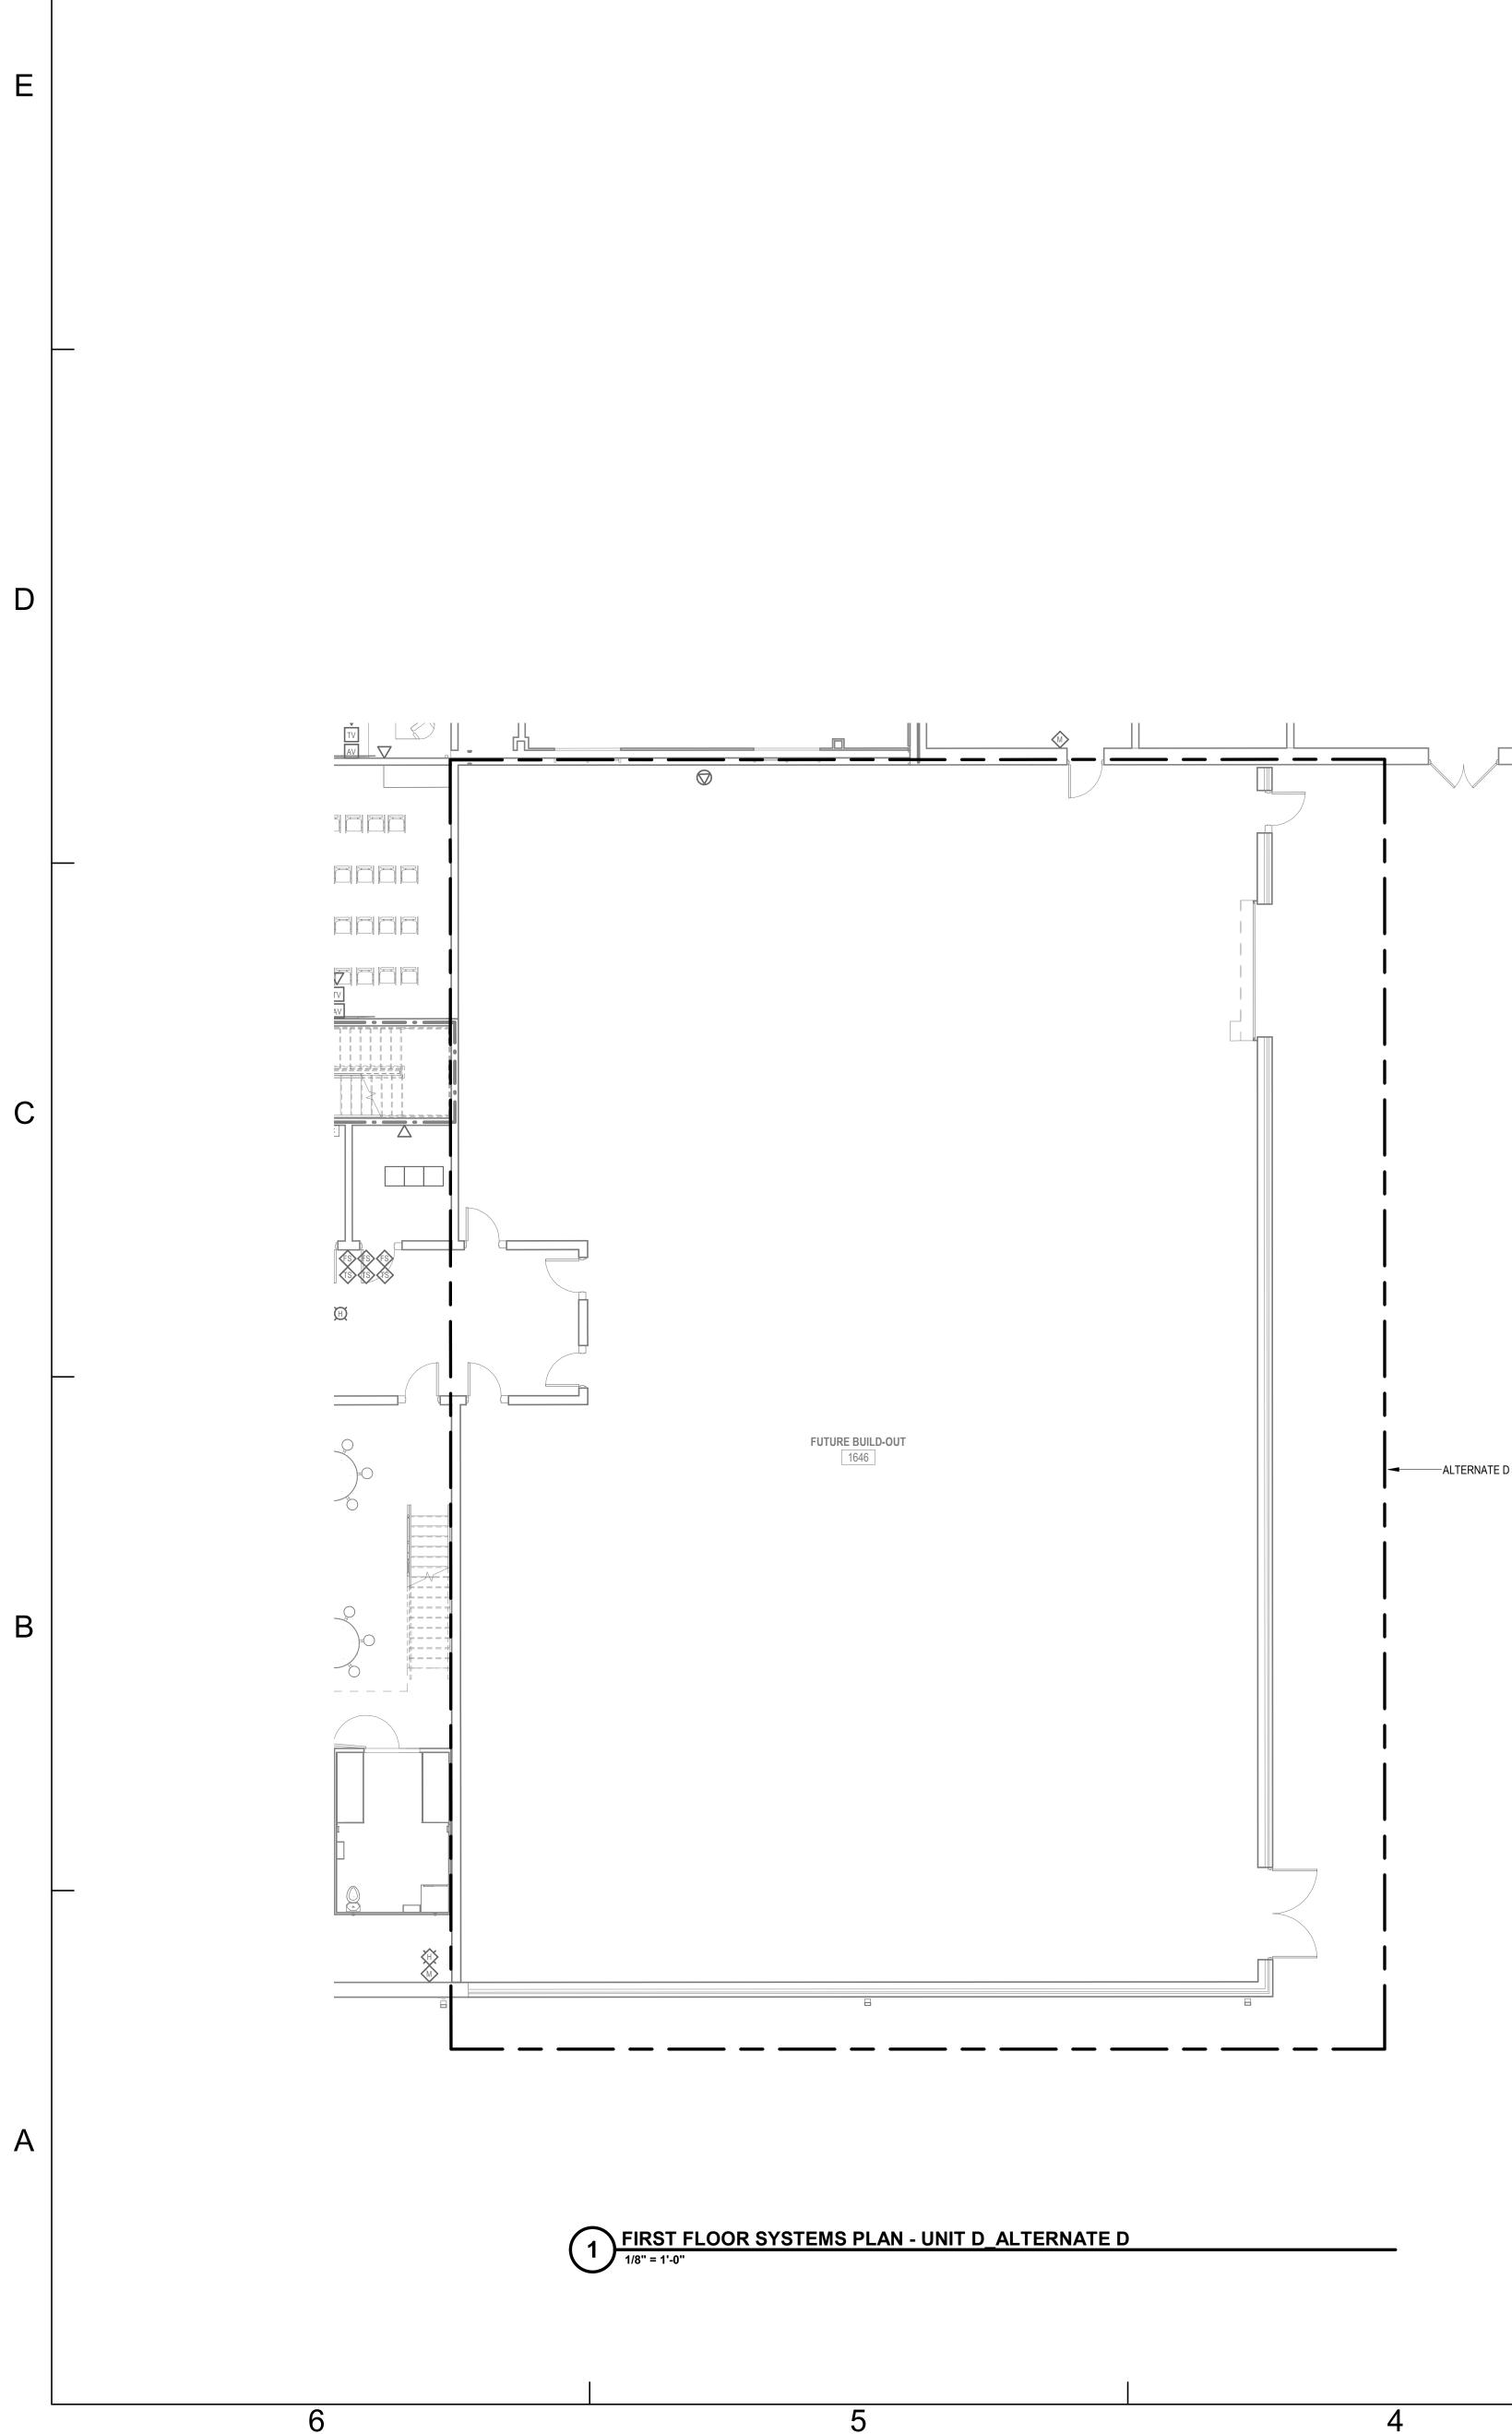

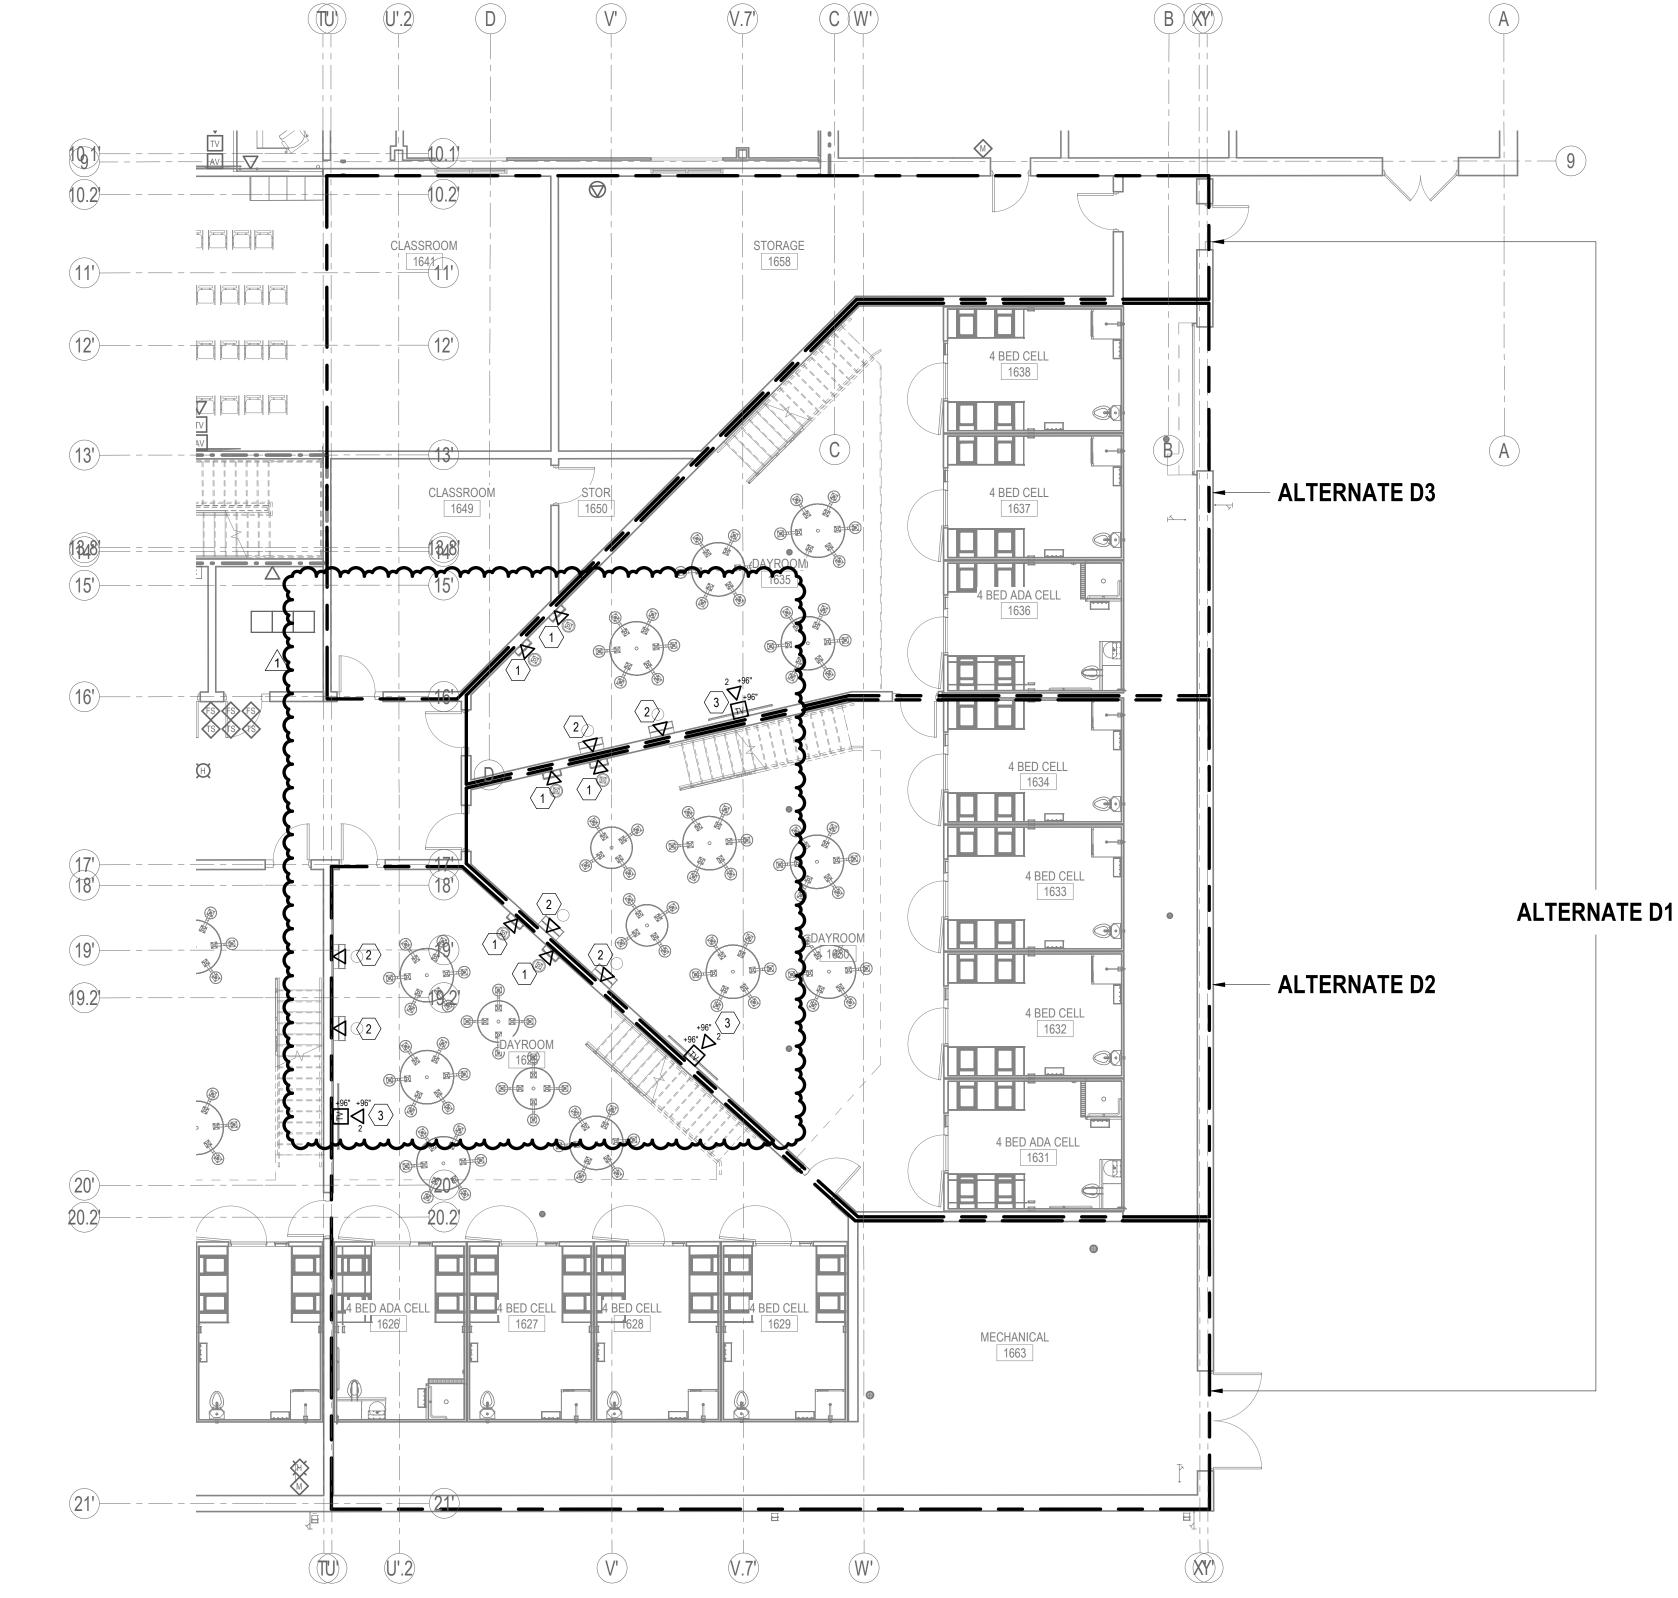

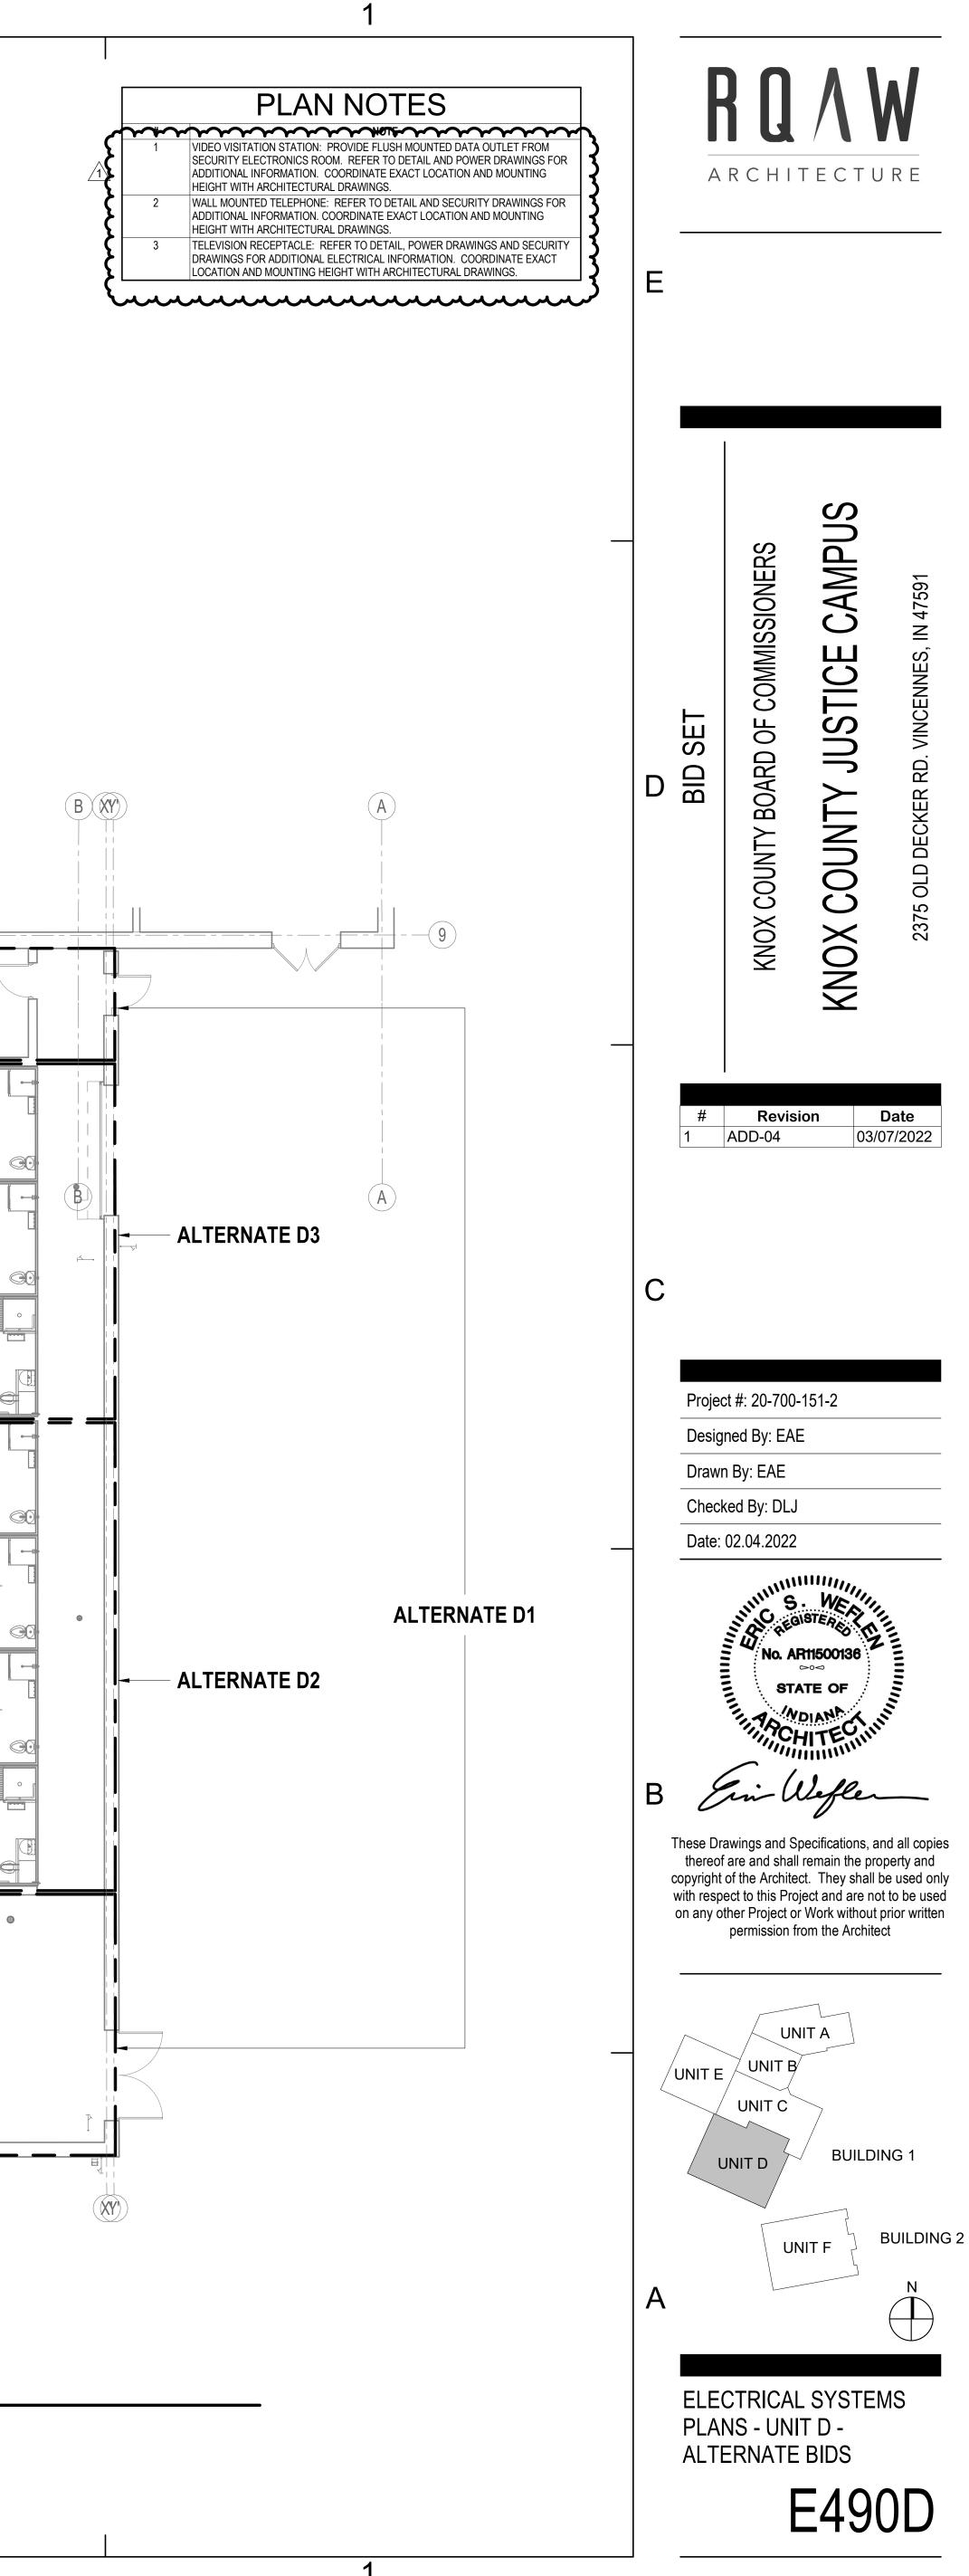

2 FIRST FLOOR SYSTEMS PLAN - UNIT D_ALTERNATES D1-D3

_	6	5	4	3
	Branch Panel: 1HEM1 Location: MECH. 1660 Supplied From: 1HEMDP1 Mounting: Surface Enclosure Type: Type 1 General Panel Comments:	Branch: EMERGENCY A.I.C. Rating: TBD Main Type: MCB Main Rating: 100A	Supplied From:1HEMDP1Phase:3A.I.C.Mounting:SurfaceWire:Main	Branch: EMERGENCY Rating: TBD - 1 in Type: MCB Rating: 100A
E	Circuit Number Circuit Description Trip Poles A B C 1 Lighting_Exterior Wall Packs 20 A 1 0.8 0.4	1 20 A Lighting_Dayroom 1614, 1615 8 1 20 A Lighting_Dayroom 1621 10 1 20 A Lighting_Control Mezz. EM 12 1 20 A SPARE 14 1 20 A SPARE 16 1 20 A SPARE 16 1 20 A SPARE 18 1 20 A SPARE 20 1 20 A SPARE 22 1 20 A SPARE 24 1 20 A SPARE 26 1 20 A SPARE 28		
		Partiel Totals 26 VA Total Conn. Load: 14726 VA Total Est. Demand: 14726 VA Total Conn. Current: 17.7 A Total Est. Demand Current: 17.7 A	Lighting 7201 VA 100.00% 7201 VA Receptacle 3740 VA 100.00% 3740 VA Tot Image: Comparison of the system Image: Comparison of the system Tot Tot Image: Comparison of the system Image: Comparison of the system Tot Tot	otal Conn. Load: 10941 VA tal Est. Demand: 10941 VA il Conn. Current: 13.2 A Demand Current: 13.2 A
D	Distribution Panel: 1HLRDP1 Location: TRAINING ROOM 1246 Voltage: 480Y/277 Supplied From: 1HEMSB1 Phase: 3 Mounting: Surface Wire: 4 Enclosure Type: Type 1 Ground EQUIPMENT GROUND Seperal Panel Comments: 1) MAIN BREAKER SHALL BE 100% RATED, INDIVIDUALLY-MOUNTED, SOLID-STATE, ELECTRONIC TRIP, WITH FIELD ADA 2) SHALL BE PROTECTED VIA REMOTE SURGE PROTECTION DEVICE (SPD) PER DIVISION 26 SECTION "SURGE PROTECTION		Supplied From:1HNDP1Phase:3A.I.C.Mounting:SurfaceWire:43Main	Branch: NORMAL Rating: TBD - 1 in Type: MCB Rating: 100A
Rating (kVA) Remarks: 3 400 - 50 - 80 - 80 - 80 - 80 - 80 - 80 -</td> <td>Circuit Number Circuit Description Trip Poles A B C Poles Trip 1 SPARE 20A 1 0 0 0 0 1 20A SPARE 3 SPARE 20A 1 0 0 0 0 1 20A SPARE 5 SPARE 20A 1 0 0 0 0 1 20A SPARE 7 SPARE 20A 1 0 0 0 0 1 20A SPARE 9 SPARE 20A 1 0 0 0 1 20A SPARE 11 SPARE 20A 1 0 0 0 1 20A SPARE 13 SPARE 20A 1 0 0 0 1 20A SPARE 17 SPARE 20A 1 0 0 0 1 20A<</td> <td>Circuit Description Circuit Number 2 4 4 6 8 10 12 14 12 14 16 18 18 0 VA</td>	Breaker Information S I G 100% Frame Trip Load S I G Rated Poles Size Rating (kVA) Remarks: 3 400 - 50 - 80 - 80 - 80 - 80 - 80 - 80 -	Circuit Number Circuit Description Trip Poles A B C Poles Trip 1 SPARE 20A 1 0 0 0 0 1 20A SPARE 3 SPARE 20A 1 0 0 0 0 1 20A SPARE 5 SPARE 20A 1 0 0 0 0 1 20A SPARE 7 SPARE 20A 1 0 0 0 0 1 20A SPARE 9 SPARE 20A 1 0 0 0 1 20A SPARE 11 SPARE 20A 1 0 0 0 1 20A SPARE 13 SPARE 20A 1 0 0 0 1 20A SPARE 17 SPARE 20A 1 0 0 0 1 20A<	Circuit Description Circuit Number 2 4 4 6 8 10 12 14 12 14 16 18 18 0 VA
		ed Demand Panel Totals 00 VA	Tota	tal Est. Demand: 0 VA Il Conn. Current: 0.0 A Demand Current: 0.0 A
	Distribution Panel: 1HNDP1 Location: ELECT. 1245 Voltage: 480Y/277 Supplied From: 1HNSB1 Phase: 3 Mounting: Surface Wire: 4 Enclosure Type: Type 1 Cround: General Panel Comments: 1) SHALL BE UL LISTED AND RATED AS SERVICE ENTRANCE EQUIPMENT. 2) MAIN BREAKER SHALL BE 100% RATED, INDIVIDUALLY MOUNTED, SOLID-STATE, ELECTRONIC-TRIP WITH FIELD ADJ	Branch: NORMAL <u>A.I.C. Rating:</u> TBD1 <u>Main Type:</u> MCB <u>Main Rating:</u> 800A	Supplied From: Phase: 3 A.I.C. Mounting: Surface Wire: 4 3 Main	Branch: NORMAL Rating: TBD - 1 in Type: MCB Rating: 3000A
B	3) SHALL BE PROTECTED VIA REMOTE SURGE PROTECTION DEVICE (SPD) PER DIVISION 26 SECTION "SURGE PROTECTION Thermal Mag Electron Circuit Adj. Harmal Mag Electron Circuit Miscellaneous Adj. L 1 Miscellaneous		Circuit Number Circuit Description Fixed Adj. Inst S G 100% Rated Poles 1 1HNDP1 - - X X X X 3 2 CH-1 - X X X X 3 3 CH-3 - X X X X 3 4 CH-2 - - X X X X 3 5 ATS - X X X X 3 3 6 ATSEM1 - X X X X 3 3 7 ATSOP1 - - - - - - - - - - - - - - - - 3 3 3 3 3 3 3 3 3 3 3 3 3 3 3 3 3 3 </td <td>1000 A 800 A 195.1 500 A 450 A 310.0 2000 A 1600 A 0.0 400 A 400 A 0.0 600 A 600 A 0.0 200 A 200 A 0.0</td>	1000 A 800 A 195.1 500 A 450 A 310.0 2000 A 1600 A 0.0 400 A 400 A 0.0 600 A 600 A 0.0 200 A 200 A 0.0
A	Miscellaneous 179400 VA 70.00% 125 Motor 1301 VA 100.00% 13 Receptacle 10580 VA 97.26% 105	ed DemandPanel Totals580 VA	Receptacle 10580 VA 97.26% 10290 VA Tc Mechanical 3782 VA 100.00% 3782 VA Total	Panel Totals Fotal Conn. Load: 1125063 VA otal Est. Demand: 1070953 VA al Conn. Current: 1353.2 A Demand Current: 1288.2 A

3


2

PLAN NOTES

 #
 NOTE

 1
 ALL ELECTRICAL EQUIPMENT SHALL BE RATED TO WITHSTAND THE AVAILABLE FAULT CURRENT FROM THE UTILITY. SERIES RATED DEVICES ARE NOT ACCEPTABLE. AVAILABLE FAULT CURRENT SHALL BE CONFIRMED WITH UTILITY AND FAULT ANALYSIS COMPLETE AS PER SPECIFICATIONS SECTION 26 05 73 PRIOR TO FINAL EQUIPMENT APPROVAL.

	ribution	Panel: 1	HEMDP1 TRAINING ROOM			Voltage:	480Y/2	77						Branc	h: ⊏™	ERGEN	CY			
		Supplied From: <u>Mounting:</u>	1HEMSB1 Surface	11210		<u>Phase:</u> Wire:	3	\sim	\sim		3		<u>A.I.C</u> <u>Ma</u>	. Rating	<u>g:</u> TBD <u>e:</u> MCE	3 -		$\langle 1 \rangle$		
eneral	Panel Commen	Enclosure Type:	Type 1			<u>Ground</u>	EQUIP	MENT	GROUN	ID BUS	3		<u>Mair</u>	n Rating	<u>g:</u> 4004	4				
MAIN E	BREAKER SHAI	<u>IIS.</u> LL BE 100% RATED ED VIA REMOTE SL											INGS.							
							Thermo	al Mari		F 1	Breake	r Inforn	nation							
ircuit umber	,		Circuit Descrip	otion			Therm	Adj.	4	S	nic Trip		100% Rated	Poles	Frame <u>Size</u>	Trip Rating	Load (kVA)		Remarks	
1 2	TLEMDP1 1HEM3								α	X	\mathfrak{X})			200 A	175 A 100 A	3.7			
3 4	1HEM1 SPARE												3	3	100 A	100 A 100 A	0.0			
5 6 7	SPARE SPACE SPACE										 		6	3 		100 A 	0.0 0.0 0.0			
	SPACE SPACE	m															0.0			
10 11	SPACE SPACE																0.0			
12	SPACE	m														 d (kVA):				
												Tot	tal Con	nected	Load (Amps):	35.3			
						1						-1								
ghting	assification			2192	27 VA 00 VA	100	d Factor .00% .00%	r	2	nated De 21927 V 7400 V/	A			Tof		Pane n. Load				
eceptac					0 VA		.00%			7400 V/	٩			Tota	l Est. D	Demand	: 2932	7 VA		
													Total	Est. De	emand (Current	: 35.3 /	A		
emarks	<u>s:</u>																			
ran	nch Pan	el: 1HN2				Volta	age: 480)Y/277						Bra	anch: N	NORMA				
		Supplied From: <u>Mounting:</u>	Surface			<u>Pha</u> <u>M</u>	ase: 3 <u>lire:</u> 4	<u> </u>	\sim	~~				.I.C. Ra <u>Main</u>	ating: ⁻ Type: I	TBD MCB	-	-(1)	\rangle	
	Panel Commen	Enclosure Type:	Туре 1			<u>Grou</u>		UIPMEI	NT GRO	DUND B	ŬS)		<u>I</u>	<u>Main Ra</u>	ating: ´	100A				
eneral I	Panel Commen	<u>ts:</u>																		
ircuit Imber		Circuit Descriptio	on			A	В		С	Р	oles T	-			Circ	uit Dese	criptior	n		Circuit Number
1 3 5	SPARE SPARE SPARE			20 A 20 A 20 A	1 0 1 1	0 0	0		D	0	1 2	0 A S 0 A S 0 A S	PARE							2 4 6
7 9	SPARE SPARE			20 A 20 A	1 0 1	0 0	0			•	1 2		PARE							8 10
11 13	SPARE SPARE			20 A 20 A	1 1 0	0			0	0	1 2	0 A S								12 14
15 17	SPARE SPARE			20 A 20 A Total L	1 1	kVA 0	0 0 0.0 kVA	(0.0 kVA	0		0 A S 0 A S								16 18
					_0.0		ad Sumr		0.0 KV/	`										
ad Cla	assification			Connec	ted Load	Demano	d Factor		Estima	ated De	mand						Totals	5		
														Total	Est. De	Load: emand: urrent:	0 VA			
																urrent:				
marks	5:																			
	ribution	Panel: 1	HOPDP1			Voltage:	1802/2	77						Branc	h. ODT	IONAL				
istı		Supplied From: <u>Mounting:</u>	1HEMSB1	W 1240		<u>Phase:</u> <u>Wire:</u>	3	····			3			. Rating	<u>n:</u> Opt <u>g:</u> TBD <u>e:</u> MCE	-	<	1		
istı		Enclosure Type:	Type 1			<u>Ground:</u>	EQUIP	MENT	GROUN		٢		<u>Mair</u>	n Rating	<u>g:</u> 6004	4				
	Panel Common	to											INGS.							
neral I MAIN E		<u>its:</u> LL BE 100% RATED ED VIA REMOTE SL									Breake	r Inforn	nation							
neral I MAIN E	BREAKER SHAI	LL BE 100% RATED					The			Electro	nic Trip		100%	Poles		Trip	Load (kVA)		Remarks	:
neral I MAIN E SHALL ircuit	BREAKER SHAI	LL BE 100% RATED		tion			Therm	Adj.	L	S			Rated			The second se		,		
ineral I MAIN E SHALL ircuit imber 1 2	BREAKER SHAL L BE PROTECTI T:LOPDP1 AHU-A1	LL BE 100% RATED	Circuit Descrip	<u>ition</u>			Therm Fixed	Adj.	X	∽ ∽∽	Š		Rated	3 3	100 A	175 A 25 A	16.1			
neral I MAIN E SHALL ircuit imber 1 2 3 4	BREAKER SHAL L BE PROTECTI T:LOPDP1 AHU-A1 B-3 B-2	LL BE 100% RATED		vtion				Adj. Inst	×	∽ ∽∽	3		Rated	3 3 3	100 A 20 A 20 A	175 A 25 A 20 A 20 A	16.1 10.0 10.0			
ircuit mber 1 2 3 4 5 6	BREAKER SHAL L BE PROTECTI T:LOPDP1 AHU-A1 B-3 B-2 B-1 HWP-1	LL BE 100% RATED		<u>)tion</u>				Adj. Inst	×		$\dot{\mathbf{x}}$		Rated	3 3 3 3 3	100 A 20 A 20 A 20 A 50 A	175 A 25 A 20 A 20 A 20 A 20 A 40 A	16.1 10.0 10.0 10.0 12.5			
ircuit Imber 1 2 3 4 5 6 7 8	BREAKER SHAL BE PROTECTI T:LOPDP1 AHU-A1 B-3 B-2 B-1 HWP-1 HWP-2 HWP-3	LL BE 100% RATED)tion				Adj. Inst			3		Rated	3 3 3 3 3 3 3 3	100 A 20 A 20 A 20 A 50 A 50 A 50 A	175 A 25 A 20 A 20 A 20 A 40 A 40 A 40 A	16.110.010.010.012.512.512.5			
neral I MAIN E SHALL ircuit imber 1 2 3 4 5 6 7 8 9	BREAKER SHAL BE PROTECTI T:LOPDP1 AHU-A1 B-3 B-2 B-1 HWP-1 HWP-2	LL BE 100% RATED)tion				Adj. Inst						3 3 3 3 3 3 3 3 3 3	100 A 20 A 20 A 50 A 50 A 50 A 100 A	175 A 25 A 20 A 20 A 20 A 20 A 40 A 40 A	16.1 10.0 10.0 12.5 12.5 12.5 45.7 28.1			
neral I MAIN E SHALL incuit mber 1 2 3 4 5 6 7 8 9 10 11 12	BREAKER SHAL BE PROTECTI T:LOPDP1 AHU-A1 B-3 B-2 B-1 HWP-1 HWP-2 HWP-3 DOAS-D1 DOAS-D2	LL BE 100% RATED		>tion				Adj. Inst			 			3 3 3 3 3 3 3 3 3 3	100 A 20 A 20 A 50 A 50 A 50 A 100 A	175 A 25 A 20 A 20 A 20 A 40 A 40 A 40 A 40 A 40 A	16.1 10.0 10.0 12.5 12.5 12.5 45.7 28.1			
neral I MAIN E SHALL ircuit imber 1 2 3 4 5 6 7 8 9 10 11	BREAKER SHAL BE PROTECTI T:LOPDP1 AHU-A1 B-3 B-2 B-1 HWP-1 HWP-2 HWP-3 DOAS-D1 DOAS-D1 DOAS-D2 T:1LOP3 SPARE	LL BE 100% RATED		>tion			Fixed	Adj. Inst				G		3 3 3 3 3 3 3 3 3 3 3 3 3 3 3 3 3 3 3	100 A 20 A 20 A 50 A 50 A 50 A 100 A 200 A	175 A 25 A 20 A 20 A 20 A 40 A 40 A 40 A 40 A 40 A 125 A 20 A	16.1 10.0 10.0 12.5 12.5 12.5 45.7 8.1 45.7 8.1 40.0			
eneral I MAIN E SHALL ircuit imber 1 2 3 4 5 6 7 8 9 10 11 12 13 14	BREAKER SHAL BE PROTECTI T:LOPDP1 AHU-A1 B-3 B-2 B-1 HWP-1 HWP-2 HWP-3 DOAS-D1 DOAS-D1 DOAS-D2 T:1LOP3 SPARE SPARE SPACE	LL BE 100% RATED		>tion			Fixed	Adj. Inst 3	 			G 		3 3 3 3 3 3 3 3 3 3 3 3 3 3 3 3 3 3 3	100 A 20 A 20 A 50 A 50 A 50 A 100 A 200 A 	175 A 25 A 20 A 20 A 20 A 40 A 40 A 40 A 60 A 125 A 20 A 20 A 	16.1 10.0 10.0 12.5 12.5 12.5 45.7 8.1 1.0 0.0 0.0			
eneral I MAIN E SHALL ircuit imber 1 2 3 4 5 6 7 8 9 10 11 12 13 11 12 13 14 15 16	BREAKER SHAL BE PROTECTI T:LOPDP1 AHU-A1 B-3 B-2 B-1 HWP-1 HWP-2 HWP-3 DOAS-D1 DOAS-D1 DOAS-D2 T:1LOP3 SPARE SPARE SPACE SPACE SPACE	LL BE 100% RATED		>tion			Fixed	Adj. Inst 3		 	 	G 		3 3 3 3 3 3 3 3 3 3 3 3 3 3 3 3 3 3 3	100 A 20 A 20 A 50 A 50 A 50 A 100 A 200 A 	175 A 25 A 20 A 20 A 20 A 40 A 40 A 40 A 40 A 40 A 125 A 20 A 	16.1 10.0 10.0 12.5 12.5 12.5 12.5 45.7 8.1 1.0 0.0 0.0 0.0 0.0 0.0 0.0 0.0 0.0 0.0 0.0 0.0 0.0 0.0 0.0			
neral I MAIN E SHALL ircuit imber 1 2 3 4 5 6 7 8 9 10 11 12 13 14 15 16 17	BREAKER SHAL BE PROTECTI T:LOPDP1 AHU-A1 B-3 B-2 B-1 HWP-1 HWP-2 HWP-3 DOAS-D1 DOAS-D1 DOAS-D2 T:1LOP3 SPARE SPARE SPACE SPACE SPACE SPACE	LL BE 100% RATED		>>tion			Fixed	Adj. Inst 3		 	 	G 	 	3 3 3 3 3 3 3 3 3 3 3 3 3 3 3 3 3 3 3	100 A 20 A 20 A 50 A 50 A 50 A 100 A 200 A 	175 A 25 A 20 A 20 A 20 A 40 A 40 A 40 A 40 A 40 A 40 A 20 A 20 A 	16.1 10.0 10.0 12.5 12.5 12.5 12.5 45.7 8.1 1.0 0.0			
eneral I MAIN E SHALL SHALL 1 2 3 4 5 6 7 8 9 10 11 12 13 14 13 14 15 16 17	BREAKER SHAL BE PROTECTI T:LOPDP1 AHU-A1 B-3 B-2 B-1 HWP-1 HWP-2 HWP-3 DOAS-D1 DOAS-D1 DOAS-D2 T:1LOP3 SPARE SPARE SPACE SPACE SPACE SPACE	LL BE 100% RATED		>>tion			Fixed	Adj. Inst 3		 	 	G 	 	3 3 3 3 3 3 3 3 3 3 3 3 3 3 3 3 3 3 3	100 A 20 A 20 A 50 A 50 A 50 A 100 A 200 A 	175 A 25 A 20 A 20 A 20 A 20 A 40 A 40 A 40 A 40 A 40 A 125 A 20 A 20 A 	16.1 10.0 10.0 12.5 12.5 12.5 12.5 45.7 8.1 1.0 0.0			
eneral I MAIN E SHALL SHALL 1 2 3 4 5 6 7 8 9 10 11 12 13 14 15 16 17 18	BREAKER SHAL BE PROTECTI T:LOPDP1 AHU-A1 B-3 B-2 B-1 HWP-1 HWP-2 HWP-3 DOAS-D1 DOAS-D1 DOAS-D2 T:1LOP3 SPARE SPARE SPACE SPACE SPACE SPACE	LL BE 100% RATED		Connec	rted Load		Fixed	Adj. Inst 3	 	 	 	G 	 	3 3 3 3 3 3 3 3 3 3 3 3 3 3 3 3 3 3 3	100 A 20 A 20 A 50 A 50 A 50 A 100 A 200 A 	175 A 25 A 20 A 20 A 20 A 40 A 40 A 40 A 40 A 40 A 125 A 20 A 	16.1 10.0 10.0 12.5 12.5 12.5 12.5 45.7 8.1 1.0 0.0			
neral I MAIN E SHALL ircuit imber 1 2 3 4 5 6 7 8 9 10 11 12 13 14 15 16 17 11 12 13 14 15 16 17 17 18 4 5 6 7 8 9 10 11 12 13 14 15 16 17 17 18	BREAKER SHAL BE PROTECTION T:LOPDP1 AHU-A1 B-3 B-2 B-1 HWP-1 HWP-2 HWP-3 DOAS-D1 DOAS-D1 DOAS-D2 T:1LOP3 SPARE SPARE SPARE SPACE SPACE SPACE SPACE SPACE SPACE SPACE SPACE	LL BE 100% RATED		Connec	21 VA 2 VA 50 VA	100 100 70.	Fixed	Adj. Inst 3	 	 16121 V 62 VA 50295 V	 emand A	G 	 	3 3 3 3 3 3 3 3 3 3 3 3 3 3 3 3 3 3 3	100 A 20 A 20 A 50 A 50 A 50 A 100 A 100 A 200 A 200 A -	175 A 25 A 20 A 20 A 20 A 40 A 40 A 40 A 40 A 40 A 40 A 20 A 20 A 20 A 20 A 20 A 20 A 20 A 2	16.1 10.0 10.0 10.0 12.5 12.5 12.5 12.5 45.7 8.1 1.00 0.0 1 1 1 1 1 1 1 </td <td>s 92 VA 07 VA</td> <td></td> <td></td>	s 92 VA 07 VA		
neral I MAIN E SHALL ircuit imber 1 2 3 4 5 6 7 8 9 10 11 12 13 14 15 16 17 13 14 15 16 17 18	BREAKER SHAL BE PROTECTION T:LOPDP1 AHU-A1 B-3 B-2 B-1 HWP-1 HWP-2 HWP-3 DOAS-D1 DOAS-D1 DOAS-D2 T:1LOP3 SPARE SPARE SPACE SPACE SPACE SPACE SPACE SPACE SPACE SPACE SPACE SPACE SPACE SPACE SPACE SPACE SPACE	LL BE 100% RATED		Connec 1612 62 7188 470 7378	21 VA 2 VA	100 100 70. 100 100	Fixed	Adj. Inst 3		 16121 V 62 VA	 emand A A A A A	G 	 tal Con	3 3 3 3 3 3 3 3 3 3 3 3 3 3 3 3 3 3 3	100 A 20 A 20 A 50 A 50 A 50 A 100 A 200 A 700 A 200 A -	175 A 25 A 20 A 20 A 20 A 40 A 40 A 40 A 40 A 125 A 20 A t (kVA): Amps): Pane Pane	16.1 10.0 10.0 10.0 12.5 12.5 12.5 12.5 12.5 12.5 12.5 12.5 12.5 12.5 12.5 12.5 45.7 8.1 1.00 0.0 1 1 1 0.0 0.0 0.0	s 92 VA 07 VA 3 A		

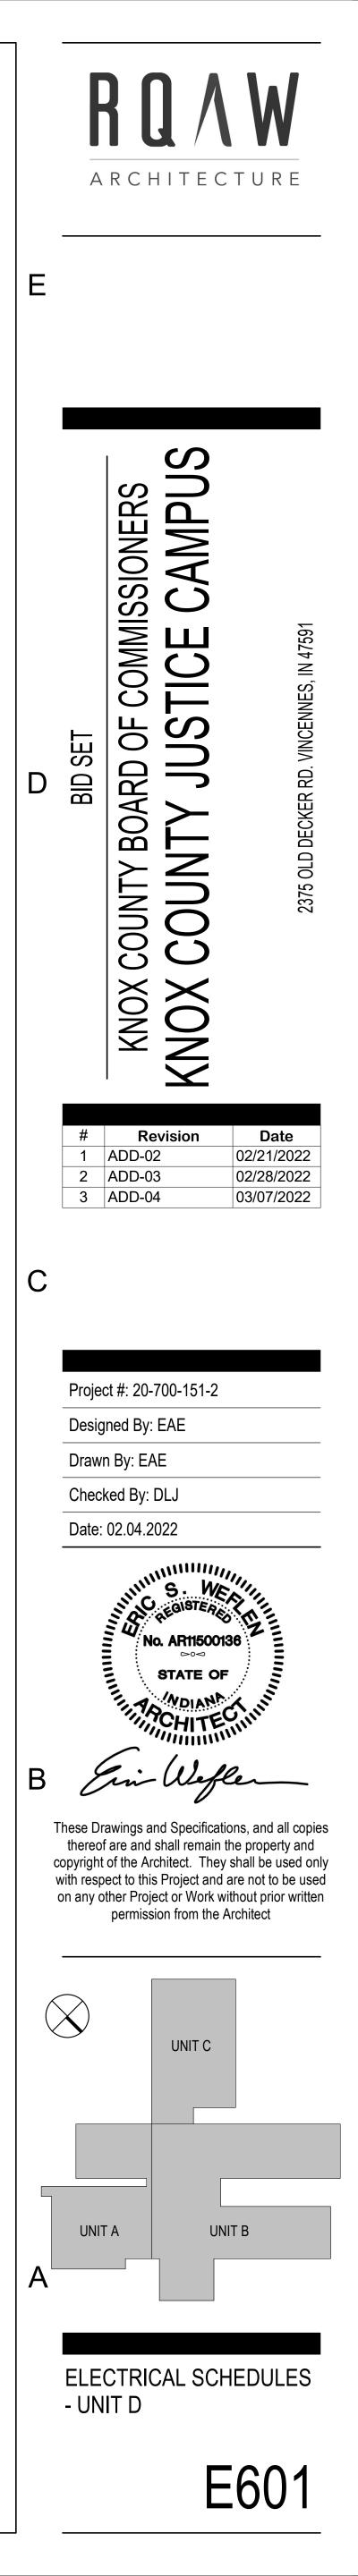

		6				5	
		Branch Panel: 1LEM1 Location: MECH. 1660 Supplied From: 1LEMDP1 Mounting: Surface Enclosure Type: Type 1 General Panel Comments:		<u>Voltage:</u> 208Y/120 <u>Phase:</u> 3 <u>Wire:</u> 4 <u>Ground</u> EQUIPM		Branch: EMERGENCY A.I.C. Rating: TBD → Main Type: MCB Main Rating: 100A	
E		Circuit Circuit Description 1 SPARE 3 SPARE 5 SPARE 7 SPARE 9 SPARE 11 SPARE 13 SPARE 15 SPARE 17 SPARE	Trin Poles A 20 A 1 0 0	0 0.5 0 0 0 0 0 0	0 0 1 20 1 20 1 20 0 0 1 20 0 0 1 20 1 20 1 20 0 0 1 20 1 20 1 20 1 20 1 20	A SPARE A NAC Panel IT 2603 A SPARE A SPARE A SPARE A SPARE A SPARE	Circuit Number 4 6 8 10 12 14 16 18
		Load Classification Receptacle	Total Load: 0.0 kVA Connected Load 500 VA	0.5 kVA Load Summary: Demand Factor 100.00%	0.0 kVA Estimated Demand 500 VA	Panel Totals Total Conn. Load: 500 VA Total Est. Demand: 500 VA	
		Remarks:				Total Conn. Current: 1.4 A Total Est. Demand Current: 1.4 A	
D		Distribution Panel: 1LEMDP1 Location: TRAINING ROC Supplied From: TLEMDP1 Mounting: Surface Enclosure Type: Type 1 General Panel Comments: 1 MAIN DEFATED CIMENT DE 100% DATED, INDUSTRIAL	DM 1246	Voltage: 208Y/120 <u>Phase:</u> 3 <u>Wire:</u> 4 <u>Grounds</u> EQUIPMEN	مربريرير	Branch: EMERGENCY A.I.C. Rating: TBD - 1 Main Type: MCB Main Rating: 400A	
	2	1) MAIN BREAKER SHALL BE 100% RATED, INDIVIDUALLY 2) SHALL BE PROTECTED VIA REMOTE SURGE PROTECT Circuit Number Circuit Descri 1 1LEM1 Circuit Descri 3 2LEM1 Circuit SPACE 6 SPACE 7 SPACE	TON DEVICE (SPD) PER DIVISIO		GE PROTECTION DEVICE Breaker I g Electronic Trip .	S." Information G Rated Poles Size Rating (kVA) Remark 3 100 A 100 A 0.5 3 100 A 100 A 0.0 3 100 A 100 A 3.2 	(S:
		8 SPACE 9 SPACE 10 SPACE		 	<td> 0.0 0.0 0.0 0.0 Total Connected Load (kVA): 3.7 3.7 Total Connected Load (Amps): 10.2</td> <td></td>	0.0 0.0 0.0 0.0 Total Connected Load (kVA): 3.7 3.7 Total Connected Load (Amps): 10.2	
С		Load Classification Receptacle Remarks:	Connected Load 3660 VA	Demand Factor 100.00%	Estimated Demand 3660 VA	Panel Totals Total Conn. Load: 3660 VA Total Est. Demand: 3660 VA Total Conn. Current: 10.2 A Total Est. Demand Current: 10.2 A	
		Branch Panel: 1LN1 Location: MECH. 1660 Supplied From: 1LNDP1 Mounting: Surface Enclosure Type: Type 1 General Panel Comments:		Voltage: 208Y/120 Phase: 3 Wire: 4 Ground EQUIPM	D ENT GROUND BUS	Branch: NORMAL A.I.C. Rating: TBD - Main Type: MCB Main Rating: 100A	
В		Circuit NumberCircuit Description1Receptacle_16443Receptacle_16035Receptacle_2601, 2604, 26057Receptacle DETENTION CORRIDOR 16019SPARE11SPARE13SPARE15SPARE17SPARE	Trip Poles A 20 A 1 1.4 1.4 20 A 1 1.4 1.4 20 A 1 1.4 1.4 20 A 1 0.5 1.4 20 A 1 0 0 20 A 1 4 4	0.9 0.2 2 0 0	1 20 0.5 0.5 1 20 0 1 20 1 20 0 0 1 20 1 20 0 0 1 20 1 20 0 0 1 20 1 20 1 20 1 20 1 20	A Receptacle_1607, 1641 A Receptacle_1661 A Receptacle A Overhead Door	Circuit Number 2 4 6 8 10 12 14 16 18
		Load Classification Motor Receptacle Remarks:	Connected Load 1176 VA 5540 VA	Load Summary: Demand Factor 100.00% 100.00%	Estimated Demand 1176 VA 5540 VA	Panel Totals Total Conn. Load: 6716 VA Total Est. Demand: 6716 VA Total Conn. Current: 18.6 A Total Est. Demand Current: 18.6 A	
A							

General Panel Comm	nel: 1LEM2 <u>Location:</u> <u>Supplied From:</u> 1LEMDP1 <u>Mounting:</u> Surface <u>Enclosure Type:</u> Type 1 <u>tents:</u>					<u>Voltage</u> <u>Phase</u> <u>Wire</u> <u>Ground</u>	: 3 : 4	~~	GROUNI	BUS		<u>Branch:</u> EMERG <u>A.I.C. Rating:</u> TBD → <u>Main Type:</u> MCB <u>Main Rating:</u> 100A		
Circuit Number	Circuit Description	Trip	Poles		A		3		с	Poles	Trip	Circuit Desc	cription	Circu Numb
1 SPARE		20 A	1	0	0					1		SPARE		2
3 SPARE		20 A	1			0	0			1		SPARE		4
5 SPARE		20 A	1					0	0	1		SPARE		6
7 SPARE		20 A	1	0	0					1		SPARE		8
9 SPARE		20 A	1			0	0			1		SPARE		1
11 SPARE		20 A	1					0	0	1		SPARE		12
13 SPARE		20 A	1	0	0					1		SPARE		14
15 SPARE		20 A	1			0	0			1		SPARE		16
17 SPARE		20 A	1 al Load:		kVA		kVA	0	0 kVA	1	20 A	SPARE		18
oad Classification		Conn	ected Lo	ad	De	Load S mand Fa	Summar actor	-	stimated	Demand		Panel	Totals	
												Total Conn. Load:	0.\/A	
												Total Est. Demand:		
								-				Total Conn. Current:		
												Total Est. Demand Current:		

eneral Pane	<u>Supplied From:</u> 1LLRDP1 <u>Mounting:</u> Surface <u>Enclosure Type:</u> Type 1 <u>el Comments:</u>					<u>Voltage</u> <u>Phase</u> <u>Wire</u> <u>Ground</u>	: 3 :4	PMENT (GROUNI	2 BUS)	<u>Branch:</u> LEGALL <u>A.I.C. Rating:</u> TBD → <u>Main Type:</u> MCB <u>Main Rating:</u> 100A		
Circuit lumber	Circuit Description	Trip	Poloc				3		C	Poloc	Trip	Circuit Desc	rintian	Circui
	ARE	20 A	Poles	0	A 0		>			Poles	Trip	SPARE	ription	2
	ARE	20 A 20 A	1	U	0	0	0			1	20 A	SPARE		4
	ARE	20 A	1			0	0	0	0	1	20 A	SPARE		6
	ARE	20 A	1	0	0			5		1		SPARE		8
	ARE	20 A	1	5	5	0	0			1	20 A	SPARE		10
	ARE	20 A	1				•	0	0	1	20 A	SPARE		12
	ARE	20 A	1	0	0			-		1	20 A	SPARE		14
	ARE	20 A	1	•		0	0			1		SPARE		16
	ARE	20 A	1				-	0	0	1		SPARE		18
			al Load:	0.0	kVA	0.0	kVA	0.0	kVA			1		
						Load	Summar	y:						
oad Classifi	ication	Conn	ected Lo	ad	De	mand Fa	actor	Es	timated	Demand		Panel	Totals	
												Total Conn. Load:		
												Total Est. Demand:		
												Total Conn. Current:		
								_				Total Est. Demand Current:	0.0 A	
emarks:														


General Panel Com	Location: Supplied From: 1LNDP1 <u>Mounting:</u> Surface Enclosure Type: Type 1 ments:					<u>Voltage</u> <u>Phase</u> <u>Wire</u> <u>Ground</u>	: 3 : 4	~~	GROUNI	DBUS)	Branch: NORMA A.I.C. Rating: TBD → Main Type: MCB Main Rating: 100A		
Circuit Number	Circuit Description	Trip	Poles				3			Poles	Trip	Circuit Des	rintion	Circu Numb
1 Receptacle	-	20 A	1	0.9	0	-	, 			1	20 A	SPARE		2
3 Receptacle		20 A	1	0.0		0.4	0			1	20 A	SPARE		4
5 SPARE	•	20 A	1			0.1	, ,	0	0	1	20 A	SPARE		6
7 SPARE		20 A	1	0	0			-		1	20 A	SPARE		8
9 SPARE		20 A	1			0	0			1	20 A	SPARE		10
11 SPARE		20 A	1					0	0	1	20 A	SPARE		12
13 SPARE		20 A	1	0	0					1	20 A	SPARE		14
15 SPARE		20 A	1			0	0			1	20 A	SPARE		16
17 SPARE		20 A	1					0	0	1	20 A	SPARE		18
		Tota	I Load:	0.9	kVA	0.4	kVA	0.0	kVA					
						Load S	Summar	y:						
Load Classification			ected Lo	bad	De	emand Fa		Es		Demand	1	Panel	Totals	
Receptacle		1	260 VA			100.00%	6		1260	VA				
												Total Conn. Load:		
												Total Est. Demand:		
												Total Conn. Current:		
												Total Est. Demand Current:	3.5 A	
Remarks:														


PLAN NOTES

 #
 NOTE

 1
 ALL ELECTRICAL EQUIPMENT SHALL BE RATED TO WITHSTAND THE AVAILABLE FAULT CURRENT FROM THE UTILITY. SERIES RATED DEVICES ARE NOT ACCEPTABLE. AVAILABLE FAULT CURRENT SHALL BE CONFIRMED WITH UTILITY AND FAULT ANALYSIS COMPLETE AS PER SPECIFICATIONS SECTION 26 05 73 PRIOR TO FINAL EQUIPMENT APPROVAL.

1 611	ICH Panel: 1LEM3 <u>Location:</u> PROPERTY STC <u>Supplied From:</u> T:1LEM3 <u>Mounting:</u> Surface <u>Enclosure Type:</u> Type 1	RAGE 1125	<u>Pi</u>	tage: 208Y/ nase: 3 Wire: 4 pund EQUIF	120 PMENT GROU	ND BUS)	Branch: EMERGENCY A.I.C. Rating: TBD- Main Type: MCB Main Rating: 100A	
neral I	Panel Comments:			-					
Circuit	Ι				1			Ι	Circuit
umber 1	Circuit Description Receptacle_1514	Trip Poles 20 A 1 0.7	A 0.7	В	С	Poles	Trip 20 A	Circuit Description Receptacle_1514	Numbe 2
3	NAC Panel Prop. Storage 1125	20 A 1		0.5 0.4	07 05	1	20 A	Receptacle EXAM 1128A	4
5 7	Receptacle NURSE OFFICE 1120 Receptacle PROPERTY STORAGE 1125	20 A 1 20 A 1 0.2	0		0.7 0.5	1	20 A	Receptacle Room 1128B, 1130 SPARE	6 8
9 11	SPARE SPARE	20 A 1 20 A 1		0 0	0 0	1	20 A 20 A	SPARE SPARE	10 12
13	SPARE	20 A 1 0	0	0 0		1	20 A	SPARE	14
15 17	SPARE SPARE	20 A 1 20 A 1		0 0	0 0	1		SPARE SPARE	16 18
		Total Load: 1.6	kVA	0.9 kVA	1.3 kVA				
	ssification	Connected Load		oad Summar	-	ed Demand		Panel Totals	
eceptac		3740 VA		0.00%		40 VA	1		
								Total Conn. Load: 3740 VA Total Est. Demand: 3740 VA	
								Total Conn. Current: 10.4 A Total Est. Demand Current: 10.4 A	
emarks	:								
istr	ribution Panel: 1LLRDP1 <u>Location:</u> TRAINING ROOM <u>Supplied From:</u> T:LLRDP1 <u>Mounting:</u> <u>Enclosure Type:</u>	И 1246	Phase Wire		INT GROUND	2 BUS		Branch: LEGALLY REQUIRED <u>A.I.C. Rating:</u> TBD - 1 <u>Main Type:</u> MCB <u>Main Rating:</u> 200A	
<u>eneral f</u>	Panel Comments:			• -					
						Brea	iker Info	ormation	
irouit				Thermal I	-	ectronic Tı	rip	100% Eromo Trin Lood	
ircuit umber	Circuit Descrip	tion			idj. 1st L	S I	G	100% Frame Trip Load Rated Poles Size Rating (kVA) Remarks	:
2	LIFT STATION				- Cun		} 2\	3 100 A 100 A 0.0	
بل	SPARE SPACE							<u>2</u> 3 2000 0.0	
4 5	SPACE					 		0.0 0.0	
6 7	SPACE SPACE							0.0 0.0	
8	SPACE							0.0	
9 10	SPACE SPACE							0.0 0.0	
							•	Total Connected Load (kVA):8.0Total Connected Load (Amps):22.2	
oad Cla	ssification	Connected Load 8000 VA		nd Factor 0.00%		ed Deman	d	Panel Totals	
Jooptad				0.0070				Total Conn. Load: 8000 VA	
								Total Est. Demand: 8000 VA Total Conn. Current: 22.2 A	
								Total Est. Demand Current: 22.2 A	
emarks	<u>i</u>								
	ICh Panel: 1LN3 Location: PROPERTY STO Supplied From: T:1LN3 Mounting: Surface Enclosure Type: Type 1 Panel Comments:	RAGE 1125	<u>Pi</u>	tage: 208Y/ nase: 3 Wire: 4 pund EQUIF	\sim	ND BUS)	Branch: NORMAL A.I.C. Rating: TBD Main Type: MCB Main Rating: 200A	
Circuit umber 1 3	Circuit Description Receptacle_1515, 1517 Receptacle_1501	Trip Poles 20 A 1 0.4 20 A 1 1	A 0.2	B	C	Poles 1 1		Circuit Description Receptacle_1532 Receptacle_1501, 1502, 1503	Circu Numb 2 4
5 5	Receptacle_1501, 1502	20 A 1		.9 1.1	1.1 0.3		20 A	GUH-A1	6
7 9	GUH-A2	15 A 1 0.3	1	0.8 0.3		1		BF-1_4	8 10
11 13	EF-A-2 A-HWRP-1	15 A 2 15 A 1 0.1	3.1		0.8 0.3			EF-A-3	12 14
15	Receptacle Room 1127, 1120	20 A 1).2 3.1		2		ACCU-A1	16
17 19	SPARE SPARE	20 A 1 20 A 1 0	0		0 0	1		SPARE SPARE	18 20
21	SPARE	20 A 1		0 0	0 0	1		SPARE	22 24
23 25	SPARE SPARE	20 A 1 0	0		0 0	1	20 A	SPARE SPARE	26
27 29	SPARE SPARE	20 A 1 20 A 1		0 0	0 0	1		SPARE SPARE	28 30
-			kVA	6.4 kVA	2.5 kVA				
ad Cl-	ssification	Connected Load		oad Sumamr nd Factor	-	ed Demand		Danal Tatala	
cellan	ssification eous	6240 VA	70	.00%	43	68 VA	1	Panel Totals	
otor	le	125 VA 3780 VA		0.00% 0.00%		5 VA 30 VA		Total Conn. Load: 13927 VA Total Est. Demand: 12055 VA	
eceptac echanic		3782 VA		0.00%		32 VA		Total Conn. Current: 38.7 A	

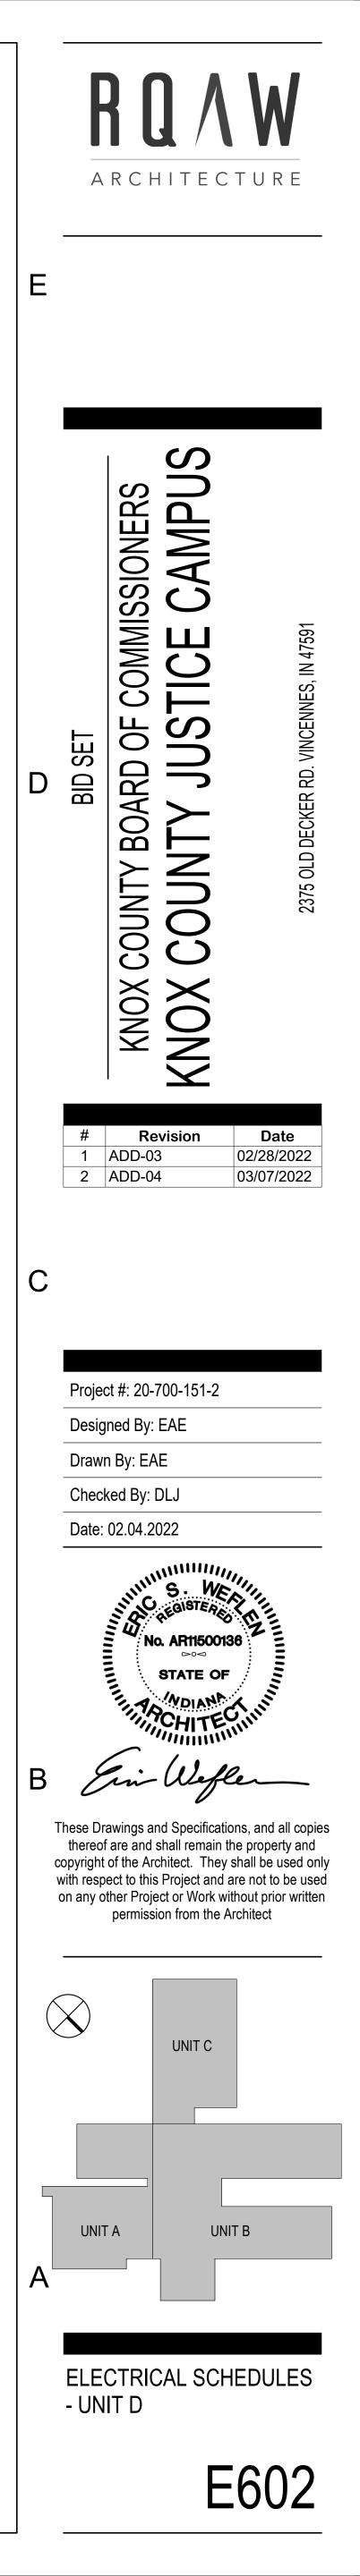

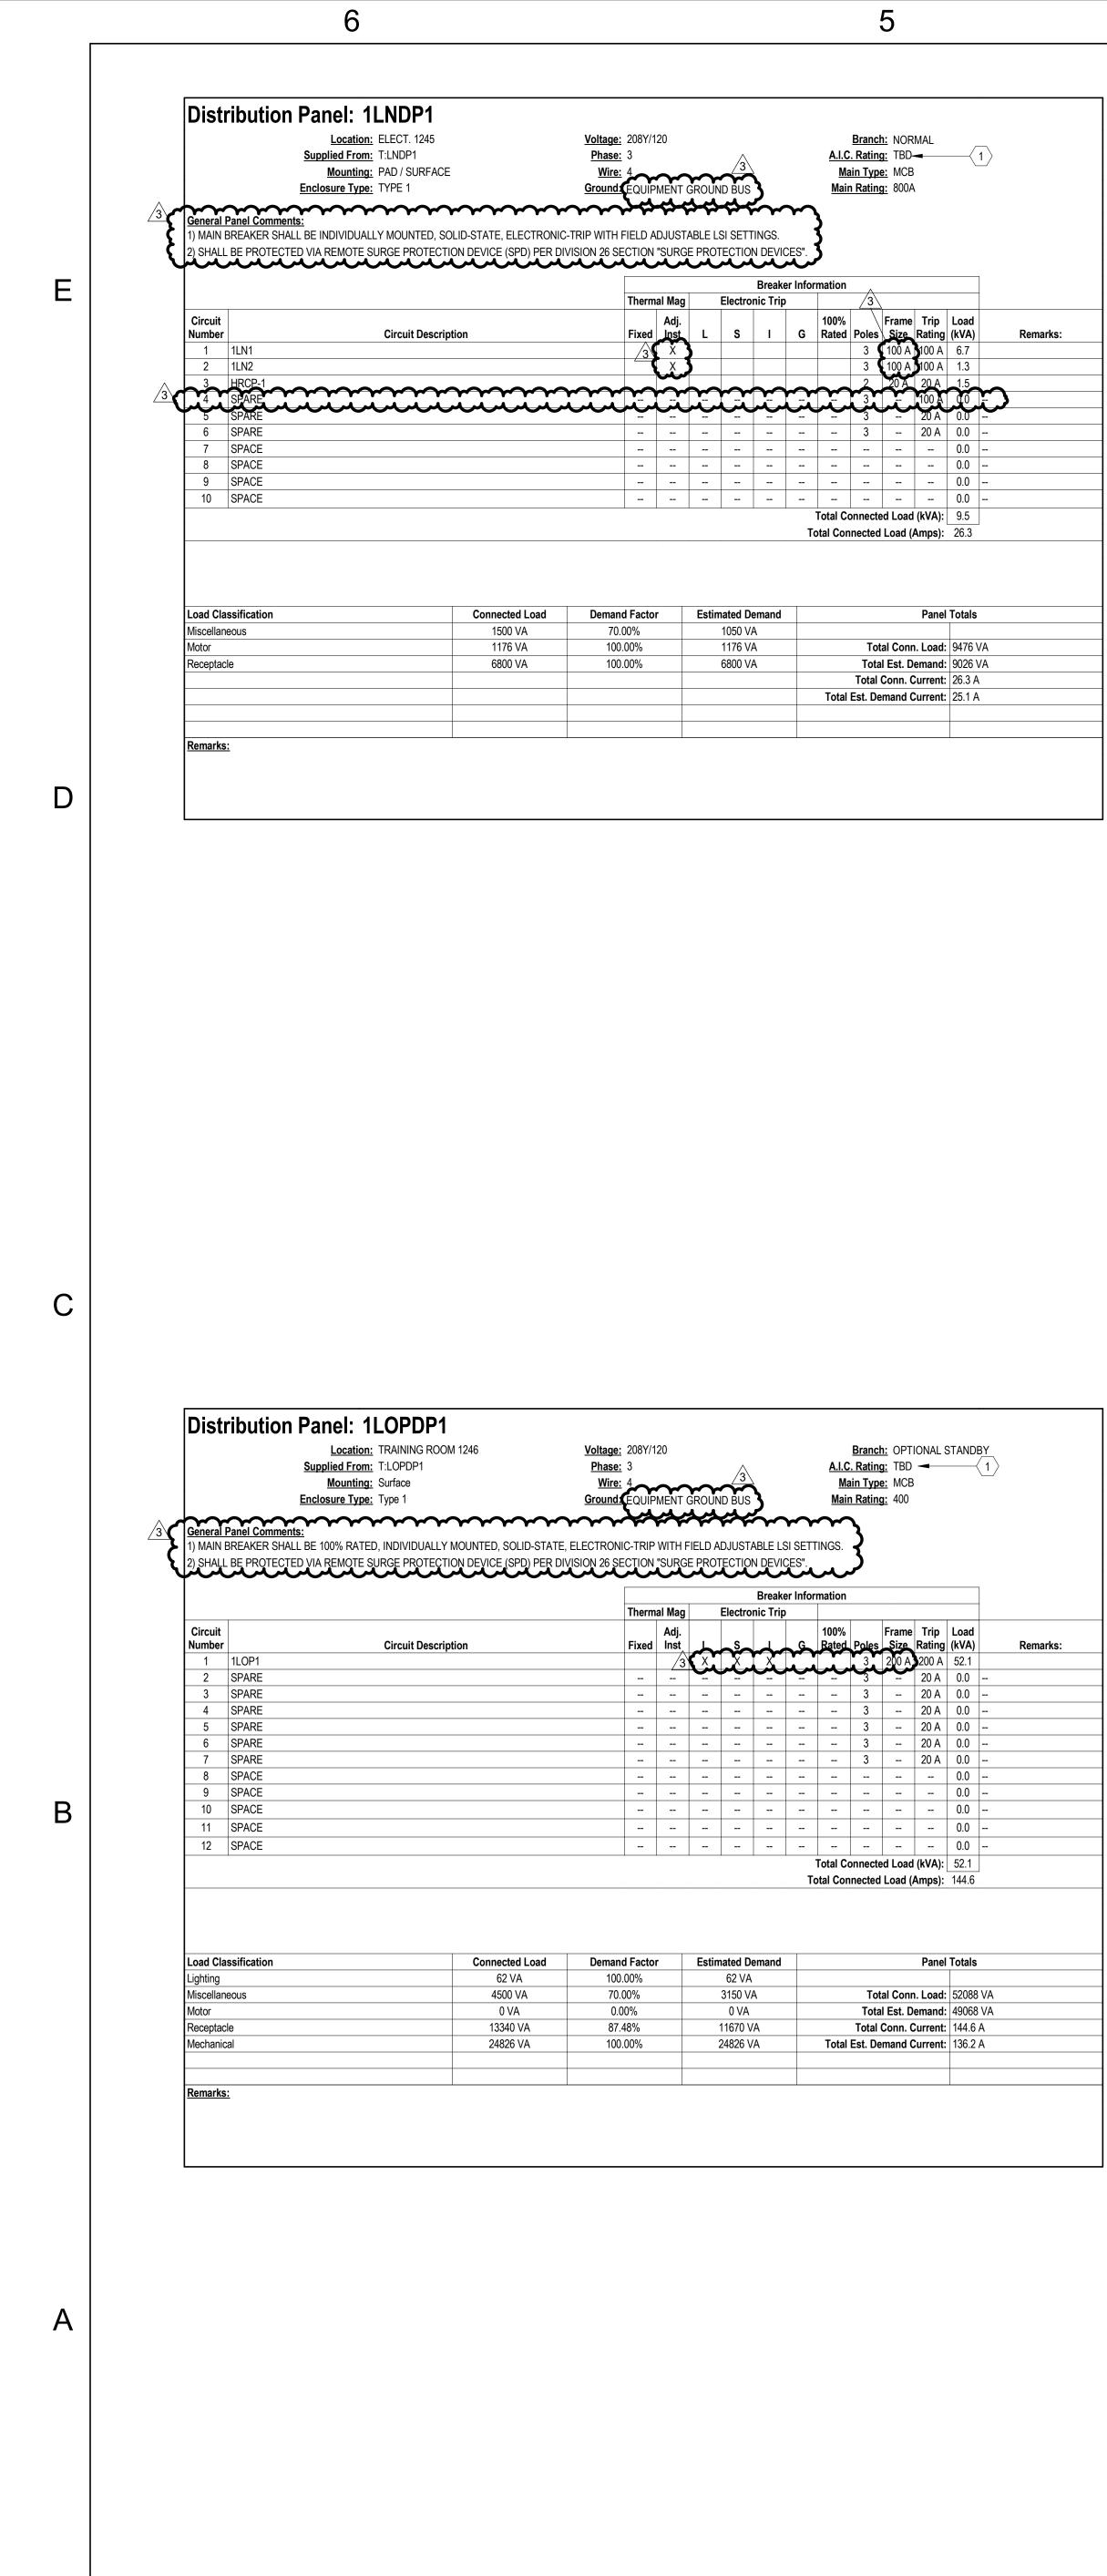

Conorol I	Location: MECH. 1660 <u>Supplied From:</u> 1LOPDP1 <u>Mounting:</u> Surface <u>Enclosure Type:</u> Type 1 eneral Panel Comments:						: 208Y/ [,] : 3 : 4 : EQUIF		GROUNE) BUS		Branch: OPTIONAL STANDBY <u>A.I.C. Rating:</u> TBD- <u>Main Type:</u> MLO <u>Main Rating:</u> 200 A			
General F	<u>anei Comments:</u>														
Circuit Number 1	Circuit Description FCU-C1	Trip 20 A	Poles	1.2	A 0.6	E	3	(C	Poles	Trip 20 A	Circuit Des	cription	Circuit Number 2	
3	C-GWH-2	20 A	1			0.6	1.1			1	20 A	Receptacle_1643		4	
5	Receptacle_1642	20 A	1					1.1	0.9	1		Receptacl_1601, 1605		6	
7	Receptacle_1610, 1660, 1662 Receptacle_1615	20 A 20 A	1	1.1	0.5	0.5	0.5			1		Receptacle_1614 Receptacle_1616		8	
11	Receptacle_1613	20 A	1			0.5	0.5	0.5	0.8			· ·		10	
13	PEF-D1-2	20 A	2	0.9	0.8					2	20 A	PEF-D1-1		14	
15	, _, _, _		<u></u>			0.9	0.9	0.0	0.0	2	20 A	PEF-D1-3		16	
17 19	PEF-D1-4	20 A	2	0.9	0.9			0.9	0.9					18 20	
21	Receptacle_2601, 2602	20 A	1	0.5	0.5	0.5	0.9			2	20 A	PEF-D1-5		20	
23	Receptacle_2602	20 A	1					0.4	1.8	1	20 A	Mechanical		24	
25	Miscellaneous	20 A	2	0.8	0	0.0				2	20 A	ACCU-D2		26	
27 29						0.8	0	0	0.5	1	20 A	Receptacle 4 BED CELL 16130	<u>.</u>	28	
31	ACCU-D1	20 A	2	0	0.5				0.0	1		Receptacle	, 	32	
	Receptacle	20 A	1			0.5	0.5			1		Receptacle		34	
	Receptacle	20 A	1	0.0	0.5			0.5	0.5	1		Receptacle		36	
37 39	Receptacle Lighting_Rooms 1606, 1607	20 A 20 A	1	0.9	0.5	0.1	0.1			1		Receptacle C-HWRP-1		40	
41						0.1	0.1	0.8	1.6					40	
43	PEF-D2-1	20 A	2	0.8	1.6					2	25 A	ACCU-D3		44	
45	PEF-D2-2	20 A	2			0.8	3.1	0.0	24	2	50 A	ACCU-D4		46	
47 49				0.8	0.5			0.8	3.1	1	20 A	Receptacle		48 50	
51	PEF-D2-3	20 A	2	0.0	0.0	0.8	1.2			1		FCU-D4		52	
53	D-EWH-1	20 A	2					1.5	1.2	1		FCU-D5		54	
55	FCU-D1	20 A		1.5	1.2	1.2	1			1	20 A 20 A	FCU-D3 VAV Transformers - Rm 1612		56 58	
57 59	FCU-D2	20 A	1			1.2	1	1.2	0.4	1		Receptacle MECHANICAL 165	9	60	
61	Receptacle Room 1640, 1639	20 A	1	0.4	0.2				0.1	1		Receptacle ELECT. 1245		62	
	SPARE	20 A	1			0	0.2			1		Receptacle - ROOF		64	
	SPARE	20 A	1	0	0			0	0	1		SPARE		66	
	SPARE SPARE	20 A 20 A	1	0	0	0	0			1		SPARE SPARE		68 70	
	SPARE	20 A	1				•	0	0	1				70	
	SPARE	20 A	1	0	0					1	20 A	SPARE		74	
	SPARE	20 A	1			0	0	0	0	1		SPARE		76	
	SPARE SPARE	20 A 20 A	1	0	0			0	0	1		SPARE SPARE		78 80	
	SPARE	20 A	1		-	0	0			1		SPARE		82	
83	SPARE	20 A	1					0	0	1	20 A	SPARE		84	
		Tota	al Load:	16.5	5 kVA	16.3	kVA Sumamr		kVA						
Load Cla	ssification		ected Lo	bad	De	mand Fa	actor	·		Demano	ł	Panel	Totals		
Lighting			62 VA			100.00%			62 V						
Miscellane Motor	eous	4	500 VA 0 VA			70.00%			3150 0 V.			Total Conn. Load: Total Est. Demand:			
Receptac	e	1:	0 VA 3340 VA			0.00% 87.48%			11670			Total Conn. Current:			
Mechanic			4826 VA			100.00%			24826			Total Est. Demand Current:			
											_				
Remarks															

3

	Supplied From: Mounting: SURFACE Enclosure Type: Type 1								S			M	<u>2. Rating:</u> ain Type: n Rating:	MCB	-	$-\langle \underline{1} \rangle$	
A 15						u	x	×	ممر								
	nel Comments:																
,	E UL LISTED AND RATED AS S REAKER SHALL BE 100% RATEI				ע מומד א	אודט כוכ		ס וו וס	וסאדי	EICI		<u></u>					
,	E PROTECTED VIA REMOTE S	•										63.					
							NOT	LOII			LU .						
									В	reake	r Informa	ation					
					Thermal Mag Electronic												
Circuit						Adj.					100%		Frame	Trip	Load		
Number		Circuit Description			Fixed	Inst	h	Å	₩ ∽	-G-	Rated	Poles	Size	Rating	(kVA)	Remar	
1	1HEMDP1						X	X	X			3	400 A	400 A	29.3		
2	1HLRDP1					3		X	X			3	200 A	200 A	9.0		
3	1HOPDP1					- 6	X	X	X			3	600 A	600 A	226.4		
4	MDS						L×	L×	L×	L	m	سىس	1600 A		0.0		
5	SPARE											3		20 A	0.0		
6	SPARE									3		20 A	0.0				
7	SPACE SPACE														0.0		
8	SPACE														0.0		
9 10	SPACE														0.0		
10	SPACE														0.0		
12	SPACE														0.0		
12													ected Loa				
					Total Connected Load (Amps): 318.4												
									_		_						
Load Class HVAC	sification		ected Load	Demano 100.				16121		and				Pane	el Totals		
Lighting			1989 VA	100.				21989					Total Co	nn. Load	: 26471	9 VA	
Miscellaneo	us		1850 VA	70.0				50295				•	Total Est.				
Motor			704 VA	100.				4704					otal Conn				
Other	73787 VA							73787			1	Total Est	. Demano	d Current	: 277.2	Α	
Receptacle			5460 VA		10%			22730									
Mechanical		3′	1447 VA	100.	00%		3	31447	' VA								
Remarks:																	

4


Switchboard: 1HEMSB1

2


PLAN NOTES

ALL ELECTRICAL EQUIPMENT SHALL BE RATED TO WITHSTAND THE AVAILABLE FAULT CURRENT FROM THE UTILITY. SERIES RATED DEVICES ARE NOT ACCEPTABLE. AVAILABLE FAULT CURRENT SHALL BE CONFIRMED WITH UTILITY AND FAULT ANALYSIS COMPLETE AS PER SPECIFICATIONS SECTION 26 05 73 PRIOR TO FINAL EQUIPMENT APPROVAL.

Bran	ch Panel: 1LOP3 <u>Location:</u> PROPERTY ST <u>Supplied From:</u> T:1LOP3 <u>Mounting:</u> Surface <u>Enclosure Type:</u> Type 1		<u>Voltage:</u> 208Y/120 <u>Phase:</u> 3 <u>Wire:</u> 4 <u>Ground:</u> EQUIPMENT GROUND BUS							Branch: OPTIONAL STANDBY <u>A.I.C. Rating:</u> TBD → 1 <u>Main Type:</u> MCB <u>Main Rating:</u> 200A			
General I	Panel Comments:												
Circuit Number	Circuit Description	Trip Poles		A		B		С		Trip	Circuit Des	cription	Circuit Numbe
1	Receptacle_1512	20 A 1	0.4	0.4					1	-	Receptacle_1512	•	2
3	Receptacle_1512	20 A 1			0.4	0.9			1	20 A	Receptacle_1516		4
5	Receptacle_1511, 1505	20 A 1					1.3	0.4	1	20 A	Receptacle_1505		6
7	Receptacle_1505	20 A 1	0.4	0.4					1	20 A	Receptacle_1505		8
9	Overhead Door Operator_1501	20 A 1			1.2	1.2			1	20 A	Overhead Door Operator_1501		10
11	Overhead Door Operator_1501	20 A 1					1.2	1.2	1	20 A	Overhead Door Operator_1501		12
13	Receptacle_1504	20 A 1	0.7	0.5					1	20 A	Receptacle ISO. 1558		14
15	FCU-A1	20 A 1			1.2	1.4							16
17	Receptacle_AHU-A1	20 A 1					0.2	1.4	2	20 A	EF-A-1		18
19	A-GWH-1	20 A 1	0.6	0.6					1	20 A	A-GWH-2		20
21	AHU-A1 Enclosure Receptacles Lighting	20 A 1			0.5	0			1	20 A	SPARE		22
23	VAV Transformers - Rm 1532	20 A 1					1	0	1	20 A	SPARE		24
25	SPARE	20 A 1	0	0					1	20 A	SPARE		26
27	SPARE	20 A 1			0	0			1	20 A	SPARE		28
29	SPARE	20 A 1					0	0	1	20 A	SPARE		30
31	SPARE	20 A 1	0	0					1	20 A	SPARE		32
33	SPARE	20 A 1			0	0			1	20 A	SPARE		34
35	SPARE	20 A 1					0	0	1	20 A	SPARE		36
37	SPARE	20 A 1	0	0					1	20 A	SPARE		38
39	SPARE	20 A 1			0	0			1	20 A	SPARE		40
41	SPARE	20 A 1					0	0	1	20 A	SPARE		42
		Total Load:	3.9	kVA	6.7	kVA	6.5	kVA		1			
						Sumamr	-						
	ssification	Connected L	oad	De	mand Fa		Es		Demano	k l	Panel	I Totals	
Motor		4704 VA			100.00%			4704					
Receptac		5720 VA			100.009		_	5720			Total Conn. Load:		
Mechanic	al	6622 VA			100.00%	%		6622	VA		Total Est. Demand:		
							_				Total Conn. Current:		
											Total Est. Demand Current:	47.3 A	
Remarks													
Remarks	emarks:												

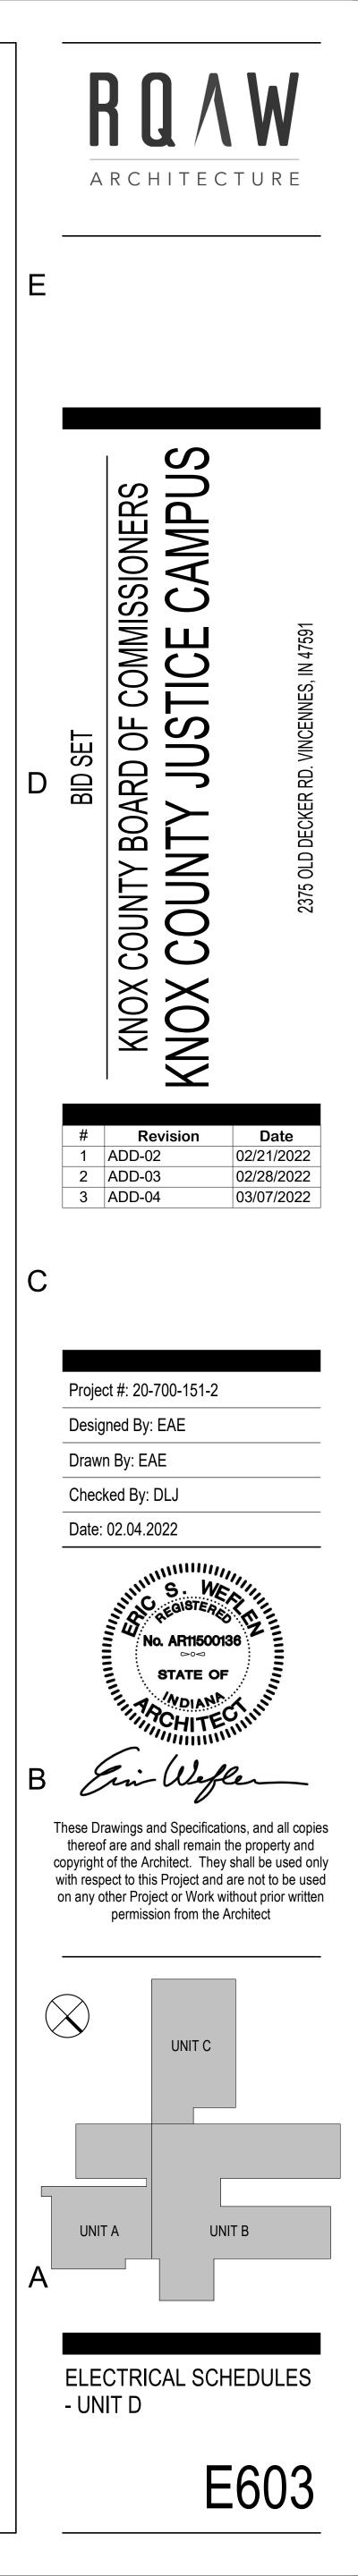



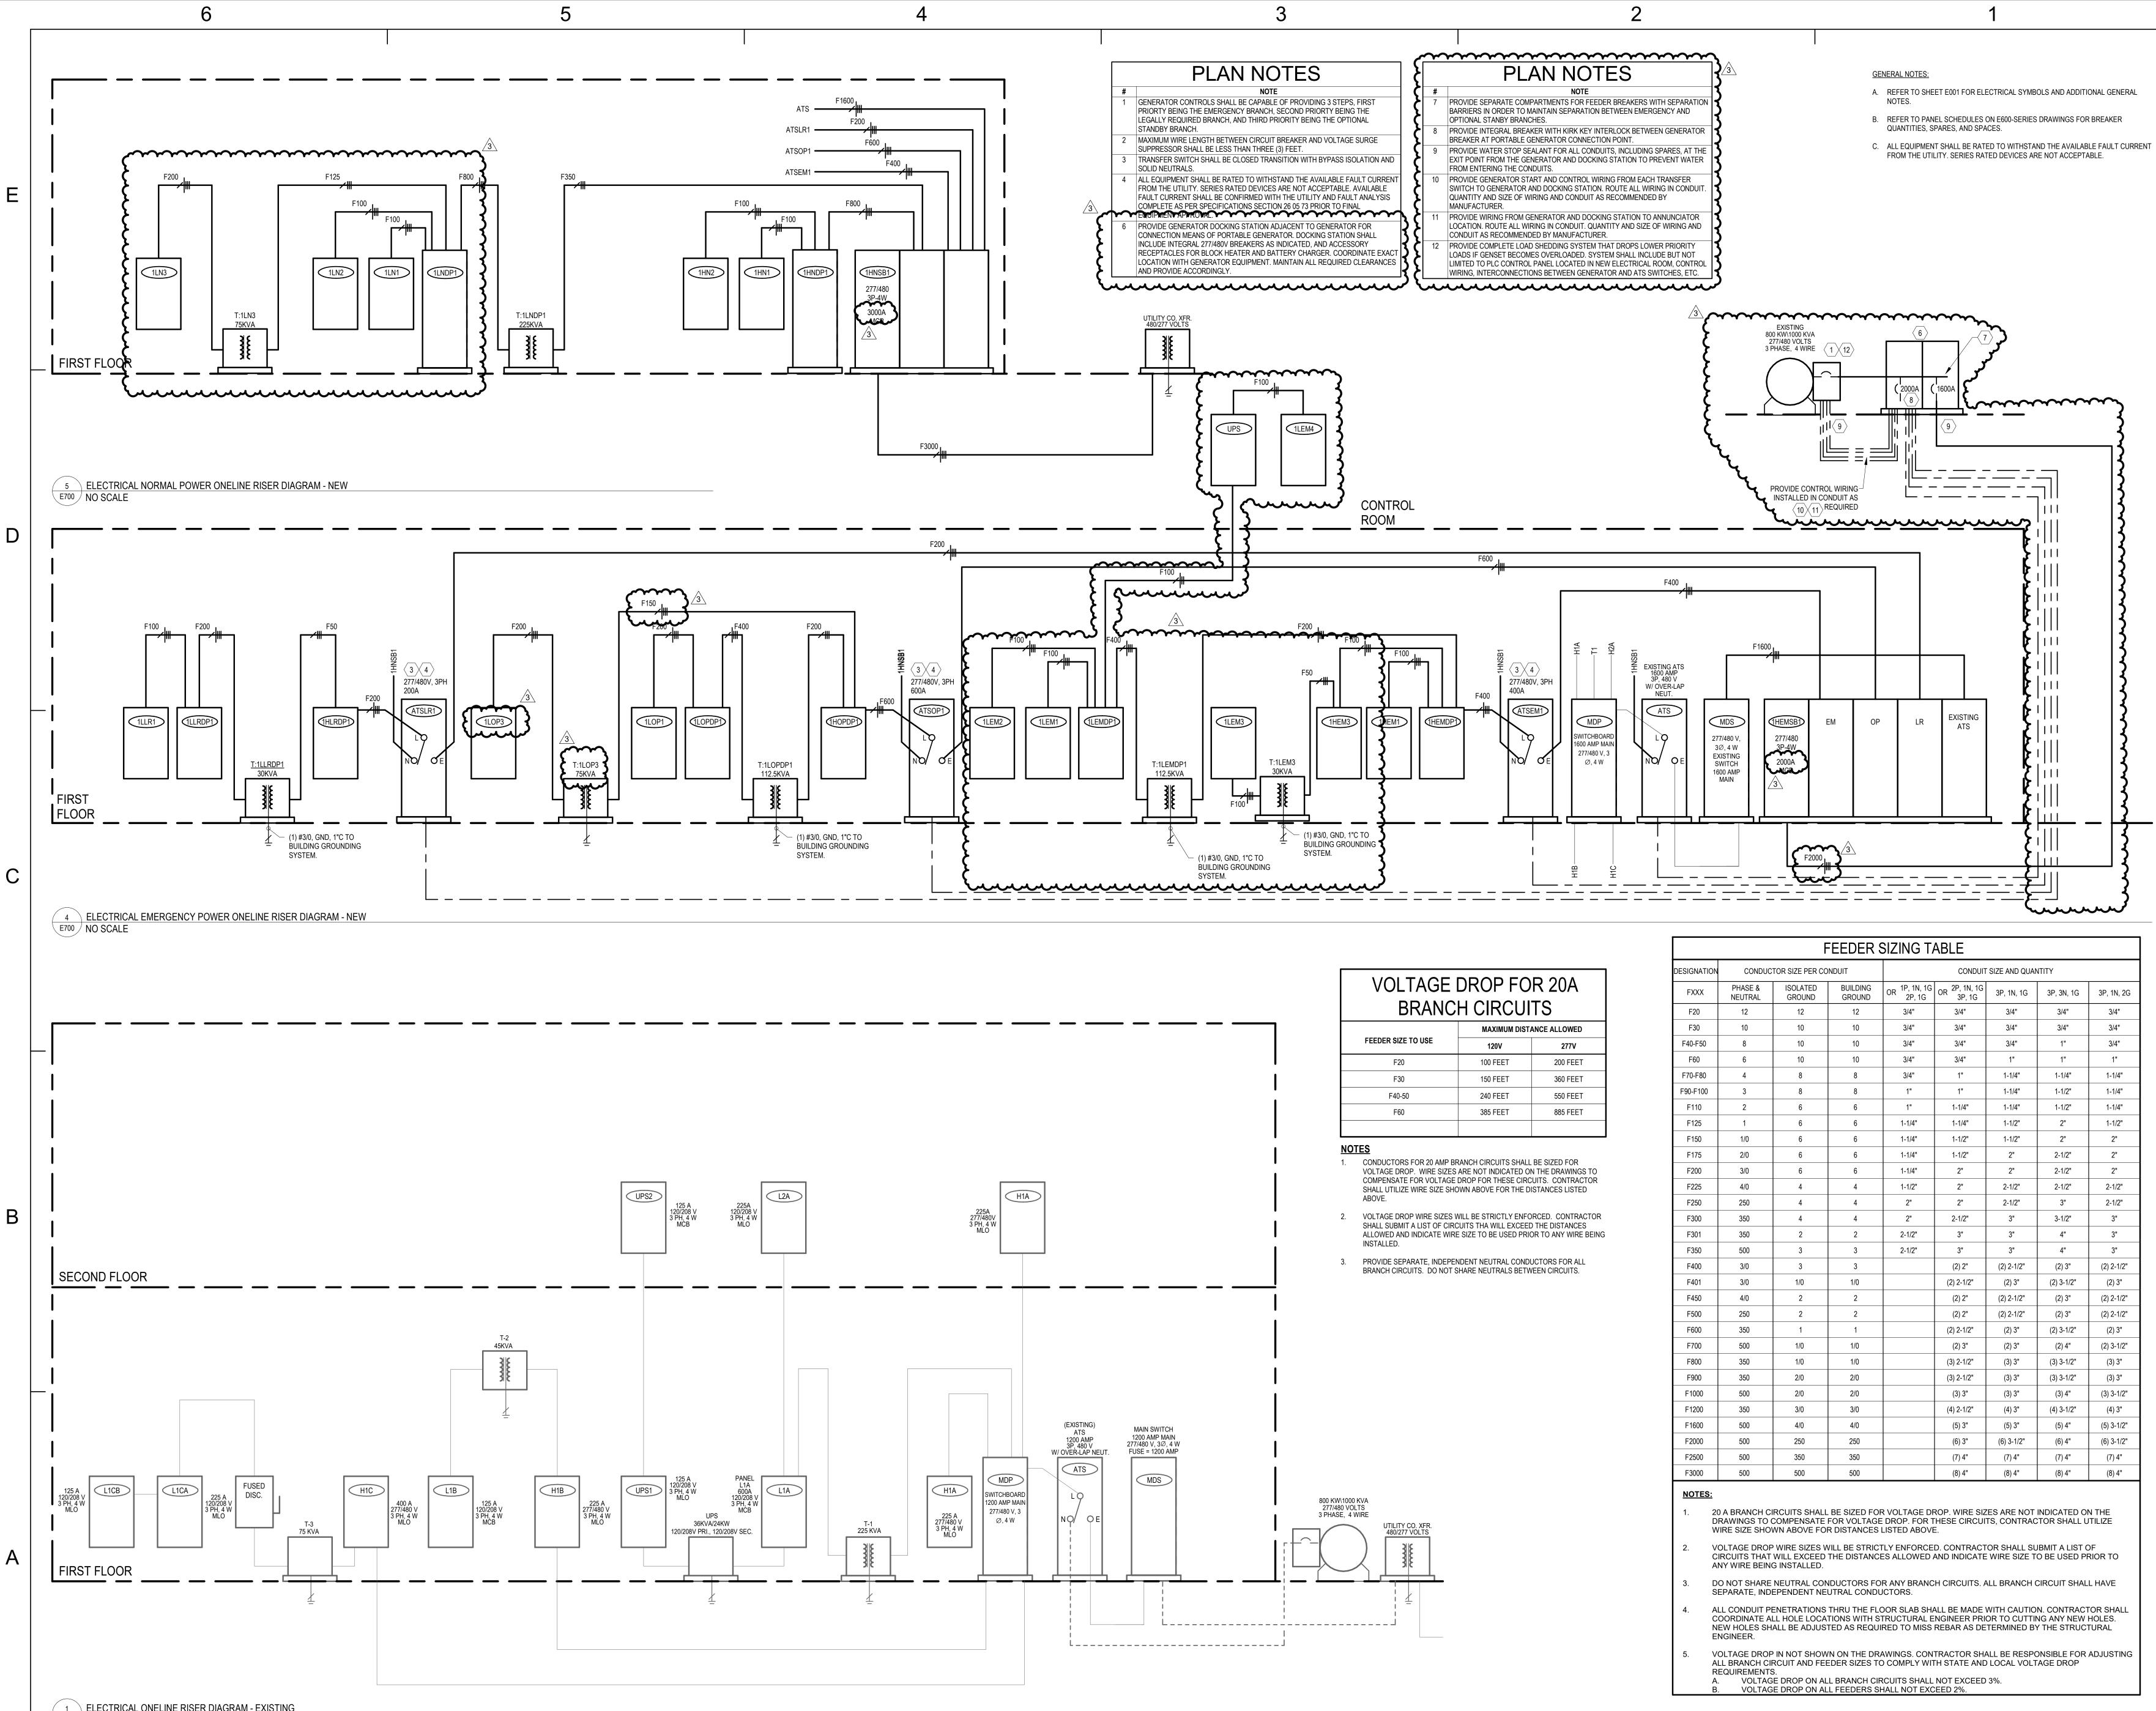

1 ELECTRICAL ONELINE RISER DIAGRAM - EXISTING E700 NO SCALE

5


3


AGE DROP FOR 20A									
RANCH CIRCUITS									
	MAXIMUM DIST	ANCE ALLOWED							
TO USE									


TO USE	120V	277V
	100 FEET	200 FEET
	150 FEET	360 FEET
	240 FEET	550 FEET
	385 FEET	885 FEET


		F	EEDER S	SIZING T/	ABLE			
DESIGNATION	CONDUC	TOR SIZE PER CO	NDUIT		CONDUIT	SIZE AND QUAN	NTITY	
FXXX	PHASE & NEUTRAL	ISOLATED GROUND	BUILDING GROUND	OR ^{1P, 1N, 1G} 2P, 1G	OR ^{2P, 1N, 1G} 3P, 1G	3P, 1N, 1G	3P, 3N, 1G	3P, 1N, 2G
F20	12	12	12	3/4"	3/4"	3/4"	3/4"	3/4"
F30	10	10	10	3/4"	3/4"	3/4"	3/4"	3/4"
F40-F50	8	10	10	3/4"	3/4"	3/4"	1"	3/4"
F60	50 6 10 10		10	3/4"	3/4"	1"	1"	1"
F70-F80	4	8	8	3/4"	1"	1-1/4"	1-1/4"	1-1/4"
F90-F100	3	8	8	1"	1"	1-1/4"	1-1/2"	1-1/4"
F110	2	6	6	1"	1-1/4"	1-1/4"	1-1/2"	1-1/4"
F125	1	6	6	1-1/4"	1-1/4"	1-1/2"	2"	1-1/2"
F150	1/0	6	6	1-1/4"	1-1/2"	1-1/2"	2"	2"
F175	2/0	6	6	1-1/4"	1-1/2"	2"	2-1/2"	2"
F200	3/0	6	6	1-1/4"	2"	2"	2-1/2"	2"
F225	4/0	4	4	1-1/2"	2"	2-1/2"	2-1/2"	2-1/2"
F250	250	4	4	2"	2"	2-1/2"	3"	2-1/2"
F300	350	4	4	2"	2-1/2"	3"	3-1/2"	3"
F301	350	2	2	2-1/2"	3"	3"	4"	3"
F350	500	3	3	2-1/2"	3"	3"	4"	3"
F400	3/0	3	3		(2) 2"	(2) 2-1/2"	(2) 3"	(2) 2-1/2"
F401	3/0	1/0	1/0		(2) 2-1/2"	(2) 3"	(2) 3-1/2"	(2) 3"
F450	4/0	2	2		(2) 2"	(2) 2-1/2"	(2) 3"	(2) 2-1/2"
F500	250	2	2		(2) 2"	(2) 2-1/2"	(2) 3"	(2) 2-1/2"
F600	350	1	1		(2) 2-1/2"	(2) 3"	(2) 3-1/2"	(2) 3"
F700	500	1/0	1/0		(2) 3"	(2) 3"	(2) 4"	(2) 3-1/2"
F800	350	1/0	1/0		(3) 2-1/2"	(3) 3"	(3) 3-1/2"	(3) 3"
F900	350	2/0	2/0		(3) 2-1/2"	(3) 3"	(3) 3-1/2"	(3) 3"
F1000	500	2/0	2/0		(3) 3"	(3) 3"	(3) 4"	(3) 3-1/2"
F1200	350	3/0	3/0		(4) 2-1/2"	(4) 3"	(4) 3-1/2"	(4) 3"
F1600	500	4/0	4/0		(5) 3"	(5) 3"	(5) 4"	(5) 3-1/2"
F2000	500	250	250		(6) 3"	(6) 3-1/2"	(6) 4"	(6) 3-1/2"
F2500	500	350	350		(7) 4"	(7) 4"	(7) 4"	(7) 4"
F3000	500	500	500		(8) 4"	(8) 4"	(8) 4"	(8) 4"


VOLTAGE DROP IN NOT SHOWN ON THE DRAWINGS. CONTRACTOR SHALL BE RESPONSIBLE FOR ADJUSTING

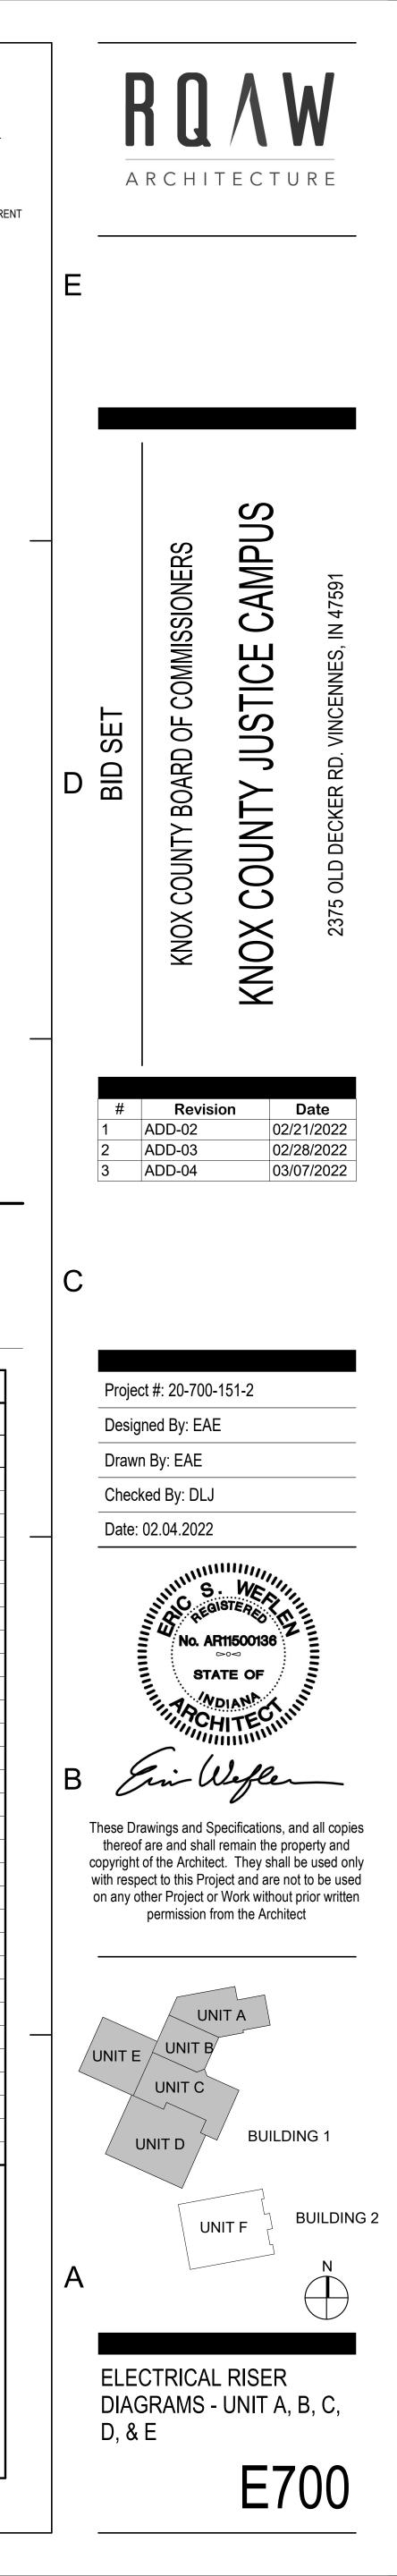

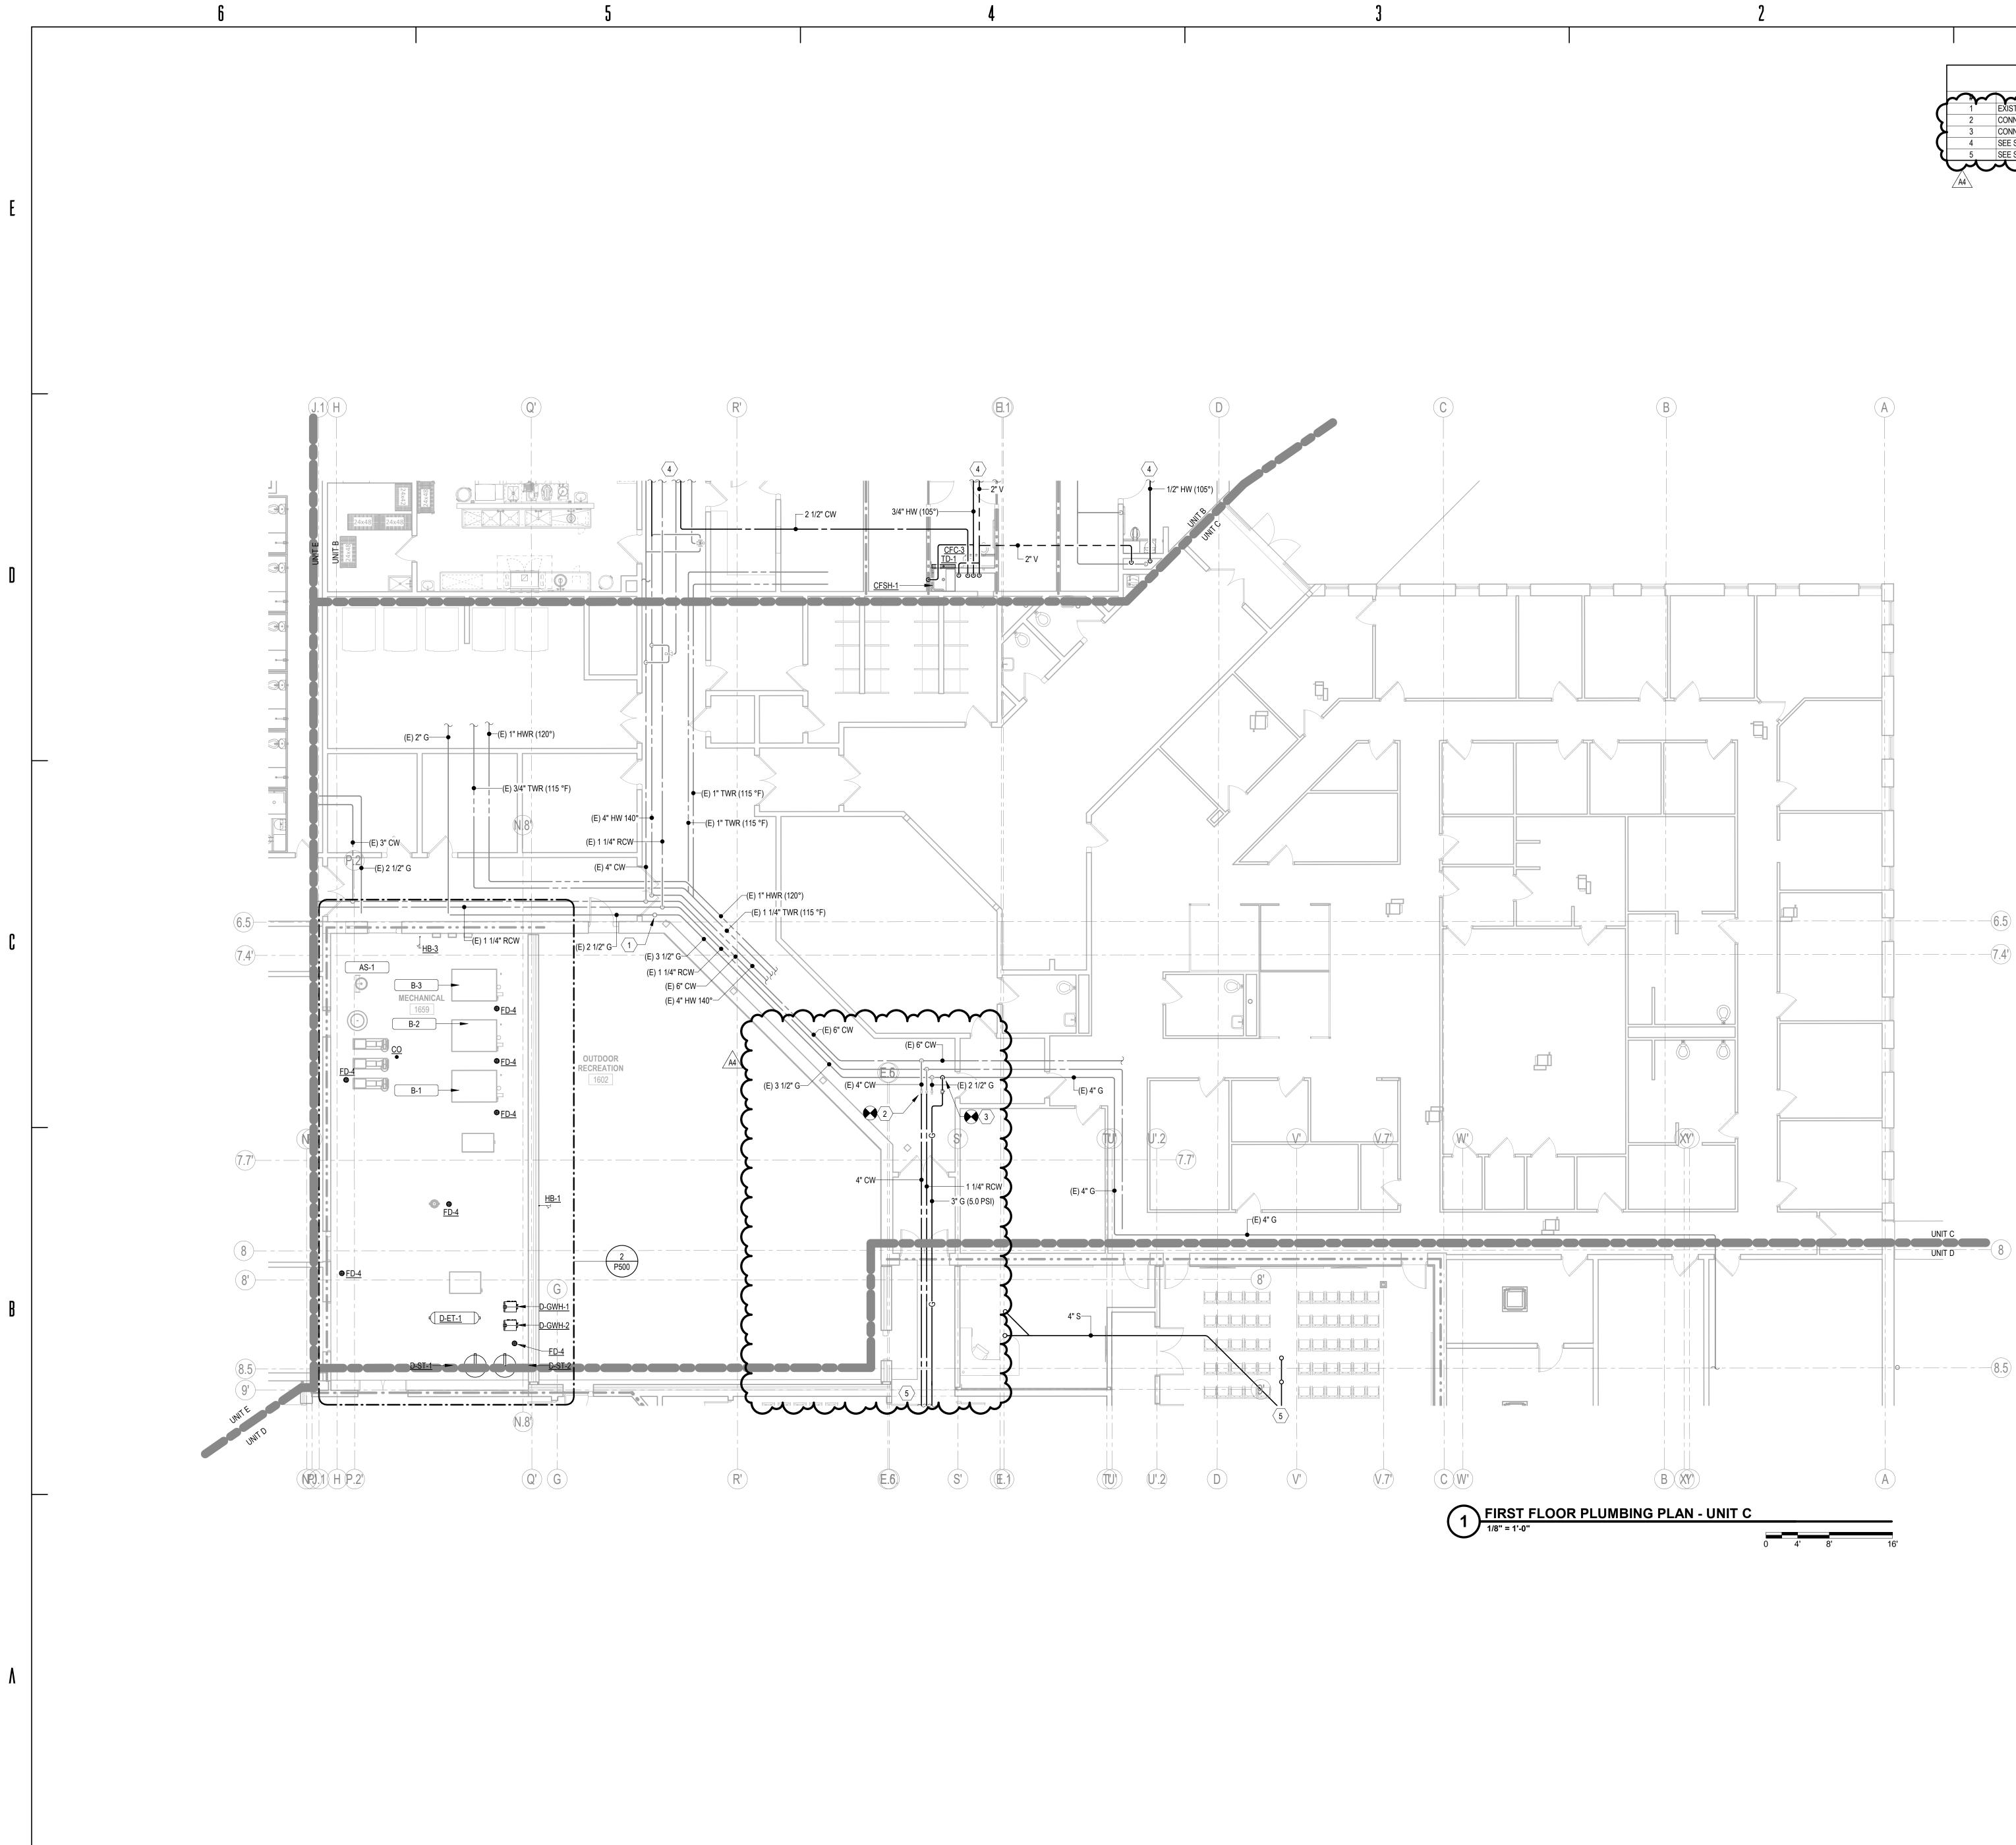


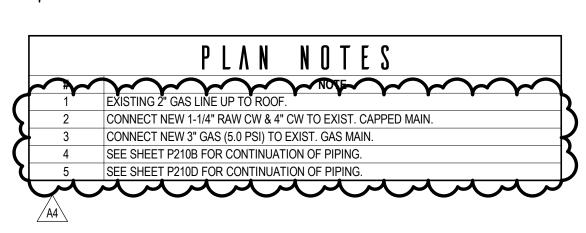


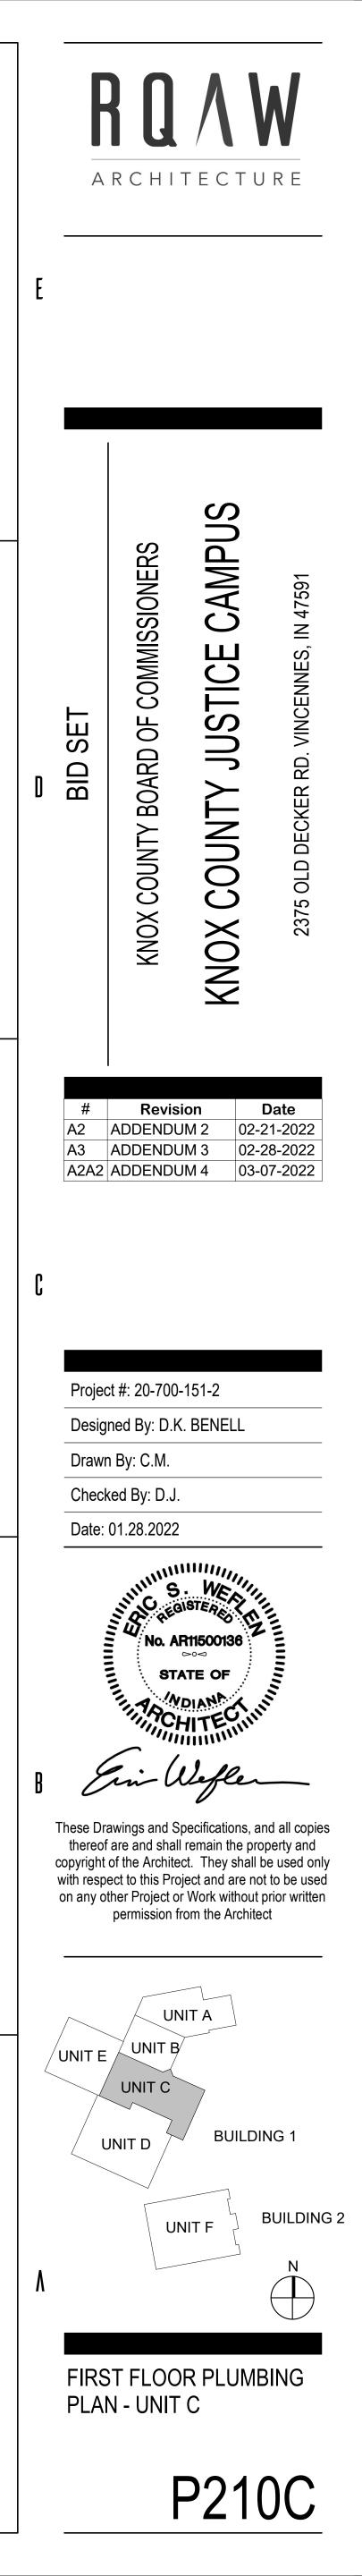


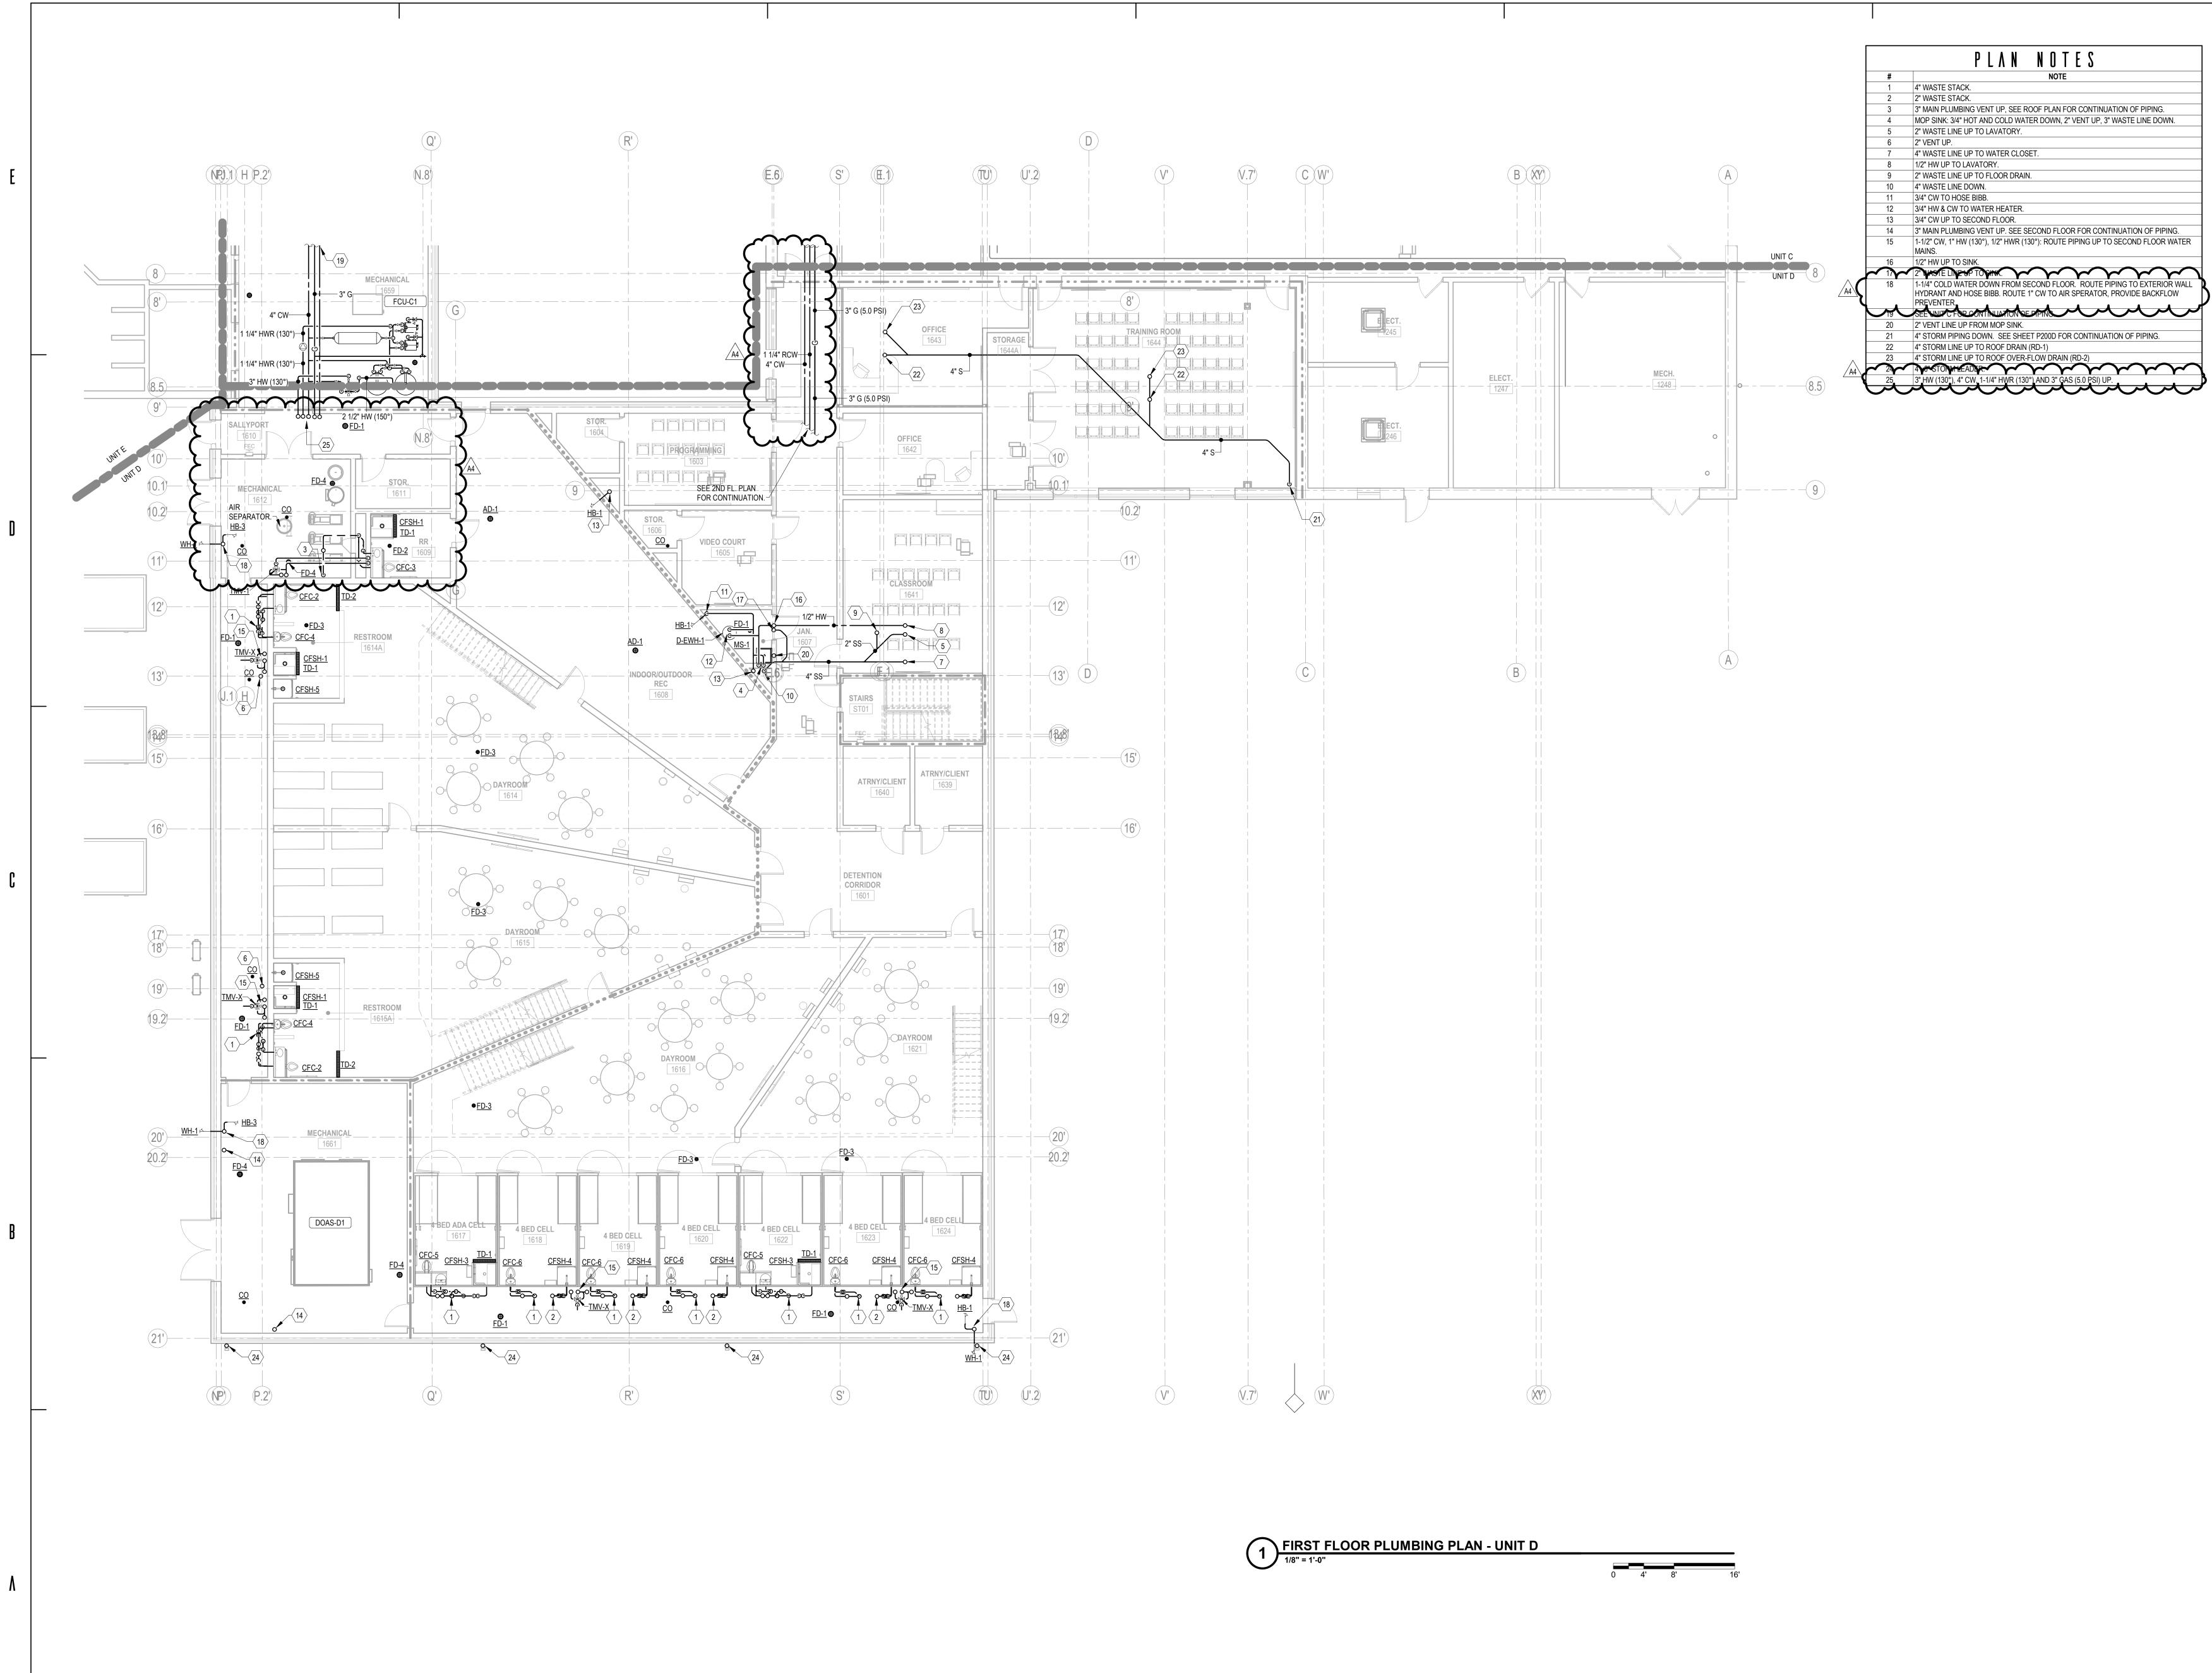




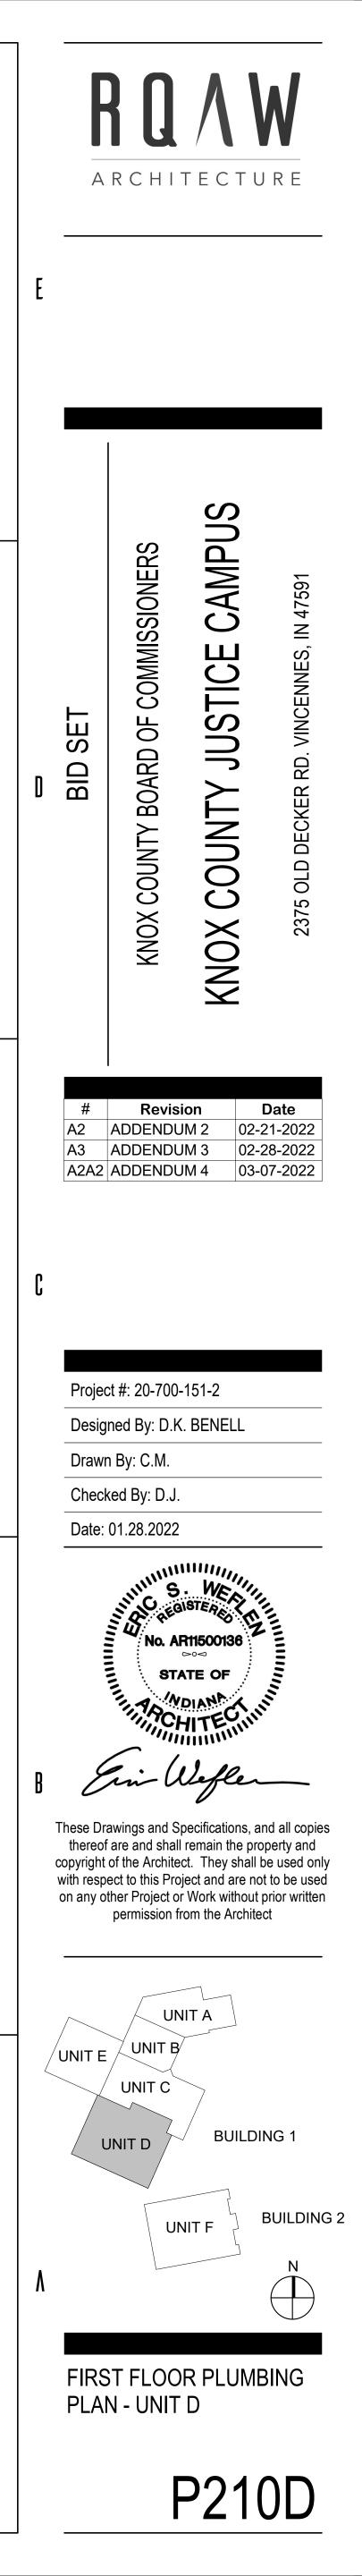


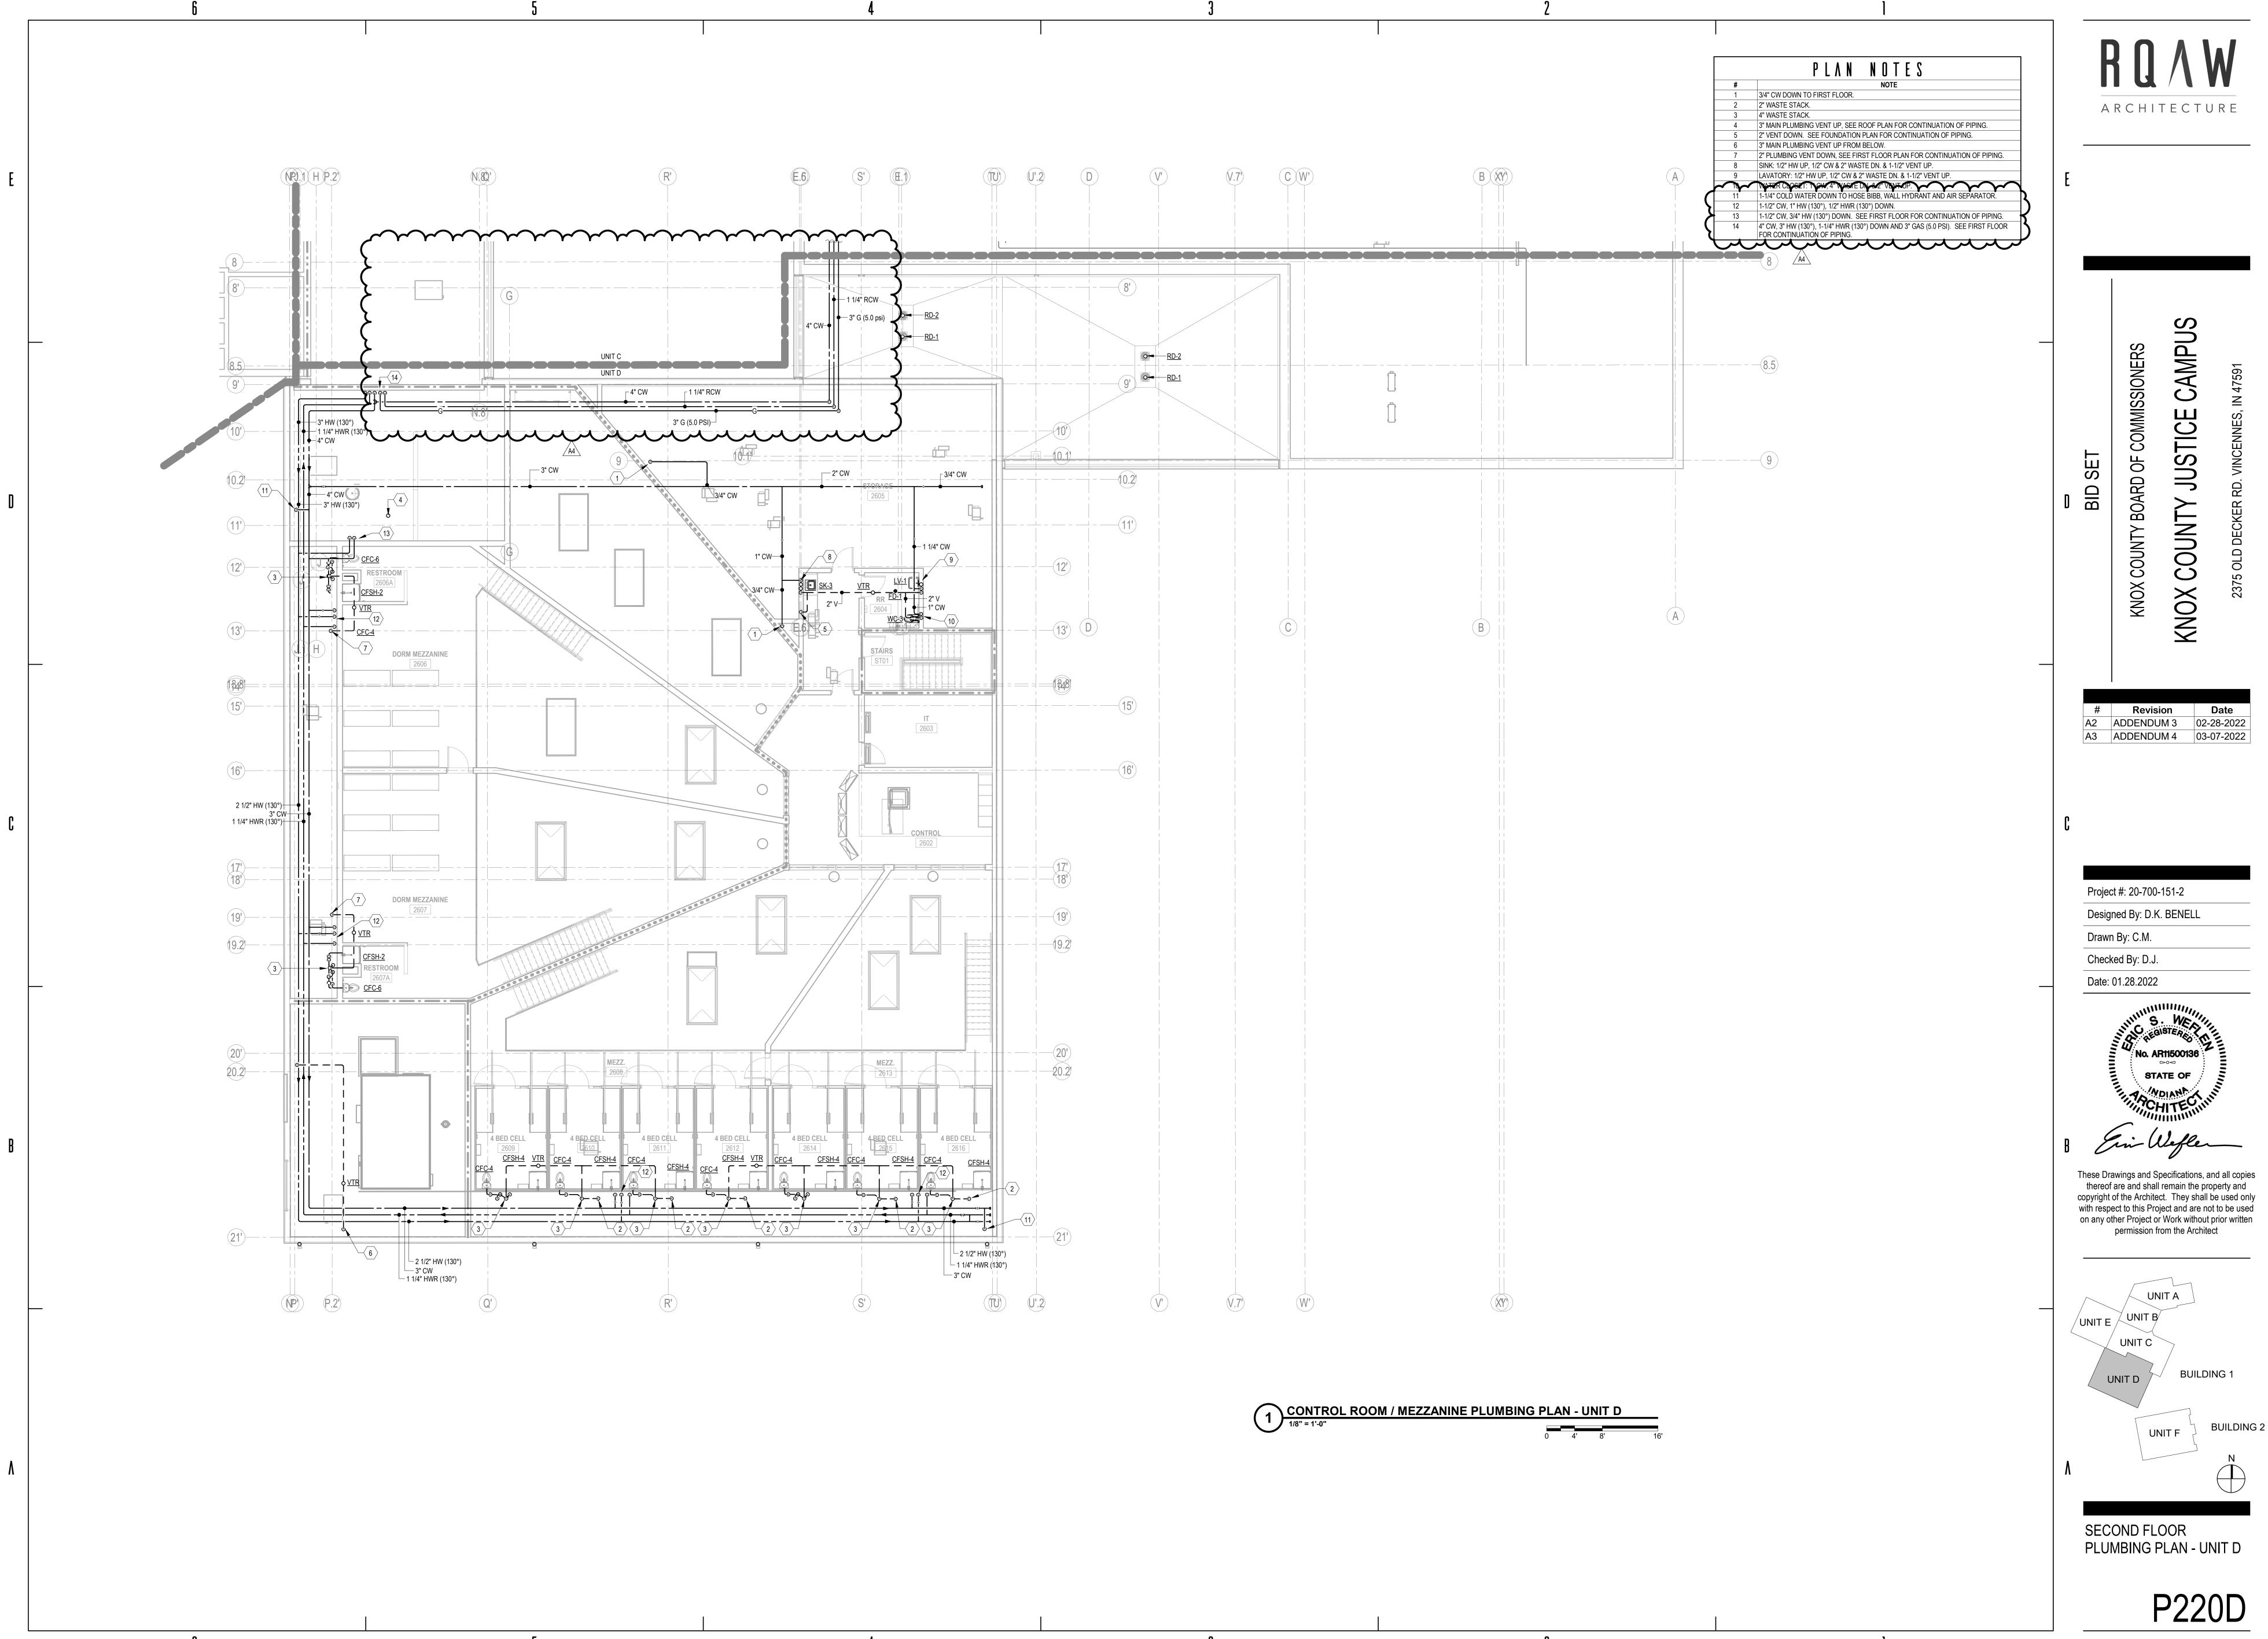

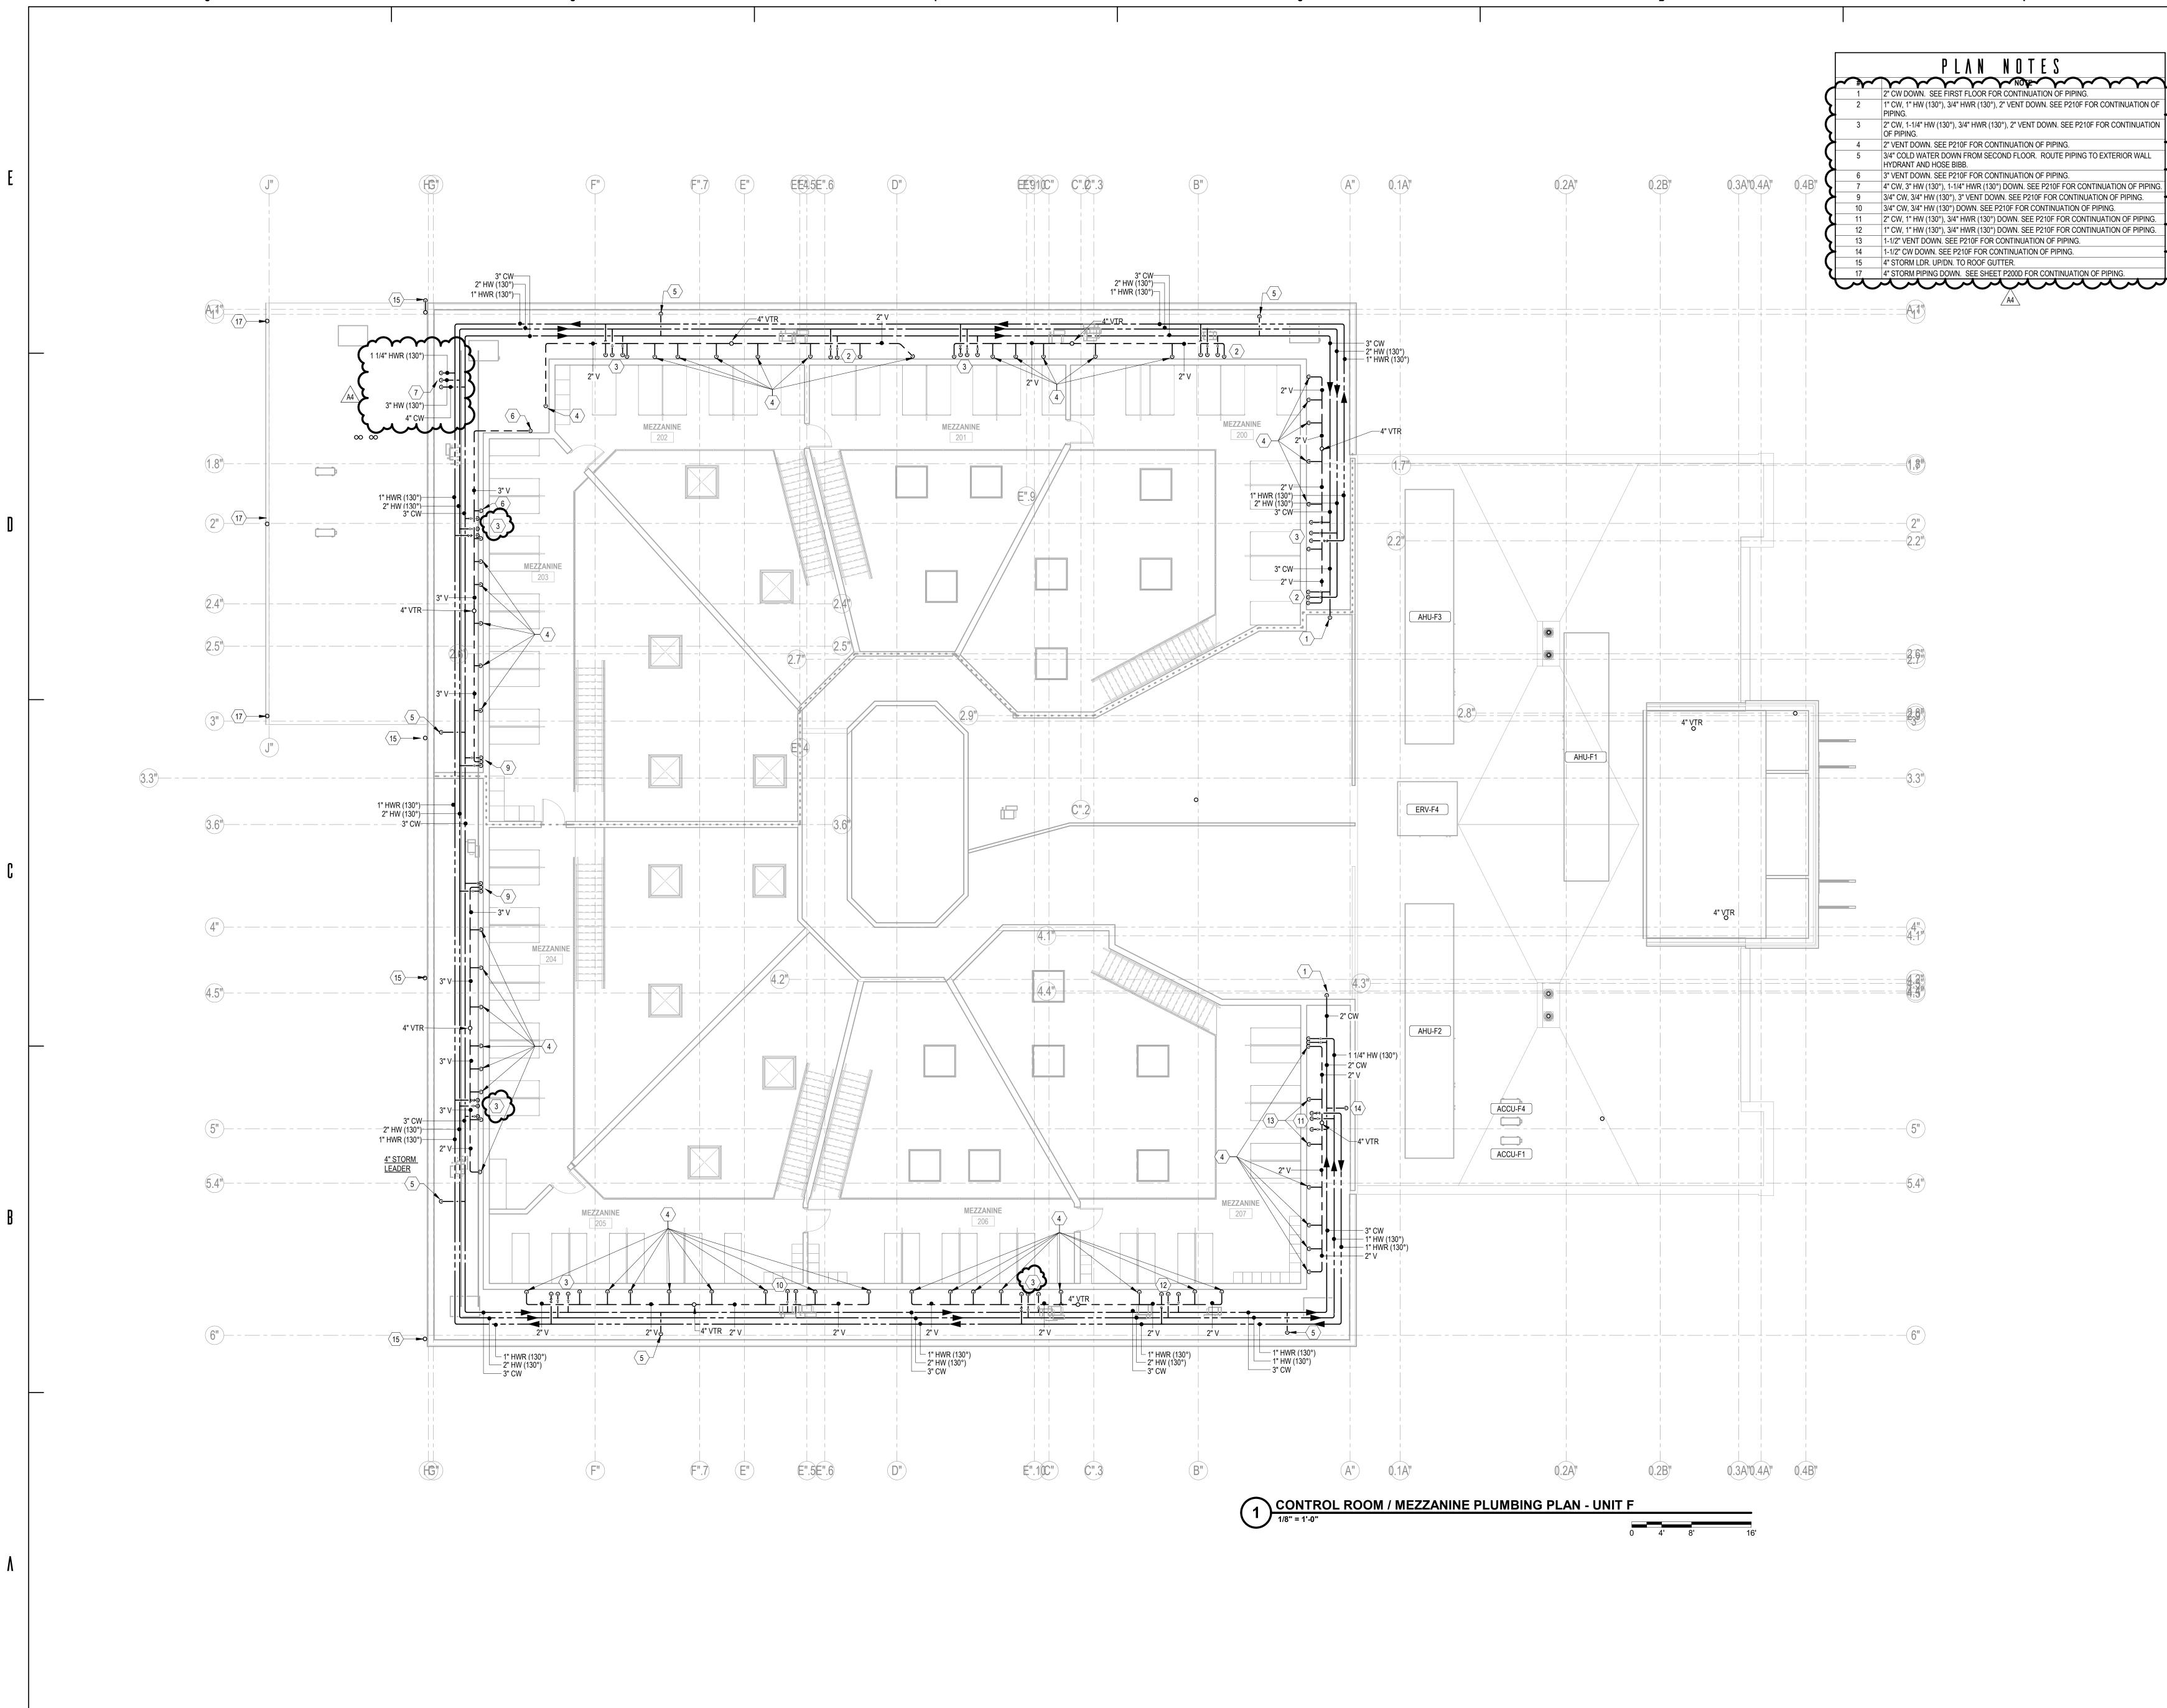




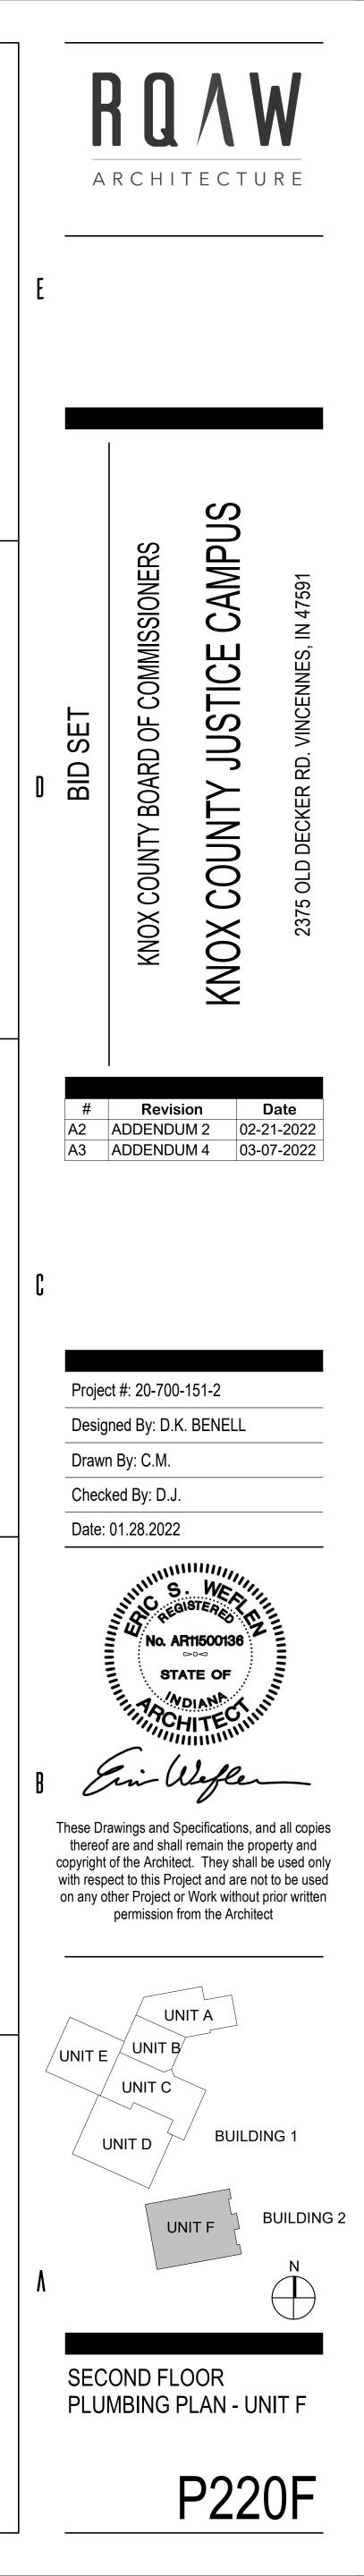

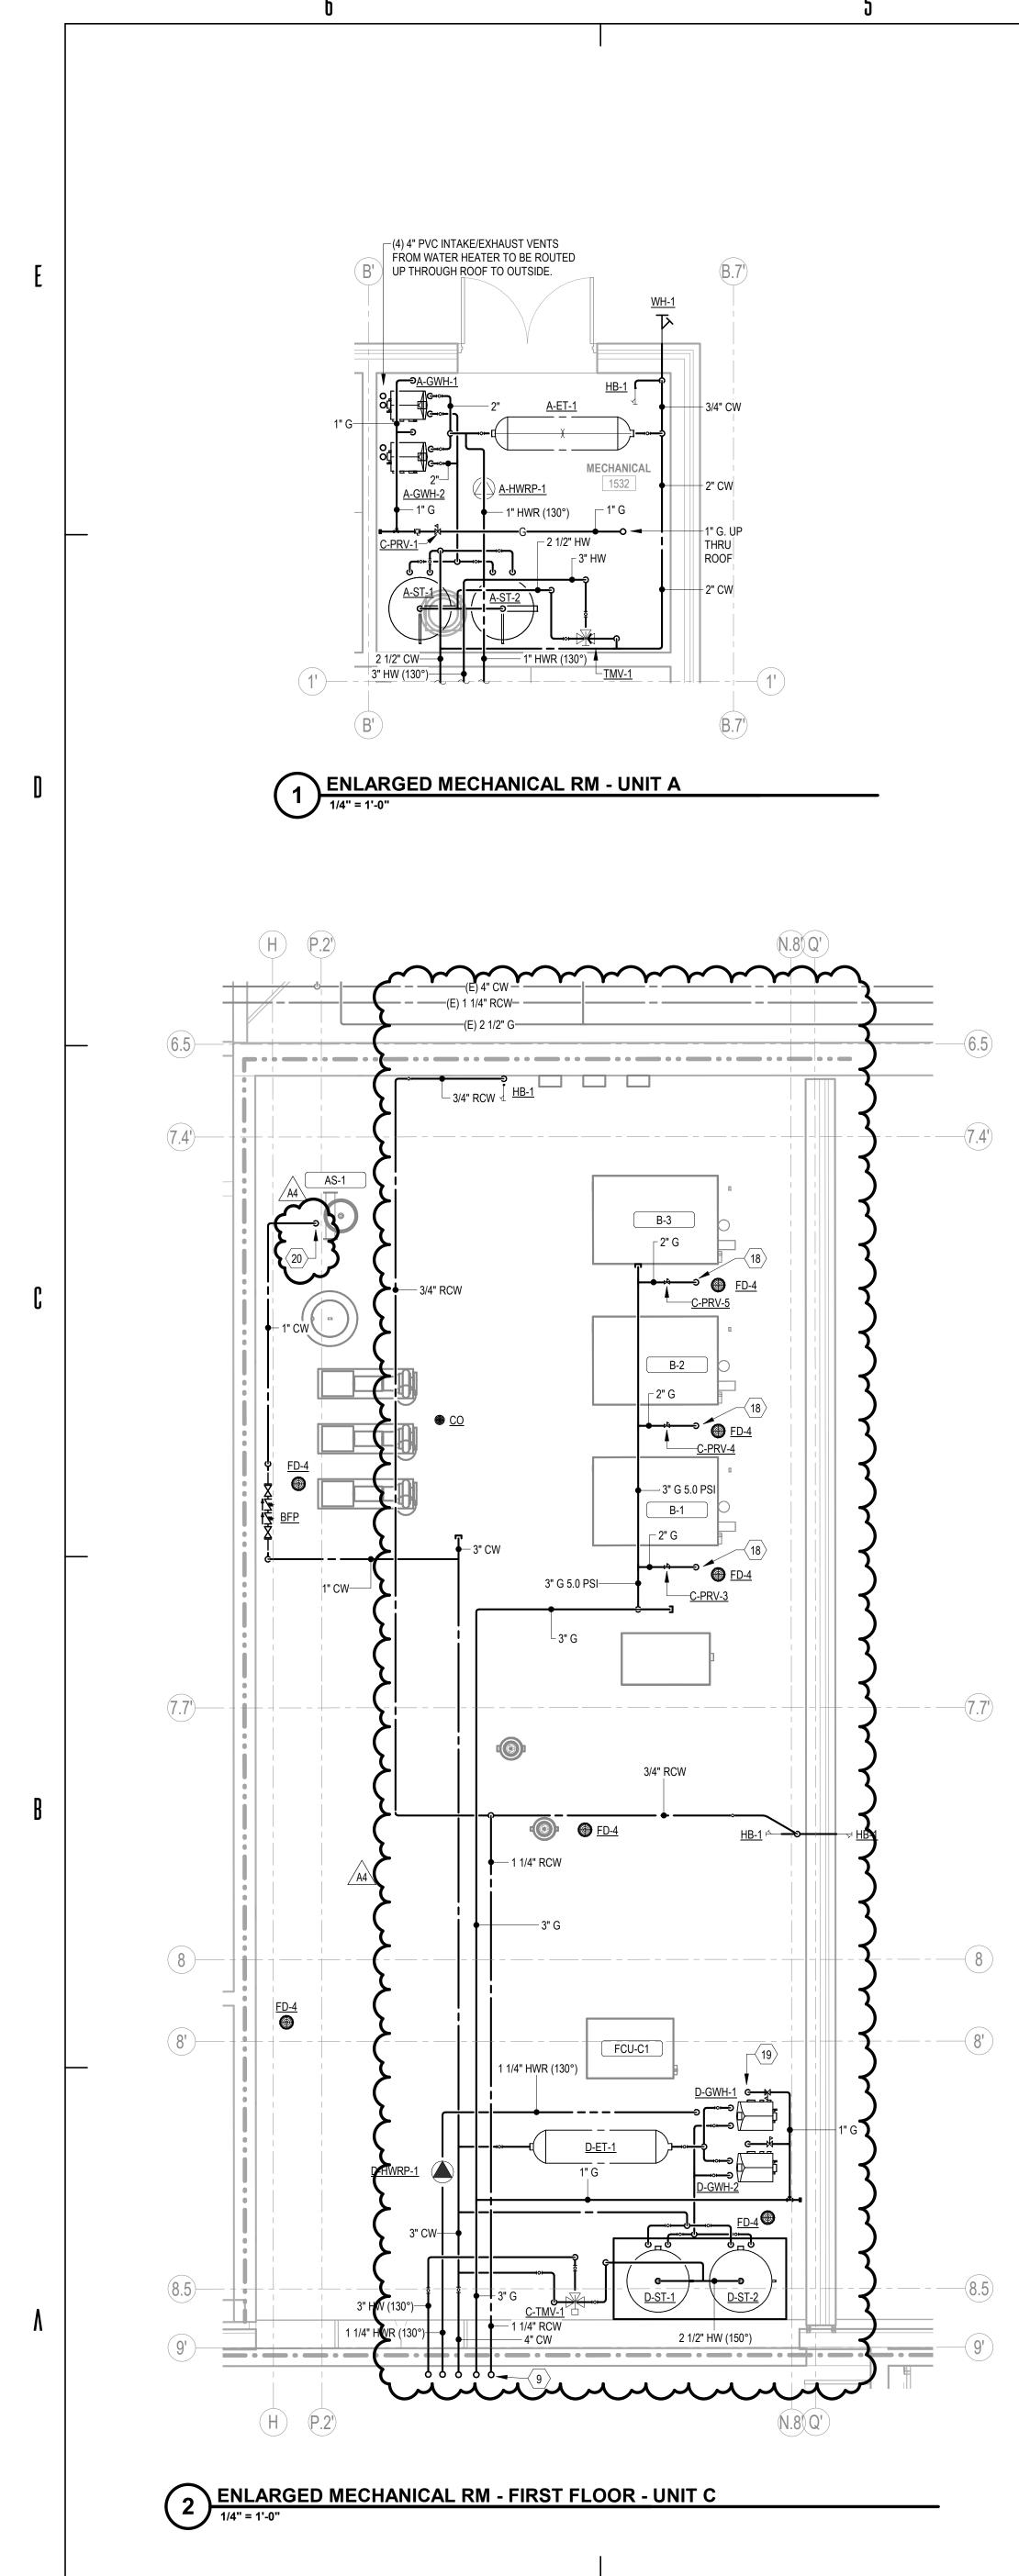






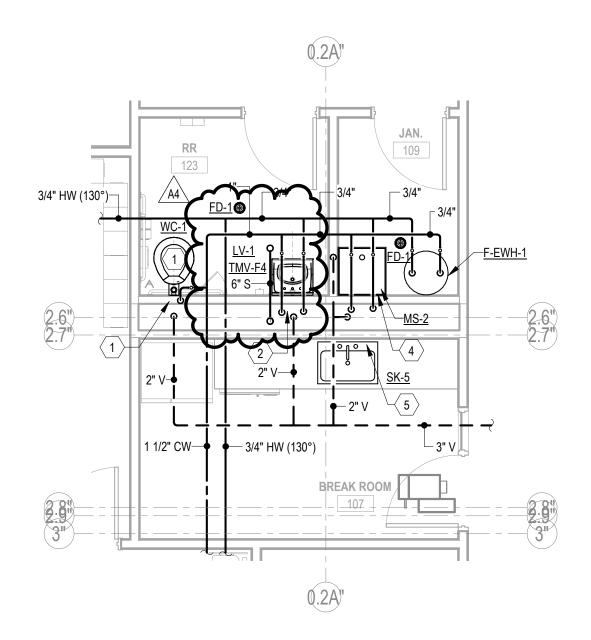




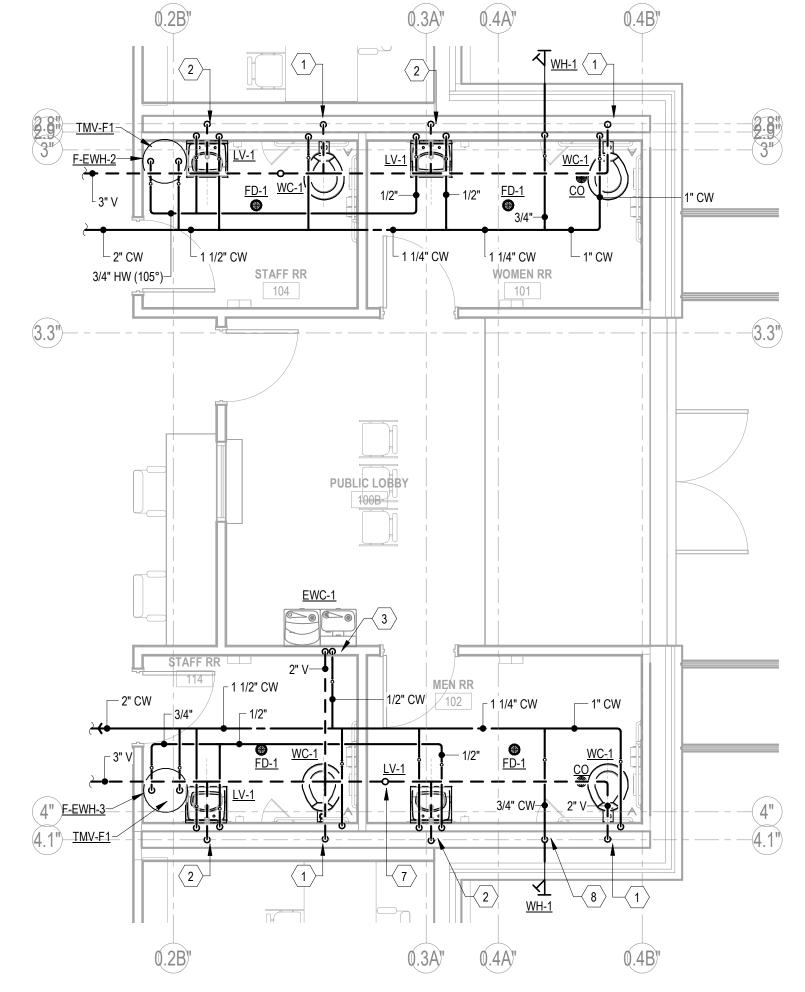


3 ENLARGED MECHANICAL RM - FIRST FLOOR - UNIT F

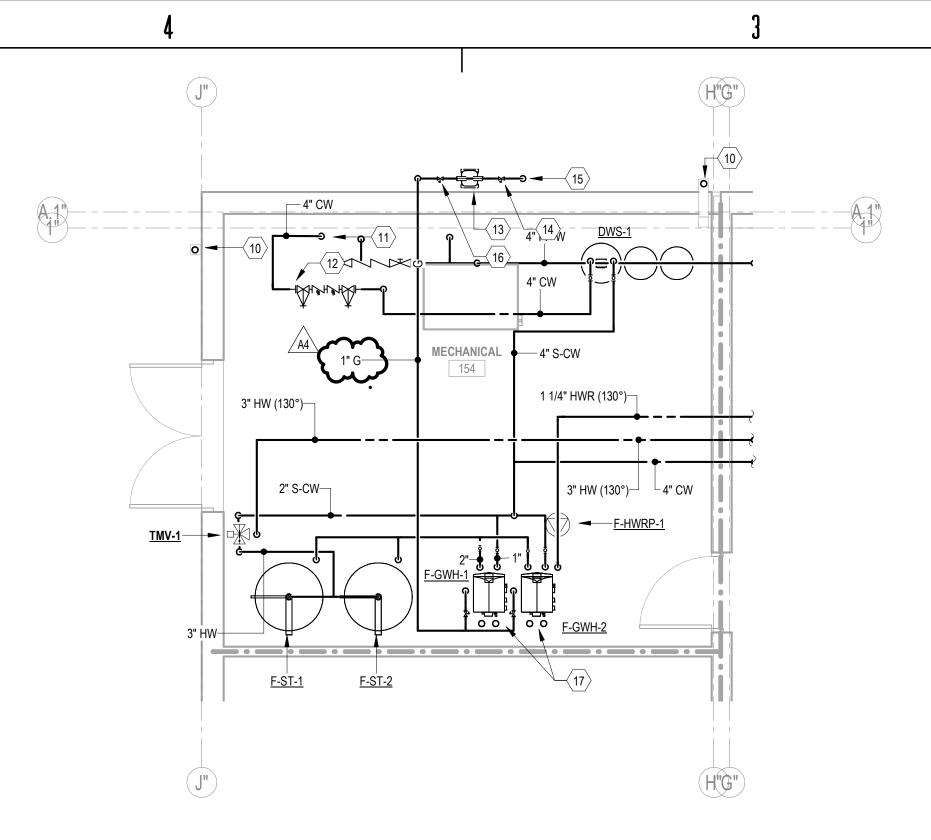


	PLAN NOTES
#	NOTE
1	WATER CLOSET: 1" CW, 4" WASTE DN. & 2" VENT UP.
2	LAVATORY: 1/2" H&CW, 2" WASTE DN. & 1-1/2" VENT UP.
3	ELECTRIC WATER COOLER: 1/2" CW, 1-1/2" WASTE DN. & 1-1/2" VENT UP.
4	MOP SINK: 3/4" H&CW, 3" WASTE DN. & 2" VENT UP.
5	SINK: 1/2" H&CW, 2" WASTE DN. & 1-1/2" VENT UP.
6	COMBO UNIT: 1/2" HW, 1" CW, 4" WASTE DN. & 2" VENT UP.
7	3" VENT UP, 4" VENT THRU ROOF.
8	3/4" CW DROP IN WALL.
9	4" HW (130°), 4" CW, 1-1/4" HWR (130°) AND 3" GAS (5.0 PSI) UP.
10	4" ST. LEADER UP/DN.
11	4" DOMESTIC WATER SERVICE MAIN DN. B.F.F.
12	4" WATER METER & BACKFLOW PRVENTER FOR DOMESTIC WATER.
14	GAS PRESSURE REGULATOR BY GAS UTILITY COMPANY.
15	GAS SERVICE MAIN DN. B.F.G.
16	GAS PRESSURE REGULATOR BY PLUMBING CONTRACTOR. REGULATOR SET TO SPSI.
17	(2) 4" PVC INTAKE/XHAUST VENTS FROM WATER HEATER TO BE ROUTED UP THROUGH ROOF TO OUTSIDE.
18	3" GAS DN. TO BOILER (4000 MBH)
19	1-1/4" GAS DN. TO WATER HEATER (286 MBH)
20	1" MAKE-UP WATER FOR AIR SEPARATOR. SEE MECHANICAL PLANS FOR DETAILS

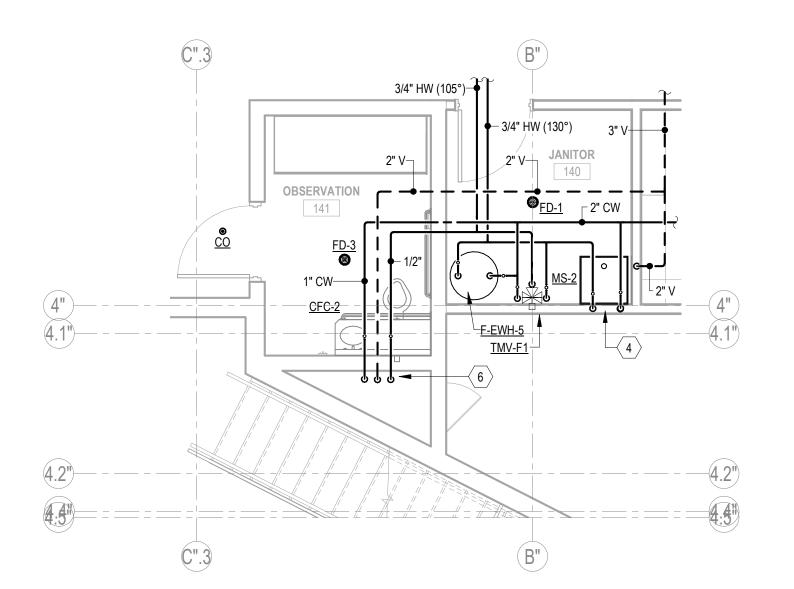



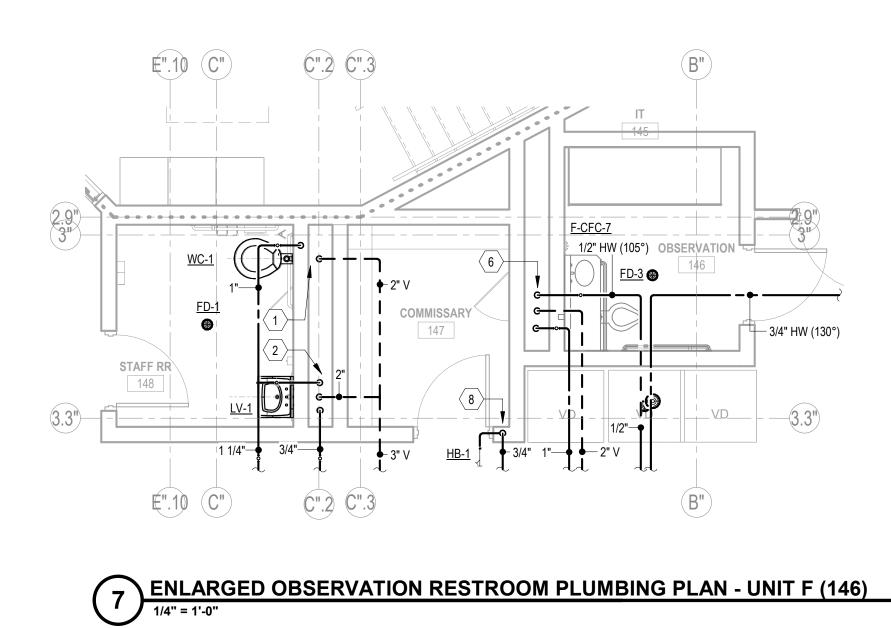

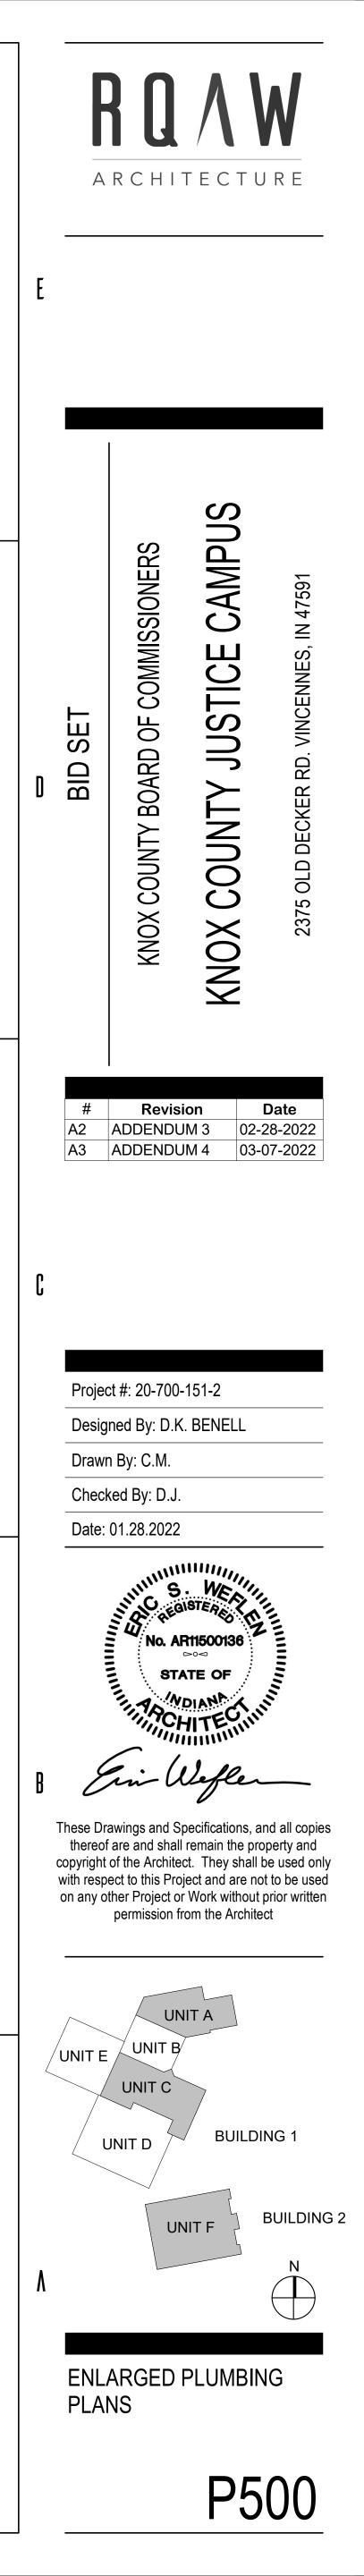

		I	
	PLUMBING FIXTURE SCHEDULE		
TAG	FIXTURE DESCRIPTION	MANUFACTURER	MODEL #
	WATER CLOSET: ADA COMPLIANT, VITREOUS CHINA, WALL-MOUNTED ELONGATED BOWL, 1-1/2" INLET TOP SPUD, LOW-CONSUMPTION 1.6 GPF, DIRECT-FED SIPHON JET ACTION, FULLY-GLAZED 2-1/8" TRAPWAY, 10"x12" WATER, SURFACE AREA, MEETS ASME FLUSH REQUIREMENTS AT 1.6 GPF.	AMERICAN STANDARD	3351.001
	FLUSH VALVE: MANUAL TYPE, CHROME PLATED, SYNTHETIC RUBBER DIAPHRAGM, 1" I.P.S. SCREWDRIVER ANGLE STOP, VACUUM BREAKER FLUSH CONNECTION, SPUD COUPLING AND FLANGE FOR 1-1/2" TOP SPUD, SWEAT SOLDER ADAPTER AND CAST SET SCREW WALL FLANGE, LOW CONSUMPTION 1.6 GPF.	SLOAN	SLOAN 111-XL
WC-1	SEAT: HEAVY WEIGHT AND INJECTION-MOLDED OF SOLID PLASTIC, OPEN FRONT LESS COVER FOR ELONGATED BOWL AND FEATURE EXCLUSIVE, FOUR LARGE MOLDED-IN BUMPERS, CONCEALED CHECK HINGES WITH STAINLESS STEEL POSTS.		
		CHURCH	295CT
	CARRIER: ADJUSTABLE, SIPHON JET WATER CLOSET WITH HUB & SPIGOT CONNECTIONS. CAST IRON MAIN FITTING, WITH 2" VENT, ADJUSTABLE GASKETED FACE PLATE, UNIVERSAL FLOOR MOUNTED FOOT SUPPORTS, CORROSION RESISTANT ADJUSTABLE COUPLING WITH INTEGRAL TEST CAP, FIXTURE BOLTS, TRIM, AN STUD PROTECTORS. REAR ANCHOR TIE DOWN AND BONDED GASKET.	ZURN	SERIES Z1200
	WATER CLOSET: VITREOUS CHINA, WALL-MOUNTED ELONGATED BOWL, 1-1/2" INLET TOP SPUD, LOW-CONSUMPTION 1.6 GPF, DIRECT-FED SIPHON JET ACTION, FULLY-GLAZED 2-1/8" TRAPWAY	AMERICAN STANDARD	3351.001
	FLUSH VALVE: MANUAL TYPE FLUSH VALVE, CHROME PLATED, SYNTHETIC RUBBER DIAPHRAGM, 1" I.P.S. SCREWDRIVER ANGLE STOP, VACUUM BREAKER FLUSH CONNECTION, SPUD COUPLING AND FLANGE FOR 1-1/2" TOP SPUD, SWEAT	SLOAN	SLOAN 111-XL
WC-2	SEAT: HEAVY WEIGHT AND INJECTION-MOLDED OF SOLID PLASTIC, OPEN FRONT LESS COVER FOR ELONGATED BOWL AND FEATURE EXCLUSIVE, FOUR LARGE MOLDED-IN BUMPERS, CONCEALED CHECK HINGES WITH STAINLESS STEEL POSTS.	CHURCH	295CT
	CARRIER: ADJUSTABLE, SIPHON JET WATER CLOSET WITH HUB & SPIGOT CONNECTIONS. CAST IRON MAIN FITTING, WITH 2" VENT, ADJUSTABLE GASKETED FACE PLATE, UNIVERSAL FLOOR MOUNTED FOOT SUPPORTS, CORROSION RESISTANT	ZURN	SERIES Z1200
	LAVATORY: WALL HUNG, 20-1/2" X 18-1/4", VITREOUS CHINA, FRONT OVERFLOW, SELF-DRAINING DECK AREA WITH CONTOURED BACK AND SIDE SPLASH SHIELDS, FAUCET LEDGE, FAUCET HOLES ON 4" CENTERS.	AMERICAN STANDARD	0476.028
LV-1	FAUCET: ELECTRONIC SENSOR, BATTERY-POWERED, 0.5 GPM PRESSURE COMPENSATING AERATOR OUTLET.	DELTA	515LF-HDF
	TRIM: SUPPLY PIPE WITH LOOSE KEY STOPS. CAST BRASS P-TRAP WITH CLEAN-OUT. DRAIN WITH CHROME PLATED CAST BRASS SOLID TOP, OPEN GRID, P.O. PLUG. CHROME PLATED BRASS 17 GAUGE TAILPIECE.	MCGUIRE	165LK, 8902, 149
MS-1	TRIM: 24"x24"x10" MOP BASIN, WALL MOUNTED SERVICE SINK FAUCET, POLISHED CHROME PLATED FINISH, SOLID BRASS BODY CONSTRUCTION, ATMOSPHERIC VACUUM BREAKER SPOUT WITH PAIL HOOK AND WALL BRACE, 3/4" MALE GARDEN HOSE THREAD OUTLET, LEVER HANDLES WITH SECURED COLOR CODED INDEX BUTTONS.	FIAT	MSBIDTG2424
MS-2	TRIM: 24"x24"x10" MOP BASIN, WALL MOUNTED SERVICE SINK FAUCET, POLISHED CHROME PLATED FINISH, SOLID BRASS BODY CONSTRUCTION, ATMOSPHERIC VACUUM BREAKER SPOUT WITH PAIL HOOK AND WALL BRACE, 3/4" MALE GARDEN HOSE THREAD OUTLET, LEVER HANDLES WITH SECURED COLOR CODED INDEX BUTTONS.	FIAT	MSBIDTG2424
	SINK - ADA: 17"X16"X5-1/2" DEEP, ADA, 18 GAUGE, TYPE 304 STAINLESS STEEL, TOP MOUNT, 3 HOLE PUNCH, OFF-SET WASTE TO CENTER/BACK.	ELKAY	LRAD171655
	FAUCET: BAR DECK FAUCET WITH 4" WRIST BLADE LEVER HANDLES.	ELKAY	LKDA2447
SK-1	DRAIN WITH NICKEL PLATED BRASS BODY WITH GRID STRAINER, POLISHED FINISH.	ELKAY	LK35L
	TRIM: SUPPLY PIPE WITH LOOSE KEY STOPS. CAST BRASS P-TRAP WITH CLEAN-OUT. P.O. PLUG. CHROME PLATED BRASS 17 GAUGE TAILPIECE.	MCGUIRE	LK99 & LK35L
	SINK - ADA: 29" x 22" x 5-1/2" DEEP, DOUBLE COMPARTMENT SINK WITH REAR CENTERED WASTE OUTLETS	ELKAY	LRAD292255
	FAUCET: DECK MOUNTED SINGLE HOLE, POLISHED CHROME PLATED FINISH, SOLID BRASS BODY CONSTRUCTION, 1.5 GPM FLOW RATE, , PULL-OUT SPOUT, LEVER HANDLE.	ELKAY	LKE4103
SK-2	DRAIN WITH NICKEL PLATED BRASS BODY WITH GRID STRAINER, POLISHED FINISH.	ELKAY	LK35
	TRIM: SUPPLY PIPE WITH LOOSE KEY STOPS. CAST BRASS P-TRAP WITH CLEAN-OUT. P.O. PLUG. CHROME PLATED BRASS 17 GAUGE TAILPIECE.	MCGUIRE	165LK, 8912
	SINK - ADA: 15"X17-1/2"X 5-1/2" DEEP, 18 GAUGE, TYPE 304 STAINLESS STEEL, TOP MOUNT, 3 HOLE PUNCH WITH CENTER REAR DRAIN	ELKAY	LRAD151755
SK-3	FAUCET: DECK MOUNTED BATTERY-POWERED SENSOR FAUCET, SINGLE HOLE, POLISHED CHROME PLATED FINISH, SOLID BRASS BODY CONSTRUCTION, 1.5 GPM FLOW RATE WITH LAMINAR FLOW SPRAY HEAD.	SLOAN	OPTIMA-PLUS EBF-687-S-4
01/-0	DRAIN WITH NICKEL PLATED BRASS BODY WITH GRID STRAINER, POLISHED FINISH.	ELKAY	LK99 & LK35L
	TRIM: SUPPLY PIPE WITH LOOSE KEY STOPS. CAST BRASS P-TRAP WITH CLEAN-OUT. P.O. PLUG. CHROME PLATED BRASS 17 GAUGE TAILPIECE.	MCGUIRE	165LK, 8912
	SINK: 17" x 16" x 6" DEEP, 18 GAUGE	ELKAY	LRADQ1716
	FAUCET: BAR DECK FAUCET WITH 4" WRIST BLADE LEVER HANDLES.	ELKAY	LKDA2447
SK-4	DRAIN WITH NICKEL PLATED BRASS BODY WITH GRID STRAINER, POLISHED FINISH.	ELKAY	LK99 & LK35L
	TRIM: SUPPLY PIPE WITH LOOSE KEY STOPS. CAST BRASS P-TRAP WITH CLEAN-OUT. P.O. PLUG. CHROME PLATED BRASS 17 GAUGE TAILPIECE.	MCGUIRE	165LK, 8912
	SINK - ADA: 25" x 21-1/4" x 6-1/2" DEEP, 18 GAUGE	ELKAY	LRAD252165
SK-5	FAUCET: BAR DECK FAUCET WITH 4" WRIST BLADE LEVER HANDLES.	ELKAY	LKE4103
	DRAIN WITH NICKEL PLATED BRASS BODY WITH GRID STRAINER, POLISHED FINISH. TRIM: SUPPLY PIPE WITH LOOSE KEY STOPS. CAST BRASS P-TRAP WITH CLEAN-OUT. P.O. PLUG. CHROME PLATED BRASS 17 GAUGE TAILPIECE.	ELKAY MCGUIRE	LK99 & LK35L 165LK, 8912
EWC-1	ELECTRIC WATER COOLER AND BOTTLE FILLER, FILTER AND REFRIGERATED. BI-LEVEL ADA. ANTI-MICROBIAL, HANDS-FREE.	ELKAY	LZSTL8WSVRLK
			STRUMPTICE
~			

	WATER SOFTENER SCHEDULE													
TAG	LOCATION	MAX. EXCHANGE CAP. (GRAINS)	MIN. EXCHANGE CAP. (GRAINS)	CONT. FLOW RATE (GPM)	PEAK FLOW RATE (GPM)	BACK WASH FLOW RATE (GPM)	CU.FT. OF RESIN PER TANK	SALT STORAG (LBS)						
DWS-1	RM. # M154	600,000	400,000	172	222	30	20	550						

TAG	DESCRIPTION	MANUFACTURER MODEL NO.	MOUNTING		FINAL CONN	ECTION SIZES	3	FLOW RATE	REMARKS	NOTES
				CW	105 HW	WASTE	VENT (MIN.)			
CFC-1	18" COMBO UNIT - LIGATURE	WILLOUGHBY #ECW1806	FLOOR	1"	1/2"	4"	2"	1.28 GPF	REAR ACCESS FURNISHED AND INSTALLED BY PLUMBING CONTRACTOR	
CFC-2	49" COMBO UNIT - ADA	WILLOUGHBY #ECW4896	FLOOR	1"	1/2"	4"	2"	1.28 GPF	REAR ACCESS UNIT- POWDER COATED WHITE FURNISHED AND INSTALLED BY THE PLUMBING CONTRACTOR	
CFC-3	49" COMBO UNIT - ADA	WILLOUGHBY #ECW4896-FA	FLOOR	1"	1/2"	4"	2"	1.28 GPF	FRONT ACCESS UNIT FURNISHED AND INSTALLED BY THE PLUMBING CONTRACTOR	
CFC-4	15" COMBO UNIT	WILLOUGHBY #ECW1546	FLOOR	1" 1/2" 4" 2"		1.28 GPF	REAR ACCESS UNIT FURNISHED AND INSTALLED BY THE PLUMBING CONTRACTOR			
CFC-5	48" COMBO UNIT - ADA	WILLOUGHBY #ECW4896	FLOOR	1"	1/2"	4"	2"	1.28 GPF	SHOWER CABINET, TWO SHOWER HEADS AND CONTROLS FURNISHED BY THE CELL MANUFACTURER.	
CFC-6	15" COMBO UNIT	WILLOUGHBY #ECW1546	FLOOR	1"	1/2"	4"	2"	1.28 GPF	FURNISHED AND INSTALLED BY THE CELL MANUFACTURER	
DT-1	DETOX - FLUSHING FLOOR TOILET	WILLOUGHBY #FD-1400	FLOOR	1"		4"	2"	1.6 GPF	FLOOR TOILET SHALL BE CONTROLED BY A WALL MOUNTED FLUSH VALVE LOCTATED IN STAINLESS STEEL WALL BOX	
CFSH-1	SHOWER - ADA	WILLOUGHBY #US-3636-HC-FA	WALL	1/2"	1/2"	2"	-	1.5 GPM	FRONT ACCESS CABINET - WITH RECESSED FRONT ACCESS SHOWER PANEL - FURNISHED AND INSTALLED BY THE PLUMBING CONTRACTOR	
CFSH-2	SHOWER	WILLOUGHBY #US-3636-FA	WALL	1/2"	1/2"	2"	-	1.5 GPM	SHOWER CABINET - FRONT ACCESS RECESSED SHOWER PANEL - FURNISHED AND INSTALLED BY THE PLUMBING CONTRACTOR	
CFSH-3	SHOWER - ADA	WILLOUGHBY	FLOOR	1/2"	1/2"	2"	-	1.5 GPM	SHOWER CABINET, TWO SHOWER HEADS AND CONTROLS FURNISHED BY THE CELL MANUFACTURER. VALVES INSTALLED BY PLUMBING CONTRCTOR	
CFSH-4	SHOWER	WILLOUGHBY	FLOOR	1/2"	1/2"	2"	-	1.5 GPM	SHOWER, SINGLE SHOWER HEAD AND CONTROLS FURNISHED BY THE CELL MANUFACTURER. VALVES INSTALLED BY PLUMBING CONTRCTOR	
CFSH-5	SHOWER	WILLOUGHBY #US-3636	FLOOR	1/2"	1/2"	2"	-	1.5 GPM	SHOWER CABINET REAR ACCESS BY THE PLUMBING CONTRACTOR	
				CORRECTIO	DNAL PLUMBING	FIXTURES -	COMMUNITY CO	RRECTIONS		
F-CFC-7	49" COMBO UNIT - ADA	WILLOUGHBY #ECW4896	FLOOR	1"	1/2"	4"	2"	1.28	REAR ACCESS UNIT- POWDER COATED WHITE FURNISHED AND INSTALLED BY THE PLUMBING CONTRACTOR	
F-CFSH-1	SHOWER - ADA	WILLOUGHBY #US-3636-HC-FA	WALL	1/2"	1/2"	2"	-	1.5 GPM	FRONT ACCESS CABINET - WITH RECESSED FRONT ACCESS SHOWER PANEL - FURNISHED AND INSTALLED BY THE PLUMBING CONTRACTOR	
F-SHC-1	3-COLUMN SHOWER	WILLOUGHBY #CWCSCY-3	FLOOR	3/4"	3/4"	2"	2"	2.5 GPM	ACCESS FROM ABOVE FURNISHED AND INSTALLED BY PLUMBING CONTRACTOR	
F-CFT-1	TOILET - ADA	WILLOUGHBY #ETW-1490	FLOOR	1"	-	4"	2"	1.28 GPF	FURNISHED AND INSTALLED BY PLUMBING CONTRACTOR	
F-CFT-2	TOILET	WILLOUGHBY #ETW-1490	FLOOR	1"	-	4"	2"	1.28 GPF	FURNISHED AND INSTALLED BY PLUMBING CONTRACTOR	
F-WF-1	3-STATION WASH FOUNTAIN	WILLOUGHBY								

TAG	DESCRIPTION	MANUFACTURER MODEL NO.	MOUNTING		FINAL CONN	ECTION SIZES	5	FLOW RATE	REMARKS NO
				CW	105 HW	WASTE	VENT (MIN.)		
CFC-1	18" COMBO UNIT - LIGATURE	WILLOUGHBY #ECW1806	FLOOR	1"	1/2"	4"	2"	1.28 GPF	REAR ACCESS FURNISHED AND INSTALLED BY PLUMBING CONTRACTOR
CFC-2	49" COMBO UNIT - ADA	WILLOUGHBY #ECW4896	FLOOR	1"	1/2"	4"	2"	1.28 GPF	REAR ACCESS UNIT- POWDER COATED WHITE FURNISHED AND INSTALLED BY THE PLUMBING CONTRACTOR
CFC-3	49" COMBO UNIT - ADA	WILLOUGHBY #ECW4896-FA	FLOOR	1"	1/2"	4"	2"	1.28 GPF	FRONT ACCESS UNIT FURNISHED AND INSTALLED BY THE PLUMBING CONTRACTOR
CFC-4	15" COMBO UNIT	WILLOUGHBY #ECW1546	FLOOR	1"	1/2"	4"	2"	1.28 GPF	REAR ACCESS UNIT FURNISHED AND INSTALLED BY THE PLUMBING CONTRACTOR
CFC-5	48" COMBO UNIT - ADA	WILLOUGHBY #ECW4896	FLOOR	1"	1/2"	4"	2"	1.28 GPF	SHOWER CABINET, TWO SHOWER HEADS AND CONTROLS FURNISHED BY THE CELL MANUFACTURER.
CFC-6	15" COMBO UNIT	WILLOUGHBY #ECW1546	FLOOR	1"	1/2"	4"	2"	1.28 GPF	FURNISHED AND INSTALLED BY THE CELL MANUFACTURER
DT-1	DETOX - FLUSHING FLOOR TOILET	WILLOUGHBY #FD-1400	FLOOR	1"		4"	2"	1.6 GPF	FLOOR TOILET SHALL BE CONTROLED BY A WALL MOUNTED FLUSH VALVE LOCTATED IN STAINLESS STEEL WALL BOX
CFSH-1	SHOWER - ADA	WILLOUGHBY #US-3636-HC-FA	WALL	1/2"	1/2"	2"	-	1.5 GPM	FRONT ACCESS CABINET - WITH RECESSED FRONT ACCESS SHOWER PANEL - FURNISHED AND INSTALLED BY THE PLUMBING CONTRACTOR
CFSH-2	SHOWER	WILLOUGHBY #US-3636-FA	WALL	1/2"	1/2"	2"	-	1.5 GPM	SHOWER CABINET - FRONT ACCESS RECESSED SHOWER PANEL - FURNISHED AND INSTALLED BY THE PLUMBING CONTRACTOR
CFSH-3	SHOWER - ADA	WILLOUGHBY	FLOOR	1/2"	1/2"	2"	-	1.5 GPM	SHOWER CABINET, TWO SHOWER HEADS AND CONTROLS FURNISHED BY THE CELL MANUFACTURER. VALVES INSTALLED BY PLUMBING CONTRCTOR
CFSH-4	SHOWER	WILLOUGHBY	FLOOR	1/2"	1/2"	2"	-	1.5 GPM	SHOWER, SINGLE SHOWER HEAD AND CONTROLS FURNISHED BY THE CELL MANUFACTURER. VALVES INSTALLED BY PLUMBING CONTRCTOR
CFSH-5	SHOWER	WILLOUGHBY #US-3636	FLOOR	1/2"	1/2"	2"	-	1.5 GPM	SHOWER CABINET REAR ACCESS BY THE PLUMBING CONTRACTOR
				CORRECTIC	DNAL PLUMBING	G FIXTURES -	COMMUNITY CO	RRECTIONS	
F-CFC-7	49" COMBO UNIT - ADA	WILLOUGHBY #ECW4896	FLOOR	1"	1/2"	4"	2"	1.28	REAR ACCESS UNIT- POWDER COATED WHITE FURNISHED AND INSTALLED BY THE PLUMBING CONTRACTOR
F-CFSH-1	SHOWER - ADA	WILLOUGHBY #US-3636-HC-FA	WALL	1/2"	1/2"	2"	-	1.5 GPM	FRONT ACCESS CABINET - WITH RECESSED FRONT ACCESS SHOWER PANEL - FURNISHED AND INSTALLED BY THE PLUMBING CONTRACTOR
F-SHC-1	3-COLUMN SHOWER	WILLOUGHBY #CWCSCY-3	FLOOR	3/4"	3/4"	2"	2"	2.5 GPM	ACCESS FROM ABOVE FURNISHED AND INSTALLED BY PLUMBING CONTRACTOR
F-CFT-1	TOILET - ADA	WILLOUGHBY #ETW-1490	FLOOR	1"	-	4"	2"	1.28 GPF	FURNISHED AND INSTALLED BY PLUMBING CONTRACTOR
F-CFT-2	TOILET	WILLOUGHBY #ETW-1490	FLOOR	1"	-	4"	2"	1.28 GPF	FURNISHED AND INSTALLED BY PLUMBING CONTRACTOR
F-WF-1	3-STATION WASH FOUNTAIN	WILLOUGHBY	FLOOR	3/4"	3/4"	2"	2"		FURNISHED AND INSTALLED BY PLUMBING CONTRACTOR

			PLUMBING E	QUIPMENT SC	CHEDUI	LE						
TAG	DESCRIPTION	MANUFACTURER / MODEL	/ CAPACITY	ELECTRICAL REQUIREMENTS			(SEE SPECIFI	REMARKS ICATIONS FOR ADDITION	IAL REQUIREMENTS)			
WH-1	WALL HYDRANT	J.R. SMITH # 5509-	QT			V		O ON PLUMBING DRAWINGS, MOUNT BOX IN EXTERIOR BRICK, MIN. OF 24" ABOVE FIN. GRADE				
HB-1	HOSE BIBB	J.R. SMITH # 551	8				WALL	MOUNTED BOX - MILD C	LIMATE TYPE			
HB-2	HOSE BIBB	J.R. SMITH # 557	5					LOCATED IN CELL CH	IASE			
HB-3	HOSE BIBB	J.R. SMITH # 567	2				L	OCATED IN MECHANICAL	ROOMS			
HWCP-1	HOT WATER CIRCULATING PUMP	B&G		120V/1 PH.			pod: to maintain s	STORAGE TANKS WATER	R TEMPERATURE @ 140 (deg.		
HWCP-2	HOT WATER CIRCULATING PUMP	B&G		120V/1 PH.				KITCHEN:				
DCV-1	DUAL CHECK VALVE	WATTS # LF7R				UNIT SHALL BE LINE SIZE						
FWD-1	FOOD WASTE DISPOSAL	INSINKERATOR - EME BADGER 5	RSON	120V/1 PH. 6.9 AMPS.			INSTA	ALL IN BREAKROOM #A12	0 - SINK SK-2			
W	ATER HAMMER ARRESTC	RSCHEDULE			F	PLUMBI	NG FIXTURE F	ROUGH-IN SCI	HEDULE			
PDI SYMBOL	FIXTURE UNITS CONNECTED			FIXTURE		ASTE	TRAP	VENT	COLD	HOT		
A	1 - 11	3/4"		WC-1	4	4"	INTEGRAL	2"	1"			
В	12 - 32	1"		WC-2	4	4"	INTEGRAL	2"	1"			
С	33 - 60	1"		UR-1	2	2"	INTEGRAL	1-1/2"	3/4"			

PDI SYMBOL	
А	
В	
С	
D	
E	
F	
NOTES: CONTRA	ACTOR TO V

	HOT WATER STORAGE TANK SCHEDULE													
TAG	ROOM LOCATION	TYPE	GALLON CAPACITY	TANK WIDTH	tank Height	WEIGHT	MANUFACTURER	MODEL #						
A-ST-1	ST-1 1532 VER		119	29-1/2"	62"	352	LOCHINVAR	RJS120M						
A-ST-2	1532	VERTICAL	119	29-1/2"	62"	352	LOCHINVAR	RGS120M						
D-ST-1	1659	VERTICAL	318	40"	80"	987	LOCHINVAR	RJA0318						
D-ST-2	1659	VERTICAL	318	40"	80"	987	LOCHINVAR	RJA0318						
F-ST-1	MECH. 154	VERTICAL	257	34"	91"	904	LOCHINVAR	RJA0257						
F-ST-2	MECH. 154	VERTICAL	257	34"	91"	904	LOCHINVAR	RJA0257						

			Tŀ	IERM	OSTATI	C MIXING VAL	VE SCHE	EDULE
TAG	Maximum GPM	PRESSURE DROP (PSI)	COLD INLET SIZE	HOT INLET SIZE	MIXED OUTLET SIZE	MANUFACTURER	MODEL #	NOTES
TMV-1	85	20	2"	2"	2"	LAWLER	66-125	SET DISCHARGE TEMPERATURE TO 130°F
TMV-2	34	20	1-1/4"	1-1/4"	1-1/2"	LAWLER	801	SET DISCHARGE TEMPERATURE TO 105°F
TMV-3	34	20	3/4"	3/4"	1"	LAWLER	801	SET DISCHARGE TEMPERATURE TO 105°F
TMV-4	14	20	3/4"	3/4"	3/4"	LAWLER	61-25	SET DISCHARGE TEMPERATURE TO 105°F
TMV-F1	14	20	3/4"	3/4"	3/4"	LAWLER	61-25	SET DISCHARGE TEMPERATURE TO 105°F
TMV-F2	34	20	3/4"	3/4"	1"	LAWLER	801	SET DISCHARGE TEMPERATURE TO 105°F
TMV-F3	14	20	3/4"	3/4"	1"	LAWLER	61-25	SET DISCHARGE TEMPERATURE TO 105°F
TMV-F4	7	20	1/2"	1/2"	1/2"	LAWLER	61-25	SET DISCHARGE TEMPERATURE TO 105°F

1"

1"

1"

							PUMP	SCHEDULE	
TAG	LOCATION	ELECTRIC			GPM	FEET OF HEAD	MANUFACTURER		NOTES
	VOLT	PHASE	POWER	GPIM	FEET OF HEAD	MANUFACIURER	MODEL #	NOTES	
A-HWRP-1	RM: 1535	120	1	125 WATTS	-	12	BELL & GOSSET	NBF-25	PART #103418LF. FLANGE CONNECTION 3/4, 1-1/4", 1-1/2"
D-HWRP-1	RM: 1661	120	1	125 WATTS	-	12	BELL & GOSSET	NBF-25	PART #103418LF. FLANGE CONNECTION 3/4, 1-1/4", 1-1/2"
F-HWRP-1	IWRP-1 MECH 154 120 1 270 WATTS 10 20 BELL & GOSSET		BELL & GOSSET	NBF-36	PART #103401LF. FLANGE CONNECTION 1-1/4"				
A-CP-1	RM:1535	120	1	4.7 AMPS	20.0	10	GRUNDFOS	UPS43-100F	CIRCULATING PUMP: PROVIDED BY WATER HEATER MANUFACTURER, INSTALLED EXTERNAL OF HEATER.
A-CP-2	RM:1535	120	1	4.7 AMPS	20.0	10	GRUNDFOS	UPS43-100F	CIRCULATING PUMP: PROVIDED BY WATER HEATER MANUFACTURER, INSTALLED EXTERNAL OF HEATER.

						DOMESTIC	C WATER HE	ATER SCH	HEDULE				
TAG	LOCATION	ELEC	CTRIC	- BTU INPUT MBH	MINIMUM	GALLONS OF	RECOVERY	EXHAUST	INTAKE SIZE	LOCATION	MANUFACTURER	MODEL #	NOTES
TAG	LOCATION	VOLT	PHASE		EFFICIENCY	STORAGE	AT 100°F	SIZE	INTARE SIZE	LUCATION	MANUFACIURER	WODEL#	NOTES
A-GWH-1	MECH. 1532	120	1	199,000.00	95%	-	232	4"	4"		LOCHINVAR	AWN200PM	
A-GWH-2	MECH. 1532	120	1	199,000.00	95%	-	232	4"	4"		LOCHINVAR	AWN200PM	
D-GWH-1	MECH. 1659	120	1	285,000.00	95%	-	332	4"	4"		LOCHINVAR	AWN286PM	
D-GWH-2	MECH. 1659	120	1	285,000.00	95%	-	332	4"	4"		LOCHINVAR	AWN286PM	
D-EWH-1	JAN. 1607	208	1	ELECTRIC		30	11				LOCHINVAR	JEJ030GS	MOUNT UNIT ON WALL
F-GWH-1	MECH. 154	120	1	199,000.00	95%	-	232	4"	4"		LOCHINVAR	AWN200PM	
F-GWH-2	MECH. 154	120	1	199,000.00	95%	-	232	4"	4"		LOCHINVAR	AWN200PM	
F-EWH-1 & 5	JAN. 109 & 140	208	1	ELECTRIC		40	19	-	-		LOCHINVAR	ESX040KD	MOUNT UNIT ABOVE CLG., 4.5KW
F-EWH-2 & 3	RR 104 & 114	208	1	ELECTRIC		20	12	-	-		LOCHINVAR	EJW020FS	MOUNT ABOVE CLG. 3KW
F-EWH-4	JAN. 132	208	1	ELECTRIC		30	19	-	-		LOCHINVAR	ESX030KD	MOUNT UNIT ABOVE CLG., 4.5KW

	FLOOR DRAIN SCHEDULE		
TAG	DRAIN DESCRIPTION	MANUFACTURER	MODEL
FD-1	FLOOR DRAIN: ADJUSTABLE CAST IRON BODY, ROUND NICKEL BRONZE STRAINER. CAULK OUTLET. SURESEAL INLINE FLOOR DRAIN TRAP SEALER.	J.R. SMITH	2005-Y02-NB
FD-2	FLOOR DRAIN: CAST IRON BODY, WITH 8" DIAMETER STRAINER,	J.R. SMITH	2008-YO2-NB
FD-3	FLOOR DRAIN: ADJUSTABLE CAST IRON BODY, ROUND NICKEL BRONZE STRAINER. CAULK OUTLET. SURESEAL INLINE FLOOR DRAIN TRAP SEALER. SECURE STRAINER WITH TORX SCREWS.	J.R. SMITH	2005-Y02-NB
FD-4	FLOOR DRAIN: CAST IRON BODY WITH 3" WASTE CONNECTION, 5" STRAINER AND 4" FUNNEL.	J.R. SMITH	2041
FD-5	FLOOR DRAIN: LARGE CAPACITY DRAIN, CAST IRON BODY. WITH BOTTOM DOME STRAINER AND 3" WASTE OUTLET.	J.R. SMITH	3200Y-12
FD-6	FLOOR DRAIN: CAST-IRON BODY, MEDIUM DUTY DRAIN (MAX. 5,000 lbs), HINGED GRATE, SEDIMENT BUCKET.	J.R. SMITH	2478C
FS-1	FLOOR SINK: 12" SQUARE CAST-IRON BODY, 10" DEEP, ACID RESISTANT ENAMEL, ANTISPLASH DOME STRAINER WITH FLANGE. 1/2" GRATE, DOME STRAINER	J.R. SMITH	3441-12-C
TD-1	TRENCH DRAIN @ ADA SHOWER AREA: STAINLESS STEEL TRENCH DRAIN (V-BOTTOM) W/ STAINLESS STEEL GRATE. INSTALL WITH TAMPER RESISTANT STAINLESS STEEL BOLTS AND RECESSED AREA FOR LOCKING DEVICES. TRENCH SHALL BE 36" LONG WITH 3" WIDE STAINLESS STEEL GRATING. GRATE SHALL BE LOCKED INTO CHANNEL WITH VANDAL RESISTANT STAINLESS STEEL BOLTS AND LOCKING DEVICES. SHIPS W/ PLYWOOD TOP FOR EASY MAINTENANCE DURING CONSTRUCTION.	DURATRENCH	DTSS2-03BW48SSA-INTE GRAL-GLWCB2-SLWD-2B
TD-2	TRENCH DRAIN @ INMATE RESTROOM DOORWAY AREA: STAINLESS STEEL TRENCH DRAIN (V-BOTTOM) W/ STAINLESS STEEL GRATE. INSTALL WITH TAMPER RESISTANT STAINLESS STEEL BOLTS AND RECESSED AREA FOR LOCKING DEVICES. TRENCH SHALL BE 42" LONG WITH 3" WIDE STAINLESS STEEL GRATING. GRATE SHALL BE LOCKED INTO CHANNEL WITH VANDAL RESISTANT STAINLESS STEEL BOLTS AND LOCKING DEVICES. SHIPS W/ PLYWOOD TOP FOR EASY MAINTENANCE DURING CONSTRUCTION.	DUTRATRENCH	DTSS2-03BW48SSA-INTE GRAL-GLWCB2-SLWD-2B
AD-1	AREA DRAIN: INDOOR RECREATION AREA. DUCO CAST-IRON BODY WITH CAST-IRON GRATE AND SEDIMENT BUCKET. OUTLET PIPE SIZE = 3"	J.R.SMITH	2210Y-U
	BACKFLOW PREVENTOR SCHEDULE		

				BA	CKFLOW PRE	/ENTOR SCHED	ULE					
TAG	SERVICE	SIZE		TYPE	MANUFACTURER	MODEL #	LOCATION	NOTES				
D-BFP-1	DOMESTIC WATER	1"	REDUCED PRE	SSURE ZONE ASSEMBLIES	WATTS	SERIES LF909	RM. # 1631	INSTALL WITH AIR GAP, ELBOWS, TEST COCKS AND NON-RISING STEAM GATE VALVES.				
F-BFP-1	DOMESTIC WATER	4"	REDUCED PRE	SSURE ZONE ASSEMBLIES	WATTS	SERIES LF909 LARGE	RM. # 185	INSTALL WITH AIR GAP, ELBOWS, TEST COCKS AND NON-RISING STEAM GATE VALVES.				
TOTAL TANK VOLUME (GALLONS)	LOCATION	INLET	ACCEPTANCE VOLUME GALLONS	EXP/ MANUFACTURER	MODEL #	NOTES						
53	1532	1"	34.5	BELL& GOSSETT	1BN057	HORIZONTAL TANK:	HORIZONTAL TANK: CHARGE TO INCOMING WATER PRESSURE AFTER REDUCED PRESSURE BACKFLOW PREVENTER					
53	1659	1"	34.5	BELL& GOSSETT	1BN057	HORIZONTAL TANK:	CHARGE TO INCOM	/ING WATER PRESSURE AFTER REDUCED PRESSURE BACKFLOW PREVENTER				
53	154	1"	34.5	BELL& GOSSETT	1BN057	HORIZONTAL TANK:	HORIZONTAL TANK: CHARGE TO INCOMING WATER PRESSURE AFTER REDUCED PRESSURE BACKFLOW PREVENTER					

					BA		ENTOR SCHEL	JULE						
	TAG	SERVICE	SIZE		TYPE	MANUFACTURER	MODEL #	LOCATION	NOTES					
	D-BFP-1	DOMESTIC WATER	1"	REDUCED PRES	SSURE ZONE ASSEMBLIES	WATTS	SERIES LF909	RM. # 1631	INSTALL WITH AIR GAP, ELBOWS, TEST COCKS AND NON-RISING STEAM GATE VALVES.					
	F-BFP-1	DOMESTIC WATER	4"	REDUCED PRES	SSURE ZONE ASSEMBLIES	WATTS	SERIES LF909 LARGE	RM. # 185	INSTALL WITH AIR GAP, ELBOWS, TEST COCKS AND NON-RISING STEAM GATE VALVES.					
	EXPANSION TANK SCHEDULE													
TAG	TOTAL TANK VOLUME (GALLONS)	LOCATION	INLET	ACCEPTANCE VOLUME GALLONS	MANUFACTURER	MODEL #	NOTES							
A-ET-1	53	1532	1"	34.5	BELL& GOSSETT	1BN057	HORIZONTAL TANK	: CHARGE TO INCOM	ING WATER PRESSURE AFTER REDUCED PRESSURE BACKFLOW PREVENTER					
D-ET-1	53	1659	1"	34.5	BELL& GOSSETT	1BN057	HORIZONTAL TANK	: CHARGE TO INCOM	ING WATER PRESSURE AFTER REDUCED PRESSURE BACKFLOW PREVENTER					
F-ET-1	53	154	1"	34.5	BELL& GOSSETT	1BN057	HORIZONTAL TANK	: CHARGE TO INCOM	ING WATER PRESSURE AFTER REDUCED PRESSURE BACKFLOW PREVENTER					

T STORAGE (LBS) PIPE SIZE MANUFACTURER MODEL # NOTES PURITAN CAT60-WS3 DUAL RESIN TANK WITH BRINE TANK 3"

VERIFY FIXTURE UNITS CONNECTED


61 - 113


114 - 154

155 - 330

T WATER STORAGE TANK SCHEDULE TYPE GALLON CAPACITY TANK WIDTH TANK HEIGHT WEIGHT MANUFACTURER MODEL # RTICAL 119 29-1/2" 62" 352 LOCHINVAR RJS120M RTICAL 119 29-1/2" 62" 352 LOCHINVAR RGS120M RTICAL 318 40" 80" 987 LOCHINVAR RJA0318 ERTICAL 318 40" 80" 987 LOCHINVAR RJA0318 ERTICAL 257 34" 91" 904 LOCHINVAR RJA0257


6.9 AMPS.		INSTAL	L IN BREAKROOM #A12	U - SINK SK-2	
	PLUMB	ING FIXTURE R	OUGH-IN SCI	HEDULE	
FIXTURE	WASTE	TRAP	VENT	COLD	HOT
WC-1	4"	INTEGRAL	2"	1"	
WC-2	4"	INTEGRAL	2"	1"	
UR-1	2"	INTEGRAL	1-1/2"	3/4"	
LV-1	1-1/2"	1-1/4"	1-1/2"	1/2"	1/2"
MS-1	3"	3"	1-1/2"	3/4"	3/4"
MS-2	3"	3"	1-1/2"	3/4"	3/4"
EWC-1	1-1/2"	NA	1-1/2"	1/2"	
SH-1	2"	2"	1-1/2"	1/2"	1/2"
SHC-1	2"	2"	1-1/2"	3/4"	3/4"
SK-1 (TYP.)	1-1/2"	1-1/2"	1-1/2"	1/2"	1/2"
SK-2	2"	1-1/2"	1-1/2"	3/4"	3/4"
LT-1	2"	2"	1-1/2"	3/4"	3/4"

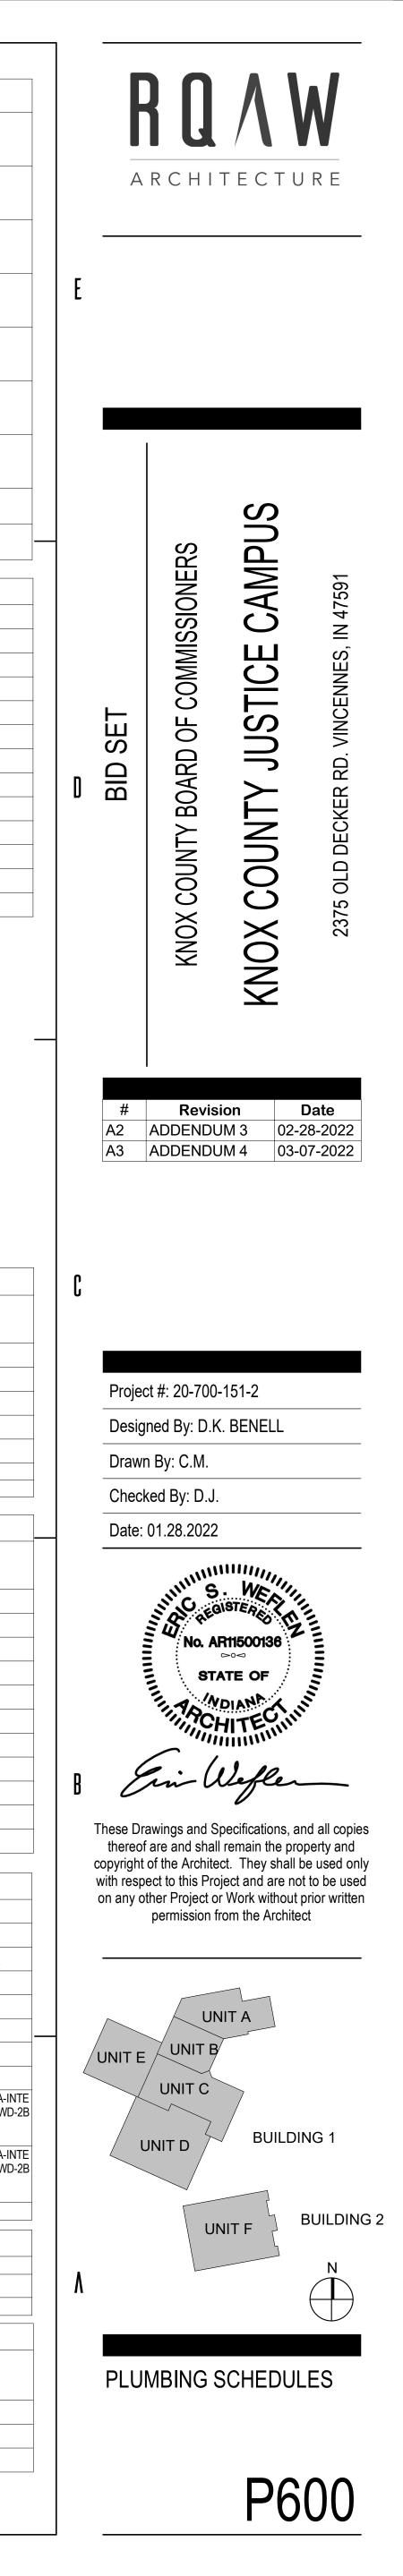


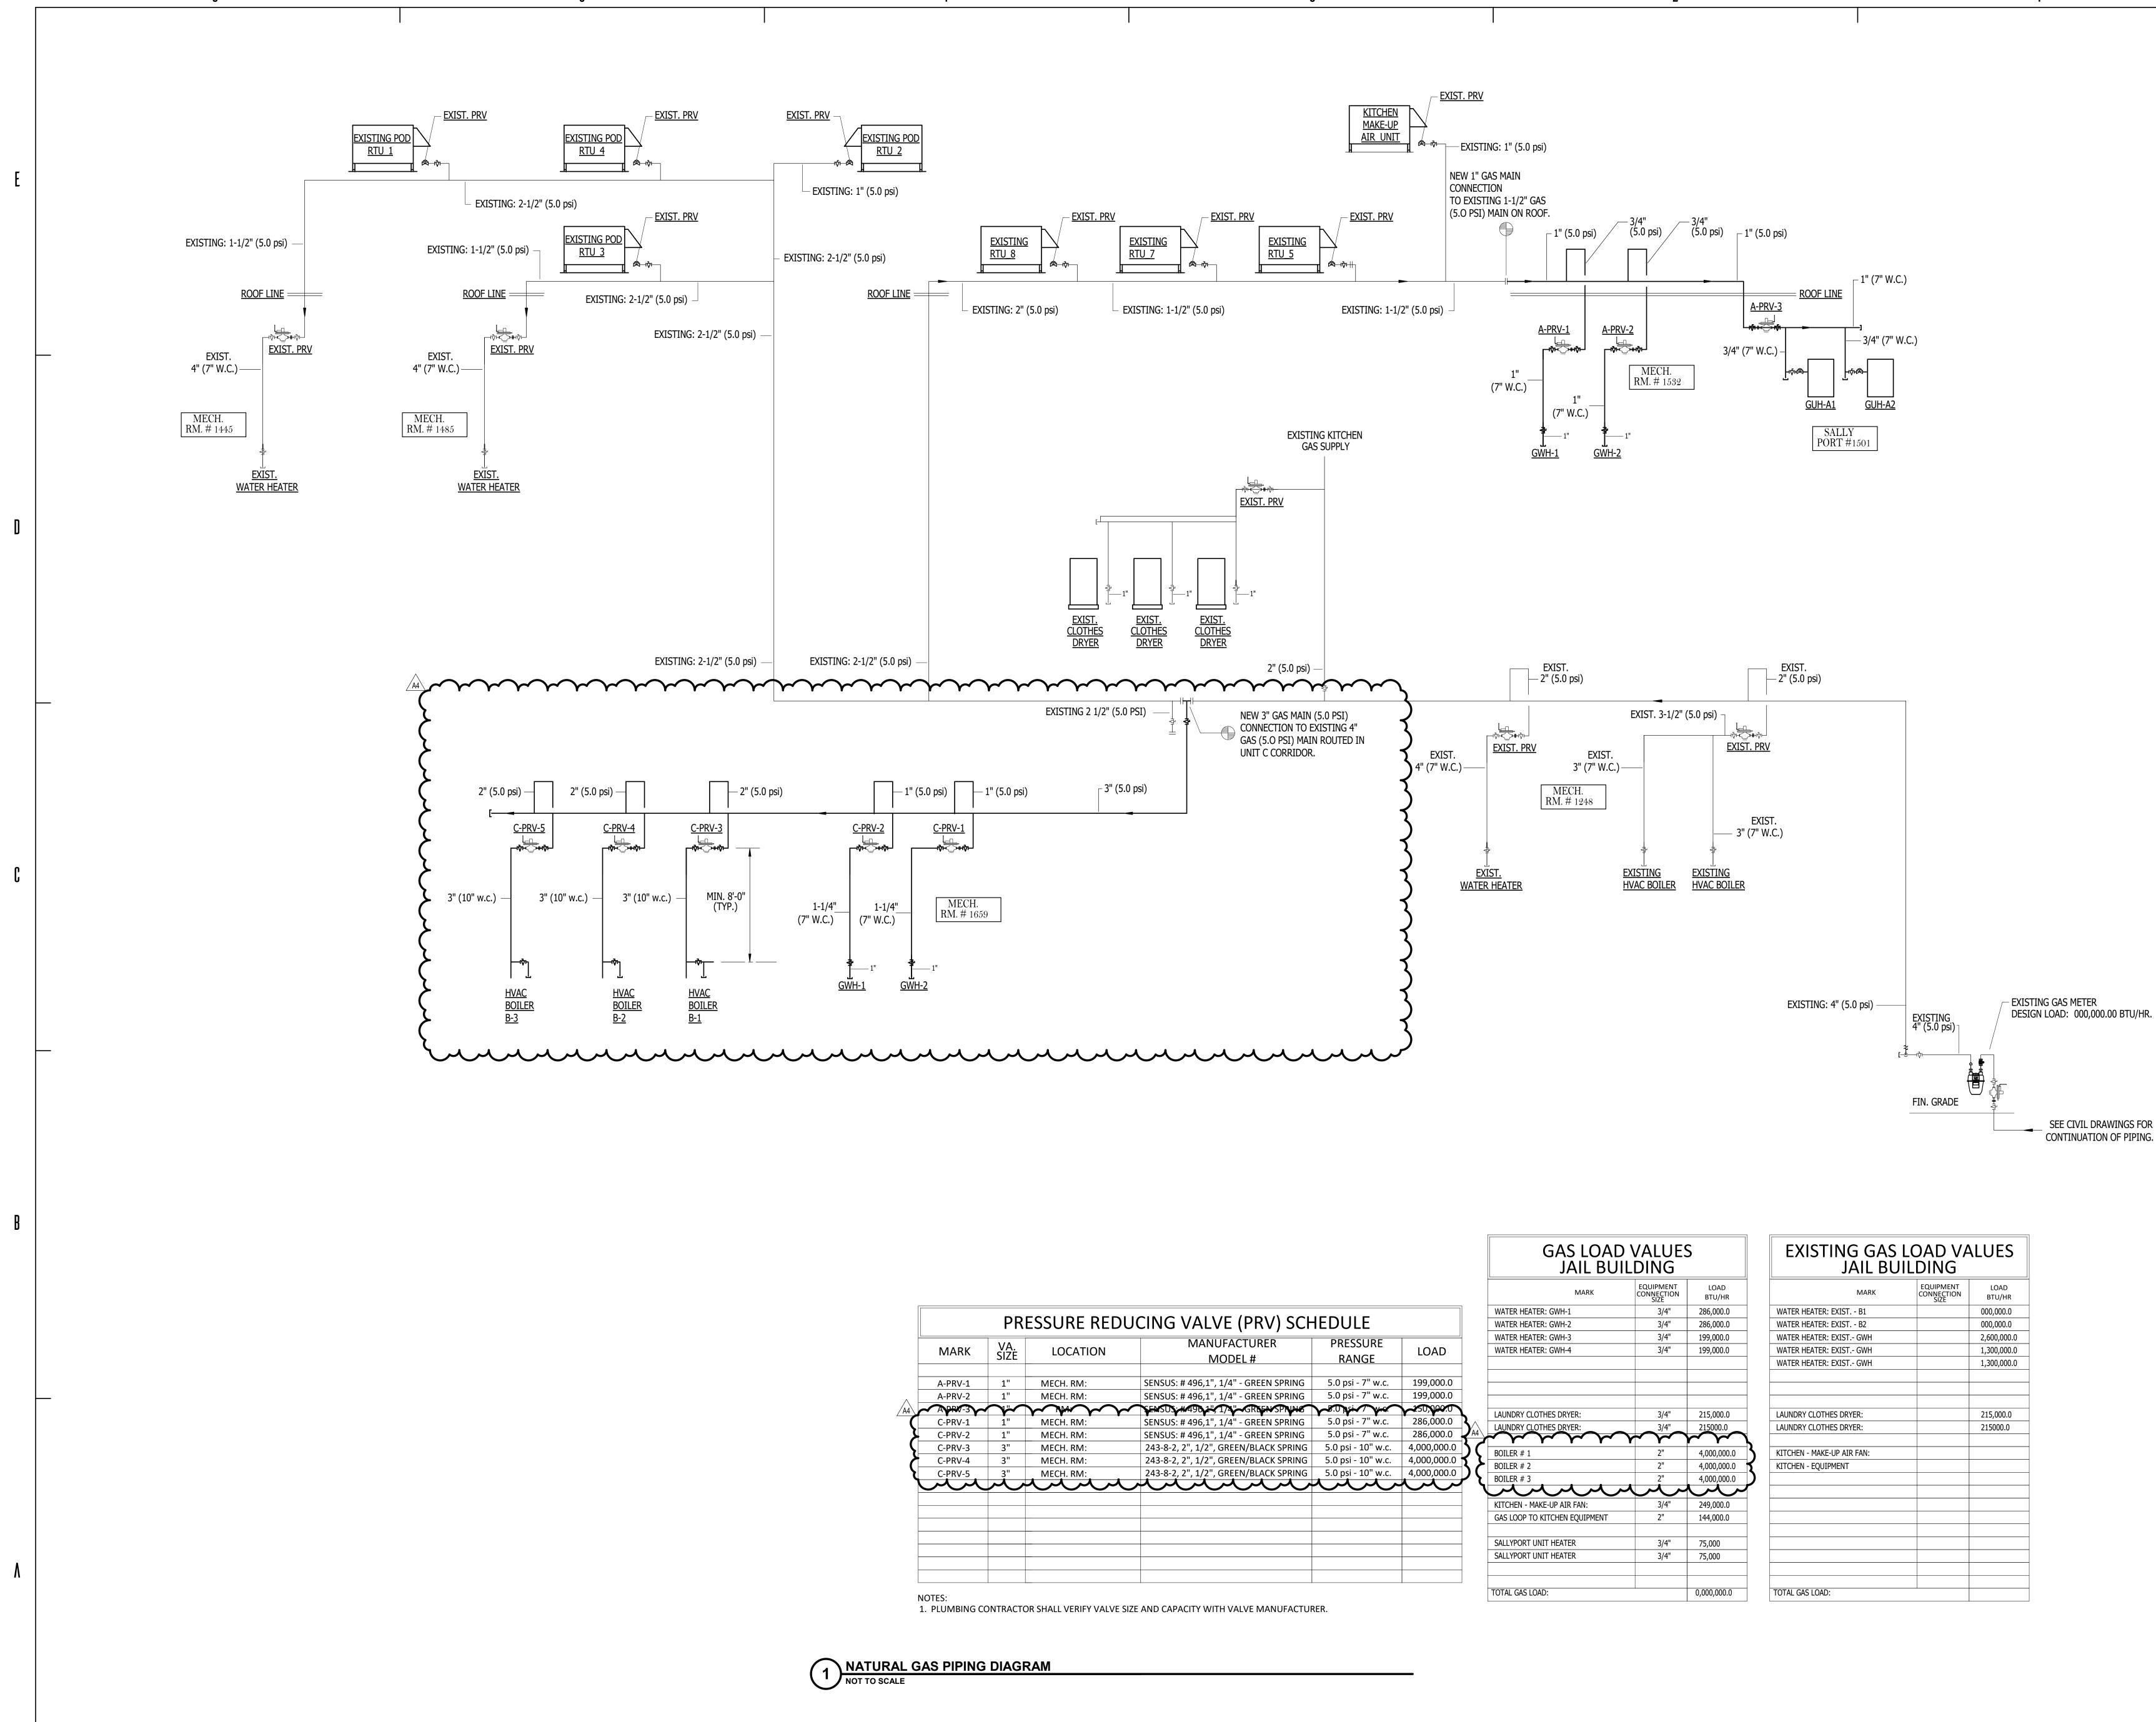


						GAS LOAI JAIL BU		5	EXISTING GAS LOAD VALUES JAIL BUILDING			
						MARK	EQUIPMENT CONNECTION SIZE	LOAD BTU/HR	MARK	EQUIPMENT CONNECTION SIZE	LOAD BTU/HR	
						WATER HEATER: GWH-1	3/4"	286,000.0	WATER HEATER: EXIST B1		000,000.0	
	PRI	ESSURE RED	UCING VALVE (PRV) SCH	IEDULE		WATER HEATER: GWH-2	3/4"	286,000.0	WATER HEATER: EXIST B2		000,000.0	
	\/A		MANUFACTURER	PRESSURE		WATER HEATER: GWH-3	3/4"	199,000.0	WATER HEATER: EXIST GWH		2,600,000	
MARK	VA. SIZE	LOCATION			LOAD	WATER HEATER: GWH-4	3/4"	199,000.0	WATER HEATER: EXIST GWH		1,300,000	
	JIZE		MODEL #	RANGE					WATER HEATER: EXIST GWH		1,300,000	
A-PRV-1	1"	MECH. RM:	SENSUS: # 496,1", 1/4" - GREEN SPRING	5.0 psi - 7" w.c.	199,000.0							
A-PRV-2	1"	MECH. RM:	SENSUS: # 496,1", 1/4" - GREEN SPRING	5.0 psi - 7" w.c.	199,000.0							
APR/-3			FMSUS #490,1", 174" GROFAUSPNAK	B.Opsin 7 www.	250,000.0	LAUNDRY CLOTHES DRYER:	3/4"	215,000.0	LAUNDRY CLOTHES DRYER:		215,000.	
C-PRV-1	1"	MECH. RM:	SENSUS: # 496,1", 1/4" - GREEN SPRING	5.0 psi - 7" w.c.	286,000.0	LAUNDRY CLOTHES DRYER:	3/4"	215,000.0	LAUNDRY CLOTHES DRYER:		215,000.	
C-PRV-2	1"	MECH. RM:	SENSUS: # 496,1", 1/4" - GREEN SPRING	5.0 psi - 7" w.c.	286,000.0						215000.0	
C-PRV-3	3"	MECH. RM:	243-8-2, 2", 1/2", GREEN/BLACK SPRING	5.0 psi - 10" w.c.	4,000,000.0	BOILER # 1	2"	4,000,000.0	KITCHEN - MAKE-UP AIR FAN:			
C-PRV-4	3"	MECH. RM:	243-8-2, 2", 1/2", GREEN/BLACK SPRING	5.0 psi - 10" w.c.	4,000,000.0	BOILER # 2	2"	4,000,000.0	KITCHEN - EQUIPMENT			
C-PRV-5	3"	MECH. RM:	243-8-2, 2", 1/2", GREEN/BLACK SPRING	5.0 psi - 10" w.c.	4,000,000.0	BOILER # 3	2"	4,000,000.0				
\mathcal{M}			mmm			Lunn						
						KITCHEN - MAKE-UP AIR FAN:	3/4"	249,000.0				
						GAS LOOP TO KITCHEN EQUIPMENT	2"	144,000.0				
						SALLYPORT UNIT HEATER	3/4"	75,000				
						SALLYPORT UNIT HEATER	3/4"	75,000				
							-, .					
DTES:		-				TOTAL GAS LOAD:		0,000,000.0	TOTAL GAS LOAD:			

_ SEE CIVIL DRAWINGS FOR CONTINUATION OF PIPING.

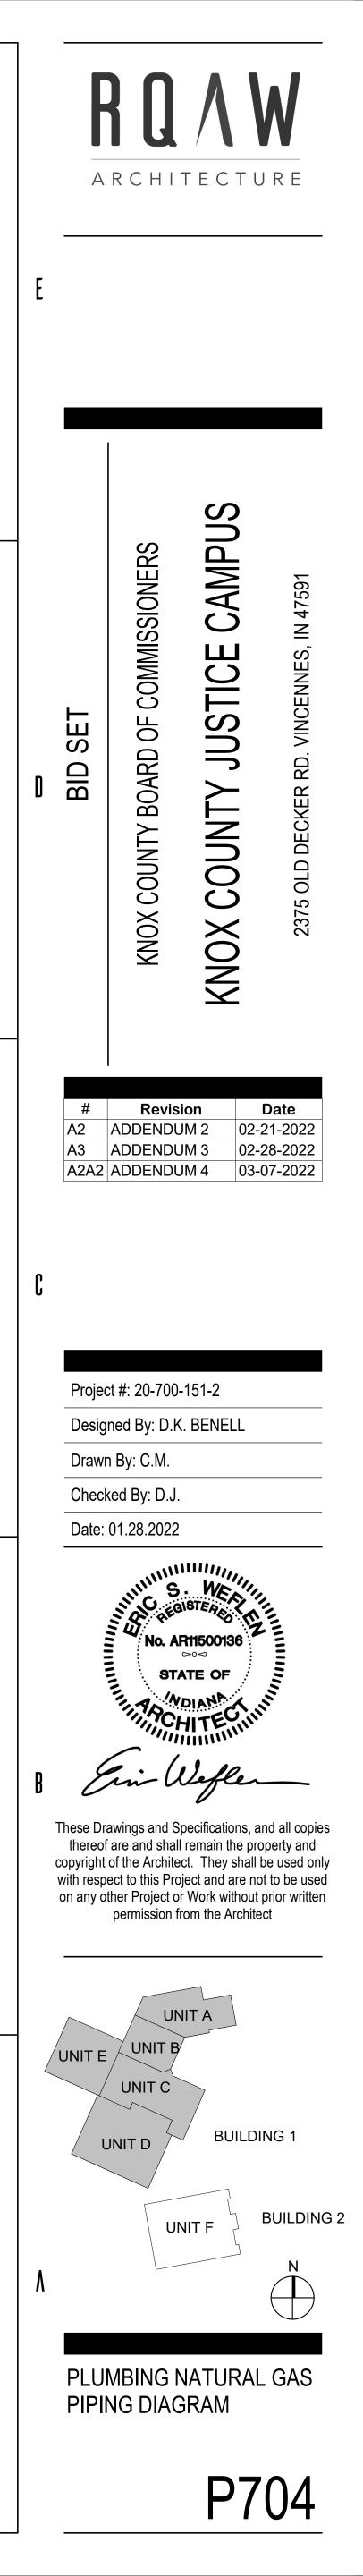

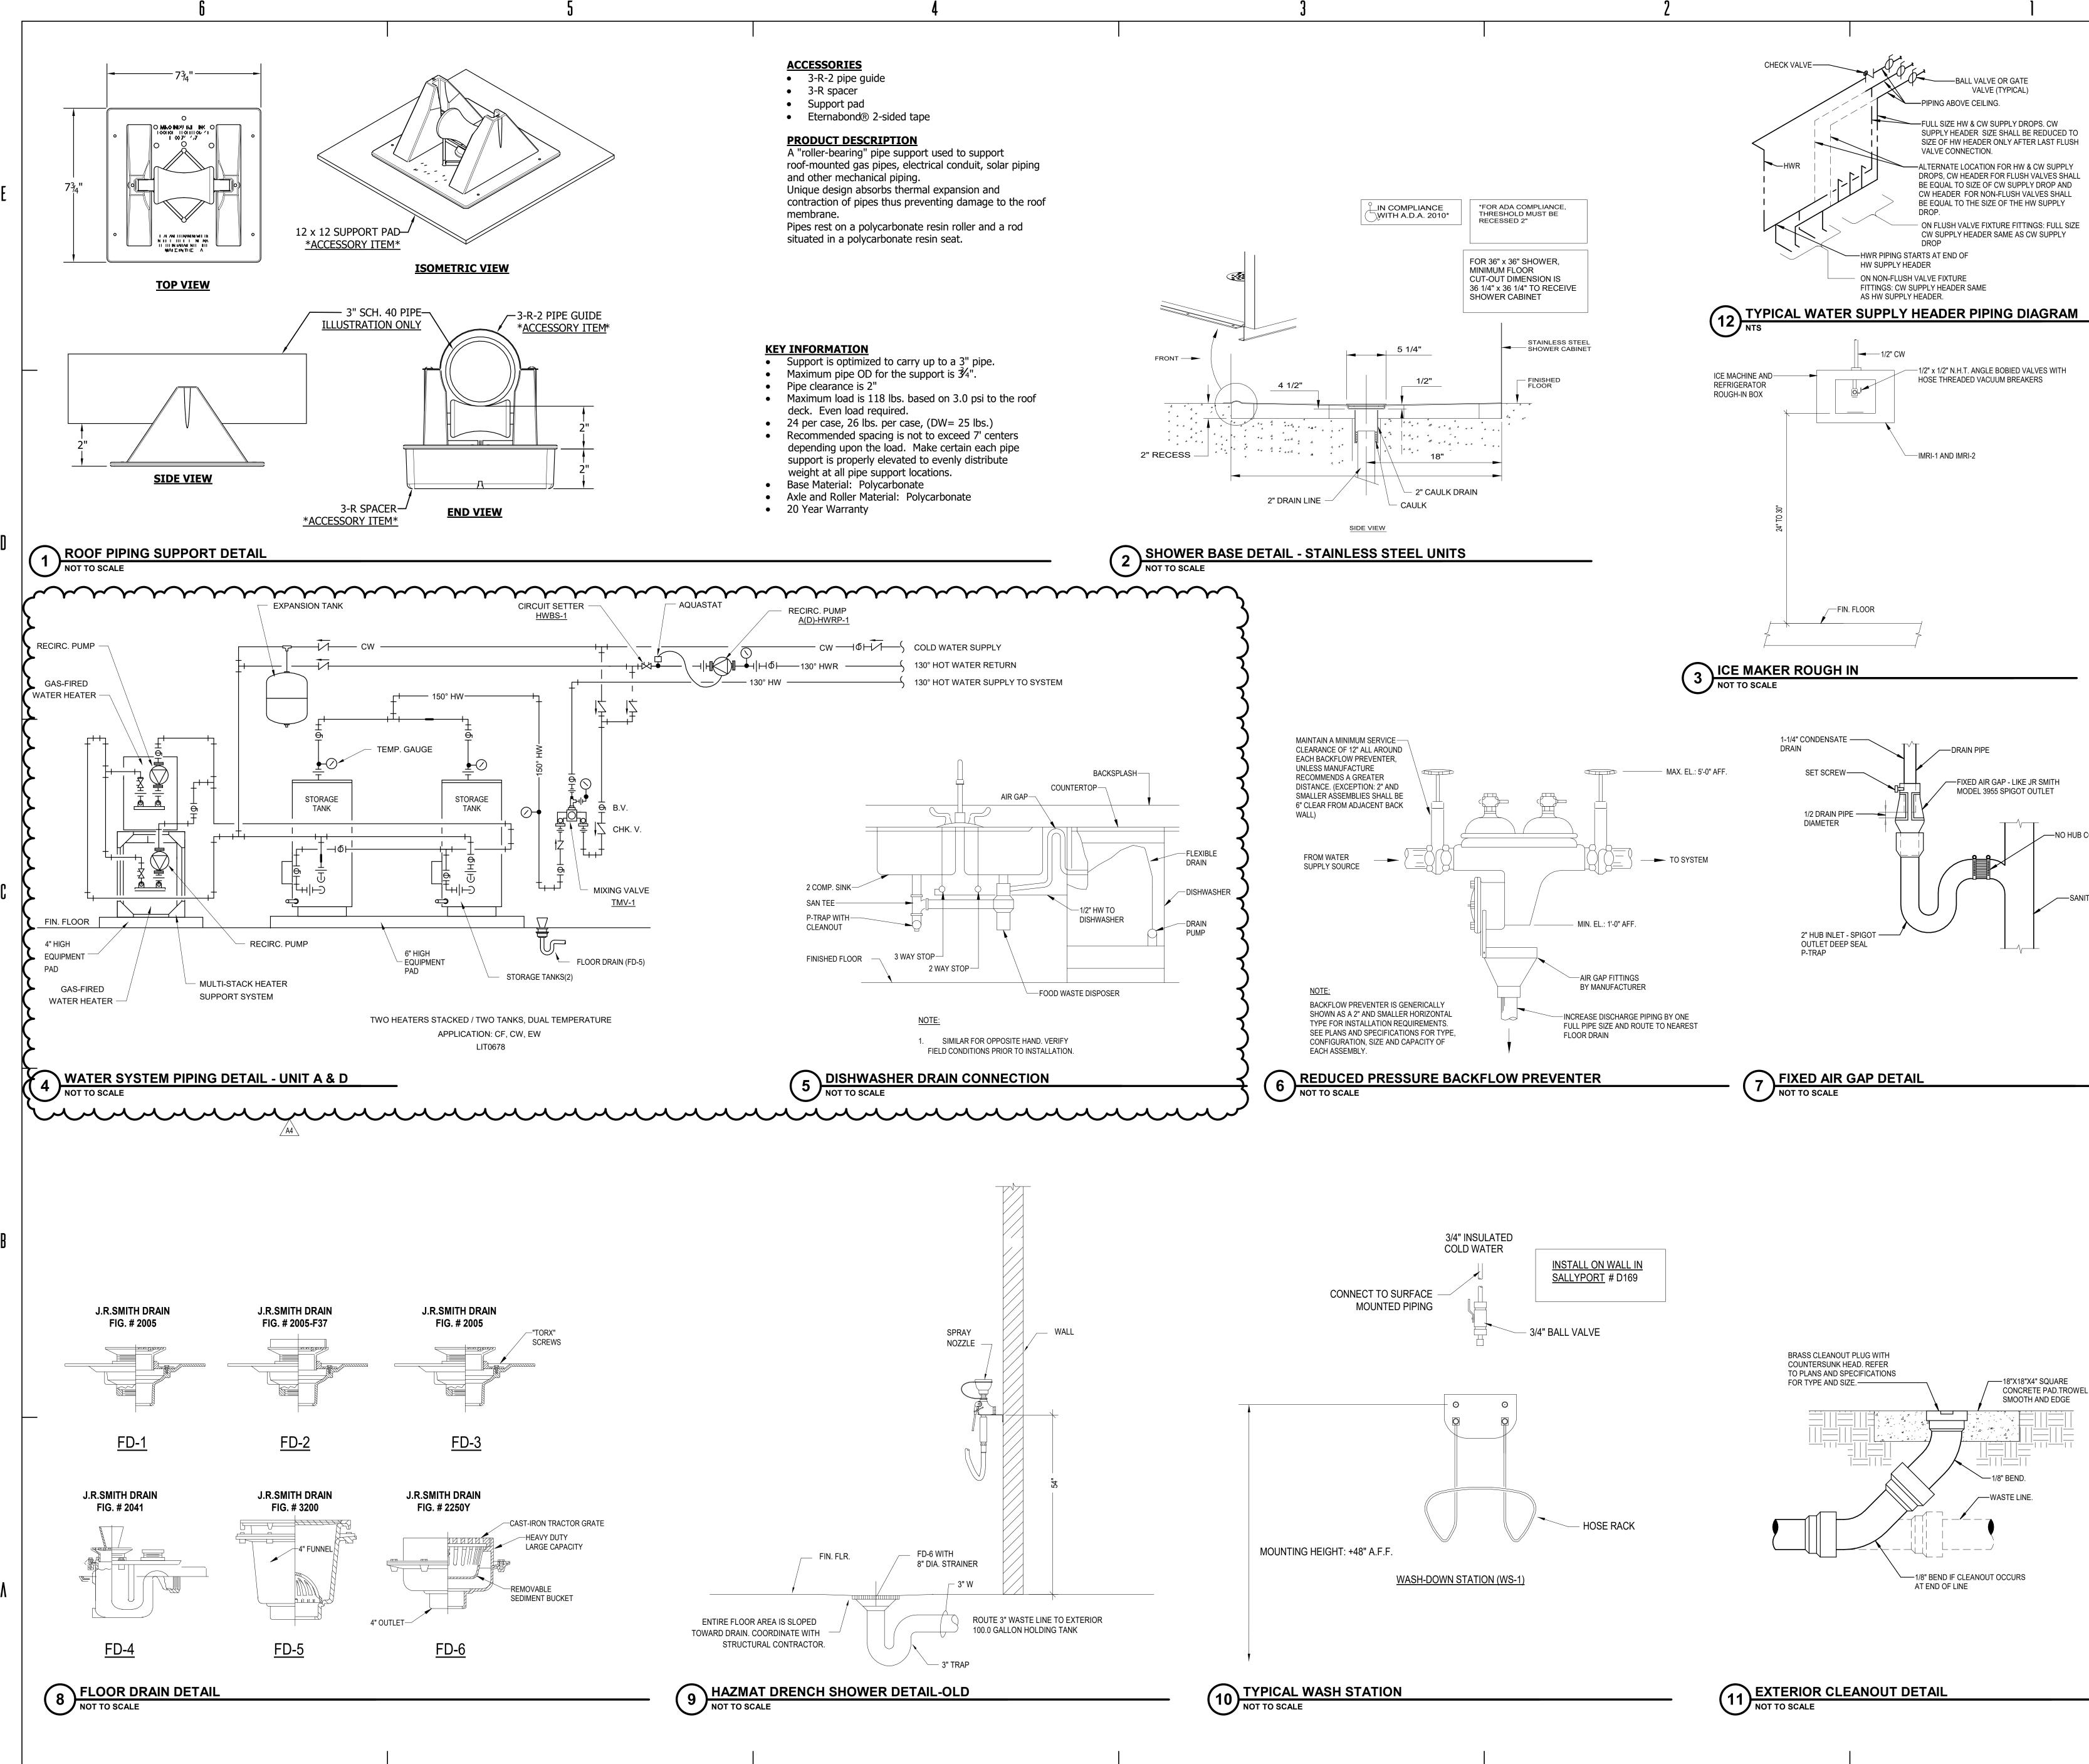

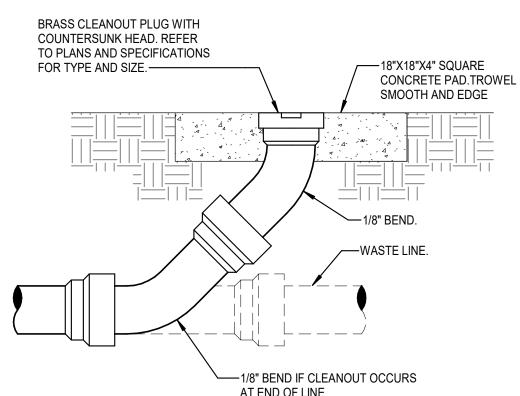

-NO HUB COUPLING

—SANITARY PIPE

